

**SAN ANTONIO WATER SYSTEM  
PRESSURE REDUCING VALVE (PRV) FLOW MONITORING  
AND PRESSURE MONITORING PROJECT  
SAWS PROJECT NO. 09-6005  
SOLICITATION NO. B-10-056-DG  
ADDENDUM NO. 1**

**October 1, 2010**

This addendum, applicable to work designated above, is an amendment to the bidding and specification documents and as such shall be a part of and included in the Contract. The original contract documents and any prior addenda remain in full force except s modified by the following which shall take precedence over any contrary provisions in prior documents.

Acknowledge receipt of this addendum by entering the addendum number and issue date in the spaces provided on all submitted copies of the proposal.

**1.0 Addenda Purpose**

The purpose of this addendum is to issue modifications to the plans and specifications, replies to submitted questions and responses, clarifications, and questions/comments at the mandatory pre-bid & site visit for the Pressure Reducing Valve (PRV) Flow Monitoring and Pressure Monitoring project (Saws Job No. 09-6005).

**2.0 Modifications to the Plans**

A. Sheet G3- ADD the following sentence to Note 51:

“Coordination of electrical service with CPS can be undertaken simultaneously for all sites.”

B. Sheet G3 – DELETE Note 43 and REPLACE with the following:

“All unpaved disturbed areas shall be vegetated with 4 inches of compacted, conditioned topsoil followed by sodding to match existing areas. Sod shall be as approved by CoSA, Bexar County, City of Helotes, or TxDOT (as applicable). Seed hydromulching may be performed in lieu of sodding only if approved by the applicable entity.”

C. Sheet C3 – DELETE the last sentence of “Existing PRV Abandonment Notes” Note 2 and REPLACE with the following:

“Remove any remaining debris, replace sidewalk, asphalt pavement, and curb and sod all remaining disturbed areas per Technical Specifications and Details.”

- D. Sheet C5 – DELETE the last two sentences of “Existing PRV Abandonment Notes” Note 2 and REPLACE with the following:  
  
“Remove any remaining debris, replace asphalt pavement, curb, and brick pavers, and sod all remaining disturbed areas per Technical Specifications and Details. New brick pavers shall match existing.”
- E. Sheet C22 – REPLACE this sheet with the modified Sheet C22 included in this Addendum.
- F. Sheet E4B – ADD this plan sheet to the Contract Documents.
- G. Sheet E6 – REPLACE this sheet with the modified Sheet E6 included in this Addendum.
- H. Sheet E6A – ADD this plan sheet to the Contract Documents.
- I. Sheet E8 – REPLACE this sheet with the modified Sheet E8 included in this Addendum.

### **3.0 Modifications to Specifications**

- A. SPECIAL CONDITIONS – DELETE section SC-2.2 in its entirety.
- B. Section 01720 PROJECT RECORD DOCUMENTS – ADD this specification to the Contract Documents.
- C. Section 16920 SCADA SYSTEM AND LOCAL STATION CONTROL AND MONITORING – Part 2.2, REPLACE with the attached Part 2.2 included in this Addendum.

### **4.0 Questions and Responses**

Q1: On this project we seem to be missing 01720 Project Record Documents from our specifications. Our specifications were downloaded from the website. Please send this section to us or advise as to the actions that should be taken.

Response: Technical Specification 01720 is included in this Addendum.

Q2: Will DIP be allowed inside the vaults (cumbersome small fabricated pieces for steel) as it will keep material consistent through out assembly instead of change?

Response: Ductile iron piping can be carried through the vault wall but the remaining piping within the vault must be steel.

Q3: There isn't room for restraint over FCA's. Will you allow FCA with restraint pins?

Response: Restraint pins will not be allowed. However, a Model 975 Dismantling Joint by Smith Blair (for restrained joint use) is acceptable instead.

Q4: The Vaults/Manholes cite spool pieces with F1 x F1 connections where penetrating the concrete...with double Link-seal connections...this will not work properly. Will grout be allowed around the pipe to allow instead?

Response: The wall penetration must be sealed with Link Seal as identified in the plans. However, ductile iron piping can be carried through the vault wall but the remaining piping within the vault must be steel.

Q5: DD-852-02 – is vented 24" R&C, The drawing and description look like a watertight 32" R&C what diameter ring and cover is required?

Response: Revised Sheet C22 is included in this Addendum. A manhole ring and cover assembly with a 32-inch clear opening is required.

Q6: Can Allen Bradley be substituted for Modicon on the PRV Monitoring and Pressure project?

Response: Allen Bradley will not be allowed as a substitute – only Modicon will be allowed, as identified in the specifications.

## 5.0 Clarifications

- A. The facility numbers in the "Site Location/Azimuth Table" on Sheet T01 are no longer valid and do not match the facility numbers shown on the Cover Sheet (Sheet G1). Refer to the facility name to match up each location. These facility numbers will be updated for the Conformance Documents for construction.
- B. PLC part numbers have been updated on Sheet E6 and Technical Specification 16920.
- C. The SCADA Digital Input on Sheet E6 has been revised to clarify between PRV and Pressure sites.
- D. Digital output drawings are now provided on Sheet E6A.
- E. In reference to Technical Specification 01323 - only pre-construction video is required (no post-construction). Video is intended only for aboveground features; the only exception would be the inside of any existing PRV vaults that will require any modifications. No NASSCO-PACP certification is required.

**6.0 Questions/Comments from the Pre-Bid Meeting**

A. Only Contractors that signed the Sign in Sheets at both the Mandatory Pre-bid Meeting and the Mandatory Site Visit are allowed to bid on this project.

B. A question was asked to reduce the liquidated damages from \$600/day to \$400/day as per General Conditions.

SAWS response: The project Special Conditions Section 2.2 noted an increase in liquidated damages to \$600/day.

C. A question was asked about using Ductile Iron pipe through vault walls in lieu of Flanged Steel Pipe as per plans.

SAWS response: This question should be submitted in writing and a response will be submitted in Addendum.

**7.0 Additional Attachments**


- A. Sign-in sheets from pre-bid meeting and pre-bid site visits.
- B. Revised Plans Sheets
- C. Revised Specifications Sheets

**ACKNOWLEDGEMENT BY BIDDER**

Each bidder is requested to acknowledge receipt of this Addendum No. 1 by his/her signature affixed hereto and to file same and attach with his/her bid.

The undersigned acknowledges receipt of this Addendum No.1 and the bid submitted herewith is in accordance with the information and stipulations set forth.

Date

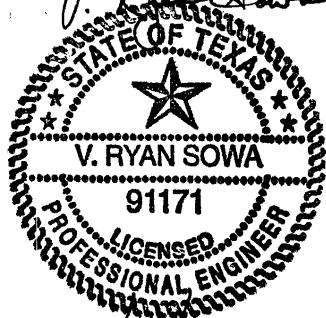*V. Ryan Sowa*  
  
10/01/10

Signature

Kimley-Horn and Associates, Inc.  
Texas Registered Engineering Firm F-928  
45 NE Loop 410, Ste. 890  
San Antonio, TX 78216



















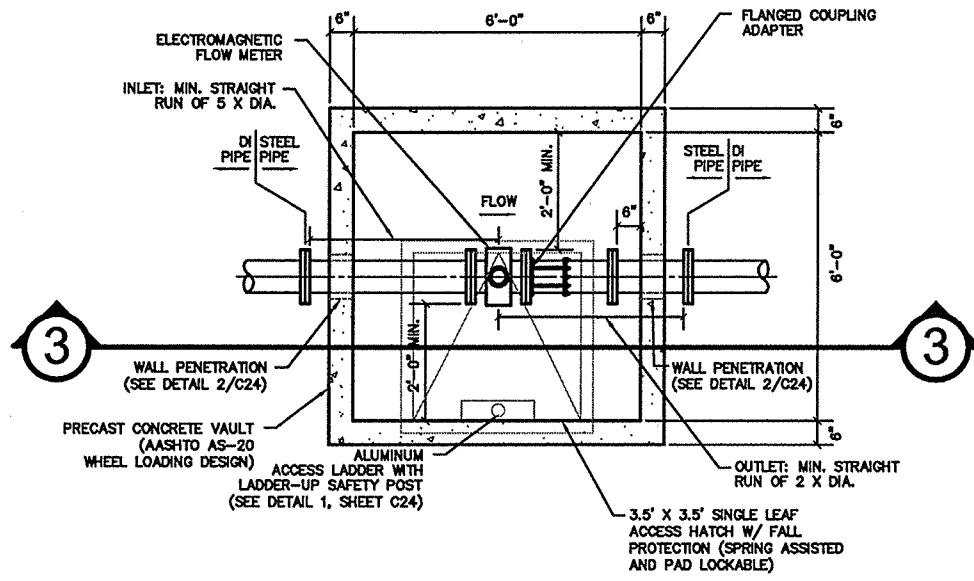


**1 FLOW METER VAULT PLAN**

SCALE: 1/4" = 1' (11" X 17")

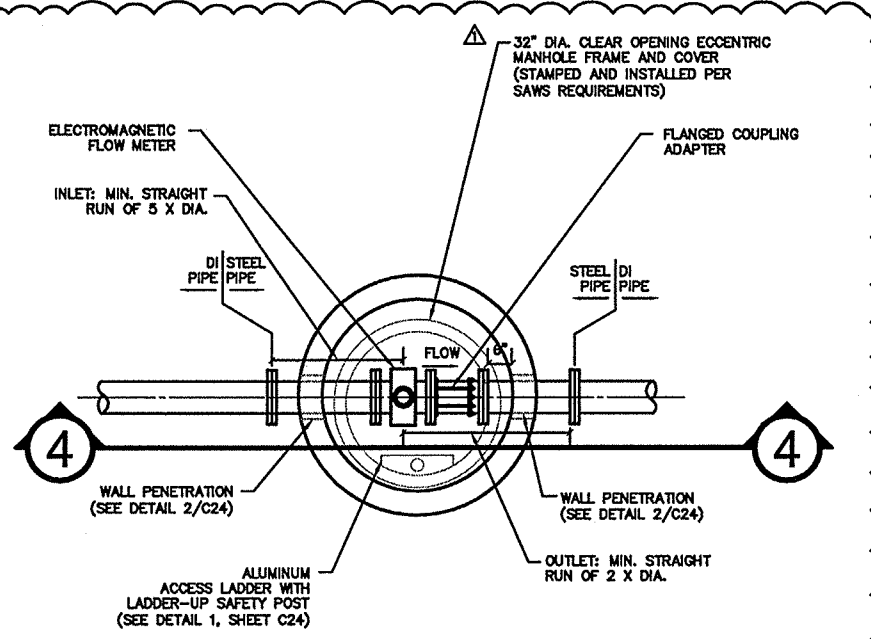

**2 FLOW METER MANHOLE - W. LOOP 1604 PLAN**


SCALE: 1/4" = 1' (11" X 17")

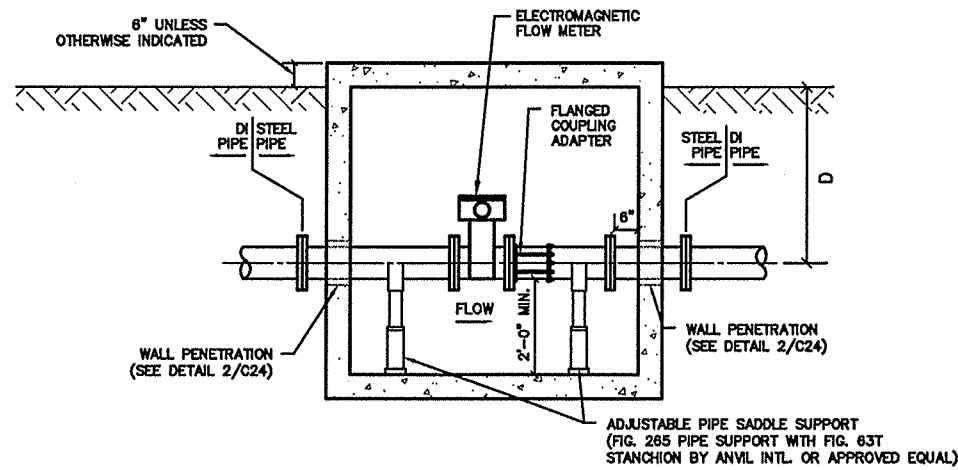

METER VAULT LOCATION	APPROXIMATE DEPTH "D" (FT.)
MILITARY DR.	5.0
IH-10 WEST FRONTAGE	4.0
TREELINE PARK	4.5
LACKLAND	3.5


**3 FLOW METER VAULT SECTION**

SCALE: 1/4" = 1' (11" X 17")

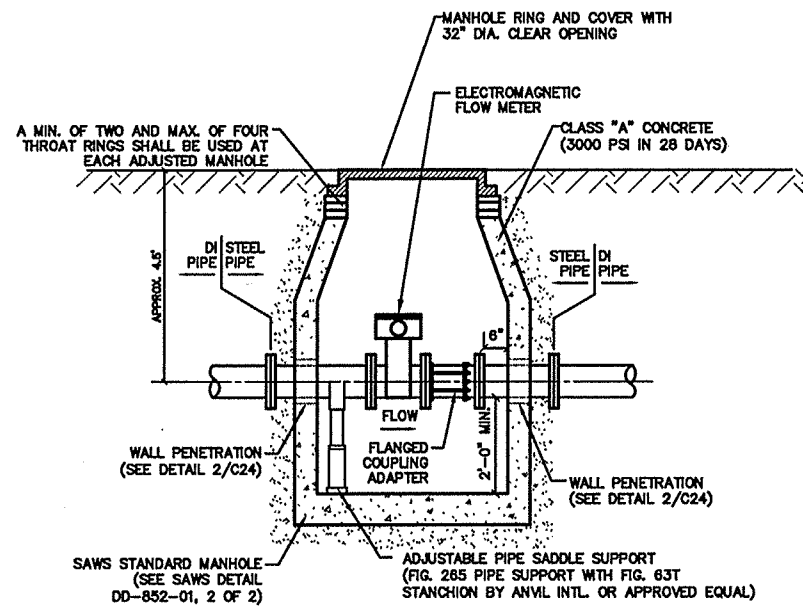

**4 FLOW METER MANHOLE - W. LOOP 1604 SECTION**

SCALE: 1/4" = 1' (11" X 17")

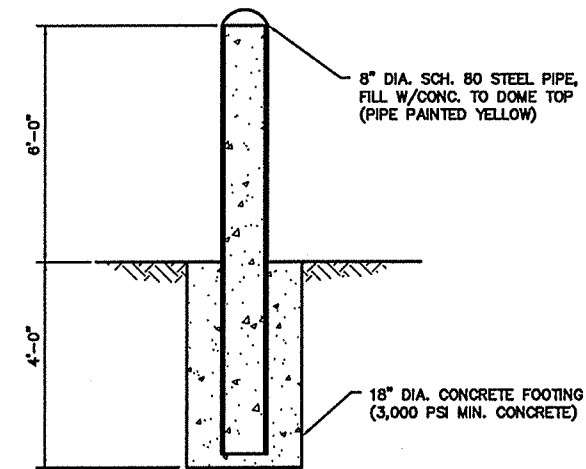

**5 PERMANENT BOLLARD DETAIL**

SCALE: NTS

MANHOLE DIA. REVISED TO 32"

**NOTES:**

1. ALL COUPLING ADAPTERS SHALL HAVE A MINIMUM GAP OF 1" AND A MAXIMUM GAP OF 2".
2. SEE SAWS DETAIL DD-902-02, SHEET C25, FOR FLANGED COUPLING ADAPTER DIMENSIONS.
3. ALL WELDED COUPLINGS SHALL BE RATED FOR 3000 LBS.
4. INSTALL CLOTH GASKET ISOLATION KITS BETWEEN ALL DISSIMILAR METALS.
5. ALL PROPOSED VALVES WITHIN VAULTS SHALL BE "OPEN LEFT". ALL PROPOSED VALVES TO BE DIRECTLY BURIED SHALL BE "OPEN RIGHT" AND THE VALVE LID SHALL BE STAMPED "OPEN RIGHT".
6. CONTRACTOR SHALL SUBMIT SHOP DRAWINGS FOR PRECAST VAULTS. SHOP DRAWING SUBMITTAL SHALL INCLUDE BUOYANCY CALCULATIONS ASSUMING THE WATER TABLE ELEVATION IS TO TOP OF GROUND. STRUCTURAL CALCULATIONS SHALL BE SIGNED AND SEALED BY A STRUCTURAL ENGINEER LICENSED IN THE STATE OF TEXAS. INSTALLATION OF VAULTS SHALL CONFORM TO SAWS CONSTRUCTION SPECIFICATIONS NO. 808 (REINFORCED CONCRETE VAULTS).

Kimley-Horn and Associates, Inc.


APPENDIX NO. 1

REVISION

DATE

BY

DC 09/26/10

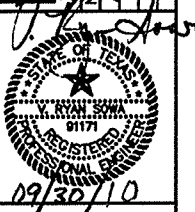

**SAN ANTONIO WATER SYSTEM**

**PRESSURE REDUCING VALVE (PRV) FLOW MONITORING AND PRESSURE MONITORING PROJECT**

**PRV/FLOW METER VAULT DETAILS 2**

Scale:	AS SHOWN
Designed by:	VRS
Drawn by:	DC
Checked by:	FCW
Date:	SEPTEMBER 2010
Project No.:	06866904
SAWS No.:	09-6005


BAR IS ONE INCH IN LENGTH ON ORIGINAL DRAWING. CHECK SCALE AND ADJUST ACCORDINGLY.

ONE INCH

SHEET


**C22**

DESIGNED BY: VRS  
 DRAWN BY: DC  
 CHECKED BY: FCW  
 DATE: SEPTEMBER 2010  
 PROJECT NO.: 06866904  
 SAWS NO.: 09-6005

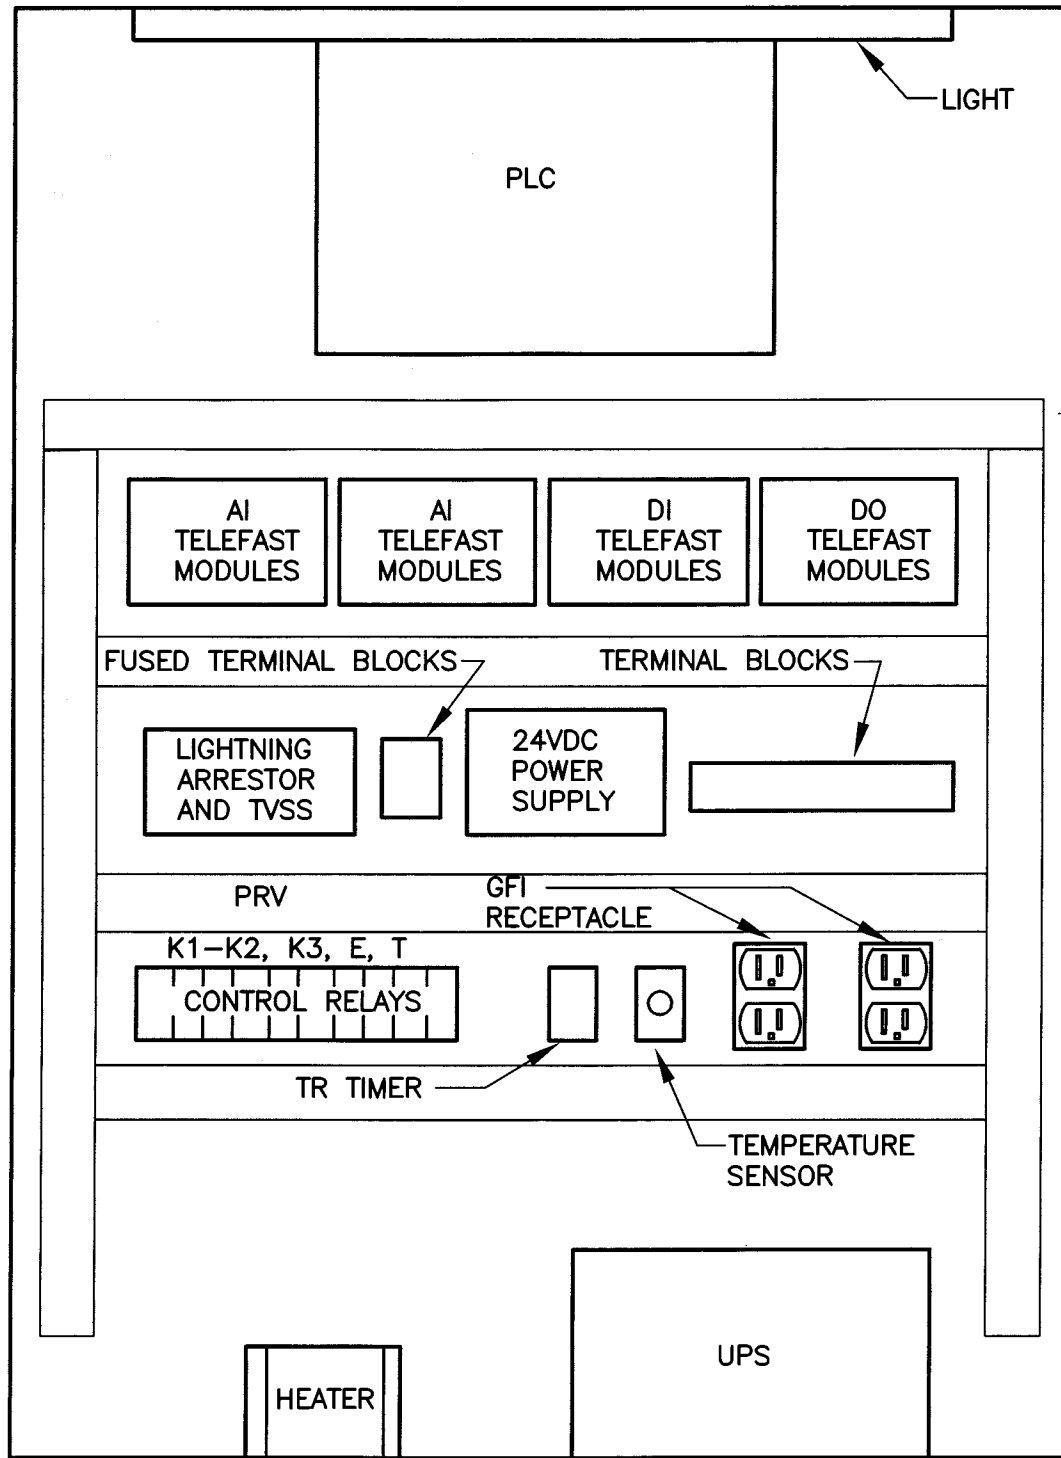


**1**  
E4B|E4B PRV SCADA PANEL LAYOUT  
NOT TO SCALE

APPLICABLE ONLY FOR WOODLAND GREEN PRV (PRV 11)  
AND IH10 WEST FRONTAGE ROAD PRV (PRV 12)

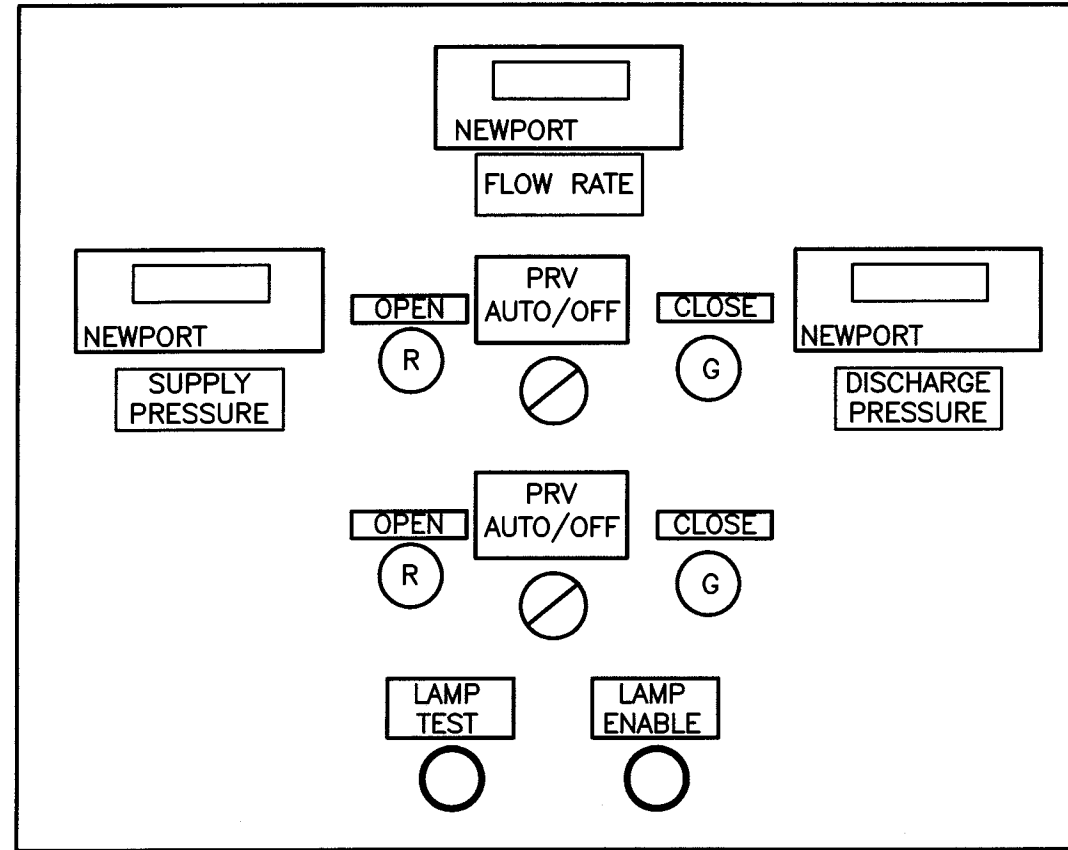

**2**  
E4B|E4B PRV SCADA PANEL:  
SWING-OUT PANEL LAYOUT  
NOT TO SCALE

JOSHUA ENGINEERING GROUP, INC.  
6800 PARK TEN BLVD., SUITE 240-E  
SAN ANTONIO, TEXAS 78213  
(210) 340-2322  
TBPB REGISTERED FIRM F-002874

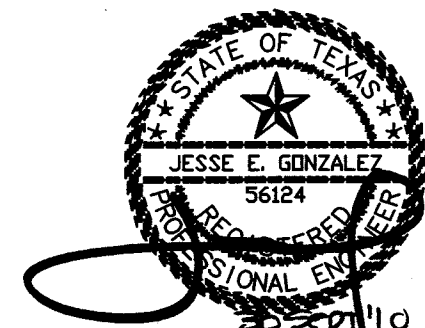

Kimley-Horn  
and Associates, Inc.  
45 NE Loop 410, Suite 800, San Antonio, TX 78218 210-541-8166  
Revision: EER10/17/10  
By: [Signature]  
Date: [Signature]

SAN ANTONIO  
WATER SYSTEM  
PRESSURE REDUCING VALVE (PRV)  
FLOW MONITORING AND PRESSURE  
MONITORING PROJECT

ELECTRICAL DETAILS

Scale: AS SHOWN  
Designed by: EER  
Drawn by: EER  
Checked by: JEG P.E.  
Date: SEPT 2010  
Project No. 066665004  
SA WS No. 09-005

SHEET  
1  
E4B

FIELD WIRING


SCADA PANEL

PLC (SCADA)


TELEFAST CONNECTION BASE \* (ABE-7H16R21)

\* NOTE 1 PROVIDE ADDITIONAL MOUNTING SPACE FOR FUTURE TELEFAST CONNECTION BASE

REF. DETAIL 1, SHEET E5 FOR TYPICAL PRV CONTROLS

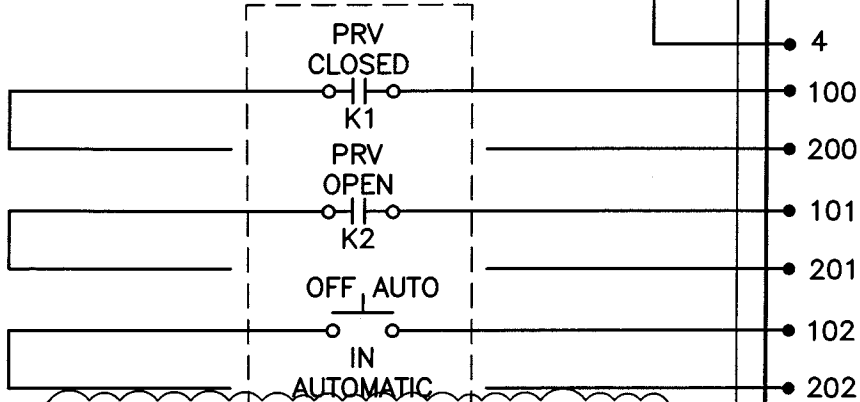


(DELETE AT PRESSURE TRANSMITTER SITES)


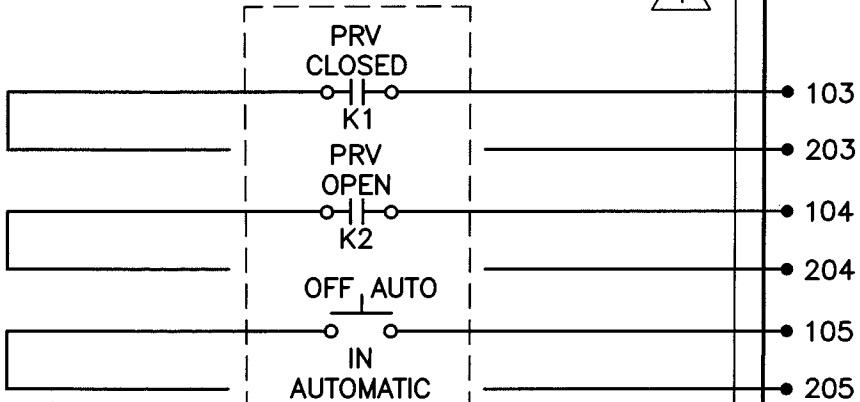


(DELETE AT PRESSURE TRANSMITTER SITES)

POWER LOSS ALARM SEE DETAIL 1, SHEET E8

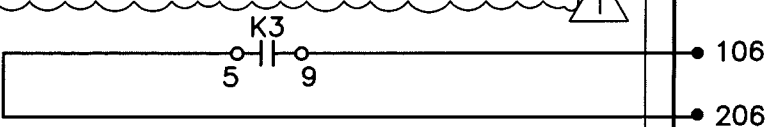

HIGH WATER IN VAULT

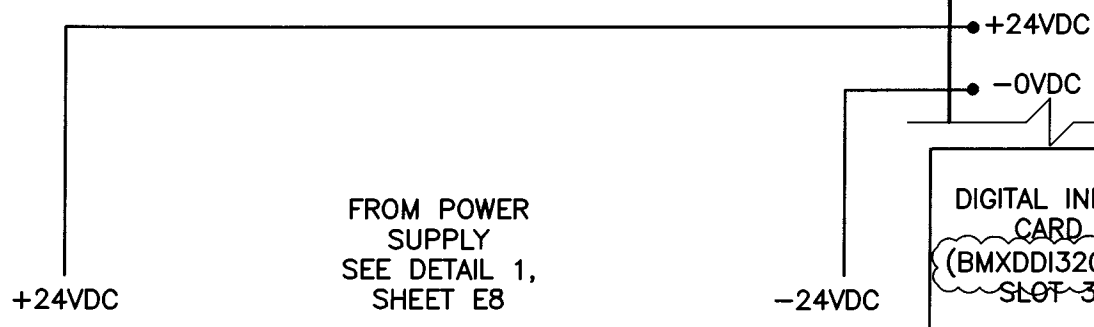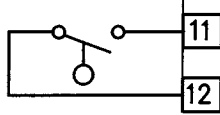

BMXFCC303

# 1 SCADA DIGITAL INPUT

E6 | E6 NOT TO SCALE

**JG**

JOSHUA ENGINEERING GROUP, INC.  
6800 PARK TEN BLVD., SUITE 240-E  
SAN ANTONIO, TEXAS 78213  
(210) 340-2322  
TBPB REGISTERED FIRM F-002874

Scale: AS SHOWN  
Designed by: EER  
Drawn by: EER  
Checked by: JEG P.E.  
Date: AUG 2010  
Project No. 068665004  
SAWS No. 09-0005

Kimley-Horn and Associates, Inc.  
44 NE Loop 410, Suite 880, San Antonio, TX 78216 210-541-8186  
By: [Signature] Date: EER10/17/10  
Revision: [Signature] ADDENDUM NO. 1

**SAW**

SAN ANTONIO WATER SYSTEM  
PRESSURE REDUCING VALVE (PRV) FLOW MONITORING AND PRESSURE MONITORING PROJECT

## ELECTRICAL DETAIL


Scale:	AS SHOWN
Designed by:	EER
Drawn by:	EER
Checked by:	JEG P.E.
Date:	AUG 2010
Project No.:	068665004
SAWS No.:	09-0005



FIELD WIRING

SCADA PANEL


PLC (SCADA)

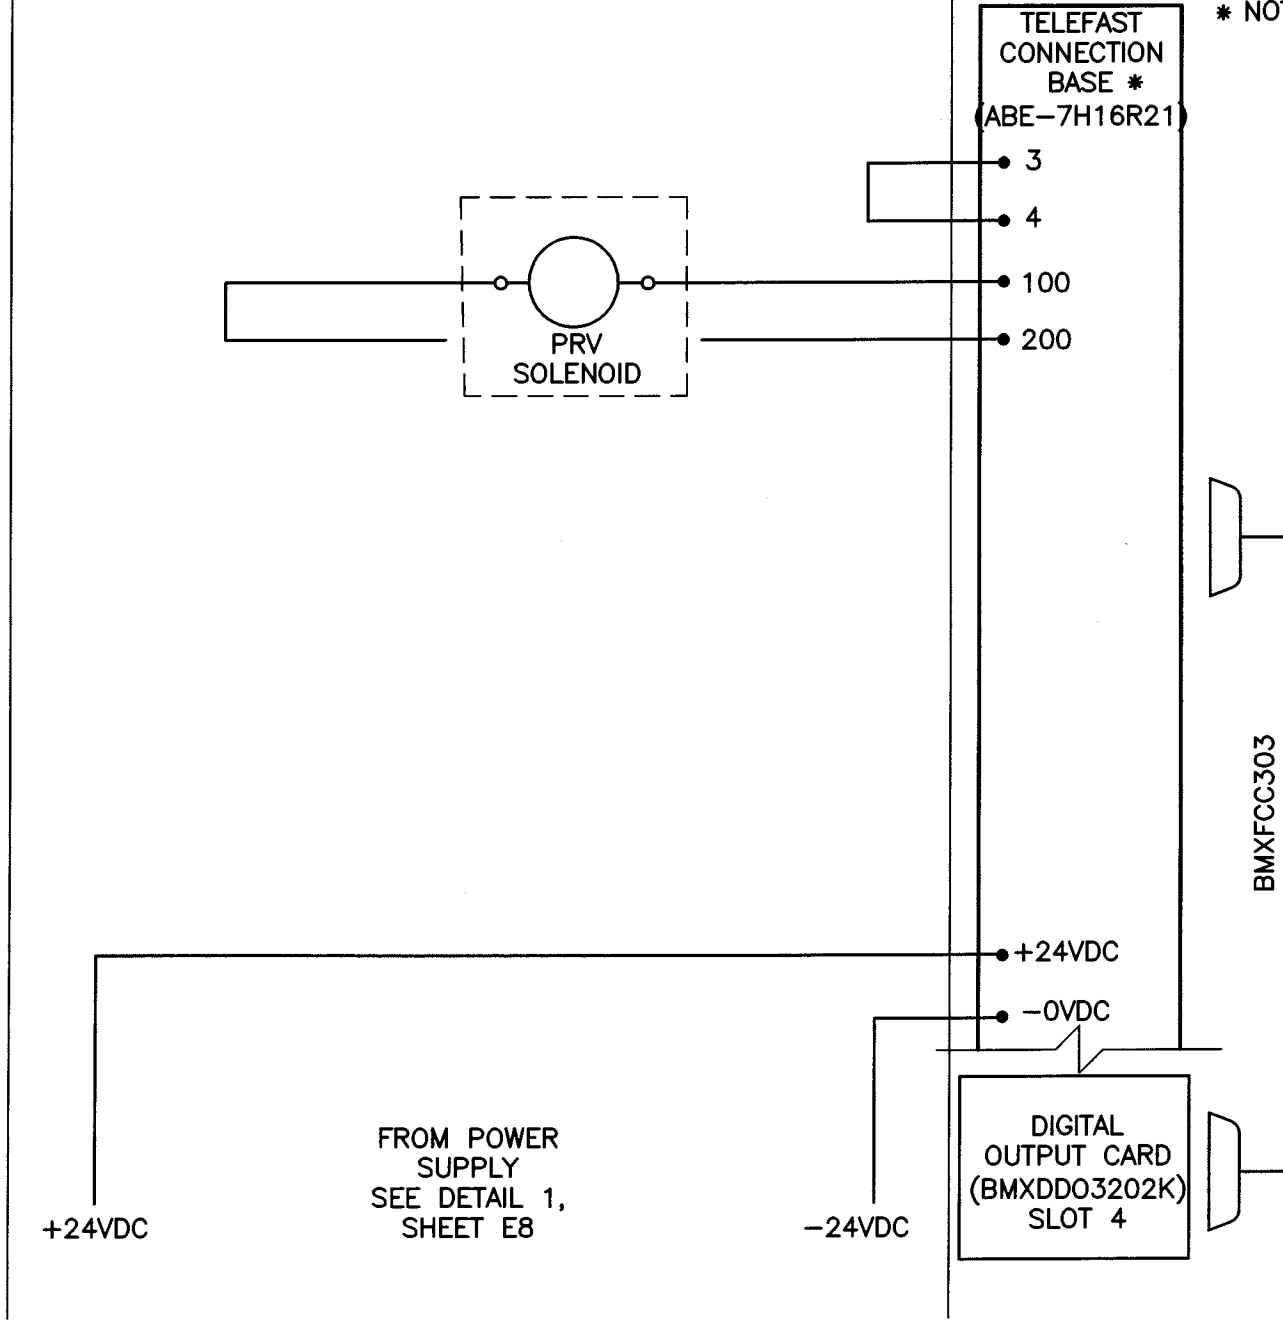

\* NOTE 1 PROVIDE ADDITIONAL MOUNTING SPACE FOR FUTURE TELEFAST CONNECTION BASE

**1 SCADA DIGITAL OUTPUT**  
 E6A | E6A NOT TO SCALE

**JEG**  
 JOSHUA ENGINEERING GROUP, INC.  
 6800 PARK TEN BLVD., SUITE 240-E  
 SAN ANTONIO, TEXAS 78213  
 (210) 340-2322  
 TBPE REGISTERED FIRM F-002974

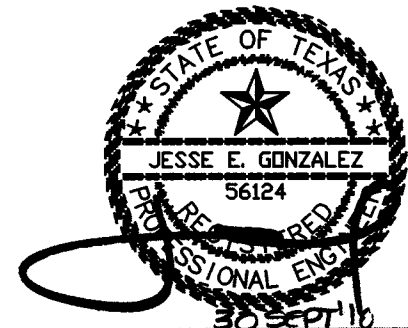


Kimley-Horn and Associates, Inc.	
45 NE Loop 410, Suite 800 San Antonio, TX 78216 210-541-9166	By: EER
Revision: APPENDIX NO. 1	Date: 10/1/10
No.:	

**SAN ANTONIO WATER SYSTEM**  
 PRESSURE REDUCING VALVE (PRV)  
 FLOW MONITORING AND PRESSURE MONITORING PROJECT

**ELECTRICAL DETAIL**

Scale: AS SHOWN
Designed by: EER
Drawn by: EER
Checked by: JEG P.E.
Date: SEPT 2010
Project No. 068665004
SAWS No. 09-6005

SHEET  
 1  
**E6A**

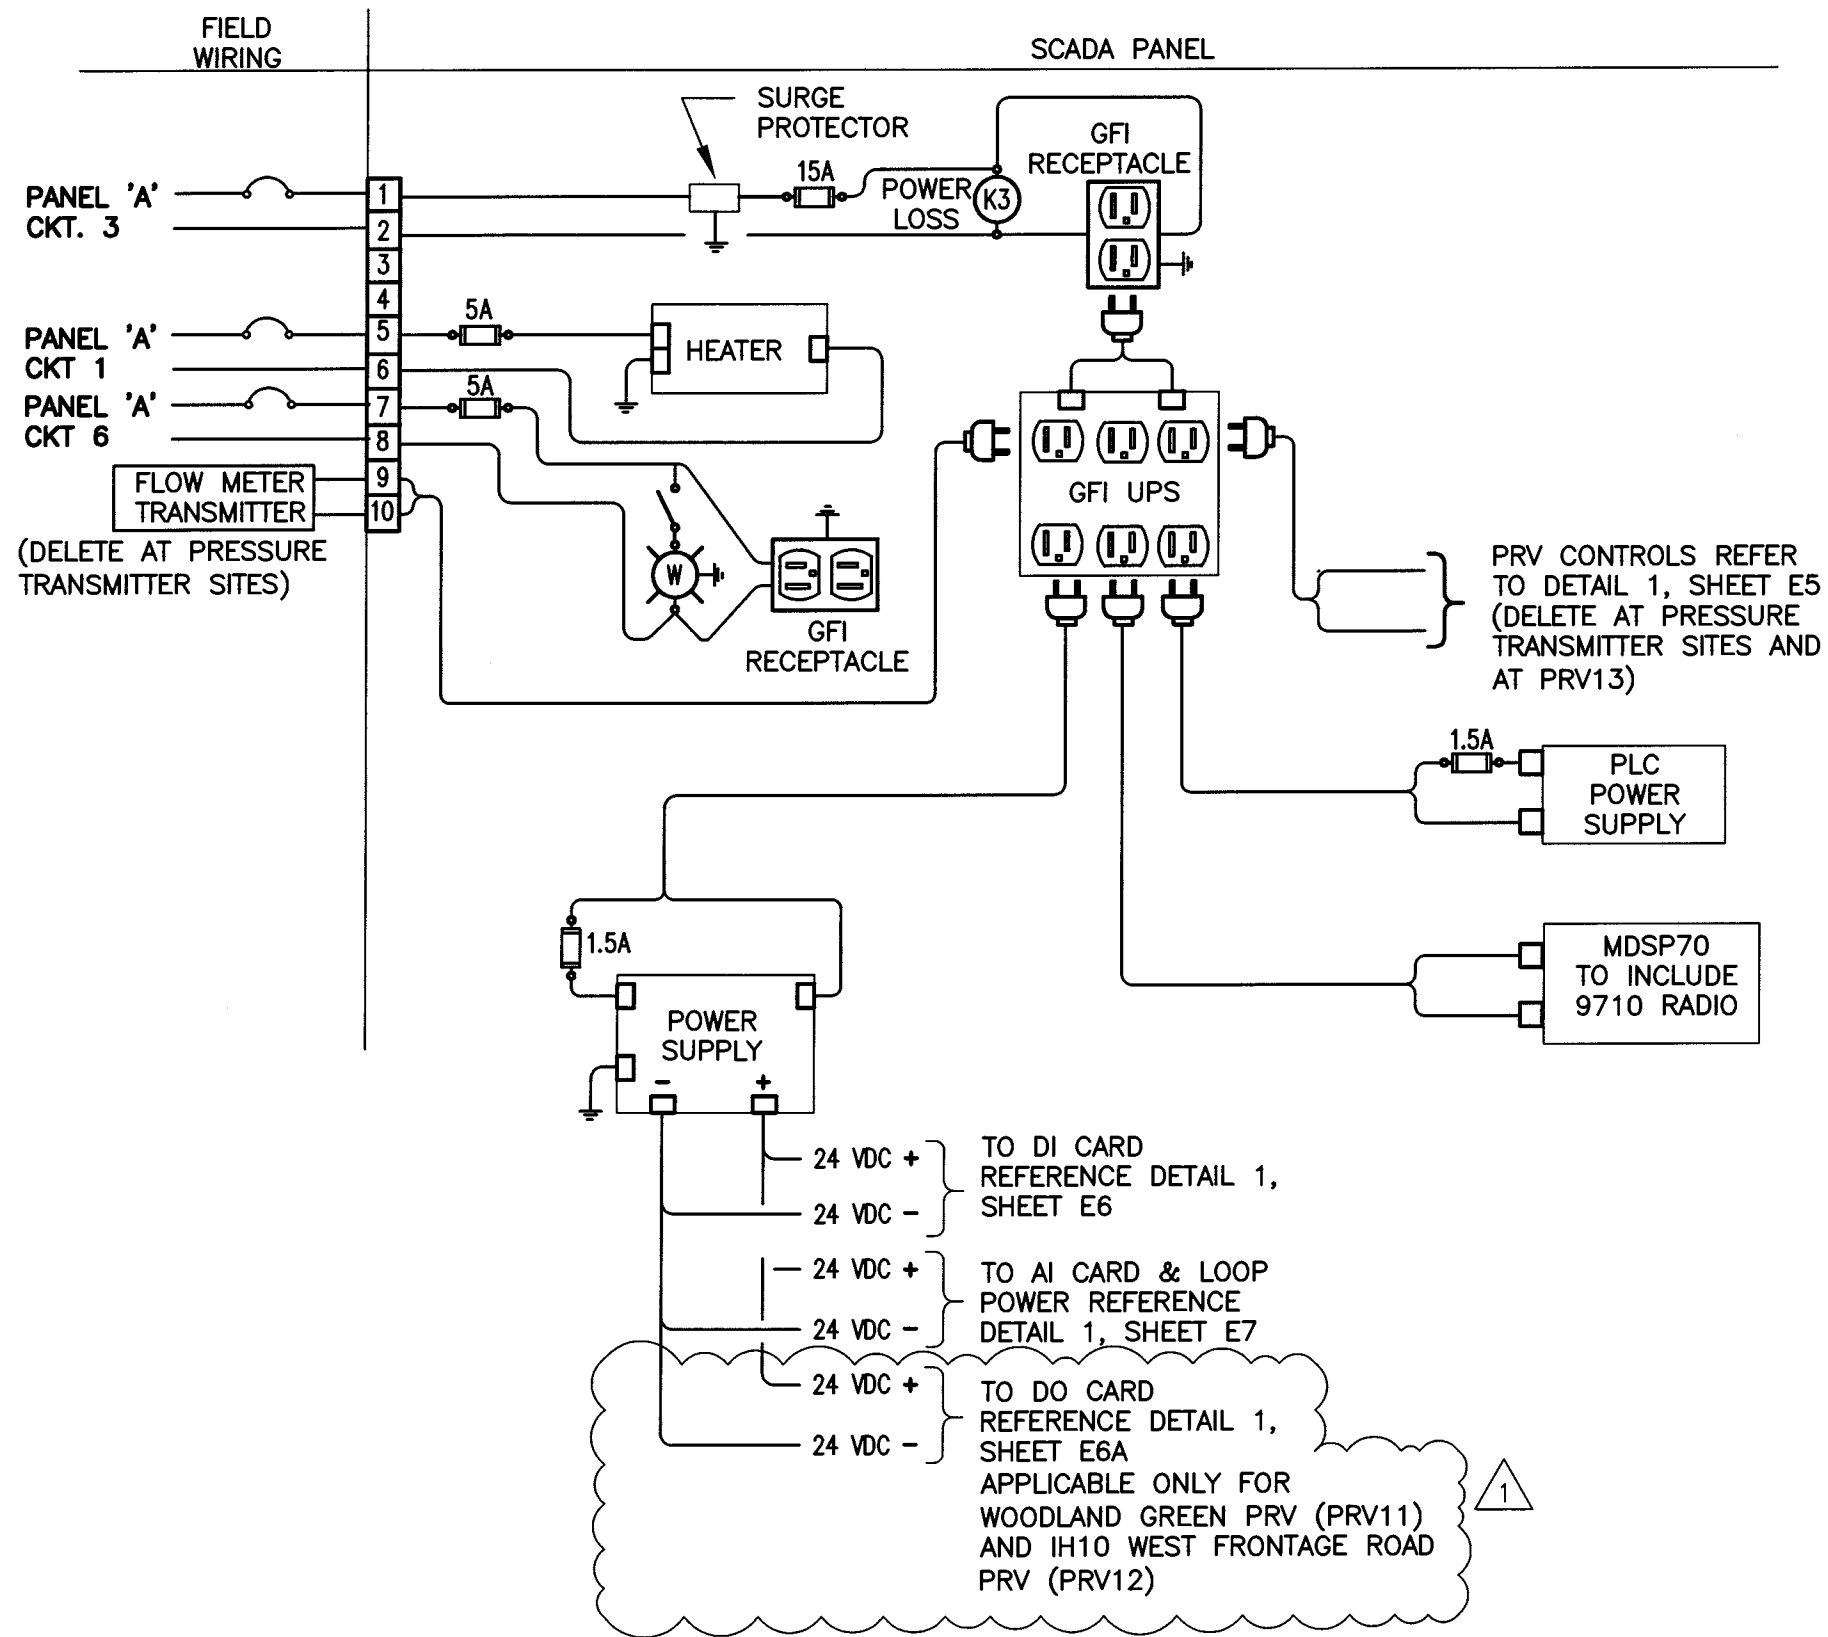


1  
E8 | E8  
**PRV SCADA POWER DISTRIBUTION**  
NOT TO SCALE

Kimley-Horn  
and Associates, Inc.  
45 NE Loop 410, Suite 800, San Antonio, TX 78216  
210-541-8166  
BY: [Signature] Date: [Blank]  
Revision: [Blank]  
No. 1 ADDENDUM NO. 1 EER10/17/10

**SAN ANTONIO WATER SYSTEM**  
PRESSURE REDUCING VALVE (PRV) FLOW MONITORING AND PRESSURE MONITORING PROJECT

**ELECTRICAL DETAIL**

JOSHUA ENGINEERING GROUP, INC.  
6800 PARK TEN BLDG., SUITE 240-E  
SAN ANTONIO, TEXAS 78213  
(210) 340-2322  
TBE REGISTERED FIRM T-002974

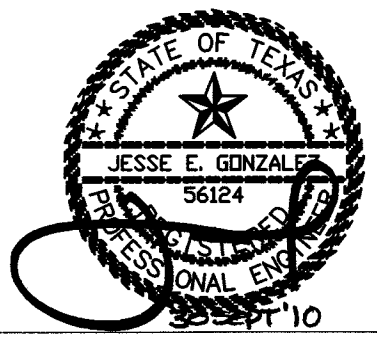

Scale: AS SHOWN  
Designed by: EER  
Drawn by: EER  
Checked by: JEG P.E.  
Date: AUG 2010  
Project No. 068665004  
SAWS No. 09-005

SHEET

**E8**

**PART 1 - GENERAL**

1.01 DESCRIPTION:

A. Work Included:

1. Throughout progress of the Work, the Contractor shall maintain an accurate record of changes in the Contract Documents, as described in Article 3.1 below.
2. Upon completion of the Work, the Contractor shall transfer the recorded changes to a set of Record Documents, as described in Article 3.2 below.

B. Related Work:

1. Documents affecting work of this Section include, but are not necessarily limited to, General Conditions, Special Conditions, and Sections in Division 1 of these Specifications.
2. Other requirements affecting Project Record Documents may appear in pertinent other Sections of these Specifications.

1.02 QUALITY ASSURANCE:

A. The Contractor shall delegate the responsibility for maintenance of Record Documents to one person on the Contractor's staff as approved by the Owner.

B. Accuracy of records:

1. The Contractor shall thoroughly coordinate changes within the Record Documents, making adequate and proper entries on each page of Specifications and each sheet of Drawings and other Documents where such entry is required to show the change properly.
2. Accuracy of records shall be such that future search for items shown in the Contract Documents may rely reasonably on information obtained from the approved Project Record Documents.

C. The Contractor shall make entries within 24 hours after receipt of information that the change has occurred.

1.03 SUBMITTALS:

A. Comply with pertinent provisions of Section 01340.

B. The Owner's approval of the current status of Project Record Documents may be a prerequisite to the Owner's approval of requests for progress payment and request for final payment under the Contract.

C. Prior to submitting each request for progress payment, secure the Owner's approval of the current status of the Project Record Documents.



- D. Prior to submitting request for final payment, submit the final Project Documents to the Owner and Consultant and secure approval.

1.04 PRODUCT HANDLING:

- A. The Contractor shall maintain the job set of Record Documents completely protected from deterioration and from loss and damage through completion of the Work and transfer of all recorded data to the final Project Record Documents.
- B. In the event of loss of recorded data, the Contractor shall use means necessary to again secure the data to the Owner's approval.
  - 1. Such means shall include, if necessary in the opinion of the Owner, removal and replacement of concealing materials.
  - 2. In such case, provide replacements to the standards originally required by the Contract Documents.

**PART 2 - PRODUCTS**

2.01 RECORD DOCUMENTS:

- A. Job set: Promptly following receipt of the Owner's Notice to Proceed, the Contractor shall secure from the Consultant at no charge to the Contractor one complete set of all Documents comprising the Contract.

**PART 3 - EXECUTION**

3.01 MAINTENANCE OF JOB SET:

- A. Immediately upon receipt of the job set described in Paragraph 2.01-A above, identify each of the Documents with the title, "RECORD DOCUMENTS - JOB SET".
- B. Preservation:
  - 1. Considering the Contract completion time, the probable number of occasions upon which the job set must be taken out for new entries and for examination, and the conditions under which these activities will be performed, devise a suitable method for protecting the job set to the approval of the Owner.
  - 2. Do not use the job set for any purpose except entry of new data and for review by the Owner, until start of transfer of data to final Project Record Documents.
  - 3. Maintain the job set at the site of Work as that site is designated by the Owner.
- C. Making entries on Plans:
  - 1. Using an erasable colored pencil (not ink or indelible pencil), clearly describe the change by graphic line and note as required.

2. Date all entries.
  3. Call attention to the entry by a "cloud" drawn around the area or areas affected.
  4. In the event of overlapping changes, use different colors for the overlapping changes.
- D. Make entries in the pertinent other Documents as approved by the Owner.
- E. Conversion of schematic layouts:
1. In some cases on the Plans, arrangements of conduits, circuits, piping, ducts, and similar items, is shown schematically and is not intended to portray precise physical layout.
    - a. Final physical arrangement is determined by the Contractor, subject to the Owner's approval.
    - b. However, design of future modifications of the facility may require accurate information as to the final physical layout of items which are shown only schematically on the Plans.
  2. Show on the job set of Record Drawings, by dimension accurate to within one inch, the centerline of each run of items such as are described in subparagraph 3.01-E-1 above.
    - a. Final physical arrangement is determined by the Contractor, subject to the Owner's approval.
    - b. Show, by symbol or note, the vertical location of the Item ("under slab", "in ceiling plenum", "exposed", and the like).
    - c. Make all identification sufficiently descriptive that it may be related reliably to the Specifications.
  3. The Owner may waive the requirements for conversion of schematic layouts where, in the Owner's judgment, conversion serves no useful purpose. However, do not rely upon waivers being issued except as specifically issued in writing by the Owner.
- 3.02 FINAL PROJECT RECORD DOCUMENTS:
- A. The purpose of the final Project Record Documents is to provide factual information regarding all aspects of the Work, both concealed and visible, to enable future modification of the Work to proceed without lengthy and expensive site measurement, investigation, and examination.
- B. Approval of recorded data prior to transfer:
1. Following receipt of the documents described in Paragraph 2.01-A above, and prior to start of transfer of recorded data thereto, secure the Owner's approval of all recorded data.
  2. Make required revisions.
- C. Transfer of data by Contractor to Plans:

1. Carefully transfer change data shown on the job set of Record Drawings to the corresponding transparencies, coordinating the changes as required.
2. Clearly indicate at each affected detail a full description of changes made during construction, and the actual location of items described in subparagraph 3.01-C above.
3. Call attention to each entry by drawing a "cloud" around the area or areas affected.
4. Make changes neatly, consistently, and with the proper media to assure longevity and clear reproduction.

D. Transfer of data to other Documents:

1. If the Documents other than Plans have been kept clean during progress of the Work, and if entries thereon have been orderly to the approval of the Owner, the job set of those Documents other than Plans will be accepted as final Record Documents.
2. If any such Document is not so approved by the Owner, secure a new copy of that Document from the Consultant at the Consultant's usual charge for reproduction and handling, and carefully transfer the change data to the new copy to the approval of the Consultant.

E. Review and submittal:

1. Submit the completed set of Project Record Documents to the Consultant as described in Paragraph 1.03-C above.
2. Participate in review meetings as required.
3. Make required changes and promptly deliver the final Project Record Documents to the Owner.

3.03 CHANGES SUBSEQUENT TO ACCEPTANCE:

- A. The Contractor has no responsibility for recording changes in the Work subsequent to Final Completion, except for changes resulting from work performed under Warranty.

END OF SECTION



## TECHNICAL SPECIFICATION 16920

### 2.2 PROGRAMMABLE LOGIC CONTROLLER (PLC) SYSTEM

- A. The PLC shall be a complete system that includes but is not limited to the following:
1. PLC Central Processing Unit (CPU)
  2. PLC modules, chassis, and power supply
  3. Connection bases
  4. Connection cables
  5. Program software deliverable to Owner (SAWS)

B. Approved Products – NO SUBSTITUTIONS

<u>DESCRIPTIONS</u>	<u>MANUFACTURER</u>	<u>PART NUMBER</u>
8 Slot Backplane *	Modicon	BMX XBP 0800
Power Supply Module *	Modicon	BMX CPS 3500
CPU *	Modicon	BMX P34 2020
32 Channel Digital Input Module *	Modicon	BMX DDI 3202K
4 Channel Analog Input Module *	Modicon	BMX AMI 0410
32 Channel Digital Output Module *	Modicon	BMX DDO 3202K
Digital Input and Output Telefast Connection Base *	Modicon	ABE 7H16R21
Digital Input and Output Telefast Connection Cable	Modicon	BMX FCC303
Analog Input and Output Telefast Connection Base *	Modicon	ABE 7CPA410
Analog Input and Output Telefast Connection Cable	Modicon	BMX FCA300
8-Slot Cable and Shielding Kit	Modicon	BMX XSP0800
Cable Shield Clamps (Package of 10)	Modicon	STB XSP3020
Empty Slot Protective Covers	Modicon	BMX XEM010

- C. Communications:
1. Modbus RS 232 communication ports shall be provided using the PLC CPU serial ports.
- D. Programming:
1. The PLC shall use Modicon Unity Pro 5.0 PLC programming software or the latest version.
  2. All the programs and licenses shall become the property of the Owner.
  3. Contractor to coordinate with the SCADA division of the SAWS Production Department.
- E. Spare Materials:
1. Furnish spare materials quantity, for each of the above listed products (Paragraph B) marked with an \*, equal to 10 per cent of amount installed, but not less than one unit/type.
  2. Extra materials shall be packaged with protective covering and identified with labels describing contents.
- F. All spare telefast I/O points shall be wired to terminal blocks.