

Addendum No. 2
Seale Ground Storage Tank No. 1 Painting and Rehabilitation Project
SAWS Job No. 11-0107
SAWS Solicitation No. B-12-052-MF

ADDENDUM NO. 2

September 11, 2012

This addendum, applicable to work designated above, is an amendment to the proposal and specification documents and as such shall be a part of and included in the Contract. Acknowledge receipt of this addendum by entering the addendum number and issue date in the spaces provided on all submitted copies of the proposal.

1.0 Addenda Purpose

- A. The purpose of this addendum is to issue revisions to the plans and specifications for the Seale Ground Storage Tank No. 1 Painting and Rehabilitation Project (SAWS Job No. 11-0107; SAWS Solicitation No. B-12-052-MF).

2.0 Modification to the Specifications

- A. Submittal Checklist
Remove the Submittal Checklist form in its entirety and replace with the revised Submittal Checklist included with this addendum.
- B. Supplementary Conditions
Strike Supplementary Condition SUC 1.1 in its entirety.
- C. Supplementary Conditions
Add the following Supplementary Condition:
“SUC 2.10 Contractor’s Insurance Requirements:
Article V, Section 5.7 of the General Conditions of these Contract Documents adequately specifies the lines of insurance coverage required by the Contractor with one exception: remove/waive Section 5.7.1.1.8 – Builder’s Risk line of coverage.”

3.0 Modification to the Plans

- A. Sheet C-002 Site Fencing Plan
Remove Sheet C-002 in its entirety and replace with the revised Sheet C-002 included with this addendum.

B. Sheet E-003 Electrical Demolition Plan

Remove Sheet E-003 in its entirety and replace with the revised Sheet E-003 included with this addendum.

4.0 Questions and Answers

Q1. In regard to the San Antonio Seale Ground Storage Tank 1 project, Raven Industries believes VaporBlock is already an approved manufacturer for the purpose of underslab vapor barrier films listed in division 3. However, we are not listed as an approved manufacturer in the project documentation (see 03300-4). Can I please request VaporBlock 10 (VB10) to be included in the next addendum?

A1. *Submission of equivalent products will not be addressed in an addendum. Refer to Special Conditions SPC 1.1 for requests for review of equivalent materials and equipment.*

Q2. Submittal check list: missing respondent questionnaire, please provide this form?

A2. *The respondent questionnaire is not required. Refer to Section 2.0, Item A of this addendum.*

Q3. Per supplementary conditions SUC 1.1, the contractor is required to perform 40% of the work with his own forces. Please delete this requirement because the nature of this project requires multiple specialized subcontractors that will prevent the prime contractor from meeting this 40% requirement.

A3. *Refer to Section 2.0, Item B of this addendum.*

Q4. Will a builder's risk insurance policy be required as part of the insurance requirements noted in 5.7, 1.8?

A4. *Builder's risk insurance will not be required; refer to Section 2.0, Item C of this addendum.*

5.0 Additional Attachments

A. Submittal Checklist

B. Sheet C-002 Site Fencing Plan

C. Sheet E-003 Electrical Demolition Plan

ACKNOWLEDGEMENT BY BIDDER

Each respondent is requested to acknowledge receipt of this Addendum No. 2 by his/her signature affixed hereto and to file same and attach with his/her proposal.

The undersigned acknowledges receipt of this Addendum No. 2 and the proposal submitted herewith is in accordance with the information and stipulations set forth.

Date

Signature

Tetra Tech, Inc.
Texas Registered Engineering Firm F-3924
700 N. Saint Mary's Street, Ste. 300
San Antonio, TX 78205



SUBMITTAL CHECKLIST

Project Name: Seale Ground Storage Tank No. 1 Painting and Rehabilitation Project
Solicitation Number: B-12-052-MF

Use this checklist to ensure that the entire proposal packet is complete by checking off each item included in both envelopes. Sign and date this form and include this page with each submittal.

ORIGINAL SUBMITTAL-1 (sealed envelope or box)

- Submittal Checklist
- Price Proposal with Proposal Certification
- Good Faith Effort Plan (Reference pages SIR-5 and SIR -6)
- Financial Statement
- Conflict of Interest Questionnaire
- Bid Bond/Cashier's Check
- W-9
- Proof of Insurability (Letter from Insurer or Sample Certificate of Insurance)
- Background, Experience, and Qualifications narrative (Reference pages SIR-2 and SIR-3)
- Proposed Plan, Safety, and Quality Control Program narrative (Reference page SIR-3 and SIR-4)
- Acknowledgement of Addendum(s)
- CD

COPIES -7 (sealed envelope or box)

- Submittal Checklist
- Background, Experience, and Qualifications narrative (Reference pages SIR-2 and SIR-3)
- Proposed Plan, Safety, and Quality Control Program narrative (Reference page SIR-3 and SIR-4)
- Acknowledgement of Addendum(s)

I certify that the proposal packet submitted includes the items as indicated above.

Signature



Date

Printed Name


Title

Firm

9/10/2012 2:08:48 PM - P:\09308131-09308-11003\CADD\SHSHEETFILES\C-003-SITE FENCING PLAN.DWG - SHERMAN, JOSHUA

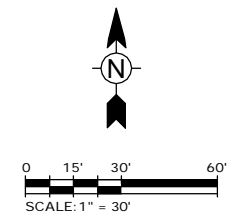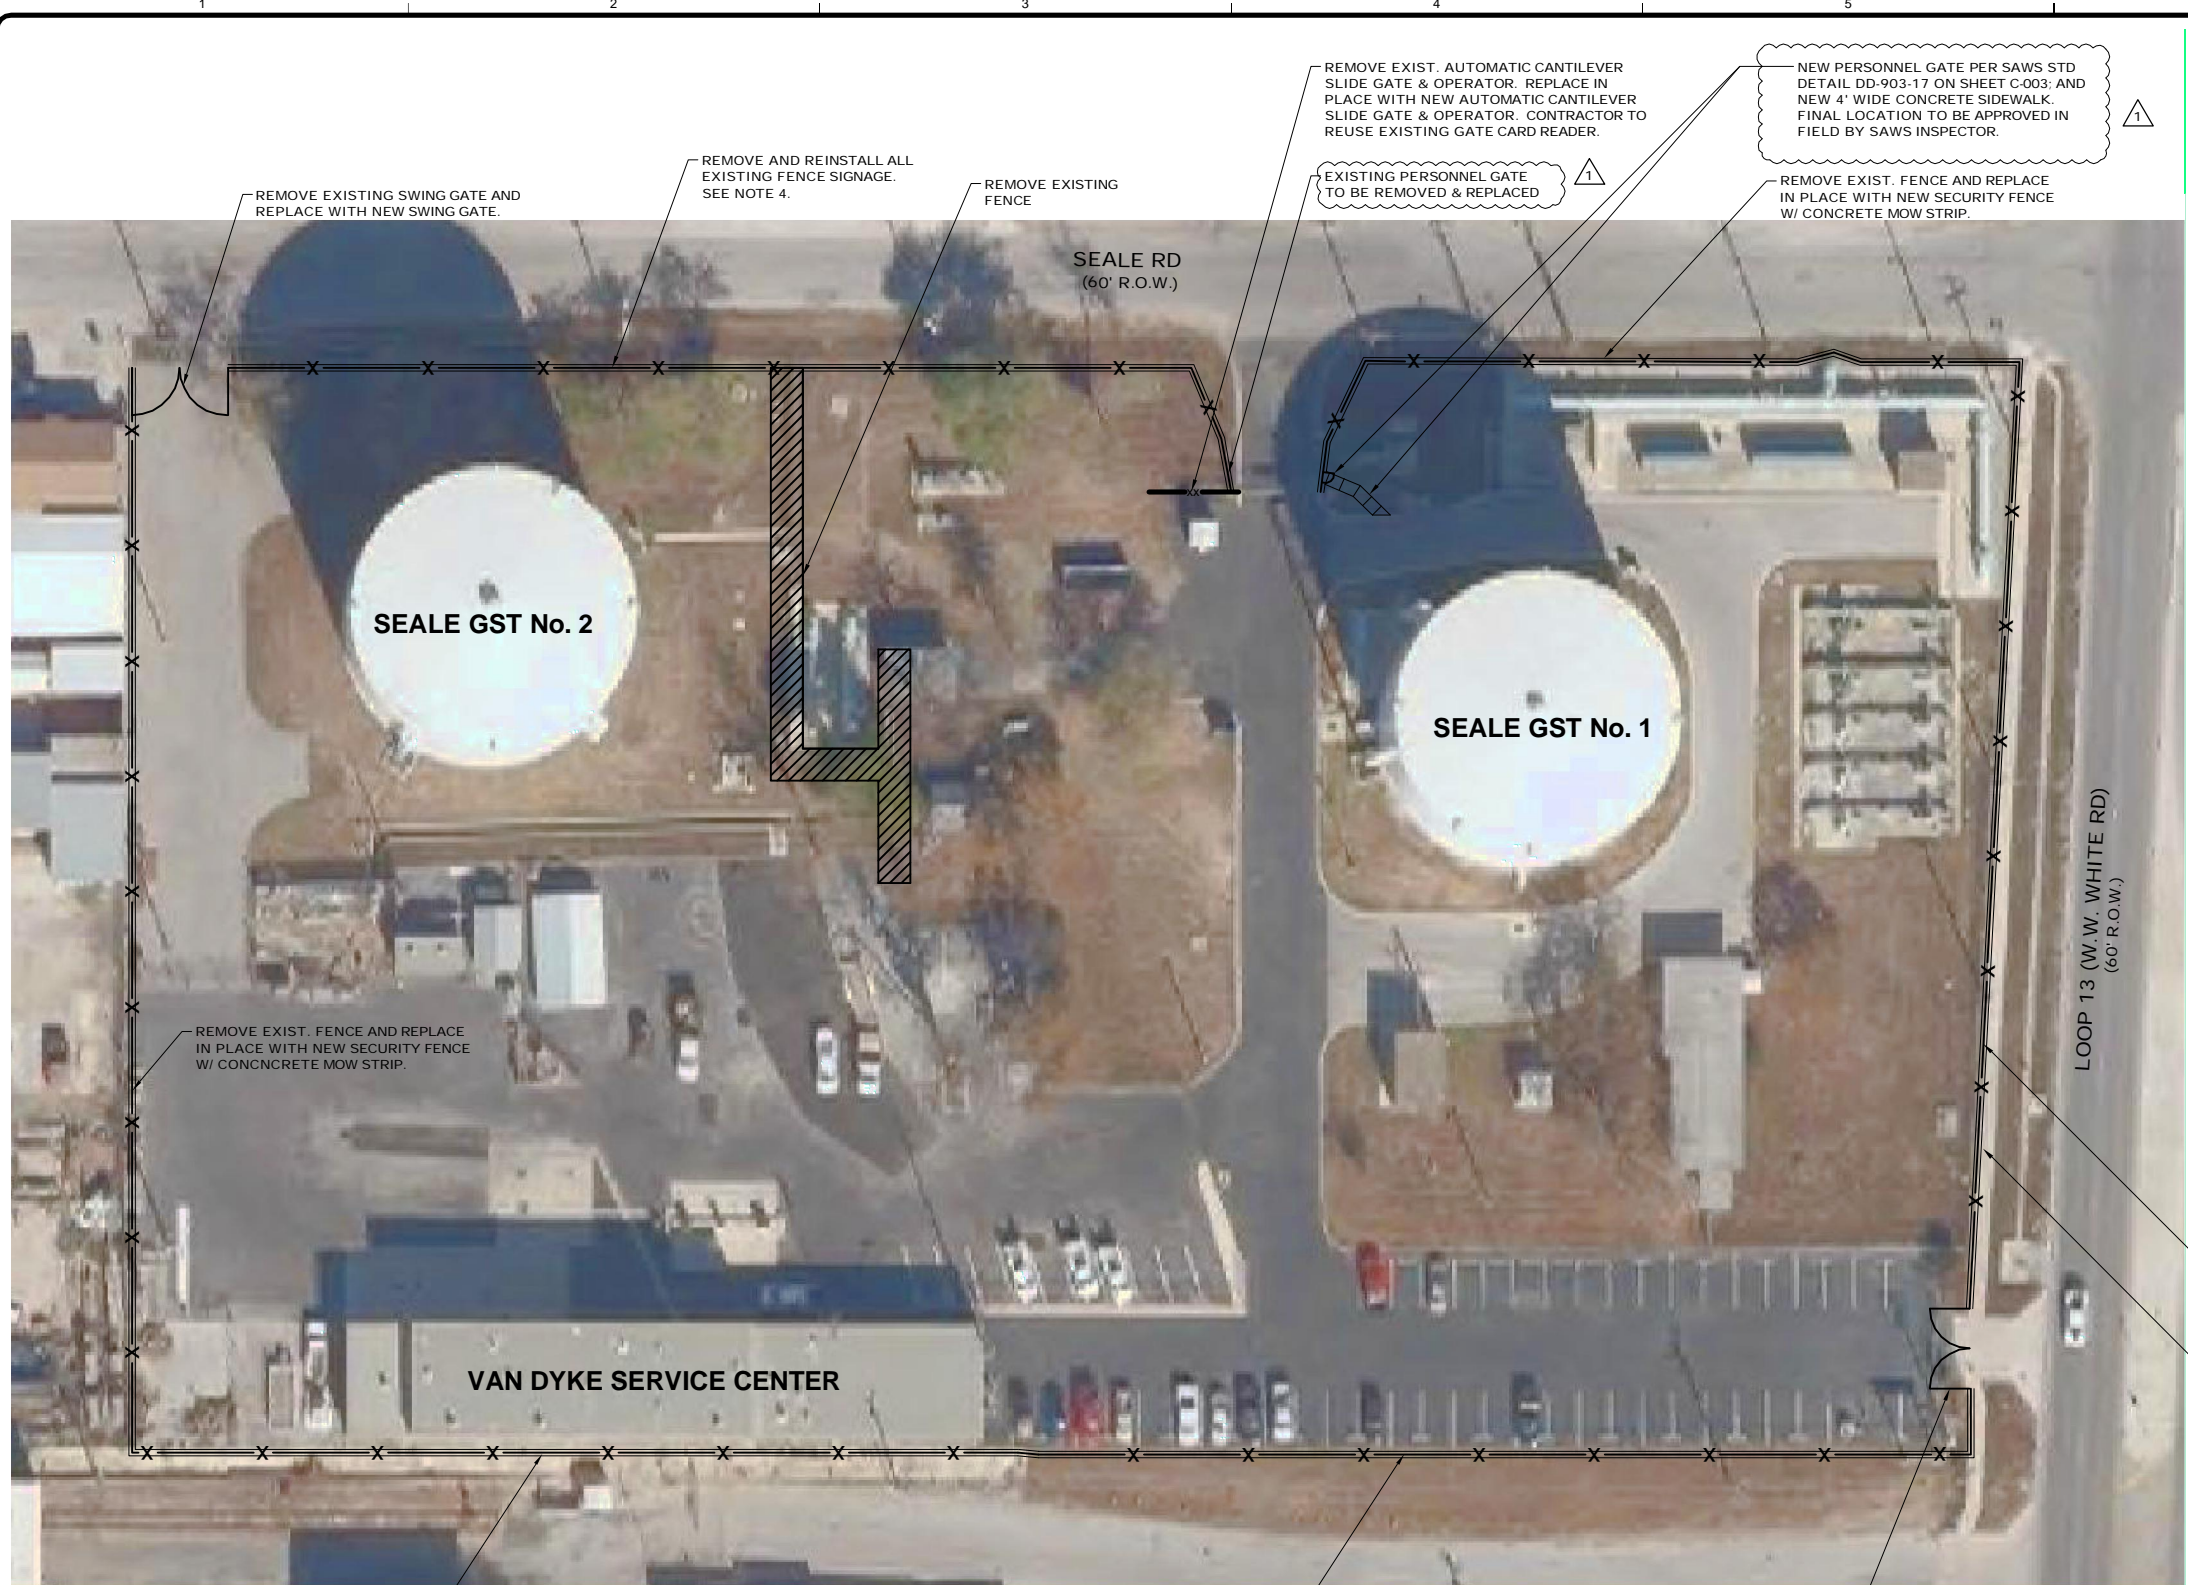

- NOTES:
1. REFER TO SHEETS C-003 AND C-004 FOR FENCING DETAILS.
 2. EXISTING INTERIOR FENCING AND GATES AROUND THE SAWS VAN DYKE SERVICE CENTER SHALL BE PROTECTED AND SHALL REMAIN IN PLACE UNLESS OTHERWISE NOTED.
 3. AT NO TIME SHALL THE SITE BE LEFT UNATTENDED BY THE CONTRACTOR WITHOUT EXISTING, TEMPORARY OR PERMANENT FENCING AND GATES IN PLACE. ALL TEMPORARY AND PERMANENT FENCING SHALL MEET T.C.E.Q. REGULATIONS.
 4. CONTRACTOR SHALL REMOVE ALL EXIST. SIGNS FROM THE FENCE PRIOR TO DEMOLITION & REPLACE ALL SIGNS ON THE NEW FENCE.

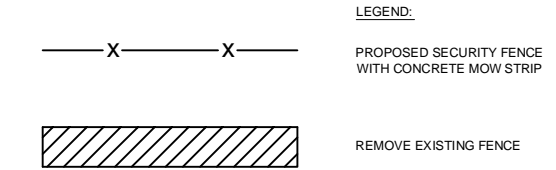

REMOVE EXIST. FENCE AND REPLACE IN PLACE WITH NEW SECURITY FENCE W/ CONCRETE MOW STRIP.

REMOVE EXIST. FENCE AND REPLACE IN PLACE WITH NEW SECURITY FENCE W/ CONCRETE MOW STRIP.

REMOVE EXISTING SWING GATE AND REPLACE WITH NEW SWING GATE.

REMOVE EXIST. FENCE AND REPLACE IN PLACE WITH NEW SECURITY FENCE W/ CONCRETE MOW STRIP.

REMOVE AND REINSTALL ALL EXISTING FENCE SIGNAGE. SEE NOTE 4.

EXISTING PERSONNEL GATE TO BE REMOVED & REPLACED

NEW PERSONNEL GATE PER SAWS STD DETAIL DD-903-17 ON SHEET C-003; AND NEW 4' WIDE CONCRETE SIDEWALK. FINAL LOCATION TO BE APPROVED IN FIELD BY SAWS INSPECTOR.

REMOVE EXIST. FENCE AND REPLACE IN PLACE WITH NEW SECURITY FENCE W/ CONCRETE MOW STRIP.

REMOVE EXIST. AUTOMATIC CANTILEVER SLIDE GATE & OPERATOR. REPLACE IN PLACE WITH NEW AUTOMATIC CANTILEVER SLIDE GATE & OPERATOR. CONTRACTOR TO REUSE EXISTING GATE CARD READER.

REMOVE AND REINSTALL ALL EXISTING FENCE SIGNAGE. SEE NOTE 4.

REMOVE EXISTING FENCE

REMOVE EXISTING SWING GATE AND REPLACE WITH NEW SWING GATE.

TETRA TECH
 Texas Registration No. F-3924
 www.tetratech.com
 700 N. St Mary's, Suite 300
 San Antonio, TX 78205
 Ph: (210) 226-2922 Fax: (210) 226-9497

SAN ANTONIO WATER SYSTEM


MARK	DATE	DESCRIPTION
1	9/11/2012	ADDENDUM No. 2

SAN ANTONIO WATER SYSTEM
 SEALE GROUND STORAGE TANK No. 1
 PAINTING AND REHABILITATION PROJECT
SITE FENCING PLAN

SAWS Job No.: 11-0107
 Designed By: JAS
 Drawn By: BLE
 Checked By: JRK

C-002

9/10/2012 10:06:53 AM - R:\TETRA TECH\2011 SEALE TANK PAINTING AND REHAB\DRAWINGS\SET\BID SET REV 8-14-12\GRUBB ENGINEERING-E-003 ELECTRICAL DEMOLITION PLAN (REVISED PER ADDENDUM #2).DWG - STEVEN MOUSER

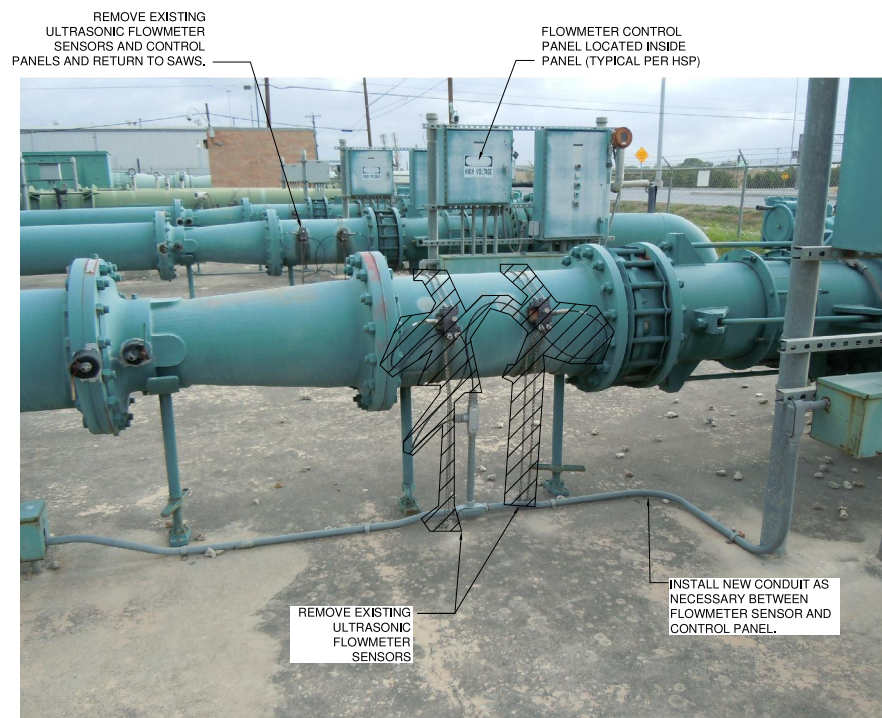


NOTES:
 1. REUSE EXISTING 4-20mA TWISTED PAIR CABLE FOR 4-20mA OUTPUT.
 2. REUSE EXISTING FLOWMETER POWER CIRCUIT FOR NEW FLOWMETER.

A EXISTING HSP # 1, 2 & 3 FLOWMETER DEMOLITION
 SCALE: N.T.S.




NOTES:
 1. REUSE EXISTING 4-20mA TWISTED PAIR CABLE FOR 4-20mA OUTPUT.
 2. REUSE EXISTING FLOWMETER POWER CIRCUIT FOR NEW FLOWMETER.

B EXISTING HSP # 4 & 5 FLOWMETER DEMOLITION
 SCALE: N.T.S.

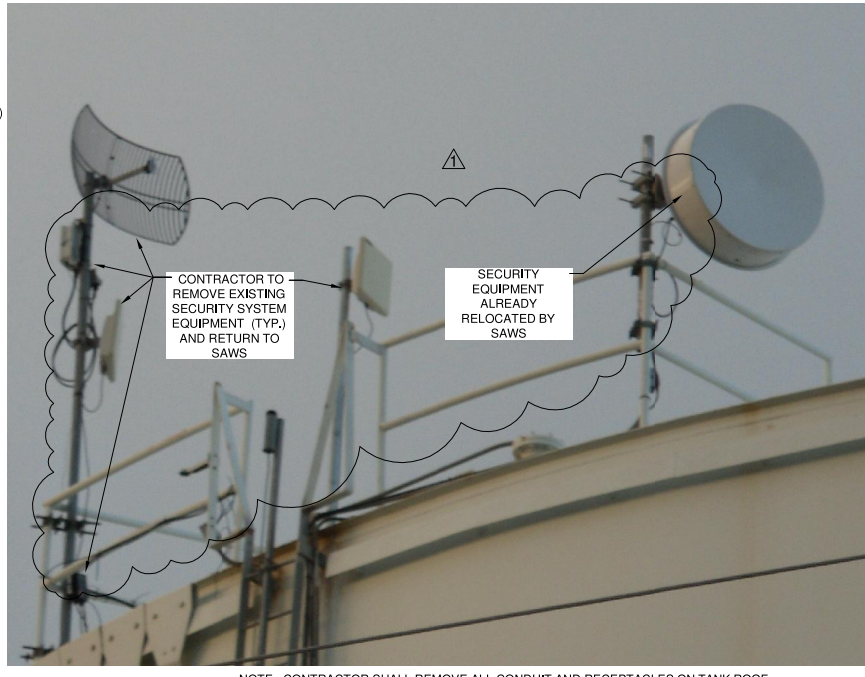

C TANK ROOF DEMOLITION
 SCALE: N.T.S.

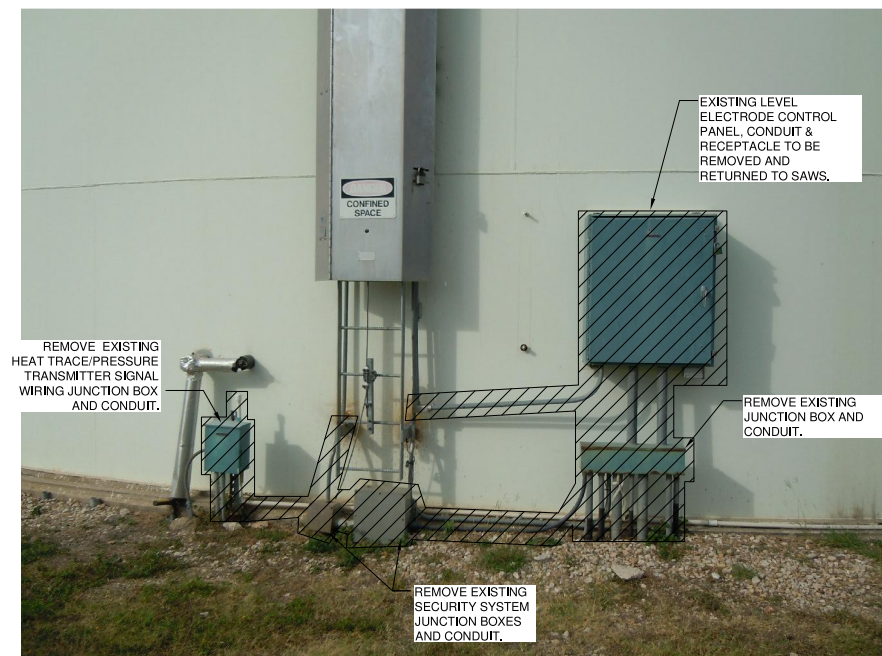


D TANK PANEL DEMOLITION
 SCALE: N.T.S.



E EXISTING TANK RACK DEMOLITION
 SCALE: N.T.S.






TETRA TECH
 www.tetratech.com
 Texas Registration No. F-3924
 700 N. St Mary's, Suite 300
 San Antonio, TX 78205
 Ph (210) 226-2922 Fax (210) 226-9497

GRUBB ENGINEERING, INC.
 ELECTRICAL POWER SYSTEMS
 DESIGN & TESTING
 3128 SIDNEY BROOKS, SAN ANTONIO, TEXAS 78225
 BUS: (210) 658 7250 FAX: (210) 658 8905
 TIRE FIRM REGISTRATION #3964

SAN ANTONIO WATER SYSTEM



MARK	DATE	DESCRIPTION	BY
▲	9/11/12	ADDENDUM #2	SM

SAN ANTONIO WATER SYSTEM
 SEALE GROUND STORAGE TANK NO.1
 PAINTING AND REHABILITATION PROJECT

**ELECTRICAL
 DEMOLITION PLAN**

SAWS Job No.: 11-0107

Designed By: BD

Drawn By: SG

Checked By: SM

E-003

Copyright: Tetra Tech
 Bar Measures 1 inch