

Eastern Sewershed Package IV Project Solicitation Number: CO-00149 Job No.: 17-4527

ADDENDUM 1 April 20, 2018

To Bidder of Record:

This addendum, applicable to work referenced above, is an amendment to the bid proposal, plans and specifications and as such will be a part of and included in the Contract Documents. Acknowledge receipt of this addendum by entering the Addendum number and issue date on the space provided in submitted copies of the bid proposal.

CHANGES TO THE SPECIFICATIONS

- 1. Bid Proposal (BP-2 & BP-3) Remove the bid proposal in its entirety and replace with the attached. This revised version should be used by bidders when submitting a bid for this project. The following items were updated: Item 866 description changed.
- 2. Insert Special Provisions to Technical Specifications (SPTS–5) with attached Special Provisions (SPTS–5). The following items added:
 - a. Item 100 Mobilization
 - b. Item 101 Preparation of Right-of-Way
- 3. Insert the following into special conditions:

Videos are available for download. To access the videos the bidder must complete and submit the Disclaimer form, found at the following link:

http://www.saws.org/business center/ContractSol/Drill.cfm?id=3157&View=Yes

The completed form should be returned to Stella Manzello, Contract Administrator, at Stella.Manzello@saws.org
The password required to view the videos will be provided upon receipt of this form. NOTE: These videos are provided for information purposes only, and are not included in the bid documents. The deterioration is an ongoing process, so the condition at the time of construction may be substantially different from that shown in the videos.

CHANGES TO THE PLANS

- 1. Plan Sheet 2- Replace sheet dated 01/05/2018 with attached sheet 04/11/2018. Updates to plan sheets consist of revisions to pay item no.'s and/or pay item descriptions.
- 2. Plan Sheets 17-55- Replace sheet dated 01/05/2018 with attached sheet 04/11/2018. Updates to plan sheets consist of revisions to pay item no.'s and/or pay item descriptions.

END OF ADDENDUM

This Addendum, including these two pages, is forty-four (45) pages with attachments in its entirety.


Attachments: Bid Proposal, page BP-2 and BP-3

Special Provision to Technical Specifications SPTS-5

Plan sheet 2

Plan sheets 17-55.

Luis Cuellar RPS

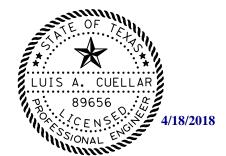



Solicitation No. CO-00149 SAWS Job No 17-4527

Proposal Eastern Sewershed Package IV

| Item No. | Spec No | Specification No. & Description | Unit | Qty | Unit Price | Total Price |
|-----------------|-------------------|---|----------------|-------|--------------|-------------------|
| 1 | COSA- 413.1 | Flowable Fill (Low Strength) | СҮ | 50 | \$ | \$ |
| 2 | COSA- 520 | Hydromulch | SY | 2200 | | |
| 3 | 530.1 | Barricade, Signs, and Traffic Handling | LS | 1 | \$ | \$ |
| 4 | COSA - 540 | Storm Water Pollution Prevention Plan | LS | 1 | \$ | \$ |
| 5 | 550 | Trench Excavation Safety Protection | LF | 130 | \$ | \$ |
| 6 | 851.1 | Manhole Adjustment | EA | 24 | \$ | \$ |
| 7 | 852.1 | Sanitary Sewer Manhole (0-6' Depth) | EA | 1 | \$ | \$ |
| 8 | 852.2 | Sanitary Sewer Manhole (Extra depth Manhole) | VF | 6 | \$ | \$ |
| 9 | 855 | Reconstruction of Existing Manhole | EA | 3 | \$ | \$ |
| 10 | 858 | Concrete Encasement, Cradles, Saddles, and Collars | CY | 17 | \$ | \$ |
| 11 | 864-S2 | Bypass Pumping Large Diameter (Project Location J) | LS | 1 | \$ | \$ |
| 12 | 864-S2 | Bypass Pumping Large Diameter (Project Location K) | LS | 1 | \$ | \$ |
| 13 | 864-S2 | Bypass Pumping Large Diameter (Project Location P) | LS | 1 | \$ | \$ |
| 14 | 864-S2 | Bypass Pumping Large Diameter (Project Location T) | LS | 1 | \$ | \$ |
| 15 | 864-S2 | Bypass Pumping Large Diameter (Project Location Z) | LS | 1 | \$ | \$ |
| 16 | 866 | Sewer Main Television Inspection(18" Through 27") | LF | 11428 | \$ | \$ |
| 17 | 866 | Sewer Main Television Inspection(30" and larger) | LF | 3134 | j | † |
| 3800 | - 1901 | 24-Inch CIPP Sewer Main Rehabilitation (Water Cured) All Depths | Lpw | 11029 | | ywwww. |
| 19 | 901 | 27-Inch CIPP Sewer Main Rehabilitation (Water Cured) All Depths | LF | 399 | \$ | \$ |
| 20 | 901 | 30-Inch CIPP Sewer Main Rehabilitation (Water Cured) All Depths | LF | 1382 | \$ | \$ |
| 21 | 901 | 42-Inch CIPP Sewer Main Rehabilitation (Water Cured) All Depths | LF | 1752 | \$ | \$ |
| 22 | 910.1 | Manhole Rehabilitation | VF | 329 | \$ | \$ |
| 23 | 1103 | 24- Inch Pipe Point Repair , All Depths | EA | 1 | \$ | \$ |
| 24 | 1103 | 27- Inch Pipe Point Repair , All Depths | EA | 1 | \$ | \$ |
| 25 | 1103 | 42- Inch Pipe Point Repair , All Depths | EA | 2 | \$ | \$ |



Solicitation No. CO-00149 SAWS Job No 17-4527

Proposal Eastern Sewershed Package IV

| 26 | 1103.2 | Extra Length Point Repair, 27-Inch Pipe, All Depths | LF | 93 | \$ \$ |
|----|--------|---|----|----|----------|
| 27 | 1103.4 | Obstruction Removal by Remote, 24" Diameter, All Depths | EA | 1 | \$ \$ |
| 28 | 1103.4 | Obstruction Removal by Remote, 42" Diameter, All Depths | EA | 21 | \$ \$ |

Special Provisions to Technical Specifications

- F. Special Provision to Item NO. 100 Mobilization
- **100.2 Measurement: Delete** this section in its entirety
- **100.3** Payment: Delete this section in its entirety and Replace with following:

Mobilization, including cost for insurance and bonds, will not be measured or paid for directly, but shall be included in the unit price bid for the items of construction in which the work occurs.

- G. Special Provision to Item NO. 101 Preparing Right-of-Way
- 101.3 Measurement: Delete this section in its entirety
- 101.4 Payment: Delete this section in its entirety and Replace with following:

Preparing Right-of-Way will not be measured or paid for directly, but shall be included in the unit price bid for the items of construction in which the work occurs.

INDEX OF SHEETS

GENERAL SHEETS

SEWER MAIN COVER SHEET

SANITARY SEWER GENERAL NOTES CPS CAUTION ZONES AND NOTES

SEWER LAYOUT AND CONTROL

INDEX OF DRAWINGS AND SUMMARY OF QUANTITIES

SEWER LAYOUT AND CONTROL PLAN - LINE J & K SEWER LAYOUT AND CONTROL PLAN - LINE P SEWER LAYOUT AND CONTROL PLAN 1 - LINE T SEWER LAYOUT AND CONTROL PLAN 2 - LINE T SEWER LAYOUT AND CONTROL PLAN - LINE Z

SUGGESTED BYPASS AND ACCESS ROUTE

SUGGESTED BYPASS AND ACCESS ROUTE PLAN - J

SUGGESTED BYPASS AND ACCESS ROUTE PLAN 1 - K SUGGESTED BYPASS AND ACCESS ROUTE PLAN 2 - K

SUGGESTED BYPASS AND ACCESS ROUTE PLAN - P SUGGESTED BYPASS AND ACCESS ROUTE PLAN 1 - T

SUGGESTED BYPASS AND ACCESS ROUTE PLAN 2 - T

SEWER PLAN - LINE J - BEGIN TO STA. 13+97

SEWER PLAN - LINE K - BEGIN TO STA. 14+00 SEWER PLAN - LINE K - STA. 14+00 TO STA. 18+00

SEWER PLAN - LINE K - STA. 18+00 TO STA. 21+50 SEWER PLAN - LINE K - STA. 21+50 TO STA. 26+00

SEWER PLAN - LINE K - STA. 26+00 TO STA. 30+00

SEWER PLAN - LINE K - STA. 30+00 TO STA. 34+00

SEWER PLAN - LINE K - STA. 34+00 TO STA. 38+00

SEWER PLAN - LINE K - STA. 38+00 TO END

SEWER PLAN - LINE P - BEGIN TO STA. 14+25

SEWER PLAN - LINE P - STA. 25+80 TO END

SEWER PLAN - LINE T - BEGIN TO STA. 13+50

SEWER PLAN - LINE T - STA. 13+50 TO STA. 17+50

SEWER PLAN - LINE T - STA. 17+50 TO STA. 21+50

SEWER PLAN - LINE T - STA. 21+50 TO STA. 25+50

SEWER PLAN - LINE T - STA. 25+50 TO STA. 29+50

SEWER PLAN - LINE T - STA. 29+50 TO STA. 33+50

SEWER PLAN - LINE T - STA. 33+50 TO STA. 37+50

SEWER PLAN - LINE T - STA. 37+50 TO STA 42+00 SEWER PLAN - LINE T - STA. 42+00 TO STA 46+00

SEWER PLAN - LINE T - STA. 46+00 TO STA 50+00

SEWER PLAN - LINE T - STA. 50+00 TO STA 54+00

SEWER PLAN - LINE T - STA. 54+00 TO STA 58+00

SEWER PLAN - LINE T - STA. 58+00 TO STA 62+00

SEWER PLAN - LINE T - STA. 62+00 TO STA 66+00

SEWER PLAN - LINE T - STA. 66+00 TO STA 70+00

SEWER PLAN - LINE T - STA. 70+00 TO STA 74+00

SEWER PLAN - LINE T - STA. 74+00 TO STA 78+00

SEWER PLAN - LINE T - STA. 78+00 TO STA 82+00

SEWER PLAN - LINE T - STA. 82+00 TO STA 86+00 SEWER PLAN - LINE T - STA. 86+00 TO END

SEWER PLAN - LINE P - STA. 14+25 TO STA. 18+50

SEWER PLAN - LINE P - STA. 18+50 TO STA. 22+80

SEWER PLAN - LINE P - STA. 22+80 TO STA. 25+80

<u>SEWER PLAN - LINE J</u>

SEWER PLAN - LINE K

SEWER PLAN - LINE P

SEWER PLAN - LINE T

SUGGESTED BYPASS AND ACCESS ROUTE PLAN 1 & 2 - Z

SHEET

2

SHEET

SHEET

10

11

12 13

14 15

16

SHEET

17

SHEET

18

19 20

21 22

23

24

25

SHEET

26

27 28

29

30

SHEET

31

32

33

34

35

36

37 38

39 40

41

42

43

44

45

46

47

48 49

| SEWER PLAN - LINE Z | SHEET |
|---|-------|
| SEWER PLAN - LINE Z - BEGIN TO STA 13:00 | 51 |
| SEWER PLAN - LINE Z - STA. 13:00 TO END | 52 |
| SEWER PLAN - LINE Z - BEGIN TO STA. 22:00 | 53 |
| SEWER PLAN - LINE Z - STA, 22:00 TO STA, 26:00 | 54 |
| SEWER PLAN - LINE Z - STA. 26.00 TO STA. END | 55 |
| TREE PRESERVATION PLAN | SHEET |
| TREE PRESERVATION GENERAL NOTES AND DETAILS | 56 |
| TREE PRESERVATION PLAN LINE J & K | 57 |
| TREE PRESERVATION PLAN LINE P | 58 |
| TREE PRESERVATION PLAN LINE T - BEGIN TO STA. 45.00 | 59 |
| TREE PRESERVATION PLAN LINE T - STA. 45:00 TO END | 60 |


TREE PRESERVATION PLAN LINE Z

ESTIMATED QUANTITIES

| Λ | ITEM NO. | DESCRIPTION | UNIT | QUANT. |
|----------|------------------|--|---------------------------------------|------------|
| <u> </u> | ,,,,, ,,, | *************************************** | ~~~ | ~~~~ |
| : | COSA-413.1* | FLOWABLE FILL (LOW STRENGTH) | CY | 50 |
| : | COSA-520* | HYDROMUL CH | SY | 2200 |
| | 530.1 | BARRICADE, SIGNS, AND TRAFFIC HANDLING | LS | 1 |
| | COSA-540 | STORM WATER POLLUTION PREVENTION PLAN | LS | 1 |
| <u> </u> | 550 | TRENCH EXCAVATION SAFETY PROTECTION | LF | 130 |
| | 851.1 | MANHOLE ADJUSTMENT | EA | 24 |
| | 852. 1 | SANITARY SEWER MANHOLE, (0-6' DEPTH) | EA | 1 |
| | 852.2 | SANITARY SEWER MANHOLE, (EXTRA DEPTH MANHOLE) | VF | 6 |
| | 855 | RECONSTRUCTION OF EXISTING MANHOLE | EΑ | . 3 |
| | 858 | CONCRETE ENCASEMENT, CRADLES, SADDLES, AND COLLARS | СҮ | 17 |
| : | 864-SZ | BYPASS PUMPING LARGE DIAMETER (PROJECT LOCATION J) | LS | · 1 |
| ! | { } 864-S2 | BYPASS PUMPING LARGE DIAMETER (PROJECT LOCATION K) | LS | 1 |
| : | } { 864-S2 | BYPASS PUMPING LARGE DIAMETER (PROJECT LOCATION P) | LS | 1 |
| ! | (} 864-S2 | BYPASS PUMPING LARGE DIAMETER (PROJECT LOCATION T) | LS | 1 |
| : | > \ 864-52 | BYPASS PUMPING LARGE DIAMETER (PROJECT LOCATION Z) | L5 | |
| <u> </u> | F | SEWER MAIN TELEVISION INSPECTION (18" THROUGH 27") | LF | 11428 |
| | 866 | . SEWER MAIN TELEVISION INSPECTION (30" AND LARGER) | LF | 3134 |
| | 901 | 24-INCH CIPP SEWER MAIN REHABILITATION (WATER-CURED) ALL | LF | 11029 |
| | } \$ 901 | DEPTHS 27-INCH CIPP SEWER MAIN REHABILITATION (WATER-CURED) ALL | LF | 399 |
| ! | 901 | DEPTHS 30-INCH CIPP SEWER MAIN REHABILITATION (WATER-CURED) ALL | LF | . 1382 |
| : | 901 | DEPTHS 42-INCH CIPP SEWER MAIN REHABILITATION (WATER-CURED) ALL | LF | 1752 |
| | سبب | DEPTHS ANALYSIA STATEMENT OF THE STATEM | VF | 329 |
| | 1103 | 24-INCH PIPE POINT REPAIR, ALL DEPTHS | EΑ | . 1 |
| | 1103 | 27-INCH PIPE POINT REPAIR, ALL DEPTHS | EA | 1 |
| | 1103 | 42-INCH PIPE POINT REPAIR, ALL DEPTHS | EA | . 2 |
| | 1103. 2 | EXTRA LENGTH POINT REPAIR, 27-INCH PIPE, ALL DEPTHS | ۸۸۸۰۰۰۰۰۰۰۰۰۰۰۰۰۰۰۰۰۰۰۰۰۰۰۰۰۰۰۰۰۰۰۰۰۰ | حميم 93 |
| <u> </u> | 1103.4 | OBSTRUCTION REMOVAL BY REMOTE, 24" DIAMETER, ALL DEPTHS | EA | <u></u> |
| | 1103, 4 | OBSTRUCTION REMOVAL BY REMOTE, 42" DIAMETER, ALL DEPTHS | EA | . 21 |
| | | SEE SHEET 3 CENERAL NOTES, ADDITIONAL NOTE 16. | • | |



THE SEAL APPEARING ON THIS DOCUMENT WAS AUTHORIZED BY LUIS A. CUELLAR P.E. 89656 04/11/2018

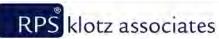

4801 NW Loop 410, Suite 910, San Antonio, Texas 78229 T 210.736.0425 • email@klotz.com • Texas PE Firm Reg. #F-929

| = | REVISI | ONS | | |
|-----|------------------------------|-------|----------|--------|
| No. | Revision | Drawn | Approved | Date |
| | | | | |
| - | | | | |
| | | | | |
| M | UPDATED BID ITEM DESCRIPTION | JP | LC | 4/11/1 |

EASTERN SEWERSHED PACKAGE IV

INDEX AND QUANTITIES


SAN ANTONIO WATER SYSTEM BUDGET PROJ

SUBMITTED 1/5/2018 APPROVED .

MAP No.

SHEET SHEET: 2 OF 61 JOB No. 17-4527

SAWS LEGEND REHABILITATE SANITARY SEWER MH LINE/R.O.W EXISTING SANITARY SEWER REHABILITATE — 8" SS — SANITARY SEWER PROPOSED NEW EXISTING \odot ----6" W----WATER MAIN SANITARY SEWER MH EXISTING EXISTING SANITARY SEWER MH STORM SEWER SUGGESTED EXISTING ____ 2" G ___ ACCESS ROUTE GAS SUGGESTED EXISTING OVERHEAD BYPASS ROUTE ELECTRIC EXISTING SAWS <--x--x FENCE EASEMENT EXISTING 100 YR \rightarrow RAILROAD FLOODPLAIN

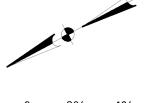





THE SEAL APPEARING ON THIS DOCUMENT WAS AUTHORIZED BY LUIS A. CUELLAR P.E. 89656 04/11/2018

Ra. anh

RPS klotz associates

4801 NW Loop 410, Suite 910, San Antonio, Texas 78229 T 210.736,0425 • email@klotz.com • Texas PE Firm Reg. #F-929

| | REVISI | ONS | | |
|-----|------------------------------|-------|----------|--------|
| No. | Revision | Drawn | Approved | Date |
| | | | | |
| | | | | |
| Δ | UPDATED BID ITEM DESCRIPTION | JP | LC | 4/11/1 |

| 2 |
|--------|
| \sim |
| |

PACKAGE IV

SEWER PLAN - LINE J BEGIN TO STA. 13+97

DEVELOPER: SAN ANTONIO WATER SYSTEM
CONT. BUDGET PROJ.

SUBMITTED 1/5/2018
APPROVED

 MAP No.
 SHEET:
 17 OF 61
 17

 DR. GP CK.
 JOB No. 17-4527
 17


NOTES

- THE EXISTING UNDERGROUND UTILITIES SHOWN ON THESE PLANS ARE BASED UPON RECORDED INFORMATION ONLY AND ARE APPROXIMATE. THE EXACT LOCATION OF ALL EXISTING UNDERGROUND UTILITIES SHALL BE FIELD VERIFIED BY THE CONTRACTOR. THE CONTRACTOR SHALL CONTACT TEXAS STATE WIDE ONE CALL (811) PRIOR TO THE BEGINNING OF WORK. CONTRACTOR SHALL TAKE FULL RESPONSIBILITY FOR ALL AND ANY DAMAGES THAT MICHI OCCUR BY HIS FAILURE TO ACCURATELY LOCATE ALL EXISTING UNDERGROUND UTILITIES AND PRESERVE
- 2 ALL CONSTRUCTION ACTIVITY SHALL BE MAINTAINED WITHIN THE SAWS EASEMENT UNLESS A TEMPORARY CONSTRUCTION EASEMENT, AGREEMENT, OR RIGHT OF ENTRY PERMITTING IS PROVIDED BY SAWS.
- 3 CONTRACTOR IS RESPONSIBLE FOR MAINTAINING SEWER SERVICE TO EXISTING SEWER MAINS AND SERVICES AT ALL TIMES.
- 4 CONTRACTOR SHALL MAINTAIN VEHICULAR ACCESS THROUGH ALL DRIVEWAYS FOR EMERGENCY ACCESS.
- 5 THE CONTRACTOR SHALL REFER TO THE SEWER LAYOUT AND CONTROL PLAN (SHEETS 4-9) FOR APPROXIMATE LOCATION OF 100 YEAR FLOODPLAIN.
- 6 PROPERTY LINES SHOWN ARE APPROXIMATE.

ESTIMATED QUANTITIES

| ITEM NO. | DESCRIPTION | UNIT | QUANT. |
|----------|---|------|--------|
| 851.1 | MANHOLE ADJUSTMENT | EA | 2 |
| 866 | SEWER MAIN TELEVISION INSPECTION (18" THROUGH 27") | LF | 399 |
| 901 | 27-INCH CIPP SEWER WAIN REHABILITATION (WATER-CURED) ALL DEPTHS | LF | 399 |
| 910.1 | MANHOLE REHABILITATION | VF | 22.5 |
| 1103 | 27-INCH PIPE POINT REPAIR, ALL DEPTHS | EA | 1 |
| ξ 1103.2 | EXTRA LENGTH POINT REPAIR, 27-INCH PIPE, ALL DEPTHS | LF | 93 |

12/2018 9:01:40 AM \007555 2017 Pipelines En

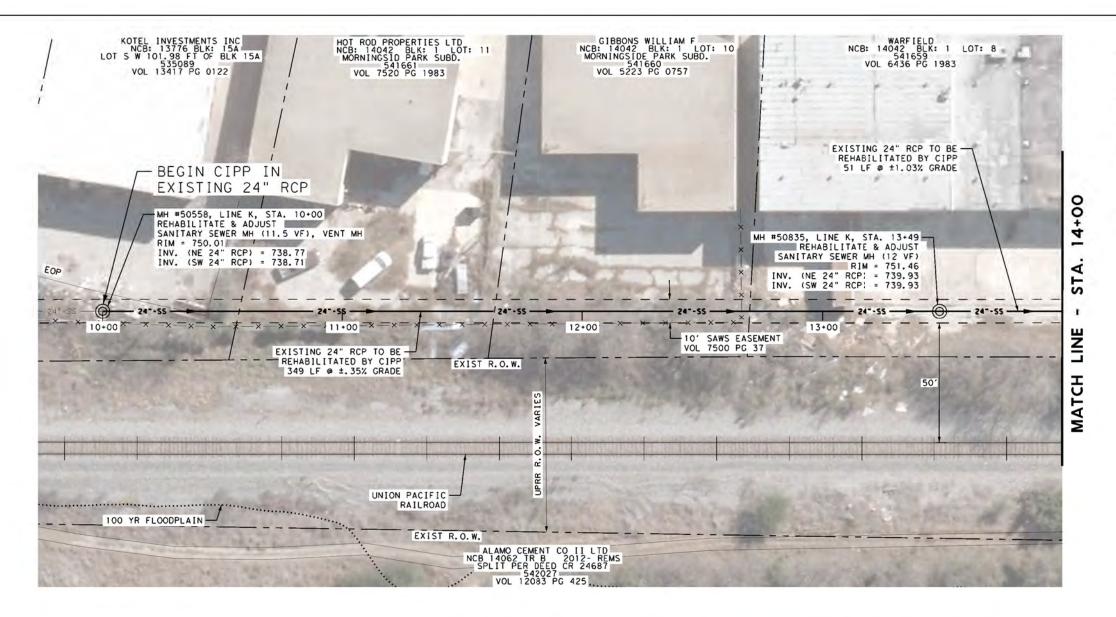

SAWS LEGEND REHABILITATE SANITARY SEWER MH LINE/R.O.W. EXISTING SANITARY SEWER REHABILITATE — 8" SS — SANITARY SEWER PROPOSED NEW EXISTING \odot ----6" W----WATER MAIN SANITARY SEWER MH EXISTING EXISTING SANITARY SEWER MH STORM SEWER SUGGESTED EXISTING ____ 2" G___ ACCESS ROUTE GAS SUGGESTED EXISTING OVERHEAD BYPASS ROUTE ELECTRIC EXISTING SAWS <--x--x FENCE EASEMENT EXISTING 100 YR \rightarrow RAILROAD FLOODPLAIN







THE SEAL APPEARING ON THIS DOCUMENT WAS AUTHORIZED BY LUIS A. CUELLAR P.E. 89656 04/11/2018

klotz associates

4801 NW Loop 410, Suite 910, San Antonio, Texas 78229 T 210.736.0425 • email@klotz.com • Texas PE Firm Reg. #F-929

| | | Approved | |
|----------------------------------|----|----------|--------|
| | | | |
| UPDATED BID ITEM DESCRIPTION | JP | LC | 4/11/1 |

| 27501 | 14 |
|-------|----------|
| | \vdash |
| 1115 | |

EASTERN SEWERSHED PACKAGE IV

SEWER PLAN - LINE K BEGIN TO STA. 14+00

DEVELOPER. SAN ANTONIO WATER SYSTEM BUDGET PROJ

SUBMITTED 1/5/2018


APPROVED MAP No.

SHEET SECT. No. SHEET: 18 OF 61 18 DR. GP CK. JOB No. 17-4527

NOTES

- THE EXISTING UNDERGROUND UTILITIES SHOWN ON THESE PLANS ARE BASED UPON RECORDED INFORMATION ONLY AND ARE APPROXIMATE. THE EXACT LOCATION OF ALL EXISTING UNDERGROUND UTILITIES SHALL BE FIELD VERIFIED BY THE CONTRACTOR. THE CONTRACTOR SHALL CONTACT TEXAS STATE WIDE ONE CALL (811) PRIOR TO THE BEGINNING OF WORK. CONTRACTOR SHALL TAKE FULL RESPONSIBILITY FOR ALL AND ANY DAMAGES THAT MICHI OCCUR BY HIS FAILURE TO ACCURATELY LOCATE ALL EXISTING UNDERGROUND UTILITIES AND PRESERVE
- 2 ALL CONSTRUCTION ACTIVITY SHALL BE MAINTAINED WITHIN THE SAWS EASEMENT UNLESS A TEMPORARY CONSTRUCTION EASEMENT, AGREEMENT, OR RIGHT OF ENTRY PERMITTING IS PROVIDED BY SAWS.
- CONTRACTOR IS RESPONSIBLE FOR MAINTAINING SEWER SERVICE TO EXISTING SEWER MAINS AND SERVICES AT ALL TIMES.
- 4 CONTRACTOR SHALL MAINTAIN VEHICULAR ACCESS THROUGH ALL DRIVEWAYS FOR EMERGENCY ACCESS.
- 5 THE CONTRACTOR SHALL REFER TO THE SEWER LAYOUT AND CONTROL PLAN (SHEETS 4-9) FOR APPROXIMATE LOCATION OF 100 YEAR FLOODPLAIN.
- 6 PROPERTY LINES SHOWN ARE APPROXIMATE.
- 7 CONTRACTOR SHALL VENT MANHOLES AT MINIMUM EVERY 1500 LF. VENTED MANHOLES ARE IDENTIFIED IN PLANS.

| ITEM NO. | DESCRIPTION | | UNIT | QUANT. |
|----------|-----------------------------------|----------------------------------|------|--------|
| 851.1 | THEMPOLE ADJUSTMENT | | EA | 2 |
| 866 | | NSPECTION (18" THROUGH 27") | LF | 400 |
| A (901 | 24-INCH CIPP SEWER MAIN DEPTHS | REHABILITATION (WATER-CURED) ALL | LF | 400 |
| 10.10 | MANHOLE REHABILITATION | | VF | 23.5 |

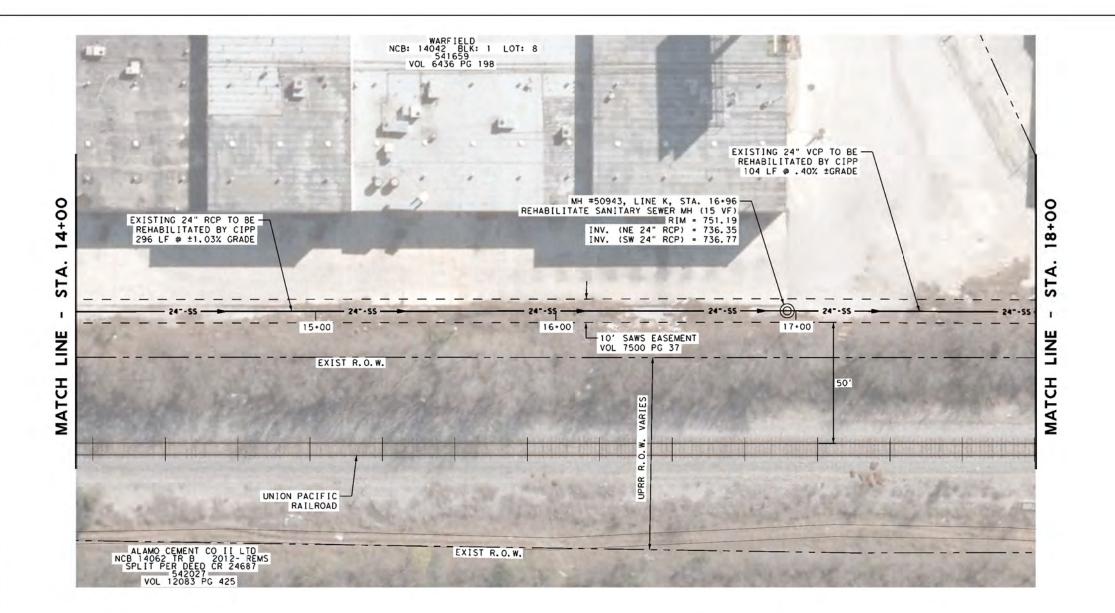

REHABILITATE SANITARY SEWER MH LINE/R.O.W. REHABILITATE EXISTING SANITARY SEWER — 8" SS— SANITARY SEWER PROPOSED NEW EXISTING \odot ----6" W----WATER MAIN SANITARY SEWER MH EXISTING EXISTING SANITARY SEWER MH STORM SEWER SUGGESTED EXISTING ____ 2" G___ ACCESS ROUTE GAS SUGGESTED EXISTING OVERHEAD BYPASS ROUTE ELECTRIC EXISTING SAWS <--x--x FENCE EASEMENT EXISTING 100 YR \rightarrow RAILROAD FLOODPLAIN

SAWS LEGEND







THE SEAL APPEARING ON THIS DOCUMENT WAS AUTHORIZED BY LUIS A. CUELLAR P.E. 89656 04/11/2018

RPS klotz associates

4801 NW Loop 410, Suite 910, San Antonio, Texas 78229 T 210.736,0425 • email@klotz.com • Texas PE Firm Reg. #F-929

| No. | Revision | Drawn | Approved | Date |
|----------|------------------------------|-------|----------|--------|
| | | | | |
| | | | | |
| <u> </u> | UPDATED BID ITEM DESCRIPTION | JP | LC | 4/11/1 |

EASTERN SEWERSHED PACKAGE IV

SEWER PLAN - LINE K STA. 14+00 TO STA. 18+00

DEVELOPER: SAN ANTONIO WATER SYSTEM

CONT. BUDGET PROJ.

SUBMITTED 1/5/2018
APPROVED

MAP No. SHEET: 19 OF 61 19


DR. GP CK. JOB No. 17-4527

ESTIMATED QUANTITIES

| ITEM NO. | DESCRIPTION | UNIT | QUANT. |
|-----------|---|------|--------|
| . 866 | SEWER MAIN TELEVISION INSPECTION (18" THROUGH 27") | LF | 400 |
| A (901) | 24-INCH CIPP SEWER WAIN REHABILITATION (WATER-CURED) ALL DEPTHS | LF | 400 |
| 1 2010.1 | MANHOLE REHABILITATION | VF | 15 |

NOTES

- THE EXISTING UNDERGROUND UTILITIES SHOWN ON THESE PLANS ARE BASED UPON RECORDED INFORMATION ONLY AND ARE APPROXIMATE. THE EXACT LOCATION OF ALL EXISTING UNDERGROUND UTILITIES SHALL BE FIELD VERIFIED BY THE CONTRACTOR. THE CONTRACTOR SHALL CONTACT TEXAS STATE WIDE ONE CALL (811) PRIOR TO THE BEGINNING OF WORK. CONTRACTOR SHALL TAKE FULL RESPONSIBILITY FOR ALL AND ANY DAMAGES THAT MICHI OCCUR BY HIS FAILURE TO ACCURATELY LOCATE ALL EXISTING UNDERGROUND UTILITIES AND PRESERVE
- 2 ALL CONSTRUCTION ACTIVITY SHALL BE MAINTAINED WITHIN THE SAWS EASEMENT UNLESS A TEMPORARY CONSTRUCTION EASEMENT, AGREEMENT, OR RIGHT OF ENTRY PERMITTING IS PROVIDED BY SAWS.
- 3 CONTRACTOR IS RESPONSIBLE FOR MAINTAINING SEWER SERVICE TO EXISTING SEWER MAINS AND SERVICES AT ALL TIMES.
- 4 CONTRACTOR SHALL MAINTAIN VEHICULAR ACCESS THROUGH ALL DRIVEWAYS FOR EMERGENCY ACCESS.
- 5 THE CONTRACTOR SHALL REFER TO THE SEWER LAYOUT AND CONTROL PLAN (SHEETS 4-9) FOR APPROXIMATE LOCATION OF 100 YEAR FLOODPLAIN.
- 6 PROPERTY LINES SHOWN ARE APPROXIMATE.

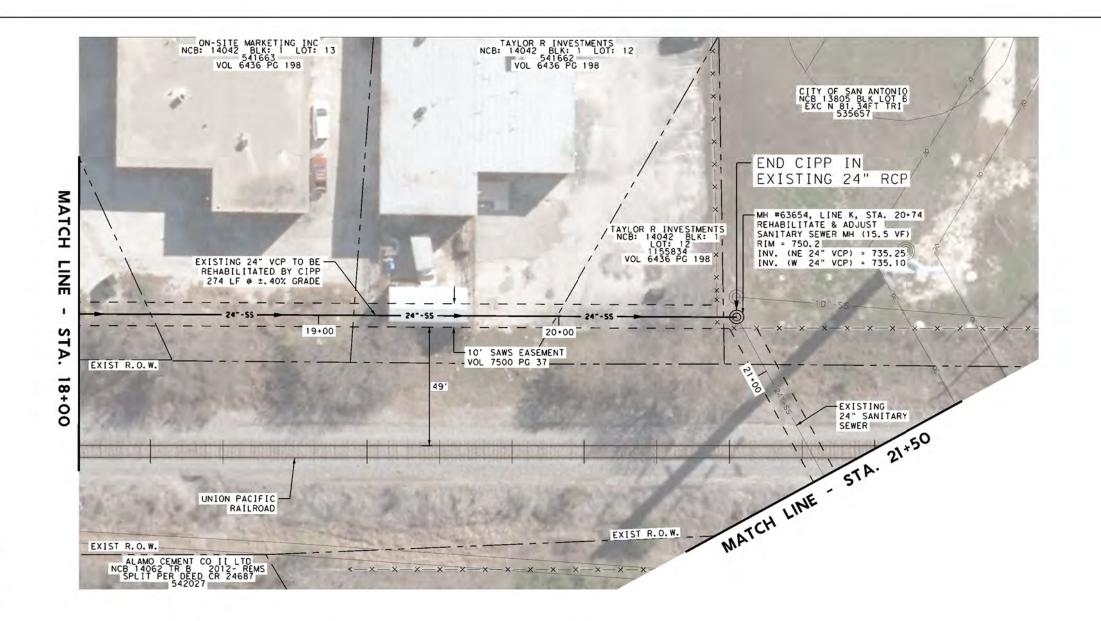

| | _ | |
|--|---------------|--------|
| ITEM NO. DESCRIPTION | UNIT | QUANT. |
| | | |
| 851.1 MANHOLE ADJUSTMENT | EA | 1 |
| 866 SEWER MAIN TELEVISION INSPECTION (18" THROUGH 27") | LF | 274 |
| \\\\\\\\\\\\\\\\\\\\\\\\\\\\\\\\\\\\\\ | $\sim\sim$ | \sim |
| 901 24-INCH CIPP SEWER MAIN REHABILITATION (WATER-CURED) ALL | LF | 274 |
| /\ | $\overline{}$ | |
| 910.1 MANHOLE REHABILITATION | VF | 15.5 |

| ITEM NO. | DESCRIPTION | UNIT | QUANT. |
|----------|---|------|--------|
| | | | |
| 851.1 | MANHOLE ADJUSTMENT | EA | 1 |
| 866 | SEWER MAIN TELEVISION INSPECTION (18" THROUGH 27") | LF | 274 |
| 901 | 24-INCH CIPP SEWER MAIN REHABILITATION (WATER-CURED) ALL DEPTHS | LF | 274 |
| 910.1 | MANHOLE REHABILITATION | VF | 15.5 |



SAWS LEGEND

 \odot

......

LINE/R.O.W.

EXISTING

EXISTING

EXISTING

ELECTRIC EXISTING

EXISTING

RAILROAD

FENCE

GAS

WATER MAIN

STORM SEWER

EXISTING OVERHEAD

EXISTING SANITARY SEWER

— 8" SS—

----6" W----

____ 2" G___

<--x--x

 \rightarrow

REHABILITATE SANITARY SEWER MH

REHABILITATE

PROPOSED NEW

EXISTING

SUGGESTED

SUGGESTED

EASEMENT

FLOODPLAIN

100 YR

SAWS


ACCESS ROUTE


BYPASS ROUTE


SANITARY SEWER

SANITARY SEWER MH

SANITARY SEWER MH

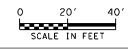

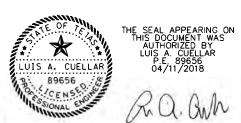

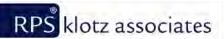

4801 NW Loop 410, Suite 910, San Antonio, Texas 78229 T 210.736.0425 • email@klotz.com • Texas PE Firm Reg. #F-929

| No. | Revision | Drawn | Approved | Date |
|-----|-----------------------------|-------|----------|----------|
| | | | | |
| | | | | |
| + | | | | |
| | PDATED BID ITEM DESCRIPTION | JP | rc | 47.117.1 |

| | T |
|--------|---|
| | |
| > (50) | |
| | |
| O O | 1 |

CONT

APPROVED

EASTERN SEWERSHED PACKAGE IV

SEWER PLAN - LINE K STA. 18+00 TO STA. 21+50

SAN ANTONIO WATER SYSTEM DEVELOPER.


BUDGET PROJ.

SUBMITTED 1/5/2018

MAP No. SHEET SECT. No. SHEET: 20 OF 61 20 DR. MN CK. JOB No. 17-4527


NOTES


- THE EXISTING UNDERGROUND UTILITIES SHOWN ON THESE PLANS ARE BASED UPON RECORDED INFORMATION ONLY AND ARE APPROXIMATE. THE EXACT LOCATION OF ALL EXISTING UNDERGROUND UTILITIES SHALL BE FIELD VERIFIED BY THE CONTRACTOR. THE CONTRACTOR SHALL CONTACT TEXAS STATE WIDE ONE CALL (811) PRIOR TO THE BEGINNING OF WORK. CONTRACTOR SHALL TAKE FULL RESPONSIBILITY FOR ALL AND ANY DAMAGES THAT MICHI OCCUR BY HIS FAILURE TO ACCURATELY LOCATE ALL EXISTING UNDERGROUND UTILITIES AND PRESERVE
- 2 ALL CONSTRUCTION ACTIVITY SHALL BE MAINTAINED WITHIN THE SAWS EASEMENT UNLESS A TEMPORARY CONSTRUCTION EASEMENT, AGREEMENT, OR RIGHT OF ENTRY PERMITTING IS PROVIDED BY SAWS.
- CONTRACTOR IS RESPONSIBLE FOR MAINTAINING SEWER SERVICE TO EXISTING SEWER MAINS AND SERVICES AT ALL TIMES.
- CONTRACTOR SHALL MAINTAIN VEHICULAR ACCESS THROUGH ALL DRIVEWAYS FOR EMERGENCY ACCESS.
- 5 THE CONTRACTOR SHALL REFER TO THE SEWER LAYOUT AND CONTROL PLAN (SHEETS 4-9) FOR APPROXIMATE LOCATION OF 100 YEAR FLOODPLAIN.
- 6 PROPERTY LINES SHOWN ARE APPROXIMATE.

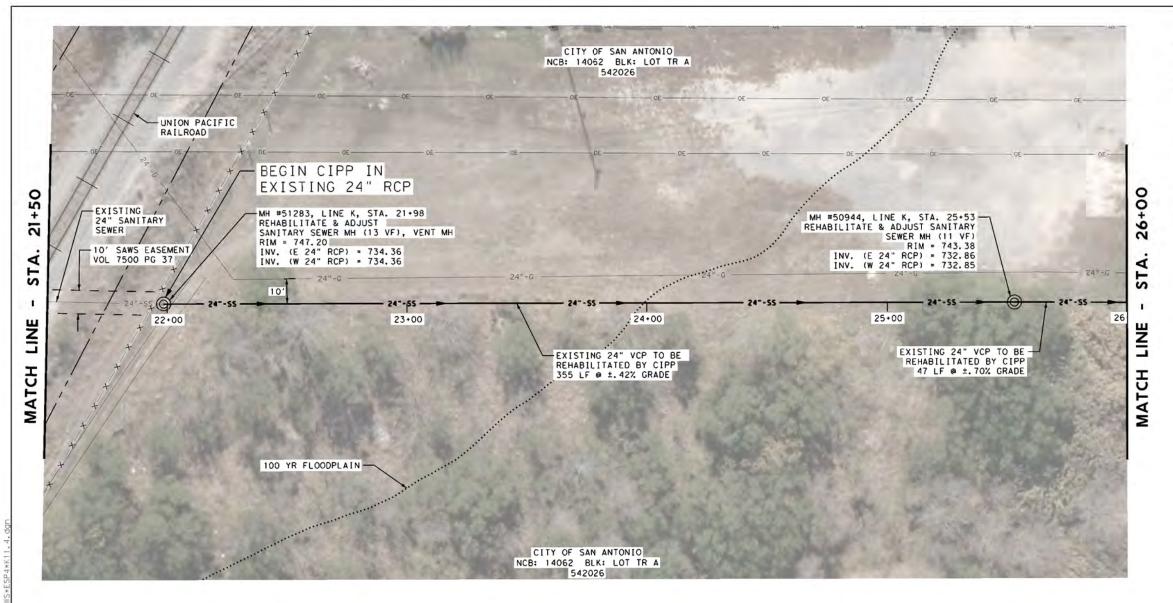


SAWS LEGEND REHABILITATE SANITARY SEWER MH LINE/R.O.W. REHABILITATE EXISTING SANITARY SEWER — 8" SS — SANITARY SEWER PROPOSED NEW EXISTING ----6" W----WATER MAIN SANITARY SEWER MH EXISTING EXISTING SANITARY SEWER MH STORM SEWER SUGGESTED EXISTING ____ 2" G___ ACCESS ROUTE GAS SUGGESTED EXISTING OVERHEAD BYPASS ROUTE ELECTRIC EXISTING SAWS <--x--x FENCE EASEMENT EXISTING 100 YR \rightarrow RAILROAD FLOODPLAIN



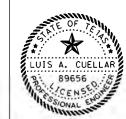

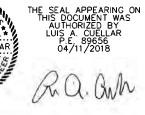

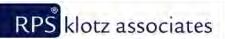

4801 NW Loop 410, Suite 910, San Antonio, Texas 78229 T 210.736.0425 • email@klotz.com • Texas PE Firm Reg. #F-929

| | REVISI | ONS | | |
|-----|------------------------------|-------|----------|------|
| No. | Revision | Drawn | Approved | Date |
| | | | | |
| | | | | |
| | DPDATED BID TTEM DESCRIPTION | | | |

| | T |
|------|---|
| (25) | |
| | ш |
| UUKS | |

EASTERN SEWERSHED PACKAGE IV

SEWER PLAN - LINE K STA. 21+50 TO STA. 26+00

DEVELOPER: SAN ANTONIO WATER SYSTEM BUDGET PROJ

SUBMITTED 1/5/2018 APPROVED

MAP No. SHEET SHEET: 21 OF 61 21 JOB No. 17-4527

NOTES

- THE EXISTING UNDERGROUND UTILITIES SHOWN ON THESE PLANS ARE BASED UPON RECORDED INFORMATION ONLY AND ARE APPROXIMATE. THE EXACT LOCATION OF ALL EXISTING UNDERGROUND UTILITIES SHALL BE FIELD VERIFIED BY THE CONTRACTOR. THE CONTRACTOR SHALL CONTACT TEXAS STATE WIDE ONE CALL (811) PRIOR TO THE BEGINNING OF WORK. CONTRACTOR SHALL TAKE FULL RESPONSIBILITY FOR ALL AND ANY DAMAGES THAT MICHI OCCUR BY HIS FAILURE TO ACCURATELY LOCATE ALL EXISTING UNDERGROUND UTILITIES AND PRESERVE
- 2 ALL CONSTRUCTION ACTIVITY SHALL BE MAINTAINED WITHIN THE SAWS EASEMENT UNLESS A TEMPORARY CONSTRUCTION EASEMENT, AGREEMENT, OR RIGHT OF ENTRY PERMITTING IS PROVIDED BY SAWS.
- CONTRACTOR IS RESPONSIBLE FOR MAINTAINING SEWER SERVICE TO EXISTING SEWER MAINS AND SERVICES AT ALL TIMES.
- 4 CONTRACTOR SHALL MAINTAIN VEHICULAR ACCESS THROUGH ALL DRIVEWAYS FOR EMERGENCY ACCESS.
- 5 THE CONTRACTOR SHALL REFER TO THE SEWER LAYOUT AND CONTROL PLAN (SHEETS 4-9) FOR APPROXIMATE LOCATION OF 100 YEAR FLOODPLAIN.
- 6 PROPERTY LINES SHOWN ARE APPROXIMATE.

| ITEM NO. | DESCRIPTION | UNIT | QUANT. |
|----------|---|------|--------|
| 851.1 | MANHOLE ADJUSTMENT | EA | 2 |
| 866 | SEWER MAIN TELEVISION INSPECTION (18" THROUGH 27") | LF | 402 |
| A { 901 | 24-INCH CIPP SEWER MAIN REHABILITATION (WATER-CURED) ALL DEPTHS | LF | 402 |
| 910.1 | MANHOLE REHABILITATION | VF | 24 |



FENCE EASEMENT EXISTING 100 YR $\overline{}$ RAILROAD FLOODPLAIN

SAWS LEGEND

 \odot

LINE/R.O.W.

EXISTING

EXISTING

EXISTING

ELECTRIC EXISTING

GAS

WATER MAIN

STORM SEWER

EXISTING OVERHEAD

EXISTING SANITARY SEWER

----6" W----

____ 2" G___

<--x--x

REHABILITATE SANITARY SEWER MH

REHABILITATE

PROPOSED NEW

EXISTING

SUGGESTED

SUGGESTED

SAWS


ACCESS ROUTE

BYPASS ROUTE

SANITARY SEWER

SANITARY SEWER MH

SANITARY SEWER MH

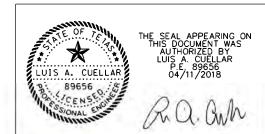

201

SCALE IN FEET

klotz associates

4801 NW Loop 410, Suite 910, San Antonio, Texas 78229 T 210.736.0425 • email@klotz.com • Texas PE Firm Reg. #F-929

| A UPDA | TED BID ITEM DESCRIP | TION JP | LC | 4/11/1 |
|--------|----------------------|---------|----------|--------|
| | | | | |
| | | | | |
| No. | Revision | Drown | Approved | Date |

| 5001 | |
|------|--|
| | |
| | |

EASTERN SEWERSHED PACKAGE IV

SEWER PLAN - LINE K STA. 26+00 TO STA. 30+00

DEVELOPER: SAN ANTONIO WATER SYSTEM BUDGET PROJ


SUBMITTED 1/5/2018 APPROVED

MAP No. SHEET SECT. No. SHEET: 22 OF 61 22 DR. GP CK. JOB No. 17-4527

NOTES


- 1 THE EXISTING UNDERGROUND UTILITIES SHOWN ON THESE PLANS ARE BASED UPON RECORDED INFORMATION ONLY AND ARE APPROXIMATE. THE EXACT LOCATION OF ALL EXISTING UNDERGROUND UTILITIES SHALL BE FIELD VERIFIED BY THE CONTRACTOR. THE CONTRACTOR SHALL CONTACT TEXAS STATE WIDE ONE CALL (811) PRIOR TO THE BEGINNING OF WORK. CONTRACTOR SHALL TAKE FULL RESPONSIBILITY FOR ALL AND ANY DAMACES THAT MICHIOCCUR BY HIS FAILURE TO ACCURATELY LOCATE ALL EXISTING UNDERGROUND UTILITIES AND PRESERVE
- 2 ALL CONSTRUCTION ACTIVITY SHALL BE MAINTAINED WITHIN THE SAWS EASEMENT UNLESS A TEMPORARY CONSTRUCTION EASEMENT, AGREEMENT, OR RIGHT OF ENTRY PERMITTING IS PROVIDED BY SAWS.
- CONTRACTOR IS RESPONSIBLE FOR MAINTAINING SEWER SERVICE TO EXISTING SEWER MAINS AND SERVICES AT ALL TIMES.
- 4 CONTRACTOR SHALL MAINTAIN VEHICULAR ACCESS THROUGH ALL DRIVEWAYS FOR EMERGENCY ACCESS.
- 5 THE CONTRACTOR SHALL REFER TO THE SEWER LAYOUT AND CONTROL PLAN (SHEETS 4-9) FOR APPROXIMATE LOCATION OF 100 YEAR FLOODPLAIN.
- 6 PROPERTY LINES SHOWN ARE APPROXIMATE.

| | ITEM NO. | DESCRIPTION | UNIT | QUANT. |
|------|----------|---|------|--------|
| | | | | |
| | 851.1 | MANHOLE ADJUSTMENT | EA | 1 |
| | 866 | SEWER MAIN TELEVISION INSPECTION (18" THROUGH 27") | LF | 400 |
| ^ (| 901 | 24-INCH CIPP SEWER MAIN REHABILITATION (WATER-CURED) ALL DEPTHS | LF | 400 |
| ₁∖⊥∕ | \sim | | | |
| | 910.1 | MANHOLE REHABILITATION | VF | 9.5 |

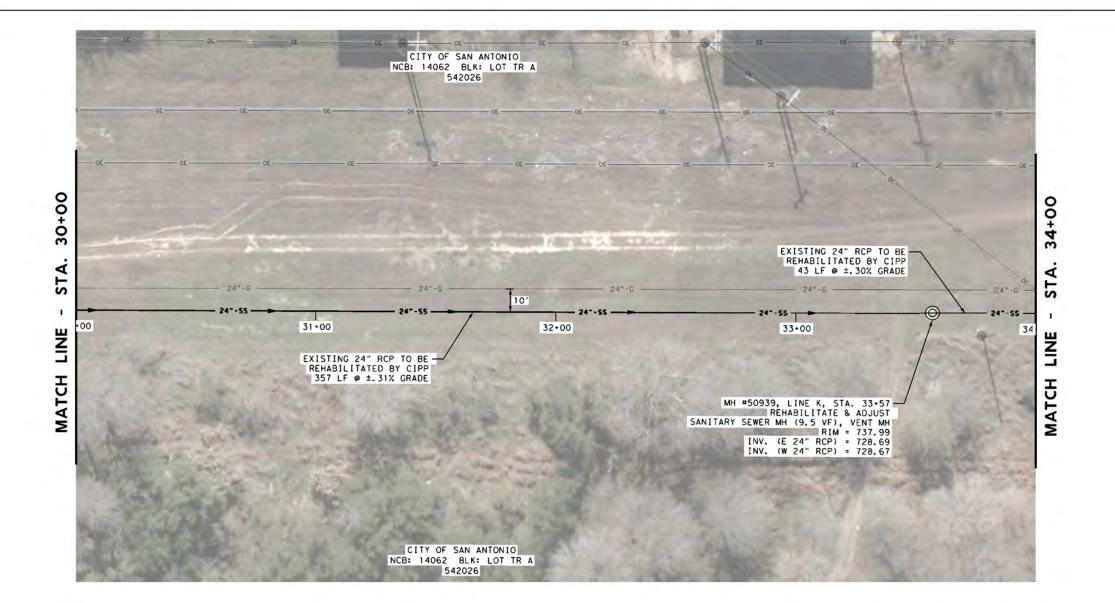

REHABILITATE SANITARY SEWER MH LINE/R.O.W. REHABILITATE EXISTING SANITARY SEWER — 8" SS— SANITARY SEWER PROPOSED NEW EXISTING \odot ----6" W----WATER MAIN SANITARY SEWER MH EXISTING EXISTING SANITARY SEWER MH STORM SEWER SUGGESTED EXISTING ____ 2" G___ ACCESS ROUTE GAS SUGGESTED EXISTING OVERHEAD BYPASS ROUTE ELECTRIC EXISTING SAWS <--x--x FENCE EASEMENT EXISTING 100 YR \rightarrow RAILROAD FLOODPLAIN


SAWS LEGEND

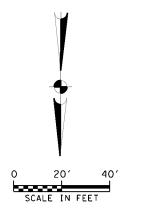



THE SEAL APPEARING ON THIS DOCUMENT WAS AUTHORIZED BY LUIS A. CUELLAR P.E. 89656 04/11/2018

Ra. am

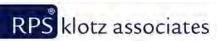

4801 NW Loop 410, Suite 910, San Antonio, Texas 78229 T 210,736,0425 • email@klotz.com • Texas PE Firm Reg. #F-929

| | REVISION | ONS | | |
|-----|------------------------------|-------|----------|--------|
| No. | Revision | Drown | Approved | Date |
| | | | | |
| | | | | |
| Δ | UPDATED BID ITEM DESCRIPTION | JP | LC | 4/11/1 |

| | 1 |
|--------|-----|
| | Ш |
| | ĮL. |
| UUIC 5 | |
| | 11. |

EASTERN SEWERSHED PACKAGE IV

SEWER PLAN - LINE K STA. 30+00 TO STA. 34+00

DEVELOPER: SAN ANTONIO WATER SYSTEM
CONT. BUDGET PROJ.

SUBMITTED 1/5/2018
APPROVED


 MAP No.
 SHEET:
 SHEET:
 23 OF 61
 23

 DR. GP CK.
 JOB No.
 17-4527
 37-4527

NOTES


- THE EXISTING UNDERGROUND UTILITIES SHOWN ON THESE PLANS ARE BASED UPON RECORDED INFORMATION ONLY AND ARE APPROXIMATE. THE EXACT LOCATION OF ALL EXISTING UNDERGROUND UTILITIES SHALL BE FIELD VERIFIED BY THE CONTRACTOR. THE CONTRACTOR SHALL CONTACT TEXAS STATE WIDE ONE CALL (811) PRIOR TO THE BEGINNING OF WORK. CONTRACTOR SHALL TAKE FULL RESPONSIBILITY FOR ALL AND ANY DAMAGES THAT MICHI OCCUR BY HIS FAILURE TO ACCURATELY LOCATE ALL EXISTING UNDERGROUND UTILITIES AND PRESERVE
- 2 ALL CONSTRUCTION ACTIVITY SHALL BE MAINTAINED WITHIN THE SAWS EASEMENT UNLESS A TEMPORARY CONSTRUCTION EASEMENT, AGREEMENT, OR RIGHT OF ENTRY PERMITTING IS PROVIDED BY SAWS.
- 3 CONTRACTOR IS RESPONSIBLE FOR MAINTAINING SEWER SERVICE TO EXISTING SEWER MAINS AND SERVICES AT ALL TIMES.
- 4 CONTRACTOR SHALL MAINTAIN VEHICULAR ACCESS THROUGH ALL DRIVEWAYS FOR EMERGENCY ACCESS.
- 5 THE CONTRACTOR SHALL REFER TO THE SEWER LAYOUT AND CONTROL PLAN (SHEETS 4-9) FOR APPROXIMATE LOCATION OF 100 YEAR FLOODPLAIN.
- 6 PROPERTY LINES SHOWN ARE APPROXIMATE.


| ITEM NO. | DESCRIPTION | UNIT | QUANT. |
|----------|---|------|--------|
| 851.1 | MANHOLE ADJUSTMENT | EA | 1 |
| 866 | SEWER MAIN TELEVISION INSPECTION (18" THROUGH 27") | LF | 400 |
| 801 | 24-INCH CIPP SEWER MAIN REHABILITATION (WATER-CURED) ALL DEPTHS | LF | 400 |
| 910.1 | MANHOLE REHABILITATION | VF | 9.5 |

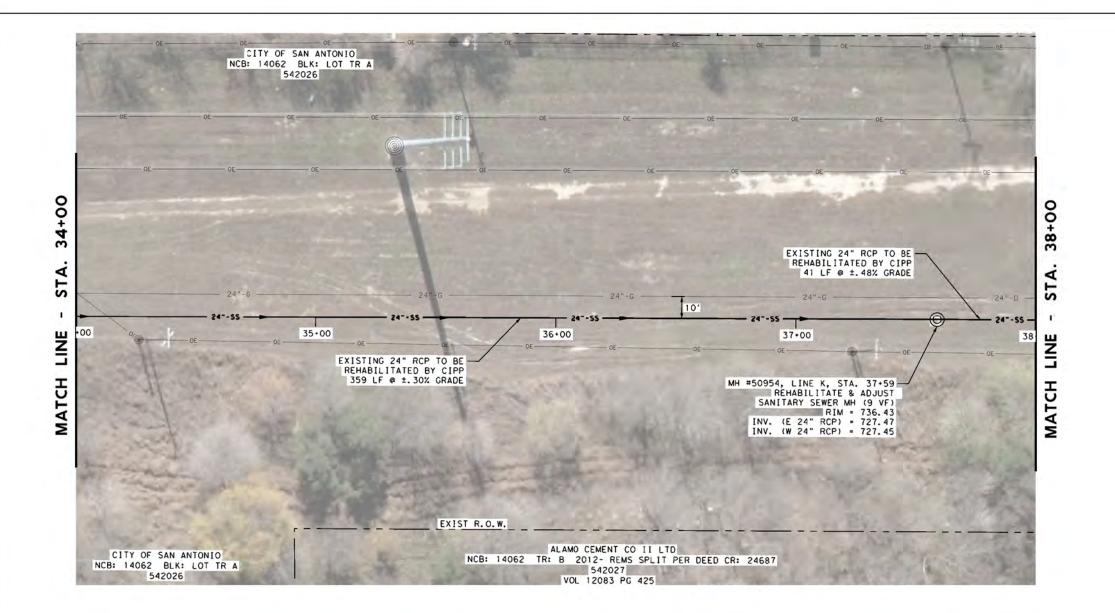

REHABILITATE SANITARY SEWER MH LINE/R.O.W. REHABILITATE EXISTING SANITARY SEWER SANITARY SEWER PROPOSED NEW EXISTING \odot ----6" W----WATER MAIN SANITARY SEWER MH EXISTING EXISTING SANITARY SEWER MH STORM SEWER SUGGESTED EXISTING ____ 2" G___ ACCESS ROUTE GAS SUGGESTED EXISTING OVERHEAD BYPASS ROUTE ELECTRIC EXISTING SAWS <--x--x FENCE EASEMENT EXISTING 100 YR \rightarrow RAILROAD FLOODPLAIN

SAWS LEGEND

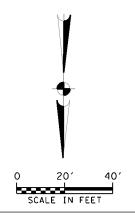

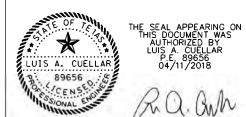

RPS klotz associates

4801 NW Loop 410, Suite 910, San Antonio, Texas 78229 T 210.736,0425 • email@klotz.com • Texas PE Firm Reg. #F-929

| | REVISI | DNS | | |
|-----|------------------------------|-------|----------|--------|
| No. | Revision | Drawn | Approved | Date |
| | | | | |
| | | | | |
| Δ | UPDATED BID ITEM DESCRIPTION | JP | LC | 4/11/1 |

| | 1 |
|-----|------|
| >00 | П |
| | ┥┝ |
| | 7 |
| 00 | 31 6 |

EASTERN SEWERSHED PACKAGE IV

SEWER PLAN - LINE K STA, 34+00 TO STA, 38+00

DEVELOPER: SAN ANTONIO WATER SYSTEM
CONT. BUDGET PROJ.

SUBMITTED 1/5/2018

 APPROVED

 MAP No.
 SHEET:
 SHEET:
 24 OF 61
 24

 DR. GP CK.
 JOB No.
 17-4527
 37-4527


NOTES

- THE EXISTING UNDERGROUND UTILITIES SHOWN ON THESE PLANS ARE BASED UPON RECORDED INFORMATION ONLY AND ARE APPROXIMATE. THE EXACT LOCATION OF ALL EXISTING UNDERGROUND UTILITIES SHALL BE FIELD VERIFIED BY THE CONTRACTOR. THE CONTRACTOR SHALL CONTACT TEXAS STATE WIDE ONE CALL (811) PRIOR TO THE BEGINNING OF WORK. CONTRACTOR SHALL TAKE FULL RESPONSIBILITY FOR ALL AND ANY DAMAGES THAT MICHT OCCUR BY HIS FAILURE TO ACCURATELY LOCATE ALL EXISTING UNDERGROUND UTILITIES AND PRESERVE
- 2 ALL CONSTRUCTION ACTIVITY SHALL BE MAINTAINED WITHIN THE SAWS EASEMENT UNLESS A TEMPORARY CONSTRUCTION EASEMENT, AGREEMENT, OR RIGHT OF ENTRY PERMITTING IS PROVIDED BY SAWS.
- 3 CONTRACTOR IS RESPONSIBLE FOR MAINTAINING SEWER SERVICE TO EXISTING SEWER MAINS AND SERVICES AT ALL TIMES.
- 4 CONTRACTOR SHALL MAINTAIN VEHICULAR ACCESS THROUGH ALL DRIVEWAYS FOR EMERGENCY ACCESS.
- 5 THE CONTRACTOR SHALL REFER TO THE SEWER LAYOUT AND CONTROL PLAN (SHEETS 4-9) FOR APPROXIMATE LOCATION OF 100 YEAR FLOODPLAIN.
- 6 PROPERTY LINES SHOWN ARE APPROXIMATE.


| ITEM NO. | DESCRIPTION | | UNIT | QUANT. |
|----------------|------------------------|------------------------------------|------|--------|
| 851 . 1 | MANHOLE ADJUSTMENT | | EA | 1 |
| 866 | | INSPECTION (18" THROUGH 27") | LF | 400 |
| 901 | | N REHABILITATION (WATER-CURED) ALL | LF | 400 |
| 910.1 | MANHOLE REHABILITATION | | VF | 9 |

REHABILITATE SANITARY SEWER MH LINE/R.O.W. REHABILITATE EXISTING SANITARY SEWER SANITARY SEWER PROPOSED NEW EXISTING \odot ----6" W----WATER MAIN SANITARY SEWER MH EXISTING EXISTING SANITARY SEWER MH STORM SEWER SUGGESTED EXISTING ____ 2" G___ ACCESS ROUTE GAS SUGGESTED EXISTING OVERHEAD BYPASS ROUTE ELECTRIC EXISTING SAWS <--x--x FENCE EASEMENT EXISTING 100 YR \rightarrow RAILROAD FLOODPLAIN

SAWS LEGEND

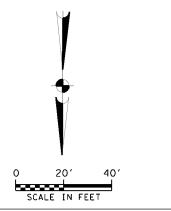



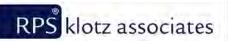

4801 NW Loop 410, Suite 910, San Antonio, Texas 78229 T 210.736.0425 • email@klotz.com • Texas PE Firm Reg. #F-929

| | DATED BID ITEM DESCRIPT | | | |
|-----|-------------------------|-------|----------|------|
| | | | | |
| No. | Revision | Drown | Approved | Date |

| | | | 1 |
|----|-----|----|----|
| 7 | 75 | 70 | ш |
| h | ı N | _ | 41 |
| 10 | UK | - | ₹1 |

EASTERN SEWERSHED PACKAGE IV

SEWER PLAN - LINE K STA. 38+00 TO END

DEVELOPER: SAN ANTONIO WATER SYSTEM

CONT. BUDGET PROJ.

SUBMITTED 1/5/2018

 APPROVED


 MAP No.
 SHEET:
 SHEET:
 25 OF 61
 25

 DR. GP CK.
 JOB No.
 17-4527
 37-4527

NOTES

- THE EXISTING UNDERGROUND UTILITIES SHOWN ON THESE PLANS ARE BASED UPON RECORDED INFORMATION ONLY AND ARE APPROXIMATE. THE EXACT LOCATION OF ALL EXISTING UNDERGROUND UTILITIES SHALL BE FIELD VERIFIED BY THE CONTRACTOR. THE CONTRACTOR SHALL CONTACT TEXAS STATE WIDE ONE CALL (811) PRIOR TO THE BEGINNING OF WORK. CONTRACTOR SHALL TAKE FULL RESPONSIBILITY FOR ALL AND ANY DAMAGES THAT MICHT OCCUR BY HIS FAILURE TO ACCURATELY LOCATE ALL EXISTING UNDERGROUND UTILITIES AND PRESERVE
- 2 ALL CONSTRUCTION ACTIVITY SHALL BE MAINTAINED WITHIN THE SAWS EASEMENT UNLESS A TEMPORARY CONSTRUCTION EASEMENT, AGREEMENT, OR RIGHT OF ENTRY PERMITTING IS PROVIDED BY SAWS.
- 3 CONTRACTOR IS RESPONSIBLE FOR MAINTAINING SEWER SERVICE TO EXISTING SEWER MAINS AND SERVICES AT ALL TIMES.
- 4 CONTRACTOR SHALL MAINTAIN VEHICULAR ACCESS THROUGH ALL DRIVEWAYS FOR EMERGENCY ACCESS.
- 5 THE CONTRACTOR SHALL REFER TO THE SEWER LAYOUT AND CONTROL PLAN (SHEETS 4-9) FOR APPROXIMATE LOCATION OF 100 YEAR FLOODPLAIN.
- 6 PROPERTY LINES SHOWN ARE APPROXIMATE.

| ITEM NO. | DESCRIPTION | | UNIT | QUANT. |
|----------|------------------------|------------------------------------|------|--------|
| 851.1 | MANHOLE ADJUSTMENT | | EA | 1 |
| 866 | | INSPECTION (18" THROUGH 27") | LF | 310 |
| A (901 | | N REHABILITATION (WATER-CURED) ALL | LF | 310 |
| 910.1 | MANHOLE REHABILITATION | | VF | 12.5 |

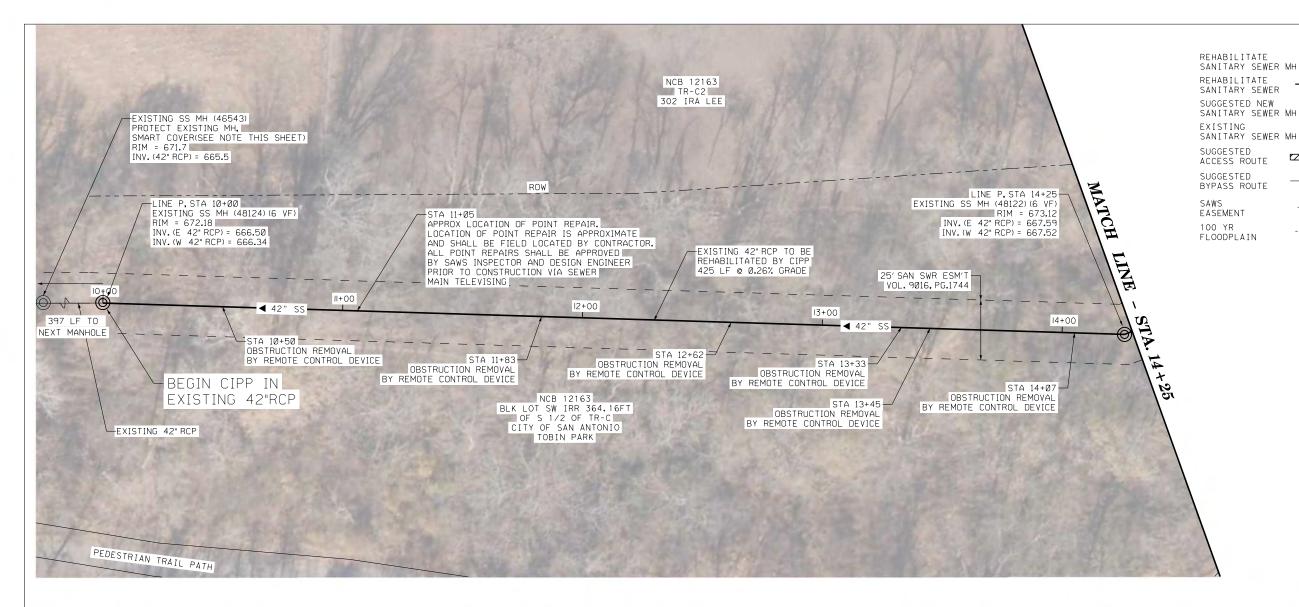

PROP 42" CIPP SEGMENT 998872 - 425 L.F.


NOIE: NOTIFY JEFF SUPPLEE AT 210-233-3569 A MINIMUM OF 72 HOURS, NOT COUNTING WEEKENDS OR SAWS HOLIDAYS, BEFORE WORKING ON THE PIPE OR MANHOLE, IN ORDER TO HAVE SAWS REMOVE THE SMART COVER/FLOW METER ANY DAMAGE DONE TO THE SMART COVER/FLOW METER WILL BE CHARGED TO THE CONTRACTOR.

<u>NOTES</u>

- THE EXISTING UNDERGROUND UTILITIES SHOWN ON THESE PLANS ARE BASED UPON RECORDED INFORMATION ONLY AND ARE APPROXIMATE. THE EXACT LOCATION OF ALL EXISTING UNDERGROUND UTILITIES SHALL BE FIELD VERTFIED BY THE CONTRACTOR. THE CONTRACTOR SHALL ALSO CONTACT THE UTILITY SURVEYORS BEFORE BEGINNING WORK. CONTRACTOR SHALL TAKE FULL RESPONSIBILITY FOR ALL AND ANY DAMAGES THAT MIGHT OCCUR BY HIS FAILURE TO ACCURATELY LOCATE ALL EXISTING UNDERGROUND UTILITIES AND PRESERVE EXISTING CONDITIONS.
- 2 ALL CONSTRUCTION ACTIVITY SHALL BE MAINTAINED WITHIN THE SAWS EASEMENT UNLESS A TEMPORARY CONSTRUCTION EASEMENT, AGREEMENT, OR RIGHT OF ENTRY PERMITTING IS PROVIDED BY SAWS.
- CONTRACTOR IS RESPONIBLE FOR MAINTANING SEWER SERVICE TO EXISTING SEWER MAINS AND SERVICES AT ALL TIMES.
- 4 CONTRACTOR SHALL MAINTAIN VEHICULAR ACCESS THROUGH ALL DRIVEWAYS FOR EMERGENCY ACCESS.
- 5 THE CONTRACTOR SHALL REFER TO THE SEWER LAYOUT AND CONTROL PLAN (SHEETS 4-9) FOR APPROXIMATE LOCATION OF 100 YEAR FLOODPLAIN.
- 6 PROPERTY LINES SHOWN ARE APPROXIMATE.

ESTIMATED QUANTITIES

| | ITEM NO. | DESCRIPTION | UNIT | QUANT. |
|-----|----------|---|------|--------|
| | 866 | SEWER MAIN TELEVISION INSPECTION (30" AND LARGER) | LF | 425 |
| { | 901 | 42-INCH CIPP SEWER MAIN REHABILITATION (WATER-CURED) ALL DEPTHS | LF | 425 |
| \ \ | 1103 | 42-INCH PIPE POINT REPAIR, ALL DEPTHS | EA | 1 |
| 1 | 1103.4 | OBSTRUCTION REMOVAL BY REMOTE DEVICE, 42" DIAMETER, ALL DEPTHS | EA | 6 |
| (| | | | |

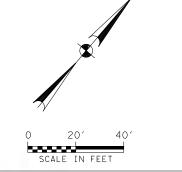



SAWS LEGEND

LINE/R.O.W. EXISTING SANITARY SEWER

EXISTING

EXISTING

EXISTING

ELECTRIC

EXISTING

EXISTING

RAILROAD

FENCE

GAS

WATER MAIN

STORM SEWER

EXISTING OVERHEAD

— 8" SS—

— 6" W —

— 2" G—

 $\leftarrow \times - \times - \times$

The seal appearing on this locument was authorized by P.E. 56996 ON 4/11/2018



BAIN MEDINA BAIN, INC.
ENGINEERS & SURVEYORS
TBPE F-001712
7073 San Pedro
San Antonio, Texas, 78216
Phone: 210-494-7223 Fax: 210-490-5120
WWW.BMBI.COM

| / 🗔 | UPDATED BID ITEM DESCRIPTIONS | Mc | СВ | 4-11-18 | | |
|-------------|-------------------------------|-------|----------|---------|--|--|
| $) \square$ | | | | | | |
| \square | | | | | | |
| | | | | | | |
| | | | | | | |
| No | . Revision | Drawn | Approved | Date | | |
| | REVISIONS | | | | | |

EASTERN SEWERSHED PACKAGE IV

SEWER PLAN - LINE P BEGIN TO STA. 14+25

DEVELOPER: SAN ANTONIO WATER SYSTEM BUDGET PROJ.

CONT. SUBMITTED 1/5/2018

APPROVED MAP No SHEET HEET: 26 OF 61 26 JOB No. 17-4527

PROP 42" CIPP SEGMENT 999937 - 425 L.F.

NOTES

- THE EXISTING UNDERGROUND UTILITIES SHOWN ON THESE PLANS ARE BASED UPON RECORDED INFORMATION ONLY AND ARE APPROXIMATE. THE EXACT LOCATION OF ALL EXISTING UNDERGROUND UTILITIES SHALL BE FIELD VERIFIED BY THE CONTRACTOR, THE CONTRACTOR SHALL ALSO CONTACT THE UTILITY SURVEYORS BEFORE BEGINNING WORK. CONTRACTOR SHALL TAKE FULL RESPONSIBILITY FOR ALL AND ANY DAMAGES THAT MIGHT OCCUR BY HIS FAILURE TO ACCURATELY LOCATE ALL EXISTING UNDERGROUND UTILITIES AND PRESERVE EXISTING CONDITIONS.
- 2 ALL CONSTRUCTION ACTIVITY SHALL BE MAINTAINED WITHIN THE SAWS EASEMENT UNLESS A TEMPORARY CONSTRUCTION EASEMENT, AGREEMENT, OR RIGHT OF ENTRY PERMITTING IS PROVIDED BY SAWS.
- CONTRACTOR IS RESPONIBLE FOR MAINTANING SEWER SERVICE TO EXISTING SEWER MAINS AND SERVICES AT ALL TIMES.
- 4 CONTRACTOR SHALL MAINTAIN VEHICULAR ACCESS THROUGH ALL DRIVEWAYS FOR EMERGENCY ACCESS.
- 5 THE CONTRACTOR SHALL REFER TO THE SEWER LAYOUT AND CONTROL PLAN (SHEETS 4-9) FOR APPROXIMATE LOCATION OF 100 YEAR FLOODPLAIN.
- 6 PROPERTY LINES SHOWN ARE APPROXIMATE.

ESTIMATED QUANTITIES

| | ITEM NO. | DESCRIPTION | UNIT | QUANT. |
|---|----------|---|------|--------|
| | 866 | SEWER MAIN TELEVISION INSPECTION (30" AND LARGER) | LF | 425 |
| (| 901 | 42-INCH CIPP SEWER MAIN REHABILITATION (WATER-CURED) ALL DEPTHS | LF | 425 |
| | 1103 | 42-INCH PIPE POINT REPAIR, ALL DEPTHS | EA | 1 |
| 8 | 1103.4 | OBSTRUCTION REMOVAL BY REMOTE DEVICE, 42" DIAMETER, ALL DEPTHS | EA | 4 |
| | | | | |

SAWS LEGEND

REHABILITATE SANITARY SEWER MH LINE/R.O.W. REHABILITATE EXISTING SANITARY SEWER — 8" SS— SANITARY SEWER SUGGESTED NEW EXISTING — 6" W — SANITARY SEWER MH WATER MAIN EXISTING EXISTING SANITARY SEWER MH STORM SEWER SUGGESTED EXISTING ____2" G____ ACCESS ROUTE GAS SUGGESTED EXISTING OVERHEAD -**●** OE ---BYPASS ROUTE ELECTRIC

SAWS EASEMENT

FLOODPLAIN

100 YR

EXISTING

EXISTING

RAILROAD

FENCE

<--×--×







BAIN MEDINA BAIN, INC.
ENGINEERS & SURVEYORS
TBPE F-001712
7073 San Pedro
San Antonio, Texas, 78216
Phone: 210-494-7223 Fax: 210-490-5120
WWW.BMBI.COM

|) | 1 | UPDATED BID ITEM DESCRIPTIONS | MC | СВ | 4-11-18 | |
|---|-----------|-------------------------------|-------|----------|---------|--|
| 1 | | | | | | |
| | | | | | | |
| | | | | | | |
| | | | | | | |
| | No. | Revision | Drawn | Approved | Date | |
| | REVISIONS | | | | | |

EASTERN SEWERSHED PACKAGE IV

SEWER PLAN - LINE P STA. 14+25 TO STA. 18+50

SAN ANTONIO WATER SYSTEM DEVELOPER: CONT. BUDGET PROJ.

SUBMITTED 1/5/2018 APPROVED

MAP No SHEET HEET: 27 OF 61 27 JOB No. 17-4527

56996

SAWS LEGEND

LINE/R.O.W.

EXISTING

EXISTING

EXISTING

ELECTRIC

EXISTING

EXISTING

RAILROAD

FENCE

GAS

WATER MAIN

STORM SEWER

EXISTING OVERHEAD

EXISTING SANITARY SEWER

— 8" SS—

— 6" W —

—— 2" G—

<--×--×

-**●** OE ---

REHABILITATE SANITARY SEWER MH

REHABILITATE

EXISTING

SUGGESTED

SUGGESTED

SAWS EASEMENT

FLOODPLAIN

100 YR

ACCESS ROUTE

BYPASS ROUTE

SANITARY SEWER SUGGESTED NEW

SANITARY SEWER MH

SANITARY SEWER MH

The seal appearing on this locument was authorized by P.E. 56996 ON 4/11/2018

BAIN MEDINA BAIN, INC.
ENGINEERS & SURVEYORS
TBPE F-001712
7073 San Pedro
San Antonio, Texas, 78216
Phone: 210-494-7223 Fax: 210-490-5120
WWW.BMBI.COM

| 1 | UPDATED BID ITEM DESCRIPTIONS | MC | CB | 4-11-18 | | | |
|-----|-------------------------------|-------|----------|---------|--|--|--|
| | | | | | | | |
| | | | | | | | |
| | | | | | | | |
| | | | | | | | |
| No. | Revision | Drawn | Approved | Date | | | |
| | REVISIONS | | | | | | |

EASTERN SEWERSHED PACKAGE IV

SEWER PLAN - LINE P STA. 18+50 TO STA. 22+80

SHEET

28

SAN ANTONIO WATER SYSTEM DEVELOPER: BUDGET PROJ.

SUBMITTED 1/5/2018

APPROVED MAP No HEET: 28 OF 61 JOB No. 17-4527

PROP 42" CIPP SEGMENT 999937 - 64 L.F. SEGMENT 999463 - 366 L.F.


<u>NOTES</u>

- THE EXISTING UNDERGROUND UTILITIES SHOWN ON THESE PLANS ARE BASED UPON RECORDED INFORMATION ONLY AND ARE APPROXIMATE. THE CONTRACTOR SHALL CONTACT TEXAS STATE WIDE ONE CALL(811) PRIOR TO THE BEGINNING OF WORK. CONTRACTOR SHALL TAKE FULL RESPONSIBILITY FOR ALL AND ANY DAMAGES THAT MIGHT OCCUR BY HIS FAILURE TO ACCURATELY LOCATE ALL EXISTING UNDERGROUND UTILITIES AND PRESERVE EXISTING CONDITIONS.
- ALL CONSTRUCTION ACTIVITY SHALL BE MAINTAINED WITHIN THE SAWS EASEMENT UNLESS A TEMPORARY CONSTRUCTION EASEMENT, AGREEMENT, OR RIGHT OF ENTRY PERMITTING IS PROVIDED BY SAWS.
- 3 CONTRACTOR IS RESPONIBLE FOR MAINTANING SEWER SERVICE TO EXISTING SEWER MAINS AND SERVICES AT ALL TIMES.
- CONTRACTOR SHALL MAINTAIN VEHICULAR ACCESS THROUGH ALL DRIVEWAYS FOR EMERGENCY ACCESS.
- 5 THE CONTRACTOR SHALL REFER TO THE SEWER LAYOUT AND CONTROL PLAN (SHEETS 4-9) FOR APPROXIMATE LOCATION OF 100 YEAR FLOODPLAIN.
- 6 PROPERTY LINES SHOWN ARE APPROXIMATE.

ESTIMATED QUANTITIES

| ^ | ITEM NO. | DESCRIPTION | UNIT | QUANT. |
|---|----------|---|----------|--------|
| 1 | ~~~ | SEWER MAIN TELEVISION INSPECTION (30" AND LARGER) 42-INCH CIPP SEWER MAIN REHABILITATION (WATER-CURED) ALL DEPTHS | LF LF | 430 |
| | | | | |

NOTE:
NOTIFY JEFF SUPPLEE AT 210-233-3569 A MINIMUM OF 72 HOURS,
NOT COUNTING WEEKENDS OR SAWS HOLIDAYS, BEFORE WORKING ON
THE PIPE OR MANHOLE, IN ORDER TO HAVE SAWS REMOVE THE
SMART COVER/FLOW METER ANY DAMAGE DONE TO THE
SMART COVER/FLOW METER WILL BE CHARGED TO THE CONTRACTOR.

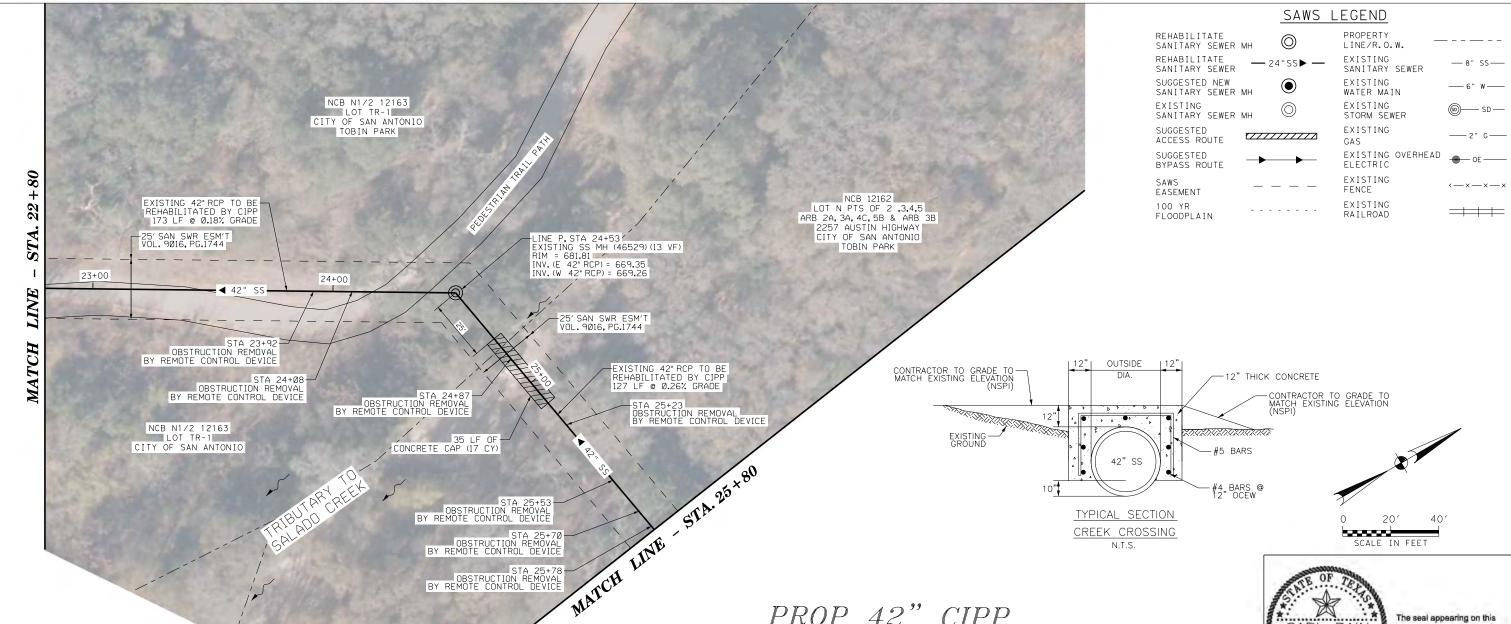

THE EXISTING UNDERGROUND UTILITIES SHOWN ON THESE PLANS ARE BASED UPON RECORDED INFORMATION ONLY AND ARE APPROXIMATE. THE CONTRACTOR SHALL CONTACT TEXAS STATE WIDE ONE CALL(811) PRIOR TO THE BEGINNING OF WORK. CONTRACTOR SHALL TAKE FULL RESPONSIBILITY FOR ALL AND ANY DAMAGES THAT MIGHT OCCUR BY HIS FAILURE TO ACCURATELY LOCATE ALL EXISTING UNDERGROUND UTILITIES AND PRESERVE EXISTING CONDITIONS.

<u>NOTES</u>

- ALL CONSTRUCTION ACTIVITY SHALL BE MAINTAINED WITHIN THE SAWS EASEMENT UNLESS A TEMPORARY CONSTRUCTION EASEMENT, AGREEMENT, OR RIGHT OF ENTRY PERMITTING IS PROVIDED BY SAWS.
- 3 CONTRACTOR IS RESPONIBLE FOR MAINTANING SEWER SERVICE TO EXISTING SEWER MAINS AND SERVICES AT ALL TIMES.
- CONTRACTOR SHALL MAINTAIN VEHICULAR ACCESS THROUGH ALL DRIVEWAYS FOR EMERGENCY ACCESS.
- THE CONTRACTOR SHALL REFER TO THE SEWER LAYOUT AND CONTROL PLAN (SHEETS 4-9) FOR APPROXIMATE LOCATION OF 100 YEAR FLOODPLAIN.
- 6 PROPERTY LINES SHOWN ARE APPROXIMATE.

PROP 42" CIPP SEGMENT 999463 - 173 L.F. SEGMENT 1000498 - 127 L.F.

ESTIMATED QUANTITIES

| | ITEM NO. | DESCRIPTION | UNIT | QUANT. | | | |
|---|----------|---|------|--------|---|--|--|
| | 858 | CONCRETE ENCASEMENT, CRADLES, SADDLES, AND COLLARS | CY | 17 | | | |
| | 866 | SEWER MAIN TELEVISION INSPECTION (30" AND LARGER) | LF | 300 | | | |
| _ | 901 | 42-INCH CIPP SEWER MAIN REHABILITATION (WATER-CURED) ALL DEPTHS | LF | 300 | 1 | | |
| | 1103.4 | OBSTRUCTION REMOVAL BY REMOTE DEVICE, 42" DIAMETER, ALL DEPTHS | EA | 7 | | | |
| | | | | | | | |



locument was authorized by P.E. 56996 ON 4/11/2018



BAIN MEDINA BAIN, INC.
ENGINEERS & SURVEYORS
TBPE F-001712
7073 San Pedro
San Antonio, Texas, 78216
Phone: 210-494-7223 Fax: 210-490-5120
WWW.BMBI.COM

| 1 | UPDATED BID ITEM DESCRIPTIONS | MC | CB | 4-11-18 |
|-----|-------------------------------|-------|----------|---------|
| | | | | |
| | | | | |
| | | | | |
| | | | | |
| No. | Revision | Drawn | Approved | Date |

EASTERN SEWERSHED PACKAGE IV

SEWER PLAN - LINE P STA. 22+80 TO STA. 25+80

SHEET

29

SAN ANTONIO WATER SYSTEM DEVELOPER: CONT. BUDGET PROJ.

SUBMITTED 1/5/2018

APPROVED MAP No SHEET: 29 OF 61 JOB No. 17-4527

20

56996

SAWS LEGEND

LINE/R.O.W. EXISTING SANITARY SEWER

EXISTING

EXISTING

EXISTING

ELECTRIC

EXISTING

EXISTING

RAILROAD

FENCE

GAS

WATER MAIN

STORM SEWER

EXISTING OVERHEAD

— 8" SS—

— 6" W —

____2" G____

<--×--×

-**●** OE ---

REHABILITATE SANITARY SEWER MH

REHABILITATE

SANITARY SEWER

SANITARY SEWER MH

SANITARY SEWER MH

SUGGESTED NEW

EXISTING

SUGGESTED

SUGGESTED

FASEMENT

FLOODPLAIN

100 YR

SAWS

ACCESS ROUTE

BYPASS ROUTE

The seal appearing on this ocument was authorized by P.E. 56996 ON 4/11/2018

BAIN MEDINA BAIN, INC.
ENGINEERS & SURVEYORS
TBPE F-001712
7073 San Pedro
San Antonio, Texas, 78216
Phone: 210-494-7223 Fax: 210-490-5120
WWW.BMBI.COM

| ı | | | | | |
|---|-----|-------------------------------|-------|----------|---------|
| S | 1 | UPDATED BID ITEM DESCRIPTIONS | MC | CB | 4-11-18 |
| N | | | | | |
| 기 | | | | | |
| | | | | | |
| | | | | | |
| ĺ | No. | Revision | Drawn | Approved | Date |

REVISIONS

EASTERN SEWERSHED PACKAGE IV

SEWER PLAN - LINE P STA. 25+80 TO END

DEVELOPER: SAN ANTONIO WATER SYSTEM CONT. BUDGET PROJ.

SUBMITTED 1/5/2018

APPROVED MAP No


SHEET HEET: 30 OF 61 30 JOB No. 17-4527

PROP 42" CIPP SEGMENT 1000498 - 172 L.F.

<u>NOTES</u>

- THE EXISTING UNDERGROUND UTILITIES SHOWN ON THESE PLANS ARE BASED UPON RECORDED INFORMATION ONLY AND ARE APPROXIMATE. THE CONTRACTOR SHALL CONTACT TEXAS STATE WIDE ONE CALL(811) PRIOR TO THE BEGINNING OF WORK. CONTRACTOR SHALL TAKE FULL RESPONSIBILITY FOR ALL AND ANY DAMAGES THAT MIGHT OCCUR BY HIS FAILURE TO ACCURATELY LOCATE ALL EXISTING UNDERGROUND UTILITIES AND PRESERVE EXISTING CONDITIONS.
- ALL CONSTRUCTION ACTIVITY SHALL BE MAINTAINED WITHIN THE SAWS EASEMENT UNLESS A TEMPORARY CONSTRUCTION EASEMENT, AGREEMENT, OR RIGHT OF ENTRY PERMITTING IS PROVIDED BY SAWS.
- 3 CONTRACTOR IS RESPONIBLE FOR MAINTANING SEWER SERVICE TO EXISTING SEWER MAINS AND SERVICES AT ALL TIMES.
- CONTRACTOR SHALL MAINTAIN VEHICULAR ACCESS THROUGH ALL DRIVEWAYS FOR EMERGENCY ACCESS.
- 5 THE CONTRACTOR SHALL REFER TO THE SEWER LAYOUT AND CONTROL PLAN (SHEETS 4-9) FOR APPROXIMATE LOCATION OF 100 YEAR FLOODPLAIN.
- 6 PROPERTY LINES SHOWN ARE APPROXIMATE.

| ^ | ITEM NO. | DESCRIPTION | UNIT | QUANT. | |
|---|----------|---|------|--------|---|
| 1 | 866 | SEWER MAIN TELEVISION INSPECTION (30" AND LARGER) | LF | 172 | |
| > | ~~901~~~ | 42-INCH CIPP SEWER MAIN REHABILITATION (WATER-CURED) ALL DEPTHS | LF | 112 | |
| ξ | 1103.4 | OBSTRUCTION REMOVAL BY REMOTE DEVICE, 42" DIAMETER, ALL DEPTHS | EA | 4 | } |
| ` | | | | | |

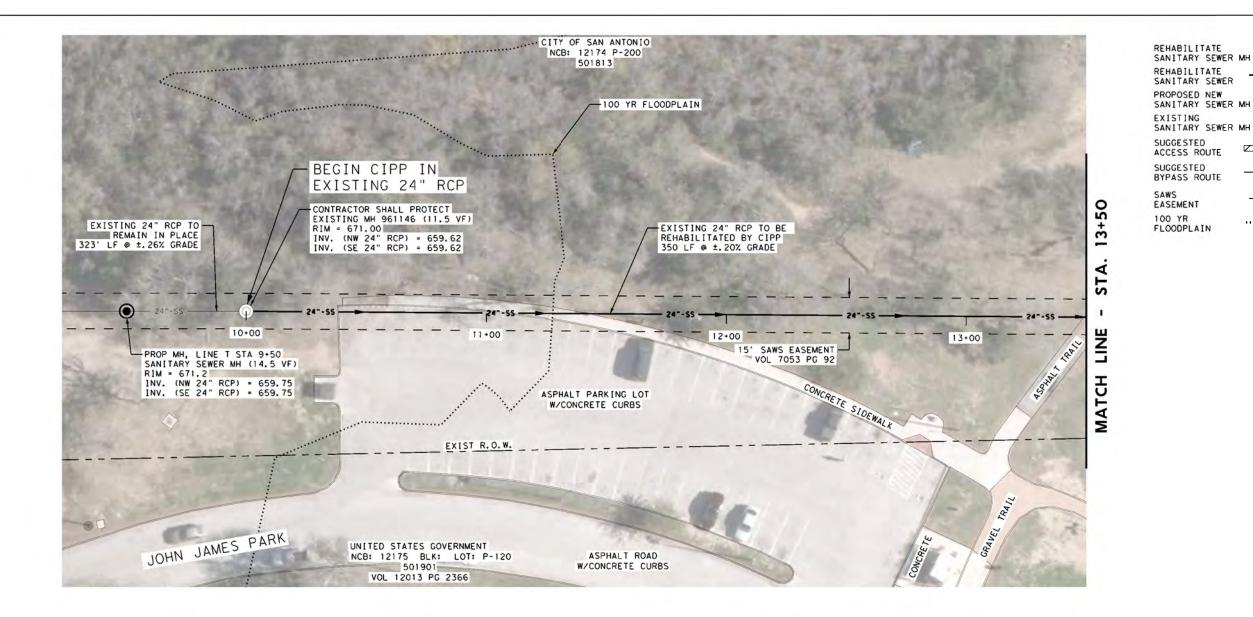

0 20' 40'

SAWS LEGEND

 \odot

......

LINE/R.O.W.

EXISTING

EXISTING

EXISTING

ELECTRIC

EXISTING

EXISTING

RAILROAD

FENCE

GAS

WATER MAIN

STORM SEWER

EXISTING OVERHEAD

EXISTING SANITARY SEWER


— 8" SS —

----6" W----

____ 2" G___

<--x--x

 \rightarrow

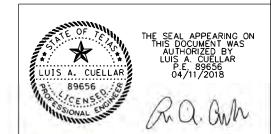

SCALE IN FEET

RPS klotz associates

4801 NW Loop 410, Suite 910, San Antonio, Texas 78229 T 210.736.0425 • email@klotz.com • Texas PE Firm Reg. #F-929

| No. | Revision | Drawn | Approved | Date |
|-----|----------|-------|----------|------|

| 1 | | _ | 1 |
|----|----|----|----|
| 7 | 75 | 0 | Ш |
| hr | | ہے | 31 |
| 10 | U | _5 | 7 |

EASTERN SEWERSHED PACKAGE IV

SEWER PLAN - LINE T BEGIN TO STA. 13+50

DEVELOPER: SAN ANTONIO WATER SYSTEM
CONT. BUDGET PROJ.

SUBMITTED 1/5/2018
APPROVED


 MAP No.
 SHEET:
 31 OF 61
 31

 DR. MN CK.
 JOB No.
 17-4527

NOTES

- THE EXISTING UNDERGROUND UTILITIES SHOWN ON THESE PLANS ARE BASED UPON RECORDED INFORMATION ONLY AND ARE APPROXIMATE. THE EXACT LOCATION OF ALL EXISTING UNDERGROUND UTILITIES SHALL BE FIELD VERIFIED BY THE CONTRACTOR. THE CONTRACTOR SHALL CONTACT TEXAS STATE WIDE ONE CALL (811) PRIOR TO THE BEGINNING OF WORK. CONTRACTOR SHALL TAKE FULL RESPONSIBILITY FOR ALL AND ANY DAMACES THAT MICHIOCCUR BY HIS FAILURE TO ACCURATELY LOCATE ALL EXISTING UNDERGROUND UTILITIES AND PRESERVE
- 2 ALL CONSTRUCTION ACTIVITY SHALL BE MAINTAINED WITHIN THE SAWS EASEMENT UNLESS A TEMPORARY CONSTRUCTION EASEMENT, AGREEMENT, OR RIGHT OF ENTRY PERMITTING IS PROVIDED BY SAWS.
- 3 CONTRACTOR IS RESPONSIBLE FOR MAINTAINING SEWER SERVICE TO EXISTING SEWER MAINS AND SERVICES AT ALL TIMES.
- 4 CONTRACTOR SHALL MAINTAIN VEHICULAR ACCESS THROUGH ALL DRIVEWAYS FOR EMERGENCY ACCESS.
- 5 THE CONTRACTOR SHALL REFER TO THE SEWER LAYOUT AND CONTROL PLAN (SHEETS 4-9) FOR APPROXIMATE LOCATION OF 100 YEAR FLOODPLAIN.
- 6 PROPERTY LINES SHOWN ARE APPROXIMATE.

| ITEM NO. | DESCRIPTION | UNIT | QUANT. |
|----------|---|------|--------|
| 851.1 | MANHOLE ADJUSTMENT | EA | 1 |
| 852.1 | SANITARY SEWER MANHOLE, (0-6' DEPTH) | EA | 1 |
| 852. 2 | SANITARY SEWER MANHOLE, (EXTRA DEPTH MANHOLE) | VF | 6 |
| 866 | SEWER MAIN TELEVISION INSPECTION (18" THROUGH 27") | LF | 350 |
| 901 | 24-INCH CIPP SEWER MAIN REHABILITATION (WATER-CURED) ALL DEPTHS | LF | 350 |
| 910.1 | MANHOLE REHABILITATION | VF | 11.5 |

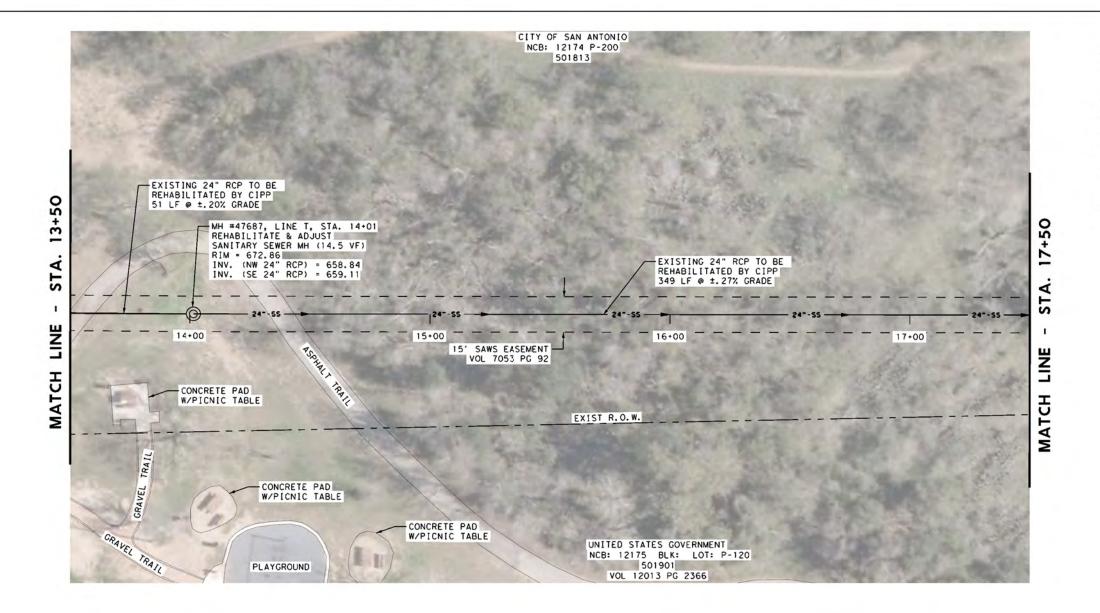


| ITEM | NO. | DESCRIPTION | UNIT | QUANT. |
|------|------|---|------|--------|
| 851 | .1 | MANHOLE ADJUSTMENT | EA | 1 |
| 86 | - | SEWER MAIN TELEVISION INSPECTION (18" THROUGH 27") | LF | 400 |
| 90 | | 24-INCH CIPP SEWER MAIN REHABILITATION (WATER-CURED) ALL DEPTHS | LF | 400 |
| 910 |), 1 | MANHOLE REHABILITATION | VF | 14.5 |


NOTES


- THE EXISTING UNDERGROUND UTILITIES SHOWN ON THESE PLANS ARE BASED UPON RECORDED INFORMATION ONLY AND ARE APPROXIMATE. THE EXACT LOCATION OF ALL EXISTING UNDERGROUND UTILITIES SHALL BE FIELD VERIFIED BY THE CONTRACTOR. THE CONTRACTOR SHALL CONTACT TEXAS STATE WIDE ONE CALL (811) PRIOR TO THE BEGINNING OF WORK. CONTRACTOR SHALL TAKE FULL RESPONSIBILITY FOR ALL AND ANY DAMAGES THAT MICHT OCCUR BY HIS FAILURE TO ACCURATELY LOCATE ALL EXISTING UNDERGROUND UTILITIES AND PRESERVE
- 2 ALL CONSTRUCTION ACTIVITY SHALL BE MAINTAINED WITHIN THE SAWS EASEMENT UNLESS A TEMPORARY CONSTRUCTION EASEMENT, AGREEMENT, OR RIGHT OF ENTRY PERMITTING IS PROVIDED BY SAWS.
- 3 CONTRACTOR IS RESPONSIBLE FOR MAINTAINING SEWER SERVICE TO EXISTING SEWER MAINS AND SERVICES AT ALL TIMES.
- 4 CONTRACTOR SHALL MAINTAIN VEHICULAR ACCESS THROUGH ALL DRIVEWAYS FOR EMERGENCY ACCESS.
- 5 THE CONTRACTOR SHALL REFER TO THE SEWER LAYOUT AND CONTROL PLAN (SHEETS 4-9) FOR APPROXIMATE LOCATION OF 100 YEAR FLOODPLAIN.
- 6 PROPERTY LINES SHOWN ARE APPROXIMATE.

SAWS LEGEND

REHABILITATE SANITARY SEWER MH LINE/R.O.W. REHABILITATE EXISTING SANITARY SEWER — 8" SS— SANITARY SEWER PROPOSED NEW EXISTING ----6" W----WATER MAIN SANITARY SEWER MH EXISTING EXISTING SANITARY SEWER MH STORM SEWER SUGGESTED EXISTING ____ 2" G___ ACCESS ROUTE GAS SUGGESTED EXISTING OVERHEAD BYPASS ROUTE ELECTRIC EXISTING SAWS <--x--x FENCE EASEMENT EXISTING 100 YR \rightarrow RAILROAD FLOODPLAIN

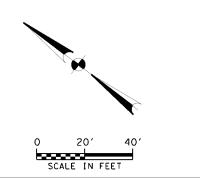

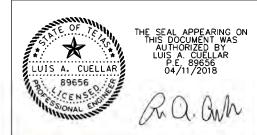

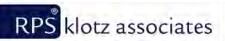

4801 NW Loop 410, Suite 910, San Antonio, Texas 78229 T 210.736,0425 • email@klotz.com • Texas PE Firm Reg. #F-929

| | REVISI | ONS | | |
|-----|------------------------------|-------|----------|--------|
| No. | Revision | Drown | Approved | Date |
| | | | | |
| | | | | |
| Δ | UPDATED BID ITEM DESCRIPTION | JP | LC | 4/11/1 |

| 35) | |
|-----|---|
| MES | S |

EASTERN SEWERSHED PACKAGE IV

SEWER PLAN - LINE T STA. 13+50 TO STA. 17+50

DEVELOPER: SAN ANTONIO WATER SYSTEM
CONT. BUDGET PROJ.

SUBMITTED 1/5/2018
APPROVED


 MAP No.
 SHEET:
 32 OF 61
 32


 DR. MN CK.
 JOB No. 17-4527
 17-4527





| ITEM NO. | DESCRIPTION | | UNIT | QUANT. |
|----------|-------------|------------------------------------|------|--------|
| | | | | |
| 866 | | INSPECTION (18" THROUGH 27") | LF | 400 |
| 901 | | N REHABILITATION (WATER-CURED) ALL | LF | 400 |
| \wedge | | | | |

| ITEM NO. | DESCRIPTION | UNIT | QUANT. |
|----------|---|------|--------|
| 866 | SEWER MAIN TELEVISION INSPECTION (18" THROUGH 27") | LF | 400 |
| 901 | 24-INCH CIPP SEWER MAIN REHABILITATION (WATER-CURED) ALL DEPTHS | LF | 400 |

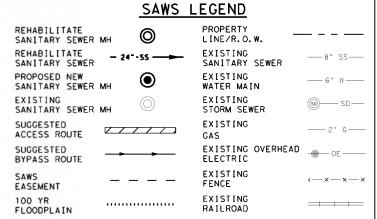

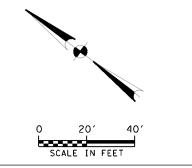

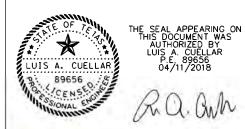

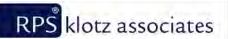

4801 NW Loop 410, Suite 910, San Antonio, Texas 78229 T 210.736.0425 • email@klotz.com • Texas PE Firm Reg. #F-929

| | REVISION | ONS | | |
|-----|------------------------------|-------|----------|---------|
| No. | Revision | Drawn | Approved | Date |
| | | | | |
| | | | | |
| △ | UPDATED BID ITEM DESCRIPTION | JP | LC | 4/11/18 |

| | 1 |
|-----|-----|
| | 1 |
| 500 | 11 |
| | Ų⊢. |
| | - 1 |
| UU |) (|

EASTERN SEWERSHED PACKAGE IV

SEWER PLAN - LINE T STA. 17+50 TO STA. 21+50


SAN ANTONIO WATER SYSTEM DEVELOPER: BUDGET PROJ.

SUBMITTED 1/5/2018 APPROVED

MAP No. SHEET SHEET: 33 OF 61 33 DR. MN CK. JOB No. 17-4527

NOTES

- THE EXISTING UNDERGROUND UTILITIES SHOWN ON THESE PLANS ARE BASED UPON RECORDED INFORMATION ONLY AND ARE APPROXIMATE. THE EXACT LOCATION OF ALL EXISTING UNDERGROUND UTILITIES SHALL BE FIELD VERIFIED BY THE CONTRACTOR. THE CONTRACTOR SHALL CONTACT TEXAS STATE WIDE ONE CALL (811) PRIOR TO THE BEGINNING OF WORK. CONTRACTOR SHALL TAKE FULL RESPONSIBILITY FOR ALL AND ANY DAMAGES THAT MICHI OCCUR BY HIS FAILURE TO ACCURATELY LOCATE ALL EXISTING UNDERGROUND UTILITIES AND PRESERVE
- 2 ALL CONSTRUCTION ACTIVITY SHALL BE MAINTAINED WITHIN THE SAWS EASEMENT UNLESS A TEMPORARY CONSTRUCTION EASEMENT, AGREEMENT, OR RIGHT OF ENTRY PERMITTING IS PROVIDED BY SAWS.
- CONTRACTOR IS RESPONSIBLE FOR MAINTAINING SEWER SERVICE TO EXISTING SEWER MAINS AND SERVICES AT ALL TIMES.
- 4 CONTRACTOR SHALL MAINTAIN VEHICULAR ACCESS THROUGH ALL DRIVEWAYS FOR EMERGENCY ACCESS.
- 5 THE CONTRACTOR SHALL REFER TO THE SEWER LAYOUT AND CONTROL PLAN (SHEETS 4-9) FOR APPROXIMATE LOCATION OF 100 YEAR FLOODPLAIN.
- 6 PROPERTY LINES SHOWN ARE APPROXIMATE.

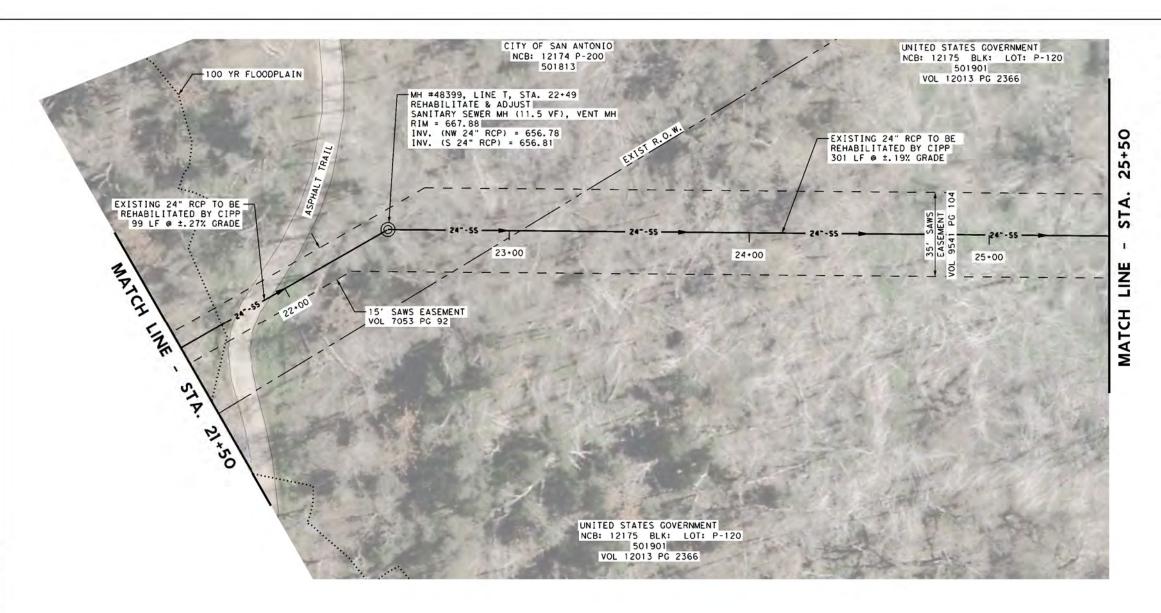

| Ī | TEM NO. | DESCRIPTION | UNIT | QUANT. |
|---------|---------|---|------|--------|
| | 851.1 | | EA | 1 |
| | 866 | SEWER MAIN TELEVISION INSPECTION (18" THROUGH 27") | LF | 400 |
| , { | 901 | 24-INCH CIPP SEWER MAIN REHABILITATION (WATER-CURED) ALL DEPTHS | LF | 400 |
| <u></u> | 910.1 | MANHOLE REHABILITATION | VF | 11.5 |

NOTES

- THE EXISTING UNDERGROUND UTILITIES SHOWN ON THESE PLANS ARE BASED UPON RECORDED INFORMATION ONLY AND ARE APPROXIMATE. THE EXACT LOCATION OF ALL EXISTING UNDERGROUND UTILITIES SHALL BE FIELD VERIFIED BY THE CONTRACTOR. THE CONTRACTOR SHALL CONTACT TEXAS STATE WIDE ONE CALL (811) PRIOR TO THE BEGINNING OF WORK. CONTRACTOR SHALL TAKE FULL RESPONSIBILITY FOR ALL AND ANY DAMAGES THAT MIGHT OCCUR BY HIS FAILURE TO ACCURATELY LOCATE ALL EXISTING UNDERGROUND UTILITIES AND PRESERVE
- 2 ALL CONSTRUCTION ACTIVITY SHALL BE MAINTAINED WITHIN THE SAWS EASEMENT UNLESS A TEMPORARY CONSTRUCTION EASEMENT, AGREEMENT, OR RIGHT OF ENTRY PERMITTING IS PROVIDED BY SAWS.
- 3 CONTRACTOR IS RESPONSIBLE FOR MAINTAINING SEWER SERVICE TO EXISTING SEWER MAINS AND SERVICES AT ALL TIMES.
- 4 CONTRACTOR SHALL MAINTAIN VEHICULAR ACCESS THROUGH ALL DRIVEWAYS FOR EMERGENCY ACCESS.
- 5 THE CONTRACTOR SHALL REFER TO THE SEWER LAYOUT AND CONTROL PLAN (SHEETS 4-9) FOR APPROXIMATE LOCATION OF 100 YEAR FLOODPLAIN.
- 6 PROPERTY LINES SHOWN ARE APPROXIMATE.

SAWS LEGEND

REHABILITATE SANITARY SEWER MH LINE/R.O.W. REHABILITATE EXISTING SANITARY SEWER SANITARY SEWER PROPOSED NEW EXISTING ----6" W----SANITARY SEWER MH WATER MAIN EXISTING EXISTING SANITARY SEWER MH STORM SEWER SUGGESTED EXISTING ____ 2" G___ ACCESS ROUTE GAS

ACCESS ROUTE

SUGGESTED
BYPASS ROUTE

SAWS
EASEMENT

100 YR
FLOODPLAIN


CAS

EXISTING OVERHEAD
ELECTRIC

EXISTING
FENCE

EXISTING
FENCE


EXISTING
RAILROAD

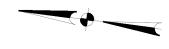





THE SEAL APPEARING ON THIS DOCUMENT WAS AUTHORIZED BY LUIS A. CUELLAR P.E. 89656 04/11/2018

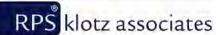

4801 NW Loop 410, Suite 910, San Antonio, Texas 78229 T 210.736,0425 • email@klotz.com • Texas PE Firm Reg. #F-929

| | REVISIONS | | | | |
|-----|------------------------------|-------|----------|--------|--|
| No. | Revision | Drown | Approved | Date | |
| | | | | | |
| | | | | | |
| Δ | UPDATED BID ITEM DESCRIPTION | JP | LC | 4/11/1 | |

EASTERN SEWERSHED PACKAGE IV

SEWER PLAN - LINE T STA. 21+50 TO STA. 25+50

DEVELOPER: SAN ANTONIO WATER SYSTEM
CONT. BUDGET PROJ.


SUBMITTED 1/5/2018
APPROVED

 MAP No.
 SHEET:
 34 OF 61
 34

 DR. MN CK.
 JOB No. 17-4527

4/12/2018 9:11:33 AM

JIIWA ILD GOARTITILS

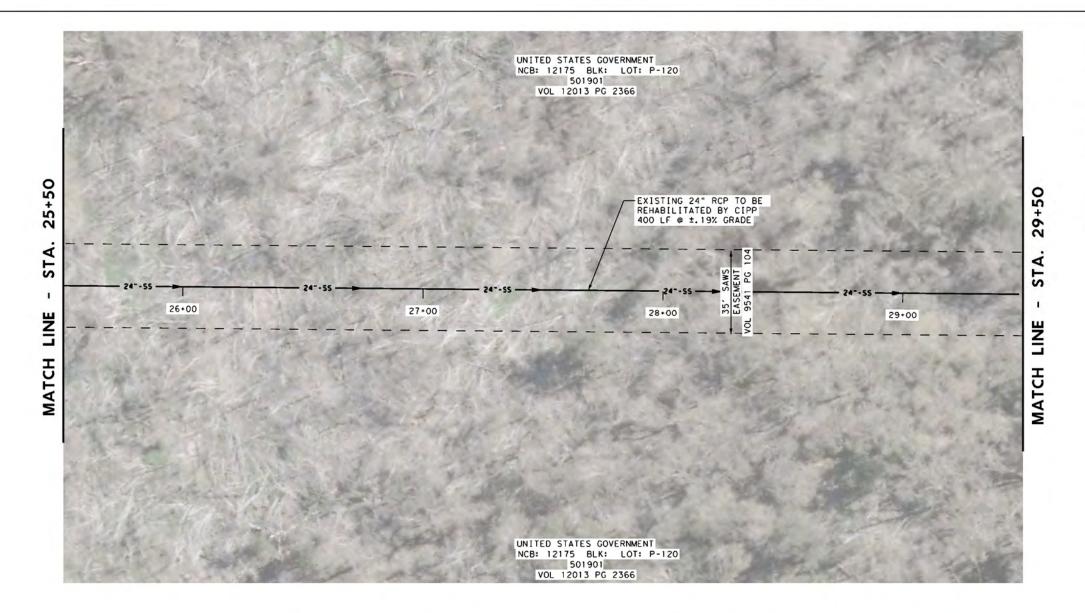



REHABILITATE SANITARY SEWER MH LINE/R.O.W. REHABILITATE EXISTING SANITARY SEWER SANITARY SEWER PROPOSED NEW EXISTING ----6" W----SANITARY SEWER MH WATER MAIN EXISTING EXISTING SANITARY SEWER MH STORM SEWER SUGGESTED EXISTING ____ 2" G___ ACCESS ROUTE GAS SUGGESTED EXISTING OVERHEAD BYPASS ROUTE ELECTRIC EXISTING SAWS <--x--x FENCE EASEMENT EXISTING 100 YR \rightarrow RAILROAD FLOODPLAIN

SAWS LEGEND





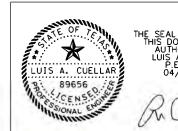

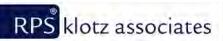

4801 NW Loop 410, Suite 910, San Antonio, Texas 78229 T 210.736.0425 • email@klotz.com • Texas PE Firm Reg. #F-929

| | UPDATED BID ITEM DESCRIPTION | JP | rc | 4/11/18 |
|-----|------------------------------|-------|----------|---------|
| | | | | |
| No. | Revision | Drawn | Approved | Date |
| | REVISI | ONS | | |

| 2750 | |
|---------|---|
| mnile 2 | H |
| n n | 1 |

PACKAGE IV

SEWER PLAN - LINE T STA. 25+50 TO STA. 29+50

VELOPER: SAN ANTONIO WATER SYSTEM
NT. BUDGET PROJ.

SUBMITTED 1/5/2018
APPROVED

 MAP No.
 SHEET:
 SFEET


 SECT. No.
 SHEET:
 35 OF 61
 35

 DR. MN CK.
 JOB No.
 17-4527
 37

NOTES

- THE EXISTING UNDERGROUND UTILITIES SHOWN ON THESE PLANS ARE BASED UPON RECORDED INFORMATION ONLY AND ARE APPROXIMATE. THE EXACT LOCATION OF ALL EXISTING UNDERGROUND UTILITIES SHALL BE FIELD VERIFIED BY THE CONTRACTOR. THE CONTRACTOR SHALL CONTACT TEXAS STATE WIDE ONE CALL (811) PRIOR TO THE BEGINNING OF WORK. CONTRACTOR SHALL TAKE FULL RESPONSIBILITY FOR ALL AND ANY DAMAGES THAT MICHI OCCUR BY HIS FAILURE TO ACCURATELY LOCATE ALL EXISTING UNDERGROUND UTILITIES AND PRESERVE
- 2 ALL CONSTRUCTION ACTIVITY SHALL BE MAINTAINED WITHIN THE SAWS EASEMENT UNLESS A TEMPORARY CONSTRUCTION EASEMENT, AGREEMENT, OR RIGHT OF ENTRY PERMITTING IS PROVIDED BY SAWS.
- 3 CONTRACTOR IS RESPONSIBLE FOR MAINTAINING SEWER SERVICE TO EXISTING SEWER MAINS AND SERVICES AT ALL TIMES.
- 4 CONTRACTOR SHALL MAINTAIN VEHICULAR ACCESS THROUGH ALL DRIVEWAYS FOR EMERGENCY ACCESS.
- 5 THE CONTRACTOR SHALL REFER TO THE SEWER LAYOUT AND CONTROL PLAN (SHEETS 4-9) FOR APPROXIMATE LOCATION OF 100 YEAR FLOODPLAIN.
- 6 PROPERTY LINES SHOWN ARE APPROXIMATE.

| ITEM NO. | DESCRIPTION | UNIT | QUANT. |
|----------|---|------|--------|
| | | | |
| 866 | SEWER MAIN TELEVISION INSPECTION (18" THROUGH 27") | LF | 400 |
| 901 | 24-INCH CIPP SEWER WAIN REHABILITATION (WATER-CURED) ALL DEPTHS | LF | 400 |

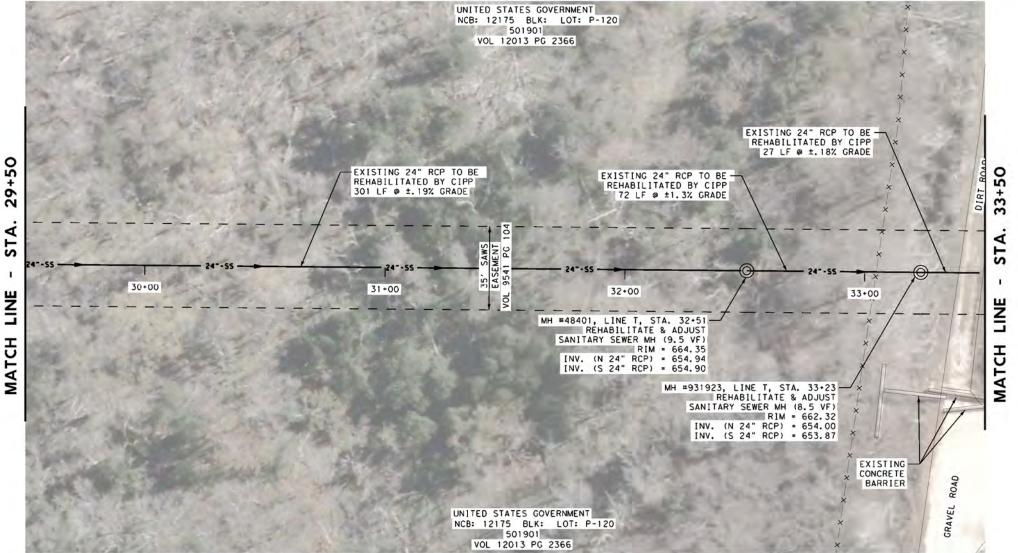

SCALE IN FEET

REHABILITATE

REHABILITATE

EXISTING

SUGGESTED

SUGGESTED

EASEMENT

FLOODPLAIN

100 YR

SAWS

ACCESS ROUTE

BYPASS ROUTE

SANITARY SEWER PROPOSED NEW

SANITARY SEWER MH

SANITARY SEWER MH


SANITARY SEWER MH

NOTES

- 1 THE EXISTING UNDERGROUND UTILITIES SHOWN ON THESE PLANS ARE BASED UPON RECORDED INFORMATION ONLY AND ARE APPROXIMATE. THE EXACT LOCATION OF ALL EXISTING UNDERGROUND UTILITIES SHALL BE FIELD VERIFIED BY THE CONTRACTOR. THE CONTRACTOR SHALL CONTACT TEXAS STATE WIDE ONE CALL (811) PRIOR TO THE BEGINNING OF WORK. CONTRACTOR SHALL TAKE FULL RESPONSIBILITY FOR ALL AND ANY DAMACES THAT MICHIOCCUR BY HIS FAILURE TO ACCURATELY LOCATE ALL EXISTING UNDERGROUND UTILITIES AND PRESERVE
- 2 ALL CONSTRUCTION ACTIVITY SHALL BE MAINTAINED WITHIN THE SAWS EASEMENT UNLESS A TEMPORARY CONSTRUCTION EASEMENT, AGREEMENT, OR RIGHT OF ENTRY PERMITTING IS PROVIDED BY SAWS.
- CONTRACTOR IS RESPONSIBLE FOR MAINTAINING SEWER SERVICE TO EXISTING SEWER MAINS AND SERVICES AT ALL TIMES.
- 4 CONTRACTOR SHALL MAINTAIN VEHICULAR ACCESS THROUGH ALL DRIVEWAYS FOR EMERGENCY ACCESS.
- 5 THE CONTRACTOR SHALL REFER TO THE SEWER LAYOUT AND CONTROL PLAN (SHEETS 4-9) FOR APPROXIMATE LOCATION OF 100 YEAR FLOODPLAIN.
- 6 PROPERTY LINES SHOWN ARE APPROXIMATE.

ESTIMATED QUANTITIES

| ITEM NO. | DESCRIPTION | UNIT | QUANT. |
|----------------|---|------|--------|
| 851 . 1 | MANHOLE ADJUSTMENT | EA | 2 |
| 866 | SEWER MAIN TELEVISION INSPECTION (18" THROUGH 27") | LF | 400 |
| 801 | 24-INCH CIPP SEWER MAIN REHABILITATION (WATER-CURED) ALL DEPTHS | LF | 400 |
| 910.1 | MANHOLE REHABILITATION | VF | 18 |

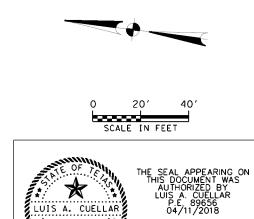

LUIS A. CUELLAR 89656

SAWS LEGEND

LINE/R.O.W.

EXISTING

EXISTING

EXISTING

ELECTRIC EXISTING

EXISTING

RAILROAD

FENCE

......

GAS

WATER MAIN

STORM SEWER

EXISTING OVERHEAD

EXISTING SANITARY SEWER

----6" W----


____ 2" G___

<--x--x

 \rightarrow

| | RPS klotz a | Antonio. | Texas 78 | 229 |
|---|------------------------------|----------|----------|---------|
| _ | UPDATED BID ITEM DESCRIPTION | JP | LC | 4/11/18 |
| | | | | |
| | | - | - | - |

|). | Revision | Draw | n Approved Date | | |
|------------------------------|-----------|----------|------------------------|--|--|
| | R | EVISIONS | | | |
| EASTERN SEWERSHED PACKAGE IV | | | | | |
| | | | - LINE T STA. 33+50 | | |
| EVELOPER: | SAN ANTON | IO WATER | SYSTEM | | |
| ONT | BU | DGET PRO | J | | |
| UBMITTED 12 PPROVED _ | /5/2018 | | | | |
| AP No. | | | SHEET | | |
| CT. No. | | 36 OF 6 | 1 36 | | |
| O MALICE | IOP No | 17_45 | 27 | | |

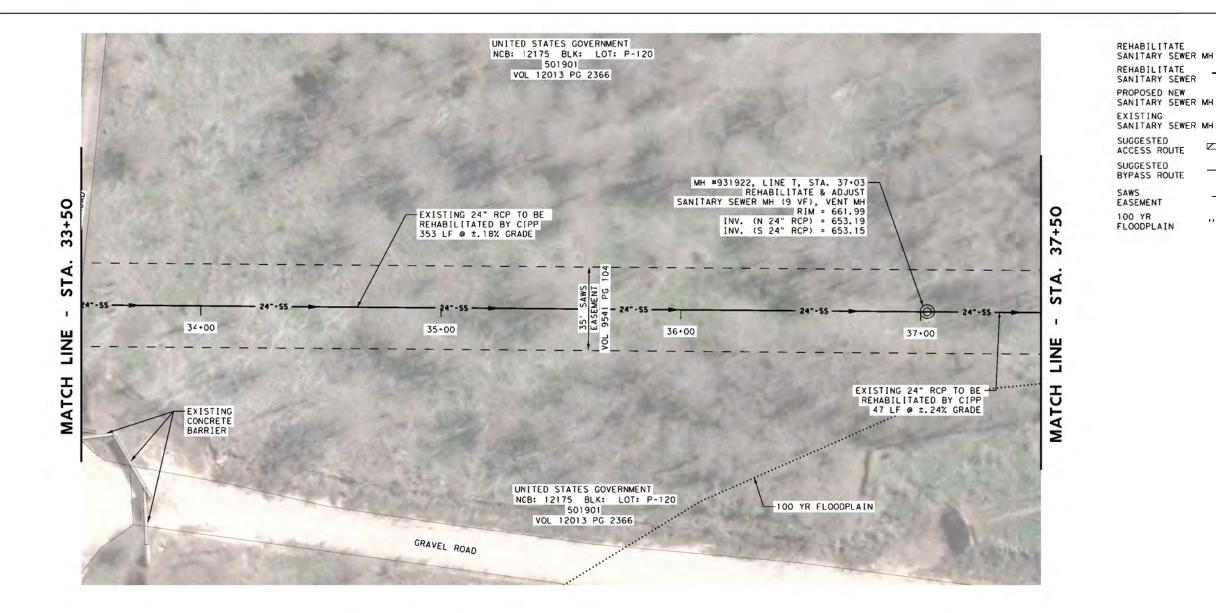

O 20' 40' SCALE IN FEET

SAWS LEGEND

......

LINE/R.O.W.

EXISTING

EXISTING

EXISTING

ELECTRIC

EXISTING

EXISTING

RAILROAD

FENCE

GAS

WATER MAIN

STORM SEWER

EXISTING OVERHEAD

EXISTING SANITARY SEWER

— 8" SS—

----6" W----

____ 2" G___

<--x--x

 \rightarrow

THE SEAL APPEARING ON THIS DOCUMENT WAS AUTHORIZED BY LUIS A. CUELLAR P.E. 89656 04/11/2018

RPS klotz associates

4801 NW Loop 410, Suite 910, San Antonio, Texas 78229 T 210.736,0425 • email@klotz.com • Texas PE Firm Reg. #F-929

| | RE | REVISIONS | | | | | |
|----------|------------------------------|-----------|----------|-------|--|--|--|
| No. | Revision | Drawn | Approved | Date | | | |
| | | | | | | | |
| | | | | | | | |
| <u> </u> | DPDATED BID ITEM DESCRIPTION | AL DE | LC | 4/11/ | | | |

| 50 | | Ī |
|----|---------------|---|
| ζ5 | اره | |
| ľ | $\overline{}$ | |
| | | |

EASTERN SEWERSHED PACKAGE IV

SEWER PLAN - LINE T STA. 33+50 TO STA. 37+50

DEVELOPER: SAN ANTONIO WATER SYSTEM
CONT. BUDGET PROJ.

SUBMITTED 1/5/2018

 APPROVED

 MAP No.
 SHEET:
 37 OF 61
 37


 SECT. No.
 SHEET:
 37 OF 61
 37

 DR. MN CK.
 JOB No.
 17-4527

NOTES

- THE EXISTING UNDERGROUND UTILITIES SHOWN ON THESE PLANS ARE BASED UPON RECORDED INFORMATION ONLY AND ARE APPROXIMATE. THE EXACT LOCATION OF ALL EXISTING UNDERGROUND UTILITIES SHALL BE FIELD VERIFIED BY THE CONTRACTOR. THE CONTRACTOR SHALL CONTACT TEXAS STATE WIDE ONE CALL (811) PRIOR TO THE BEGINNING OF WORK. CONTRACTOR SHALL TAKE FULL RESPONSIBILITY FOR ALL AND ANY DAMAGES THAT MIGHT OCCUR BY HIS FAILURE TO ACCURATELY LOCATE ALL EXISTING UNDERGROUND UTILITIES AND PRESERVE
- 2 ALL CONSTRUCTION ACTIVITY SHALL BE MAINTAINED WITHIN THE SAWS EASEMENT UNLESS A TEMPORARY CONSTRUCTION EASEMENT, AGREEMENT, OR RIGHT OF ENTRY PERMITTING IS PROVIDED BY SAWS.
- 3 CONTRACTOR IS RESPONSIBLE FOR MAINTAINING SEWER SERVICE TO EXISTING SEWER MAINS AND SERVICES AT ALL TIMES.
- 4 CONTRACTOR SHALL MAINTAIN VEHICULAR ACCESS THROUGH ALL DRIVEWAYS FOR EMERGENCY ACCESS.
- 5 THE CONTRACTOR SHALL REFER TO THE SEWER LAYOUT AND CONTROL PLAN (SHEETS 4-9) FOR APPROXIMATE LOCATION OF 100 YEAR FLOODPLAIN.
- 6 PROPERTY LINES SHOWN ARE APPROXIMATE.

| ITEM NO. | DESCRIPTION | UNIT | QUANT. |
|----------|---|------|--------|
| 851.1 | MANHOLE ADJUSTMENT | EA | 1 |
| 866 | SEWER MAIN TELEVISION INSPECTION (18" THROUGH 27") | LF | 400 |
| 901 | 24-INCH CIPP SEWER MAIN REHABILITATION (WATER-CURED) ALL DEPTHS | LF | 400 |
| 910.1 | MANHOLE REHABILITATION | VF | 9 |

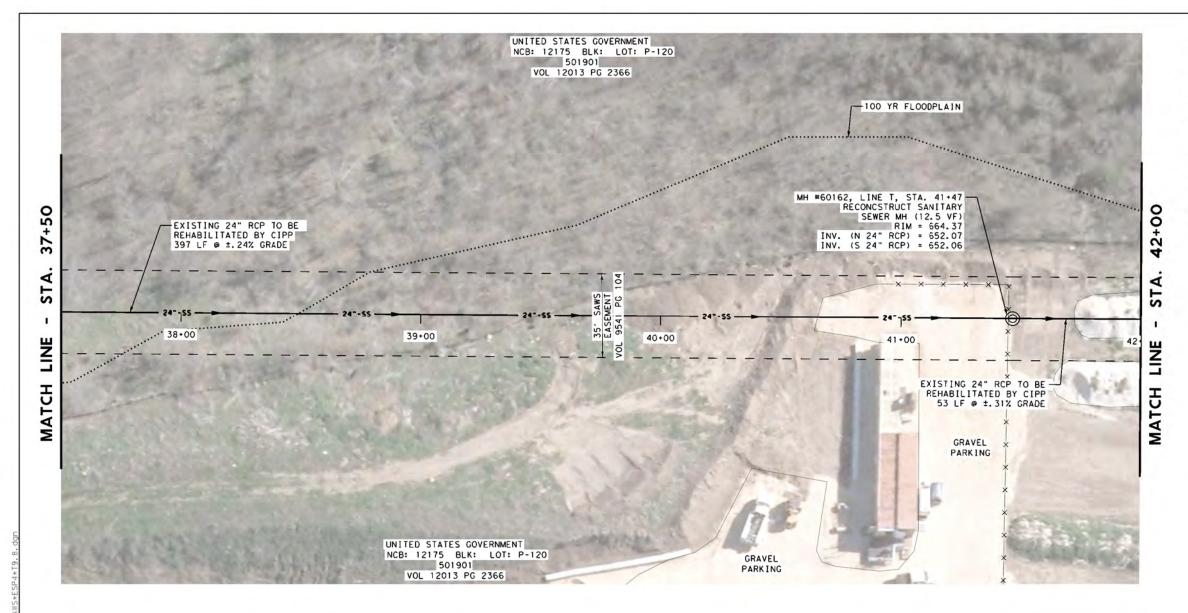

SAWS LEGEND REHABILITATE SANITARY SEWER MH LINE/R.O.W. REHABILITATE EXISTING SANITARY SEWER — 8" SS— SANITARY SEWER PROPOSED NEW EXISTING \odot ----6" W----WATER MAIN SANITARY SEWER MH EXISTING EXISTING SANITARY SEWER MH STORM SEWER SUGGESTED EXISTING ____ 2" G___ ACCESS ROUTE GAS SUGGESTED EXISTING OVERHEAD BYPASS ROUTE ELECTRIC EXISTING SAWS <--x--x FENCE EASEMENT EXISTING 100 YR \rightarrow RAILROAD FLOODPLAIN



| o | 2 | 20′ | | 40′ |
|---|-------|-----|------|-----|
| | SCALE | ΙN | FEET | |



THE SEAL APPEARING ON THIS DOCUMENT WAS AUTHORIZED BY LUIS A. CUELLAR P.E. 89656 04/11/2018

Ra. anh

RPS klotz associates

4801 NW Loop 410, Suite 910, San Antonio, Texas 78229 T 210.736,0425 • email@klotz.com • Texas PE Firm Reg. #F-929

| | | CVICIONE | | |
|------|-----------------------|----------|----------|--------|
| No. | Revision | Drawn | Approved | Date |
| | | | | |
| + | | | | |
| | | | | |
| UPDA | TED BID ITEM DESCRIPT | ON JP | LC | 4/11/1 |

| _ | | Г |
|-----|------|---|
| 5 | 2501 | H |
| וחו | | H |
| UU | 5 | |

EASTERN SEWERSHED PACKAGE IV

SEWER PLAN - LINE T STA. 37+50 TO 42+00

DEVELOPER: SAN ANTONIO WATER SYSTEM CONT. BUDGET PROJ.

SUBMITTED 1/5/2018
APPROVED


 MAP No.
 SHEET:
 38 OF 61
 38

 DR. MN CK.
 JOB No.
 17-4527

NOTES

- THE EXISTING UNDERGROUND UTILITIES SHOWN ON THESE PLANS ARE BASED UPON RECORDED INFORMATION ONLY AND ARE APPROXIMATE. THE EXACT LOCATION OF ALL EXISTING UNDERGROUND UTILITIES SHALL BE FIELD VERIFIED BY THE CONTRACTOR. THE CONTRACTOR SHALL CONTACT TEXAS STATE WIDE ONE CALL (811) PRIOR TO THE BEGINNING OF WORK. CONTRACTOR SHALL TAKE FULL RESPONSIBILITY FOR ALL AND ANY DAMAGES THAT MICHT OCCUR BY HIS FAILURE TO ACCURATELY LOCATE ALL EXISTING UNDERGROUND UTILITIES AND PRESERVE
- 2 ALL CONSTRUCTION ACTIVITY SHALL BE MAINTAINED WITHIN THE SAWS EASEMENT UNLESS A TEMPORARY CONSTRUCTION EASEMENT, AGREEMENT, OR RIGHT OF ENTRY PERMITTING IS PROVIDED BY SAWS.
- 3 CONTRACTOR IS RESPONSIBLE FOR MAINTAINING SEWER SERVICE TO EXISTING SEWER MAINS AND SERVICES AT ALL TIMES.
- 4 CONTRACTOR SHALL MAINTAIN VEHICULAR ACCESS THROUGH ALL DRIVEWAYS FOR EMERGENCY ACCESS.
- 5 THE CONTRACTOR SHALL REFER TO THE SEWER LAYOUT AND CONTROL PLAN (SHEETS 4-9) FOR APPROXIMATE LOCATION OF 100 YEAR FLOODPLAIN.
- 6 PROPERTY LINES SHOWN ARE APPROXIMATE.

| DESCRIPTION | UNIT | QUANT. |
|---|--|---|
| RECONSTRUCTION OF EXISTING MANHOLE | EA | 1 |
| SEWER MAIN TELEVISION INSPECTION (18" THROUGH 27") | LF | 450 |
| 24-INCH CIPP SEWER MAIN REHABILITATION (WATER-CURED) ALL DEPTHS | LF | 450 |
| | SEWER MAIN TELEVISION INSPECTION (18" THROUGH 27") 24-INCH CIPP SEWER MAIN REHABILITATION (WATER-CURED) ALL | RECONSTRUCTION OF EXISTING MANHOLE SEWER MAIN TELEVISION INSPECTION (18" THROUGH 27") 24-INCH CIPP SEWER MAIN REHABILITATION (WATER-CURED) ALL DEPTHS |

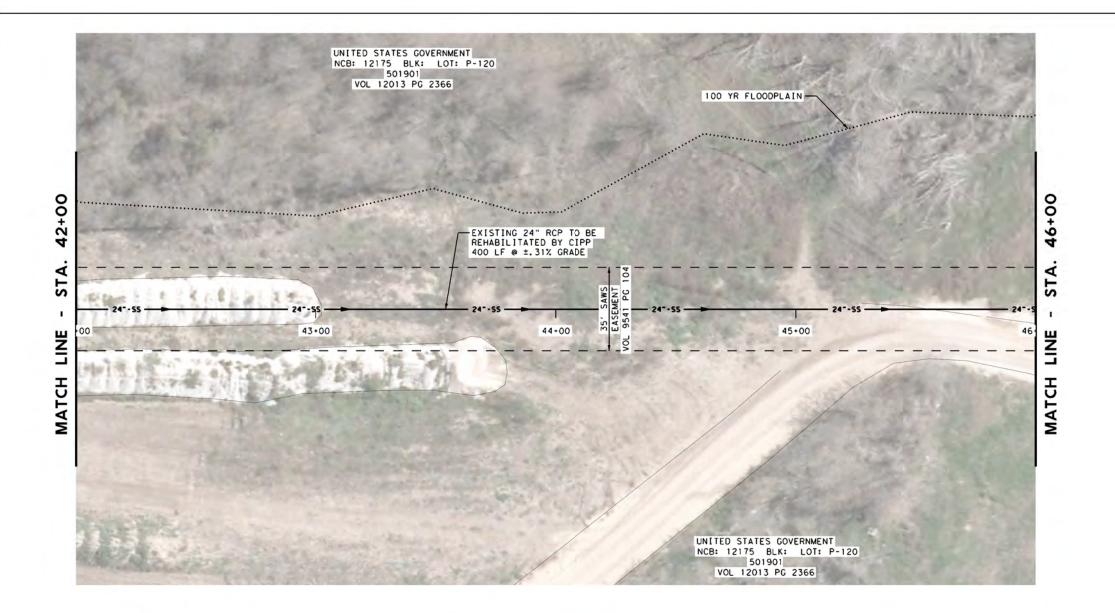

REHABILITATE SANITARY SEWER MH LINE/R.O.W. REHABILITATE EXISTING SANITARY SEWER SANITARY SEWER PROPOSED NEW EXISTING \odot ----6" W----WATER MAIN SANITARY SEWER MH EXISTING EXISTING SANITARY SEWER MH STORM SEWER SUGGESTED EXISTING ____ 2" G___ ACCESS ROUTE GAS SUGGESTED EXISTING OVERHEAD BYPASS ROUTE ELECTRIC EXISTING SAWS <--x--x FENCE EASEMENT EXISTING 100 YR \rightarrow RAILROAD FLOODPLAIN

SAWS LEGEND







THE SEAL APPEARING ON THIS DOCUMENT WAS AUTHORIZED BY LUIS A. CUELLAR P.E. 89656 04/11/2018

Ra. anh

RPS klotz associates

4801 NW Loop 410, Suite 910, San Antonio, Texas 78229 T 210.736,0425 • email@klotz.com • Texas PE Firm Reg. #F-929

| | REVISI | ONS | | |
|-----|------------------------------|-------|----------|--------|
| No. | Revision | Drawn | Approved | Date |
| | | | | |
| | | | | |
| Δ | UPDATED BID ITEM DESCRIPTION | JP | LC | 4/11/1 |

350

EASTERN SEWERSHED PACKAGE IV

SEWER PLAN - LINE T STA. 42+00 TO STA 46+00

DEVELOPER: SAN ANTONIO WATER SYSTEM
CONT. BUDGET PROJ.

SUBMITTED 1/5/2018
APPROVED


 MAP No.
 SHEET:
 39 OF 61
 39

 DR. MN CK.
 JOB No.
 17-4527

NOTES

- THE EXISTING UNDERGROUND UTILITIES SHOWN ON THESE PLANS ARE BASED UPON RECORDED INFORMATION ONLY AND ARE APPROXIMATE. THE EXACT LOCATION OF ALL EXISTING UNDERGROUND UTILITIES SHALL BE FIELD VERIFIED BY THE CONTRACTOR. THE CONTRACTOR SHALL CONTACT TEXAS STATE WIDE ONE CALL (811) PRIOR TO THE BEGINNING OF WORK. CONTRACTOR SHALL TAKE FULL RESPONSIBILITY FOR ALL AND ANY DAMAGES THAT MICHT OCCUR BY HIS FAILURE TO ACCURATELY LOCATE ALL EXISTING UNDERGROUND UTILITIES AND PRESERVE
- 2 ALL CONSTRUCTION ACTIVITY SHALL BE MAINTAINED WITHIN THE SAWS EASEMENT UNLESS A TEMPORARY CONSTRUCTION EASEMENT, AGREEMENT, OR RIGHT OF ENTRY PERMITTING IS PROVIDED BY SAWS.
- 3 CONTRACTOR IS RESPONSIBLE FOR MAINTAINING SEWER SERVICE TO EXISTING SEWER MAINS AND SERVICES AT ALL TIMES.
- 4 CONTRACTOR SHALL MAINTAIN VEHICULAR ACCESS THROUGH ALL DRIVEWAYS FOR EMERGENCY ACCESS.
- 5 THE CONTRACTOR SHALL REFER TO THE SEWER LAYOUT AND CONTROL PLAN (SHEETS 4-9) FOR APPROXIMATE LOCATION OF 100 YEAR FLOODPLAIN.
- 6 PROPERTY LINES SHOWN ARE APPROXIMATE.

| ITEM NO. | DESCRIPTION | UNIT | QUANT. |
|----------|---|-------|--------|
| . 866 | . SEWER MAIN TELEVISION INSPECTION (18" THROUGH 27") | I.F. | 400 |
| | ************************************** | | |
| 901 | 24-INCH CIPP SEWER WAIN REHABILITATION (WATER-CURED) ALL DEPTHS | LF | 400 |
| \sim | | ····· | |

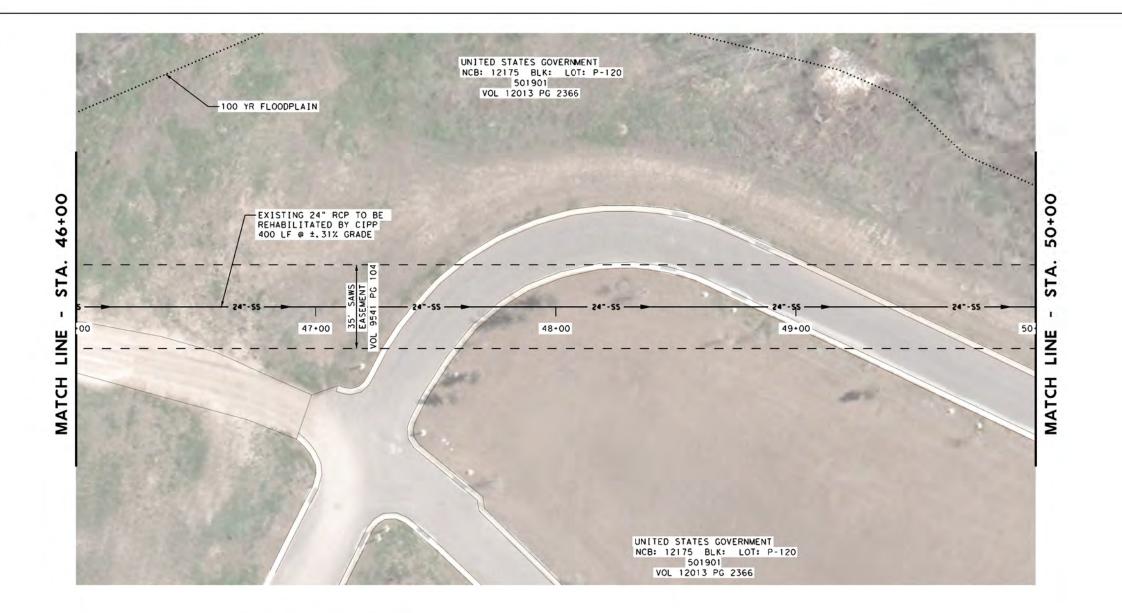

REHABILITATE SANITARY SEWER MH LINE/R.O.W. REHABILITATE EXISTING SANITARY SEWER — 8" SS— SANITARY SEWER PROPOSED NEW EXISTING \odot ----6" W----SANITARY SEWER MH WATER MAIN EXISTING EXISTING SANITARY SEWER MH STORM SEWER SUGGESTED EXISTING ____ 2" G___ ACCESS ROUTE GAS SUGGESTED EXISTING OVERHEAD BYPASS ROUTE ELECTRIC EXISTING SAWS <--x--x FENCE EASEMENT EXISTING 100 YR \rightarrow RAILROAD FLOODPLAIN

SAWS LEGEND







THE SEAL APPEARING ON THIS DOCUMENT WAS AUTHORIZED BY LUIS A. CUELLAR P.E. 89656 04/11/2018

K. a. Own

RPS klotz associates

4801 NW Loop 410, Suite 910, San Antonio, Texas 78229 T 210,736,0425 • email@klotz.com • Texas PE Firm Reg. #F-929

| | REVISI | ONS | | |
|-----|------------------------------|-------|----------|--------|
| No. | Revision | Drawn | Approved | Date |
| | | | | |
| | | | | |
| Λ | UPDATED BID ITEM DESCRIPTION | JP | LC | 4/11/1 |

| | 7 |
|----------|----|
| 577 | 11 |
| TITLE OF | 4 |
| LUUK. | 5 |

EASTERN SEWERSHED PACKAGE IV

SEWER PLAN - LINE T STA. 46+00 TO STA 50+00

DEVELOPER: SAN ANTONIO WATER SYSTEM
CONT. BUDGET PROJ.

SUBMITTED 1/5/2018
APPROVED


 MAP No.
 SHEET:
 40 OF 61
 40

 DR. MN CK.
 JOB No.
 17-4527

NOTES

- THE EXISTING UNDERGROUND UTILITIES SHOWN ON THESE PLANS ARE BASED UPON RECORDED INFORMATION ONLY AND ARE APPROXIMATE. THE EXACT LOCATION OF ALL EXISTING UNDERGROUND UTILITIES SHALL BE FIELD VERIFIED BY THE CONTRACTOR. THE CONTRACTOR SHALL CONTACT TEXAS STATE WIDE ONE CALL (811) PRIOR TO THE BEGINNING OF WORK. CONTRACTOR SHALL TAKE FULL RESPONSIBILITY FOR ALL AND ANY DAMAGES THAT MIGHT OCCUR BY HIS FAILURE TO ACCURATELY LOCATE ALL EXISTING UNDERGROUND UTILITIES AND PRESERVE
- 2 ALL CONSTRUCTION ACTIVITY SHALL BE MAINTAINED WITHIN THE SAWS EASEMENT UNLESS A TEMPORARY CONSTRUCTION EASEMENT, AGREEMENT, OR RIGHT OF ENTRY PERMITTING IS PROVIDED BY SAWS.
- 3 CONTRACTOR IS RESPONSIBLE FOR MAINTAINING SEWER SERVICE TO EXISTING SEWER MAINS AND SERVICES AT ALL TIMES.
- 4 CONTRACTOR SHALL MAINTAIN VEHICULAR ACCESS THROUGH ALL DRIVEWAYS FOR EMERGENCY ACCESS.
- 5 THE CONTRACTOR SHALL REFER TO THE SEWER LAYOUT AND CONTROL PLAN (SHEETS 4-9) FOR APPROXIMATE LOCATION OF 100 YEAR FLOODPLAIN.
- 6 PROPERTY LINES SHOWN ARE APPROXIMATE.

| ITEM NO. | DESCRIPTION | | UNIT | QUANT. |
|--|--------------------------|------------------------------------|------|--------|
| | . SEMEO NELO TELEVICIONI | INCOCCTION (10" TUDOUCU 27") | 1.5 | 400 |
| 866 | | INSPECTION (18" THROUGH 27") | LF | 400 |
| χ (901 · | | N REHABILITATION (WATER-CURED) ALL | LF | 400 |
| \\\\\\\\\\\\\\\\\\\\\\\\\\\\\\\\\\\\\\ | | | | |

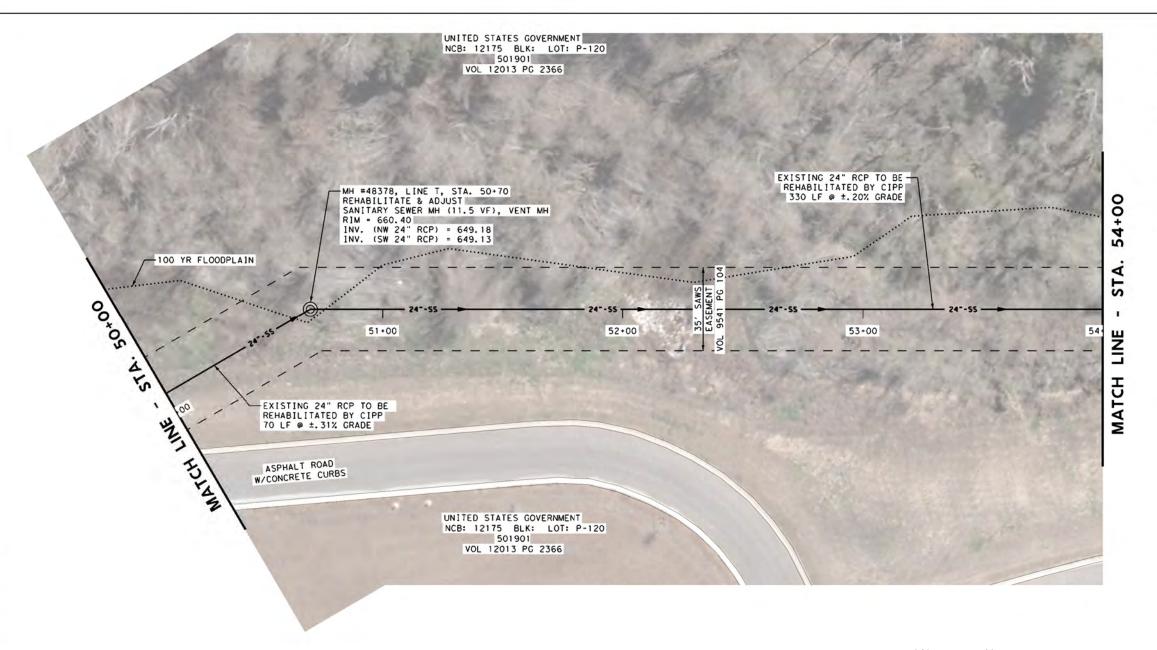

PROPOSED NEW EXISTING \odot ----6" W----WATER MAIN SANITARY SEWER MH EXISTING EXISTING SANITARY SEWER MH STORM SEWER SUGGESTED EXISTING ____ 2" G___ ACCESS ROUTE GAS SUGGESTED EXISTING OVERHEAD BYPASS ROUTE ELECTRIC EXISTING SAWS <--x--x FENCE EASEMENT EXISTING 100 YR \rightarrow RAILROAD FLOODPLAIN

SAWS LEGEND

LINE/R.O.W.

EXISTING SANITARY SEWER

REHABILITATE

REHABILITATE

SANITARY SEWER

SANITARY SEWER MH







THE SEAL APPEARING ON THIS DOCUMENT WAS AUTHORIZED BY LUIS A. CUELLAR P.E. 89656 04/11/2018

Ra. anh

RPS klotz associates

4801 NW Loop 410, Suite 910, San Antonio, Texas 78229 T 210,736,0425 • email@klotz.com • Texas PE Firm Reg. #F-929

| | | REVISIONS | | |
|------|------------------------|-----------|----------|---------|
| No. | Revision | Drawn | Approved | Date |
| | | | | |
| | | | | |
| A UP | DATED BID ITEM DESCRIP | non JP | LC | 4/11/18 |

| | П |
|-------|---|
| 575/1 | ш |
| | Н |
| UUKK | 1 |

EASTERN SEWERSHED PACKAGE IV

SEWER PLAN - LINE T STA. 50+00 TO STA 54+00

DEVELOPER: SAN ANTONIO WATER SYSTEM
CONT. BUDGET PROJ.

SUBMITTED 1/5/2018


 MAP No.
 SHEET:
 41 OF 61
 41

 DR. MN CK.
 JOB No.
 17-4527

NOTES

- THE EXISTING UNDERGROUND UTILITIES SHOWN ON THESE PLANS ARE BASED UPON RECORDED INFORMATION ONLY AND ARE APPROXIMATE. THE EXACT LOCATION OF ALL EXISTING UNDERGROUND UTILITIES SHALL BE FIELD VERIFIED BY THE CONTRACTOR. THE CONTRACTOR SHALL CONTACT TEXAS STATE WIDE ONE CALL (811) PRIOR TO THE BEGINNING OF WORK. CONTRACTOR SHALL TAKE FULL RESPONSIBILITY FOR ALL AND ANY DAMAGES THAT MICHT OCCUR BY HIS FAILURE TO ACCURATELY LOCATE ALL EXISTING UNDERGROUND UTILITIES AND PRESERVE
- 2 ALL CONSTRUCTION ACTIVITY SHALL BE MAINTAINED WITHIN THE SAWS EASEMENT UNLESS A TEMPORARY CONSTRUCTION EASEMENT, AGREEMENT, OR RIGHT OF ENTRY PERMITTING IS PROVIDED BY SAWS.
- 3 CONTRACTOR IS RESPONSIBLE FOR MAINTAINING SEWER SERVICE TO EXISTING SEWER MAINS AND SERVICES AT ALL TIMES.
- 4 CONTRACTOR SHALL MAINTAIN VEHICULAR ACCESS THROUGH ALL DRIVEWAYS FOR EMERGENCY ACCESS.
- 5 THE CONTRACTOR SHALL REFER TO THE SEWER LAYOUT AND CONTROL PLAN (SHEETS 4-9) FOR APPROXIMATE LOCATION OF 100 YEAR FLOODPLAIN.
- 6 PROPERTY LINES SHOWN ARE APPROXIMATE.

| ITEM NO. | DESCRIPTION | | UNIT | QUANT. |
|----------------|------------------------|------------------------------------|------|--------|
| 851 . 1 | MANHOLE ADJUSTMENT | | EA | 1 |
| 866 | | INSPECTION (18" THROUGH 27") | LF | 400 |
| A { 901 | | N REHABILITATION (WATER-CURED) ALL | LF | 400 |
| 910.1 | MANHOLE REHABILITATION | | VF | 11.5 |

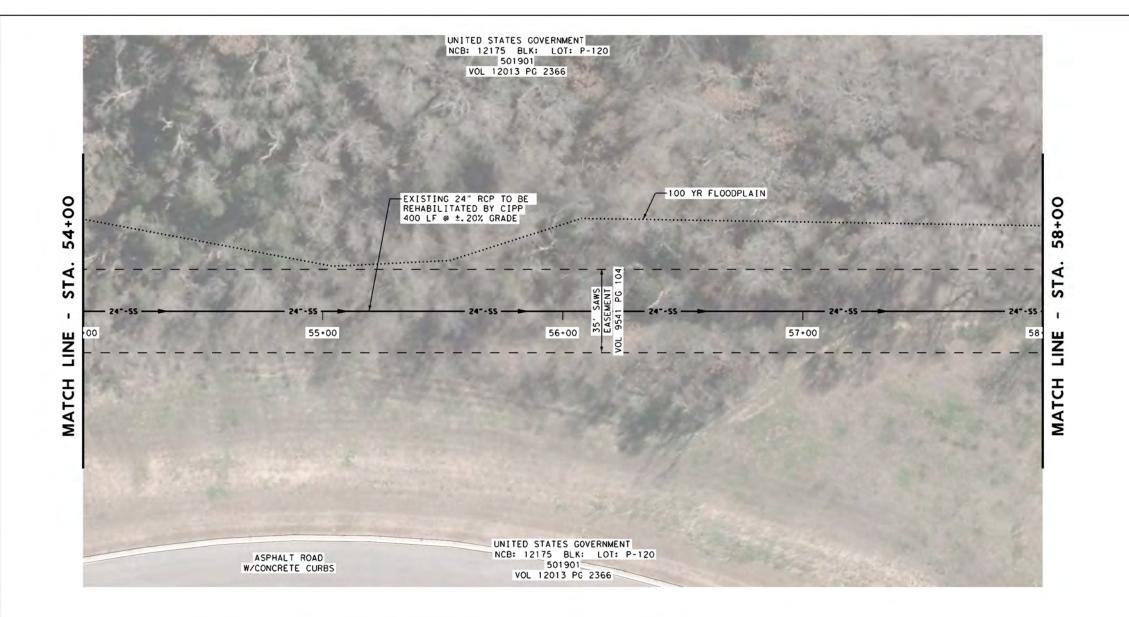


SAWS LEGEND REHABILITATE SANITARY SEWER MH LINE/R.O.W. REHABILITATE EXISTING SANITARY SEWER — 8" SS— SANITARY SEWER PROPOSED NEW EXISTING \odot ----6" W----SANITARY SEWER MH WATER MAIN EXISTING EXISTING SANITARY SEWER MH STORM SEWER SUGGESTED EXISTING ____ 2" G___ ACCESS ROUTE GAS SUGGESTED EXISTING OVERHEAD BYPASS ROUTE ELECTRIC EXISTING SAWS <--x--x FENCE EASEMENT EXISTING 100 YR \rightarrow RAILROAD FLOODPLAIN







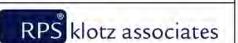

4801 NW Loop 410, Suite 910, San Antonio, Texas 78229 T 210.736.0425 • email@klotz.com • Texas PE Firm Reg. #F-929

| No. | Revision | Drawn | Approved | Date |
|----------|------------------------------|-------|----------|---------|
| | | | | |
| | | | | |
| <u> </u> | UPDATED BID ITEM DESCRIPTION | JP | LC | 4/11/18 |

| 5 | 50 1 |
|-----|------|
| hni | |
| 100 | 5 |

EASTERN SEWERSHED PACKAGE IV

SEWER PLAN - LINE T STA. 54+00 TO STA 58+00

SHEET

42

DEVELOPER: SAN ANTONIO WATER SYSTEM
CONT. BUDGET PROJ.

SUBMITTED 1/5/2018
APPROVED

 MAP No.

 SECT. No.
 SHEET: 42 OF 61

 DR. MN CK.
 JOB No. 17-4527

NOTES

- THE EXISTING UNDERGROUND UTILITIES SHOWN ON THESE PLANS ARE BASED UPON RECORDED INFORMATION ONLY AND ARE APPROXIMATE. THE EXACT LOCATION OF ALL EXISTING UNDERGROUND UTILITIES SHALL BE FIELD VERIFIED BY THE CONTRACTOR. THE CONTRACTOR SHALL CONTACT TEXAS STATE WIDE ONE CALL (811) PRIOR TO THE BEGINNING OF WORK. CONTRACTOR SHALL TAKE FULL RESPONSIBILITY FOR ALL AND ANY DAMAGES THAT MIGHT OCCUR BY HIS FAILURE TO ACCURATELY LOCATE ALL EXISTING UNDERGROUND UTILITIES AND PRESERVE
- 2 ALL CONSTRUCTION ACTIVITY SHALL BE MAINTAINED WITHIN THE SAWS EASEMENT UNLESS A TEMPORARY CONSTRUCTION EASEMENT, AGREEMENT, OR RIGHT OF ENTRY PERMITTING IS PROVIDED BY SAWS.
- 3 CONTRACTOR IS RESPONSIBLE FOR MAINTAINING SEWER SERVICE TO EXISTING SEWER MAINS AND SERVICES AT ALL TIMES.
- 4 CONTRACTOR SHALL MAINTAIN VEHICULAR ACCESS THROUGH ALL DRIVEWAYS FOR EMERGENCY ACCESS.
- 5 THE CONTRACTOR SHALL REFER TO THE SEWER LAYOUT AND CONTROL PLAN (SHEETS 4-9) FOR APPROXIMATE LOCATION OF 100 YEAR FLOODPLAIN.
- 6 PROPERTY LINES SHOWN ARE APPROXIMATE.


| ITEM NO. | DESCRIPTION | UNIT | QUANT |
|----------|---|------------|------------|
| . 866 | . SEWER MAIN TELEVISION INSPECTION (18" THROUGH 27") | I F | 400 |
| ~~~~ | *************************************** | $\sim\sim$ | $\sim\sim$ |
| 901 | 24-INCH CIPP SEWER WAIN REHABILITATION (WATER-CURED) ALL DEPTHS | LF | 400 |


NOTES

- 1 THE EXISTING UNDERGROUND UTILITIES SHOWN ON THESE PLANS ARE BASED UPON RECORDED INFORMATION ONLY AND ARE APPROXIMATE. THE EXACT LOCATION OF ALL EXISTING UNDERGROUND UTILITIES SHALL BE FIELD VERIFIED BY THE CONTRACTOR. THE CONTRACTOR SHALL CONTACT TEXAS STATE WIDE ONE CALL (811) PRIOR TO THE BEGINNING OF WORK. CONTRACTOR SHALL TAKE FULL RESPONSIBILITY FOR ALL AND ANY DAMACES THAT MICHIOCCUR BY HIS FAILURE TO ACCURATELY LOCATE ALL EXISTING UNDERGROUND UTILITIES AND PRESERVE
- 2 ALL CONSTRUCTION ACTIVITY SHALL BE MAINTAINED WITHIN THE SAWS EASEMENT UNLESS A TEMPORARY CONSTRUCTION EASEMENT, AGREEMENT, OR RIGHT OF ENTRY PERMITTING IS PROVIDED BY SAWS.
- 3 CONTRACTOR IS RESPONSIBLE FOR MAINTAINING SEWER SERVICE TO EXISTING SEWER MAINS AND SERVICES AT ALL TIMES.
- 4 CONTRACTOR SHALL MAINTAIN VEHICULAR ACCESS THROUGH ALL DRIVEWAYS FOR EMERGENCY ACCESS.
- 5 THE CONTRACTOR SHALL REFER TO THE SEWER LAYOUT AND CONTROL PLAN (SHEETS 4-9) FOR APPROXIMATE LOCATION OF 100 YEAR FLOODPLAIN.
- 6 PROPERTY LINES SHOWN ARE APPROXIMATE.


ESTIMATED QUANTITIES

| ITEM NO. | DESCRIPTION | UNIT | QUANT. |
|----------|---|------|--------|
| 855 | RECONSTRUCTION OF EXISTING MANHOLE | EA | 1 |
| 866 | SEWER MAIN TELEVISION INSPECTION (18" THROUGH 27") | LF | 400 |
| 901 | 24-INCH CIPP SEWER MAIN REHABILITATION (WATER-CURED) ALL DEPTHS | LF | 400 |

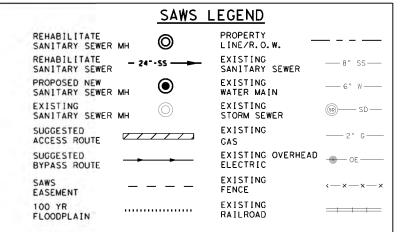

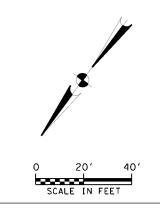



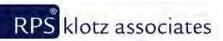

4801 NW Loop 410, Suite 910, San Antonio, Texas 78229 T 210.736,0425 • email@klotz.com • Texas PE Firm Reg. #F-929

| No. Revision Drawn Approved Date | | PEVISI | TNS | | |
|---|-----|-------------------------------|-------|----------|--------|
| | No. | Revision | Drawn | Approved | Date |
| | | | | | |
| | | | | | |
| 1) UPDATED BID ITEM DESCRIPTION JP LC 4/11/ | | Dr DATES DID TIEM DESCRIPTION | | 1.0 | 4/11/1 |

| 5750 | |
|-------|----------|
| | \vdash |
| UU 55 | |
| | |

EASTERN SEWERSHED PACKAGE IV

SEWER PLAN - LINE T STA. 58+00 TO STA 62+00


DEVELOPER: SAN ANTONIO WATER SYSTEM
CONT. BUDGET PROJ.

SUBMITTED 1/5/2018
APPROVED

MAP No. SHEET: 43 OF 61 43

DR. MN CK. JOB No. 17-4527

4/12/2018 9:16:49 AM

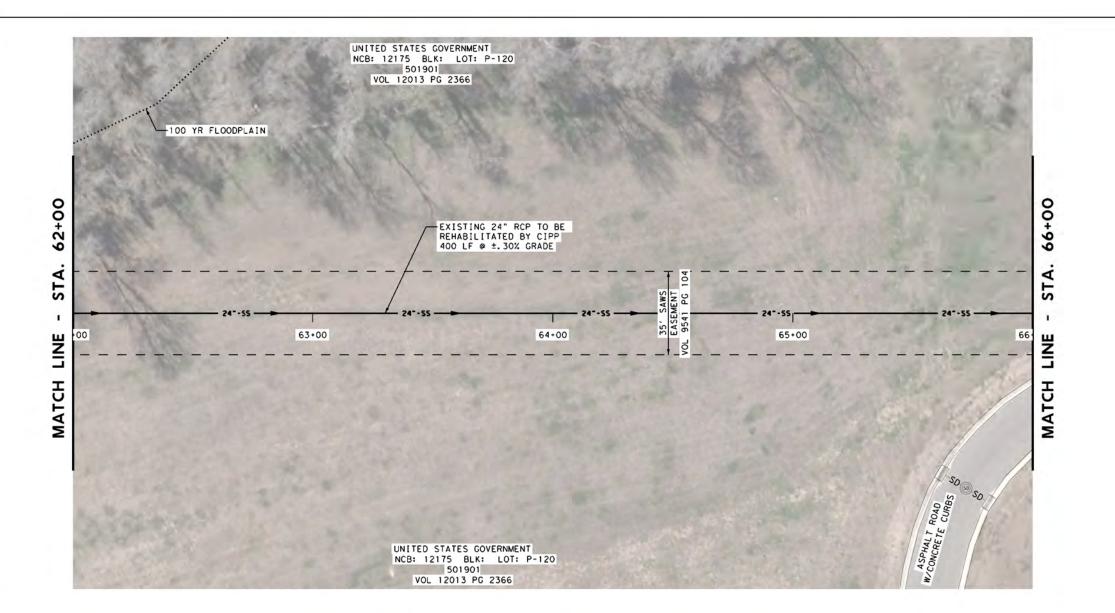

0 20' 40'

SCALE IN FEET

LUIS A. CUELLAR 89656 CENS STOMAL E

SAWS LEGEND

 \odot

......

LINE/R.O.W.

EXISTING

EXISTING

EXISTING

ELECTRIC EXISTING

EXISTING

RAILROAD

FENCE

GAS

WATER MAIN

STORM SEWER

EXISTING OVERHEAD

EXISTING SANITARY SEWER

— 8" SS —

----6" W----

____ 2" G___

<--x--x

 $\overline{}$

REHABILITATE SANITARY SEWER MH

REHABILITATE

EXISTING

SUGGESTED

SUGGESTED

EASEMENT

FLOODPLAIN

100 YR

SAWS

ACCESS ROUTE

BYPASS ROUTE

SANITARY SEWER
PROPOSED NEW

SANITARY SEWER MH

SANITARY SEWER MH

RPS klotz associates

4801 NW Loop 410, Suite 910, San Antonio, Texas 78229 T 210.736,0425 • email@klotz.com • Texas PE Firm Reg. #F-929

| | | REVISIONS | | |
|--------|----------------------|-----------|----------|--------|
| No. | Revision | Drawn | Approved | Date |
| | | | | |
| | | | | |
| 1 UPDA | TED BID ITEM DESCRIP | TION JP | LC | 4/11/1 |

| $\overline{}$ | | |
|---------------|-----|----|
| 5 | 501 | П |
| ПÍ | | |
| U U | 5 | B. |

EASTERN SEWERSHED PACKAGE IV

SEWER PLAN - LINE T STA. 62+00 TO STA 66+00

DEVELOPER: SAN ANTONIO WATER SYSTEM
CONT. BUDGET PROJ.

SUBMITTED 1/5/2018

 APPROVED


 MAP No.
 SHEET:
 44 OF 61
 44

 DR. MN CK.
 JOB No.
 17-4527
 44

NOTES

- THE EXISTING UNDERGROUND UTILITIES SHOWN ON THESE PLANS ARE BASED UPON RECORDED INFORMATION ONLY AND ARE APPROXIMATE. THE EXACT LOCATION OF ALL EXISTING UNDERGROUND UTILITIES SHALL BE FIELD VERIFIED BY THE CONTRACTOR. THE CONTRACTOR SHALL CONTACT TEXAS STATE WIDE ONE CALL (811) PRIOR TO THE BEGINNING OF WORK. CONTRACTOR SHALL TAKE FULL RESPONSIBILITY FOR ALL AND ANY DAMAGES THAT MICHT OCCUR BY HIS FAILURE TO ACCURATELY LOCATE ALL EXISTING UNDERGROUND UTILITIES AND PRESERVE
- 2 ALL CONSTRUCTION ACTIVITY SHALL BE MAINTAINED WITHIN THE SAWS EASEMENT UNLESS A TEMPORARY CONSTRUCTION EASEMENT, AGREEMENT, OR RIGHT OF ENTRY PERMITTING IS PROVIDED BY SAWS.
- 3 CONTRACTOR IS RESPONSIBLE FOR MAINTAINING SEWER SERVICE TO EXISTING SEWER MAINS AND SERVICES AT ALL TIMES.
- 4 CONTRACTOR SHALL MAINTAIN VEHICULAR ACCESS THROUGH ALL DRIVEWAYS FOR EMERGENCY ACCESS.
- 5 THE CONTRACTOR SHALL REFER TO THE SEWER LAYOUT AND CONTROL PLAN (SHEETS 4-9) FOR APPROXIMATE LOCATION OF 100 YEAR FLOODPLAIN.
- 6 PROPERTY LINES SHOWN ARE APPROXIMATE.

| ITEM NO. | DESCRIPTION | | UNIT | QUANT. |
|-----------------|--|---|------|----------------|
| | | | | |
| 866 | SEWER MAIN TELEVISION | INSPECTION (18" THROUGH 27") | LF | 400 |
| ~~~~~ | \sim | ~~~~~~~~~~~~~~~~~~~~~~~~~~~~~~~~~~~~~~~ | ~~~~ | $\sim\sim\sim$ |
| √ € 901 | 24-INCH CIPP SEWER WAIN DEPTHS | REHABILITATION (WATER-CURED) ALL | LF | 400 |
| \/ \ | | | | |

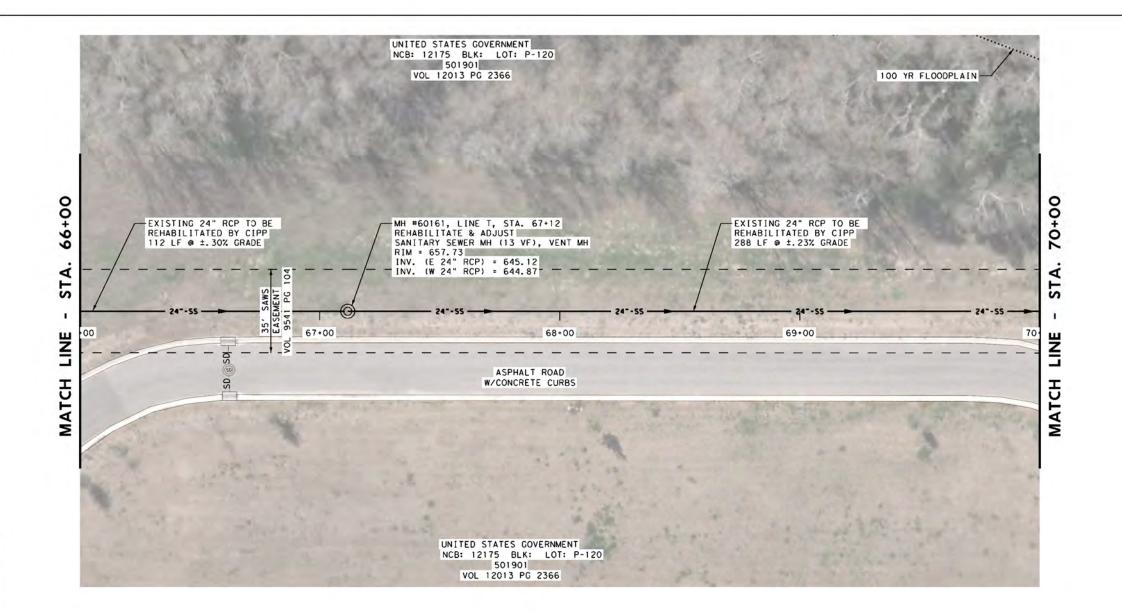


SANITARY SEWER MH LINE/R.O.W. REHABILITATE EXISTING SANITARY SEWER — 8" SS— SANITARY SEWER PROPOSED NEW EXISTING \odot ----6" W----WATER MAIN SANITARY SEWER MH EXISTING EXISTING SANITARY SEWER MH STORM SEWER SUGGESTED EXISTING ____ 2" G___ ACCESS ROUTE GAS SUGGESTED EXISTING OVERHEAD BYPASS ROUTE ELECTRIC EXISTING SAWS <--x--x FENCE EASEMENT EXISTING 100 YR \rightarrow RAILROAD FLOODPLAIN

SAWS LEGEND

REHABILITATE



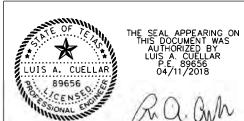

RPS klotz associates

4801 NW Loop 410, Suite 910, San Antonio, Texas 78229 T 210.736,0425 • email@klotz.com • Texas PE Firm Reg. #F-929

| | REVISI | ONS | | |
|----------|------------------------------|-------|----------|--------|
| No. | Revision | Drawn | Approved | Date |
| | | | | |
| | | | | |
| <u> </u> | UPDATED BID ITEM DESCRIPTION | JP | LC | 4/11/1 |

| | | \neg |
|------|-----|--------|
| 5 | 350 | 2 |
| וחוו | Y | 2 |
| LUU | | 7 |

EASTERN SEWERSHED PACKAGE IV

SEWER PLAN - LINE T STA. 66+00 TO STA 70+00

DEVELOPER: SAN ANTONIO WATER SYSTEM
CONT. BUDGET PROJ.

SUBMITTED 1/5/2018

 APPROVED


 MAP No.
 SHEET:
 45 OF 61
 45

 DR. MN CK.
 JOB No. 17-4527
 17-4527

NOTES


- THE EXISTING UNDERGROUND UTILITIES SHOWN ON THESE PLANS ARE BASED UPON RECORDED INFORMATION ONLY AND ARE APPROXIMATE. THE EXACT LOCATION OF ALL EXISTING UNDERGROUND UTILITIES SHALL BE FIELD VERIFIED BY THE CONTRACTOR. THE CONTRACTOR SHALL CONTACT TEXAS STATE WIDE ONE CALL (811) PRIOR TO THE BEGINNING OF WORK. CONTRACTOR SHALL TAKE FULL RESPONSIBILITY FOR ALL AND ANY DAMACES THAT MICHIOCCUR BY HIS FAILURE TO ACCURATELY LOCATE ALL EXISTING UNDERGROUND UTILITIES AND PRESERVE
- 2 ALL CONSTRUCTION ACTIVITY SHALL BE MAINTAINED WITHIN THE SAWS EASEMENT UNLESS A TEMPORARY CONSTRUCTION EASEMENT, AGREEMENT, OR RIGHT OF ENTRY PERMITTING IS PROVIDED BY SAWS.
- 3 CONTRACTOR IS RESPONSIBLE FOR MAINTAINING SEWER SERVICE TO EXISTING SEWER MAINS AND SERVICES AT ALL TIMES.
- 4 CONTRACTOR SHALL MAINTAIN VEHICULAR ACCESS THROUGH ALL DRIVEWAYS FOR EMERGENCY ACCESS.
- 5 THE CONTRACTOR SHALL REFER TO THE SEWER LAYOUT AND CONTROL PLAN (SHEETS 4-9) FOR APPROXIMATE LOCATION OF 100 YEAR FLOODPLAIN.
- 6 PROPERTY LINES SHOWN ARE APPROXIMATE.


| ITEM NO. | DESCRIPTION | | UNIT | QUANT. |
|----------|-----------------------------------|------------------------------------|------|--------|
| 851.1 | MANHOLE ADJUSTMENT | | EA | 1 |
| 866 | | INSPECTION (18" THROUGH 27") | LF | 400 |
| 901 | 24-INCH CIPP SEWER MAIN DEPTHS | N REHABILITATION (WATER-CURED) ALL | LF | 400 |
| 910.1 | MANHOLE REHABILITATION | | VF | 13 |

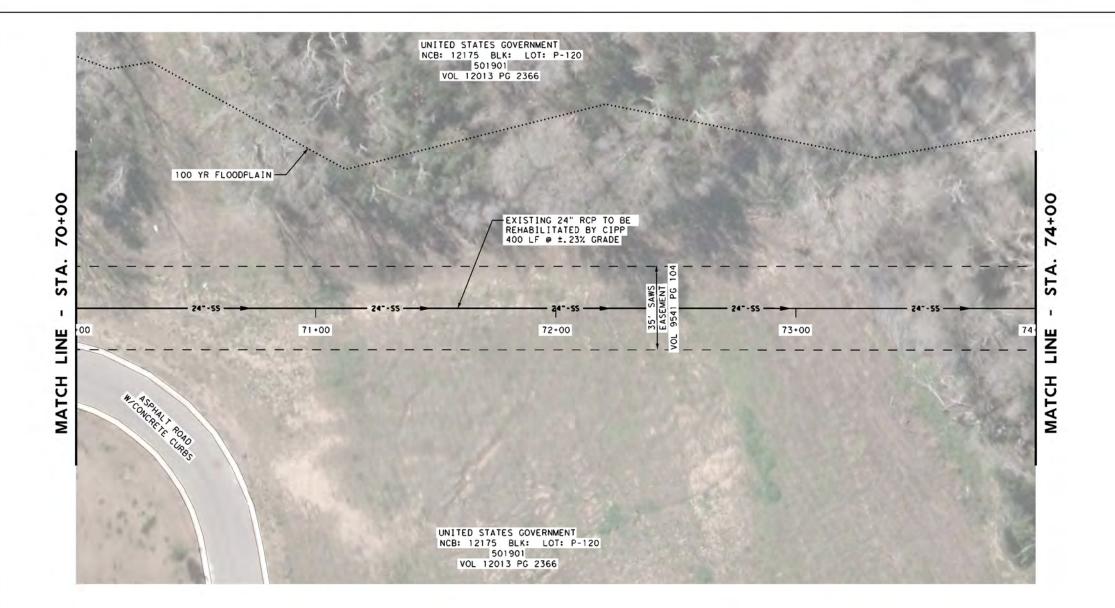


REHABILITATE SANITARY SEWER MH LINE/R.O.W. REHABILITATE EXISTING SANITARY SEWER — 8" SS — SANITARY SEWER PROPOSED NEW EXISTING \odot ----6" W----WATER MAIN SANITARY SEWER MH EXISTING EXISTING SANITARY SEWER MH STORM SEWER SUGGESTED EXISTING ____ 2" G___ ACCESS ROUTE GAS SUGGESTED EXISTING OVERHEAD BYPASS ROUTE ELECTRIC EXISTING SAWS <--x--x FENCE EASEMENT EXISTING 100 YR \rightarrow RAILROAD FLOODPLAIN

SAWS LEGEND

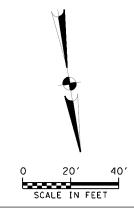

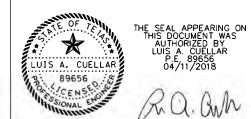

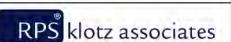

4801 NW Loop 410, Suite 910, San Antonio, Texas 78229 T 210.736,0425 • email@klotz.com • Texas PE Firm Reg. #F-929

| | REVISI | DNS | | |
|-----|------------------------------|-------|----------|-------|
| No. | Revision | Drawn | Approved | Date |
| | | | | |
| | | | | |
| Δ | UPDATED BID ITEM DESCRIPTION | JP | LC | 4/11/ |

| 57 | 50.11 |
|-----|-------|
| hut | |
| UU | 5 |

EASTERN SEWERSHED PACKAGE IV

SEWER PLAN - LINE T STA. 70+00 TO STA 74+00

DEVELOPER: SAN ANTONIO WATER SYSTEM
CONT. BUDGET PROJ.

SUBMITTED 1/5/2018

 APPROVED


 MAP No.
 SHEET:
 46 OF 61
 46

 DR. MN CK.
 JOB No. 17-4527
 17-4527

NOTES

- THE EXISTING UNDERGROUND UTILITIES SHOWN ON THESE PLANS ARE BASED UPON RECORDED INFORMATION ONLY AND ARE APPROXIMATE. THE EXACT LOCATION OF ALL EXISTING UNDERGROUND UTILITIES SHALL BE FIELD VERIFIED BY THE CONTRACTOR. THE CONTRACTOR SHALL CONTACT TEXAS STATE WIDE ONE CALL (811) PRIOR TO THE BEGINNING OF WORK. CONTRACTOR SHALL TAKE FULL RESPONSIBILITY FOR ALL AND ANY DAMAGES THAT MICHT OCCUR BY HIS FAILURE TO ACCURATELY LOCATE ALL EXISTING UNDERGROUND UTILITIES AND PRESERVE
- 2 ALL CONSTRUCTION ACTIVITY SHALL BE MAINTAINED WITHIN THE SAWS EASEMENT UNLESS A TEMPORARY CONSTRUCTION EASEMENT, AGREEMENT, OR RIGHT OF ENTRY PERMITTING IS PROVIDED BY SAWS.
- 3 CONTRACTOR IS RESPONSIBLE FOR MAINTAINING SEWER SERVICE TO EXISTING SEWER MAINS AND SERVICES AT ALL TIMES.
- 4 CONTRACTOR SHALL MAINTAIN VEHICULAR ACCESS THROUGH ALL DRIVEWAYS FOR EMERGENCY ACCESS.
- 5 THE CONTRACTOR SHALL REFER TO THE SEWER LAYOUT AND CONTROL PLAN (SHEETS 4-9) FOR APPROXIMATE LOCATION OF 100 YEAR FLOODPLAIN.
- 6 PROPERTY LINES SHOWN ARE APPROXIMATE.

| ITEM NO. | DESCRIPTION | UNIT | QUANT. |
|----------------|---|----------------|----------|
| | | | |
| 866 | SEWER MAIN TELEVISION INSPECTION (18" THROUGH 27") | LF | 400 |
| ~~~~~~ | ************************************** | $\sim\sim\sim$ | ∞ |
| √ { 901 | 24-INCH CIPP SEWER MAIN REHABILITATION (WATER-CURED) ALL DEPTHS | LF | 400 |
| ∇r | | | |

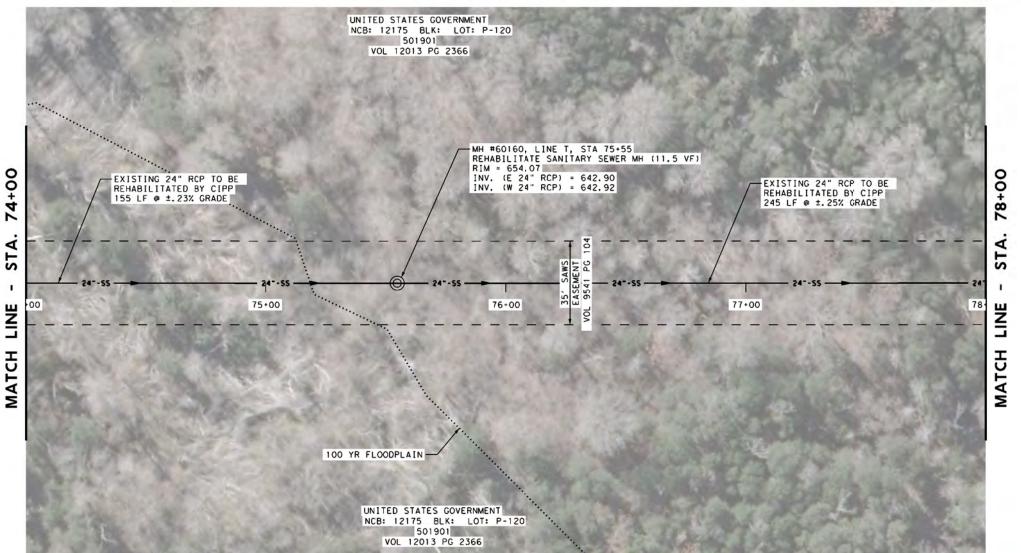

201 SCALE IN FEET

REHABILITATE

REHABILITATE

EXISTING

SUGGESTED

SUGGESTED

EASEMENT

FLOODPLAIN

100 YR

SAWS

ACCESS ROUTE

BYPASS ROUTE

SANITARY SEWER PROPOSED NEW

SANITARY SEWER MH

SANITARY SEWER MH


SANITARY SEWER MH

NOTES

- 1 THE EXISTING UNDERGROUND UTILITIES SHOWN ON THESE PLANS ARE BASED UPON RECORDED INFORMATION ONLY AND ARE APPROXIMATE. THE EXACT LOCATION OF ALL EXISTING UNDERGROUND UTILITIES SHALL BE FIELD VERIFIED BY THE CONTRACTOR. THE CONTRACTOR SHALL CONTACT TEXAS STATE WIDE ONE CALL (811) PRIOR TO THE BEGINNING OF WORK. CONTRACTOR SHALL TAKE FULL RESPONSIBILITY FOR ALL AND ANY DAMACES THAT MICHIOCCUR BY HIS FAILURE TO ACCURATELY LOCATE ALL EXISTING UNDERGROUND UTILITIES AND PRESERVE
- 2 ALL CONSTRUCTION ACTIVITY SHALL BE MAINTAINED WITHIN THE SAWS EASEMENT UNLESS A TEMPORARY CONSTRUCTION EASEMENT, AGREEMENT, OR RIGHT OF ENTRY PERMITTING IS PROVIDED BY SAWS.
- CONTRACTOR IS RESPONSIBLE FOR MAINTAINING SEWER SERVICE TO EXISTING SEWER MAINS AND SERVICES AT ALL TIMES.
- 4 CONTRACTOR SHALL MAINTAIN VEHICULAR ACCESS THROUGH ALL DRIVEWAYS FOR EMERGENCY ACCESS.
- 5 THE CONTRACTOR SHALL REFER TO THE SEWER LAYOUT AND CONTROL PLAN (SHEETS 4-9) FOR APPROXIMATE LOCATION OF 100 YEAR FLOODPLAIN.
- 6 PROPERTY LINES SHOWN ARE APPROXIMATE.

ESTIMATED QUANTITIES

| ITEM NO. | DESCRIPTION | | UNIT | QUANT. |
|----------|-----------------------------------|----------------------------------|------|--------|
| . 866 | | NSPECTION (18" THROUGH 27") | LF | 400 |
| 901 | 24-INCH CIPP SEWER MAIN DEPTHS | REHABILITATION (WATER-CURED) ALL | LF | 400 |
| 10.1 | MANHOLE REHABILITATION | | VF | 11.5 |

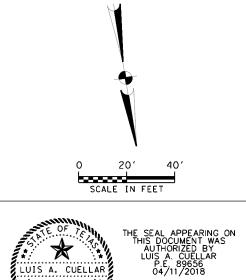

SAWS LEGEND

 \odot

......

LINE/R.O.W.

EXISTING

EXISTING

EXISTING

ELECTRIC EXISTING

EXISTING

RAILROAD

FENCE

GAS

WATER MAIN

STORM SEWER

EXISTING OVERHEAD

EXISTING SANITARY SEWER

—— 8" SS—

----6" W----

____ 2" G___

<--x--x

 \rightarrow


| | 4801 NW Loop | klotz a | Antonio. | Texas 782 | 29 |
|-----|--------------|-----------------|-------------|-------------|---------|
| Δ | | TEM DESCRIPTION | JP | LC | 4/11/18 |
| No. | Re | evision | Drawn | Approved | Date |
| | | REVISI | ONS | | |
| 5 | 350 | EASTERN | SEW KAGE | |) |
| | | | 40-0-6 | in restrict | |

| 250 | PACKAGE IV |
|------------|--|
| | SEWER PLAN - LINE T STA. 74+00 TO STA 78+00 |
| DEVELOPER. | SAN ANTONIO WATER SYSTEM |
| CONT | BUDGET PROJ |

SUBMITTED 1/5/2018

LUIS A. CUELLAR 89656

APPROVED MAP No. SHEET SECT. No. SHEET: 47 OF 61 47 DR. MN CK. JOB No. 17-4527

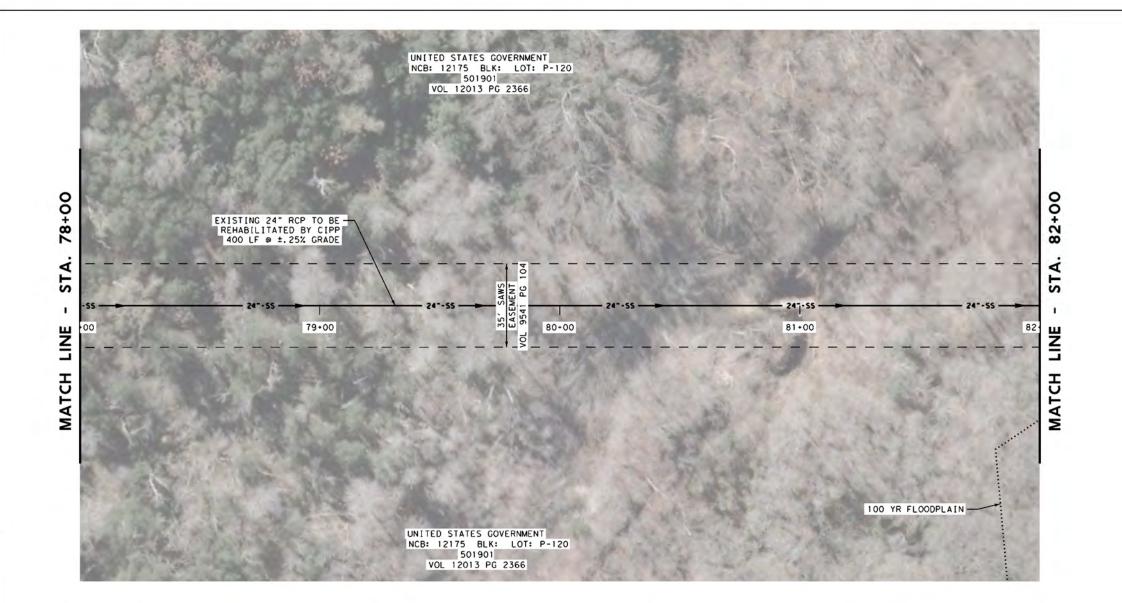


SANITARY SEWER MH LINE/R.O.W. REHABILITATE EXISTING SANITARY SEWER — 8" SS — SANITARY SEWER PROPOSED NEW EXISTING \odot ----6" W----SANITARY SEWER MH WATER MAIN EXISTING EXISTING SANITARY SEWER MH STORM SEWER SUGGESTED EXISTING ____ 2" G___ ACCESS ROUTE GAS SUGGESTED EXISTING OVERHEAD BYPASS ROUTE ELECTRIC EXISTING SAWS <--x--x FENCE EASEMENT EXISTING 100 YR \rightarrow RAILROAD FLOODPLAIN

SAWS LEGEND

REHABILITATE



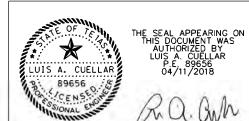

RPS klotz associates

4801 NW Loop 410, Suite 910, San Antonio, Texas 78229 T 210.736.0425 • email@klotz.com • Texas PE Firm Reg. #F-929

| No. | Revision | Drawn | Approved | Date |
|-----|------------------------------|-------|----------|---------|
| | | | | |
| | | | | |
| Δ | UPDATED BID ITEM DESCRIPTION | Jb. | LC | 4/11/18 |

| | VI. |
|------|-----|
| 5750 | 11 |
| 100 | {⊢ |
| | |

EASTERN SEWERSHED PACKAGE IV

SEWER PLAN - LINE T STA. 78+00 TO STA 82+00

DEVELOPER: SAN ANTONIO WATER SYSTEM
CONT. BUDGET PROJ.

SUBMITTED 1/5/2018
APPROVED


 MAP No.
 SHEET:
 48 OF 61
 48

 DR. MN CK.
 JOB No.
 17-4527

NOTES

- THE EXISTING UNDERGROUND UTILITIES SHOWN ON THESE PLANS ARE BASED UPON RECORDED INFORMATION ONLY AND ARE APPROXIMATE. THE EXACT LOCATION OF ALL EXISTING UNDERGROUND UTILITIES SHALL BE FIELD VERIFIED BY THE CONTRACTOR. THE CONTRACTOR SHALL CONTACT TEXAS STATE WIDE ONE CALL (811) PRIOR TO THE BEGINNING OF WORK. CONTRACTOR SHALL TAKE FULL RESPONSIBILITY FOR ALL AND ANY DAMAGES THAT MICHI OCCUR BY HIS FAILURE TO ACCURATELY LOCATE ALL EXISTING UNDERGROUND UTILITIES AND PRESERVE
- 2 ALL CONSTRUCTION ACTIVITY SHALL BE MAINTAINED WITHIN THE SAWS EASEMENT UNLESS A TEMPORARY CONSTRUCTION EASEMENT, AGREEMENT, OR RIGHT OF ENTRY PERMITTING IS PROVIDED BY SAWS.
- 3 CONTRACTOR IS RESPONSIBLE FOR MAINTAINING SEWER SERVICE TO EXISTING SEWER MAINS AND SERVICES AT ALL TIMES.
- 4 CONTRACTOR SHALL MAINTAIN VEHICULAR ACCESS THROUGH ALL DRIVEWAYS FOR EMERGENCY ACCESS.
- 5 THE CONTRACTOR SHALL REFER TO THE SEWER LAYOUT AND CONTROL PLAN (SHEETS 4-9) FOR APPROXIMATE LOCATION OF 100 YEAR FLOODPLAIN.
- 6 PROPERTY LINES SHOWN ARE APPROXIMATE.

| ITEM NO. | DESCRIPTION | UNIT | QUANT. |
|----------------|---|----------------|----------|
| | | | |
| 866 | SEWER MAIN TELEVISION INSPECTION (18" THROUGH 27") | LF | 400 |
| ~~~~~~ | ************************************** | $\sim\sim\sim$ | ∞ |
| √ { 901 | 24-INCH CIPP SEWER MAIN REHABILITATION (WATER-CURED) ALL DEPTHS | LF | 400 |
| ∇r | | | |

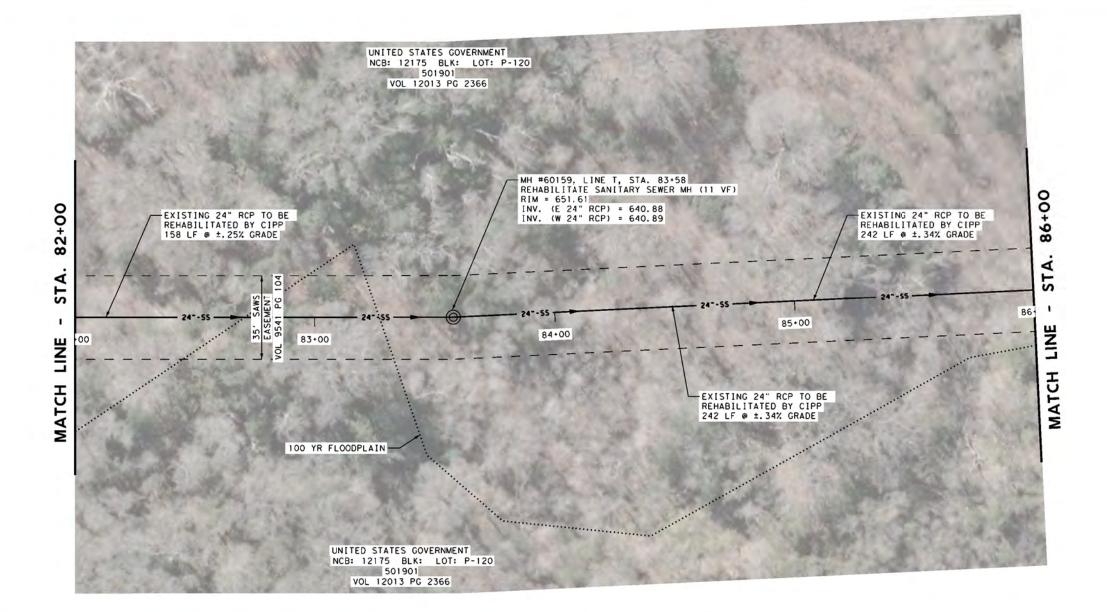



| 1 | THE EXISTING UNDERGROUND UTILITIES SHOWN ON THESE PLANS ARE BASED UPON RECORDED INFORMATION ONLY AND ARE APPROXIMATE. THE EXACT LOCATION OF ALL EXISTING UNDERGROUND UTILITIES SHALL BE FIELD VERIFIED BY THE CONTRACTOR. THE CONTRACTOR SHALL CONTACT TEXAS STATE WIDE ONE CALL (811) PRIOR TO THE BEGINNING OF WORK. CONTRACTOR SHALL TAKE FULL RESPONSIBILITY FOR ALL AND ANY DAMAGES THAT MIGHT OCCUR. BY HIS FAILURE TO ACCURATELY LOCATE ALL |
|---|--|
| | EXISTING UNDERGROUND UTILITIES AND PRESERVE |


NOTES


- 2 ALL CONSTRUCTION ACTIVITY SHALL BE MAINTAINED WITHIN THE SAWS EASEMENT UNLESS A TEMPORARY CONSTRUCTION EASEMENT, AGREEMENT, OR RIGHT OF ENTRY PERMITTING IS PROVIDED BY SAWS.
- 3 CONTRACTOR IS RESPONSIBLE FOR MAINTAINING SEWER SERVICE TO EXISTING SEWER MAINS AND SERVICES AT ALL TIMES.
- 4 CONTRACTOR SHALL MAINTAIN VEHICULAR ACCESS THROUGH ALL DRIVEWAYS FOR EMERGENCY ACCESS.
- 5 THE CONTRACTOR SHALL REFER TO THE SEWER LAYOUT AND CONTROL PLAN (SHEETS 4-9) FOR APPROXIMATE LOCATION OF 100 YEAR FLOODPLAIN.
- 6 PROPERTY LINES SHOWN ARE APPROXIMATE.

| . ITEM NO | | LINITT | OLIANT |
|----------------|---|----------------|----------------|
| LIEM NO. | DESCRIPTION | UNIT | QUANT. |
| | | | |
| | | | |
| 866 | SEWER MAIN TELEVISION INSPECTION (18" THROUGH 27") | LF | 400 |
| | ·///////////////////////////////////// | $\sim\sim\sim$ | $\sim\sim\sim$ |
| \ \ 901 | 24-INCH CIPP SEWER MAIN REHABILITATION (WATER-CURED) ALL DEPTHS | LF | 400 |
| ,\ ruuu | | $\overline{}$ | $\overline{}$ |
| 910.1 | MANHOLE REHABILITATION | VF | 11 |

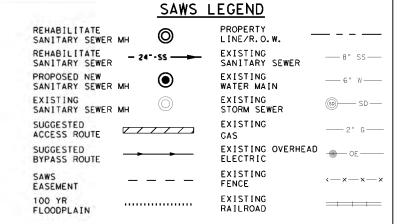

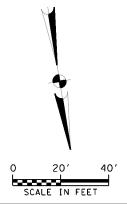

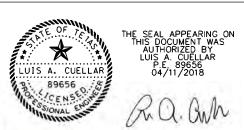

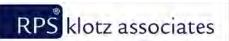

4801 NW Loop 410, Suite 910, San Antonio, Texas 78229 T 210.736,0425 • email@klotz.com • Texas PE Firm Reg. #F-929

| | REVISIO | INS | | |
|-----|------------------------------|-------|----------|--------|
| No. | Revision | Drawn | Approved | Date |
| | | | | |
| | | | | |
| | UPDATED BID ITEM DESCRIPTION | JP | LC | 4/11/1 |

EASTERN SEWERSHED PACKAGE IV

SEWER PLAN - LINE T STA. 82+00 TO STA 86+00

DEVELOPER: SAN ANTONIO WATER SYSTEM
CONT. BUDGET PROJ.

SUBMITTED 1/5/2018

 APPROVED

 MAP No.
 SHEET:
 49 OF 61
 49

 DR. MN CK.
 JOB No.
 17-4527
 49

4/12/2018 9:21:21 AM

SAWS LEGEND REHABILITATE SANITARY SEWER MH LINE/R.O.W. REHABILITATE EXISTING SANITARY SEWER — 8" SS— SANITARY SEWER PROPOSED NEW EXISTING ----6" W----WATER MAIN SANITARY SEWER MH EXISTING EXISTING SANITARY SEWER MH STORM SEWER SUGGESTED EXISTING ____ 2" G___ ACCESS ROUTE GAS SUGGESTED EXISTING OVERHEAD BYPASS ROUTE ELECTRIC EXISTING SAWS <--x--x FENCE EASEMENT EXISTING 100 YR \rightarrow RAILROAD FLOODPLAIN





THE SEAL APPEARING ON THIS DOCUMENT WAS AUTHORIZED BY LUIS A. CUELLAR P.E. 89656 04/11/2018

RPS klotz associates

4801 NW Loop 410, Suite 910, San Antonio, Texas 78229 T 210,736,0425 • email@klotz.com • Texas PE Firm Reg. #F-929

| | RI | VISIONS | | |
|-------|-------------------------|---------|----------|---------|
| No. | Revision | Drawn | Approved | Date |
| | | | | |
| | | | | |
| 1 UPD | ATED BID ITEM DESCRIPTI | ON JP | LC | 4/11/18 |

EASTERN SEWERSHED PACKAGE IV

SEWER PLAN - LINE T STA. 86+00 TO END

SHEET

50

DEVELOPER: SAN ANTONIO WATER SYSTEM

CONT. BUDGET PROJ.
SUBMITTED 1/5/2018


APPROVED _____

SECT. No. SHEET: 50 OF 61
DR. MN CK. JOB No. 17-4527

NOTES

- THE EXISTING UNDERGROUND UTILITIES SHOWN ON THESE PLANS ARE BASED UPON RECORDED INFORMATION ONLY AND ARE APPROXIMATE. THE EXACT LOCATION OF ALL EXISTING UNDERGROUND UTILITIES SHALL BE FIELD VERIFIED BY THE CONTRACTOR. THE CONTRACTOR SHALL CONTACT TEXAS STATE WIDE ONE CALL (811) PRIOR TO THE BEGINNING OF WORK. CONTRACTOR SHALL TAKE FULL RESPONSIBILITY FOR ALL AND ANY DAMAGES THAT MICHT OCCUR BY HIS FAILURE TO ACCURATELY LOCATE ALL EXISTING UNDERGROUND UTILITIES AND PRESERVE
- 2 ALL CONSTRUCTION ACTIVITY SHALL BE MAINTAINED WITHIN THE SAWS EASEMENT UNLESS A TEMPORARY CONSTRUCTION EASEMENT, AGREEMENT, OR RIGHT OF ENTRY PERMITTING IS PROVIDED BY SAWS.
- 3 CONTRACTOR IS RESPONSIBLE FOR MAINTAINING SEWER SERVICE TO EXISTING SEWER MAINS AND SERVICES AT ALL TIMES.
- 4 CONTRACTOR SHALL MAINTAIN VEHICULAR ACCESS THROUGH ALL DRIVEWAYS FOR EMERGENCY ACCESS.
- 5 THE CONTRACTOR SHALL REFER TO THE SEWER LAYOUT AND CONTROL PLAN (SHEETS 4-9) FOR APPROXIMATE LOCATION OF 100 YEAR FLOODPLAIN.
- 6 PROPERTY LINES SHOWN ARE APPROXIMATE.

| ITEM NO. | DESCRIPTION | UNIT | QUANT. |
|----------|--|------|--------|
| 855 | RECONSTRUCTION OF EXISTING MANHOLE | EA | 1 |
| 866 | SEWER MAIN TELEVISION INSPECTION (18" THROUGH 27") | LF | 443 |
| , { 901 | 24-INCH CIPP SEWER MAIN REHABILITATION (WATER-CURED) ALL DEPTHS | LF | 443 |
| 1103 | 24-INCH PIPE POINT REPAIR, ALL DEPTHS | EA | 1 |

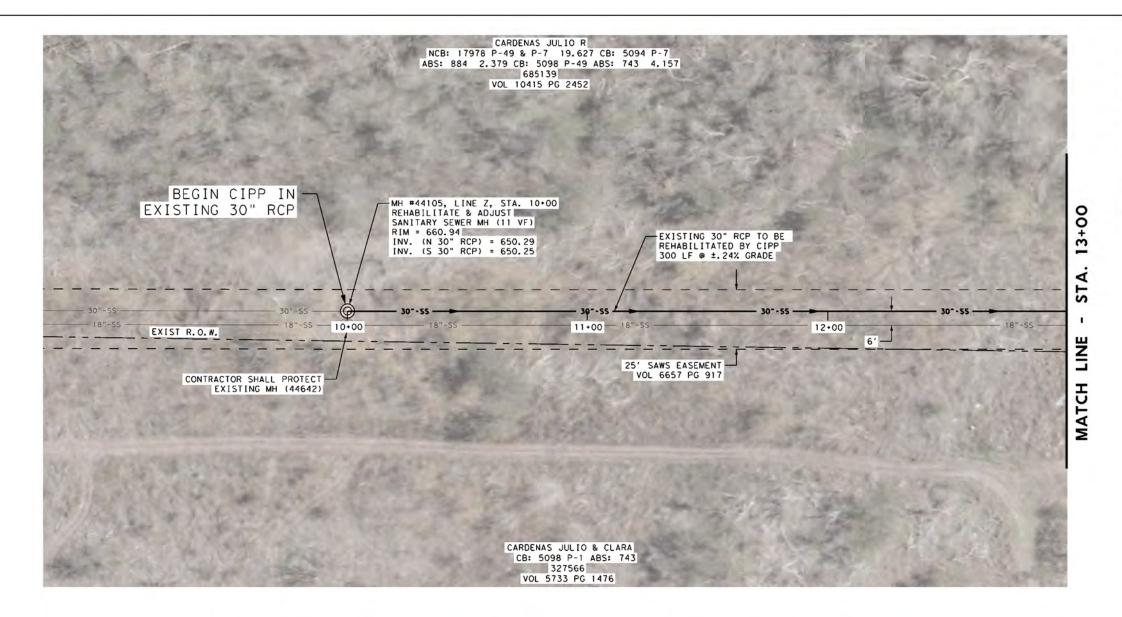

REHABILITATE SANITARY SEWER MH LINE/R.O.W. REHABILITATE EXISTING SANITARY SEWER — 8" SS— SANITARY SEWER PROPOSED NEW EXISTING ----6" W----WATER MAIN SANITARY SEWER MH EXISTING EXISTING SANITARY SEWER MH STORM SEWER SUGGESTED EXISTING ____ 2" G___ ACCESS ROUTE GAS SUGGESTED EXISTING OVERHEAD BYPASS ROUTE ELECTRIC EXISTING SAWS <--x--x FENCE EASEMENT EXISTING 100 YR \rightarrow RAILROAD FLOODPLAIN

SAWS LEGEND








THE SEAL APPEARING ON THIS DOCUMENT WAS AUTHORIZED BY LUIS A. CUELLAR P.E. 89656 04/11/2018

R.a. am

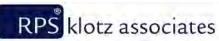

4801 NW Loop 410, Suite 910, San Antonio, Texas 78229 T 210.736.0425 • email@klotz.com • Texas PE Firm Reg. #F-929

| | REVISI | ONS | | |
|----|------------------------------|-------|----------|---------|
| No | Revision | Drawn | Approved | Date |
| | | | | |
| | | | | |
| A | UPDATED BID ITEM DESCRIPTION | JP | LC | 4/11/18 |

| | | 1 |
|------|----|----|
| 57 | 50 | 11 |
| TITI | | 4⊢ |
| UU | , | 7 |

EASTERN SEWERSHED PACKAGE IV

SEWER PLAN - LINE Z BEGIN TO STA. 13+00

DEVELOPER: SAN ANTONIO WATER SYSTEM

CONT. BUDGET PROJ.

SUBMITTED 1/5/2018


 MAP No.
 SHEET:
 51 OF 61
 51

 DR. MN CK.
 JOB No.
 17-4527

NOTES

- THE EXISTING UNDERGROUND UTILITIES SHOWN ON THESE PLANS ARE BASED UPON RECORDED INFORMATION ONLY AND ARE APPROXIMATE. THE EXACT LOCATION OF ALL EXISTING UNDERGROUND UTILITIES SHALL BE FIELD VERIFIED BY THE CONTRACTOR. THE CONTRACTOR SHALL CONTACT TEXAS STATE WIDE ONE CALL (811) PRIOR TO THE BEGINNING OF WORK. CONTRACTOR SHALL TAKE FULL RESPONSIBILITY FOR ALL AND ANY DAMACES THAT MICHIOCCUR BY HIS FAILURE TO ACCURATELY LOCATE ALL EXISTING UNDERGROUND UTILITIES AND PRESERVE
- 2 ALL CONSTRUCTION ACTIVITY SHALL BE MAINTAINED WITHIN THE SAWS EASEMENT UNLESS A TEMPORARY CONSTRUCTION EASEMENT, AGREEMENT, OR RIGHT OF ENTRY PERMITTING IS PROVIDED BY SAWS.
- 3 CONTRACTOR IS RESPONSIBLE FOR MAINTAINING SEWER SERVICE TO EXISTING SEWER MAINS AND SERVICES AT ALL TIMES.
- 4 CONTRACTOR SHALL MAINTAIN VEHICULAR ACCESS THROUGH ALL DRIVEWAYS FOR EMERGENCY ACCESS.
- 5 THE CONTRACTOR SHALL REFER TO THE SEWER LAYOUT AND CONTROL PLAN (SHEETS 4-9) FOR APPROXIMATE LOCATION OF 100 YEAR FLOODPLAIN.
- 6 PROPERTY LINES SHOWN ARE APPROXIMATE.

| ITEM NO. | DESCRIPTION | | UNIT | QUANT. |
|----------------|-----------------------------------|------------------------------------|------|--------|
| 851 . 1 | MANHOLE ADJUSTMENT | | EA | 1 |
| 866 | | INSPECTION (30" AND LARGER) | LF | 300 |
| 901 | 30-INCH CIPP SEWER MAIN DEPTHS | N REHABILITATION (WATER-CURED) ALL | LF | 300 |
| 910.1 | MANHOLE REHABILITATION | | VF | 11 |

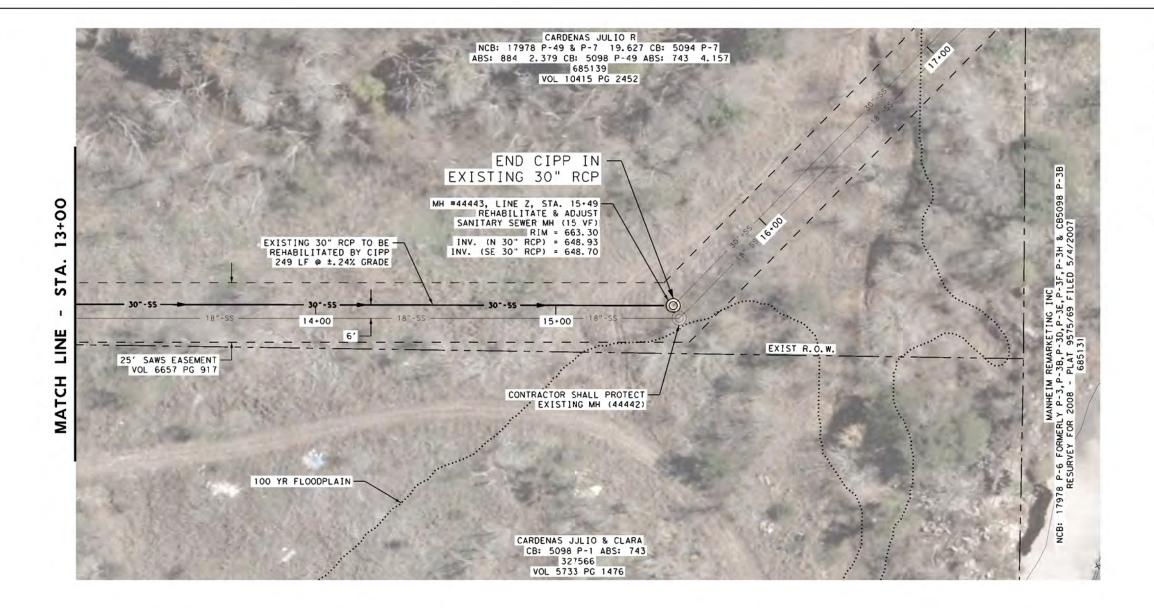

SAWS LEGEND REHABILITATE SANITARY SEWER MH LINE/R.O.W. REHABILITATE EXISTING SANITARY SEWER SANITARY SEWER PROPOSED NEW EXISTING ----6" W----WATER MAIN SANITARY SEWER MH EXISTING EXISTING SANITARY SEWER MH STORM SEWER SUGGESTED EXISTING ____ 2" G___ ACCESS ROUTE GAS SUGGESTED EXISTING OVERHEAD BYPASS ROUTE ELECTRIC EXISTING SAWS <--x--x FENCE EASEMENT EXISTING 100 YR \rightarrow RAILROAD FLOODPLAIN







THE SEAL APPEARING ON THIS DOCUMENT WAS AUTHORIZED BY LUIS A. CUELLAR P.E. 89656 04/11/2018

klotz associates

4801 NW Loop 410, Suite 910, San Antonio, Texas 78229 T 210.736.0425 • email@klotz.com • Texas PE Firm Reg. #F-929

| | REVISI | ONS | | |
|-----|------------------------------|-------|----------|---------|
| No. | Revision | Drawn | Approved | Date |
| | | | | |
| | | | | |
| Δ | UPDATED BID ITEM DESCRIPTION | JP | LC | 4/11/18 |

| | П |
|-------|----|
| 57501 | 1. |
| | - |
| UUKS | |

EASTERN SEWERSHED PACKAGE IV

52

SEWER PLAN - LINE Z STA. 13+00 TO END

SAN ANTONIO WATER SYSTEM DEVELOPER. BUDGET PROJ

SUBMITTED 1/5/2018

APPROVED MAP No. SHEET SHEET: 52 OF 61 JOB No. 17-4527 DR. MN CK.


NOTES


- THE EXISTING UNDERGROUND UTILITIES SHOWN ON THESE PLANS ARE BASED UPON RECORDED INFORMATION ONLY AND ARE APPROXIMATE. THE EXACT LOCATION OF ALL EXISTING UNDERGROUND UTILITIES SHALL BE FIELD VERIFIED BY THE CONTRACTOR. THE CONTRACTOR SHALL CONTACT TEXAS STATE WIDE ONE CALL (811) PRIOR TO THE BEGINNING OF WORK. CONTRACTOR SHALL TAKE FULL RESPONSIBILITY FOR ALL AND ANY DAMAGES THAT MICHI OCCUR BY HIS FAILURE TO ACCURATELY LOCATE ALL EXISTING UNDERGROUND UTILITIES AND PRESERVE
- 2 ALL CONSTRUCTION ACTIVITY SHALL BE MAINTAINED WITHIN THE SAWS EASEMENT UNLESS A TEMPORARY CONSTRUCTION EASEMENT, AGREEMENT, OR RIGHT OF ENTRY PERMITTING IS PROVIDED BY SAWS.
- CONTRACTOR IS RESPONSIBLE FOR MAINTAINING SEWER SERVICE TO EXISTING SEWER MAINS AND SERVICES AT ALL TIMES.
- 4 CONTRACTOR SHALL MAINTAIN VEHICULAR ACCESS THROUGH ALL DRIVEWAYS FOR EMERGENCY ACCESS.
- 5 THE CONTRACTOR SHALL REFER TO THE SEWER LAYOUT AND CONTROL PLAN (SHEETS 4-9) FOR APPROXIMATE LOCATION OF 100 YEAR FLOODPLAIN.
- 6 PROPERTY LINES SHOWN ARE APPROXIMATE.


| ITEM NO. | DESCRIPTION | | UNIT | QUANT. |
|----------|-----------------------------------|------------------------------------|------|--------|
| 851.1 | MANHOLE ADJUSTMENT | | EA | 1 |
| 866 | | INSPECTION (30" AND LARGER) | LF | 249 |
| A \ 901 | 30-INCH CIPP SEWER MAIN DEPTHS | N REHABILITATION (WATER-CURED) ALL | LF | 249 |
| 910.1 | MANHOLE REHABILITATION | | VF | 15 |

REHABILITATE SANITARY SEWER MH LINE/R.O.W. REHABILITATE EXISTING SANITARY SEWER — 8" SS — SANITARY SEWER PROPOSED NEW EXISTING ----6" W----WATER MAIN SANITARY SEWER MH EXISTING EXISTING SANITARY SEWER MH STORM SEWER SUGGESTED EXISTING ____ 2" G___ ACCESS ROUTE GAS SUGGESTED EXISTING OVERHEAD BYPASS ROUTE ELECTRIC EXISTING SAWS <--x--x FENCE EASEMENT EXISTING 100 YR \rightarrow RAILROAD FLOODPLAIN

SAWS LEGEND

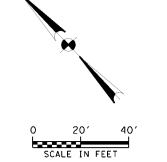

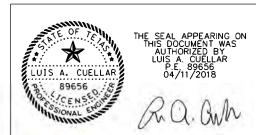

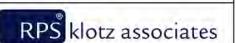

4801 NW Loop 410, Suite 910, San Antonio, Texas 78229 T 210.736,0425 • email@klotz.com • Texas PE Firm Reg. #F-929

| | REVISI | ONS | | |
|----------|------------------------------|-------|----------|--------|
| No. | Revision | Drawn | Approved | Date |
| | | | | |
| | | | | |
| <u> </u> | UPDATED BID ITEM DESCRIPTION | JP | LC | 4/11/1 |

| | П |
|----------------|---|
| 577 | |
| | + |
| $UU \subset S$ | |

PACKAGE IV

SEWER PLAN - LINE Z BEGIN TO STA 22+00

DEVELOPER: SAN ANTONIO WATER SYSTEM
CONT. BUDGET PROJ.

SUBMITTED 1/5/2018

 MAP No.
 SHEET:
 53 OF 61
 53

 DR. MN CK.
 JOB No.
 17-4527

NOTES

- THE EXISTING UNDERGROUND UTILITIES SHOWN ON THESE PLANS ARE BASED UPON RECORDED INFORMATION ONLY AND ARE APPROXIMATE. THE EXACT LOCATION OF ALL EXISTING UNDERGROUND UTILITIES SHALL BE FIELD VERIFIED BY THE CONTRACTOR. THE CONTRACTOR SHALL CONTACT TEXAS STATE WIDE ONE CALL (811) PRIOR TO THE BEGINNING OF WORK. CONTRACTOR SHALL TAKE FULL RESPONSIBILITY FOR ALL AND ANY DAMAGES THAT MICHI OCCUR BY HIS FAILURE TO ACCURATELY LOCATE ALL EXISTING UNDERGROUND UTILITIES AND PRESERVE
- 2 ALL CONSTRUCTION ACTIVITY SHALL BE MAINTAINED WITHIN THE SAWS EASEMENT UNLESS A TEMPORARY CONSTRUCTION EASEMENT, AGREEMENT, OR RIGHT OF ENTRY PERMITTING IS PROVIDED BY SAWS.
- 3 CONTRACTOR IS RESPONSIBLE FOR MAINTAINING SEWER SERVICE TO EXISTING SEWER MAINS AND SERVICES AT ALL TIMES.
- 4 CONTRACTOR SHALL MAINTAIN VEHICULAR ACCESS THROUGH ALL DRIVEWAYS FOR EMERGENCY ACCESS.
- 5 THE CONTRACTOR SHALL REFER TO THE SEWER LAYOUT AND CONTROL PLAN (SHEETS 4-9) FOR APPROXIMATE LOCATION OF 100 YEAR FLOODPLAIN.
- 6 PROPERTY LINES SHOWN ARE APPROXIMATE.

| ITEM NO. | DESCRIPTION | | UNIT | QUANT. |
|----------|------------------------|------------------------------------|------|--------|
| 851.1 | MANHOLE ADJUSTMENT | | EA | 1 |
| 866 | | INSPECTION (30" AND LARGER) | LF | 286 |
| 901 | | N REHABILITATION (WATER-CURED) ALL | LF | 286 |
| 910.1 | MANHOLE REHABILITATION | | VF | 13.5 |



| ITEM NO. | DESCRIPTION | | UNIT | QUANT. |
|----------|--------------------------------|---|----------------|---------------|
| • | | | | |
| | | | | |
| 851.1 | MANHOLE ADJUSTMENT | | EA | 1 |
| | | | | |
| 866 | SEWER MAIN TELEVISION ! | NSPECTION (30" AND LARGER) | LF | 400 |
| ~~~~~ | | ~~~~~~~~~~~~~~~~~~~~~~~~~~~~~~~~~~~~~~~ | $\sim\sim\sim$ | $\sim\sim$ |
| 201 | 30-INCH CIPP SEWER MAIN DEPTHS | REHABILITATION (WATER-CURED) ALL | LF | 400 |
| /\ | | | $\overline{}$ | $\overline{}$ |
| 910.1 | MANHOLE REHABILITATION | | VF | 19.5 |

NOTES

- THE EXISTING UNDERGROUND UTILITIES SHOWN ON THESE PLANS ARE BASED UPON RECORDED INFORMATION ONLY AND ARE APPROXIMATE. THE EXACT LOCATION OF ALL EXISTING UNDERGROUND UTILITIES SHALL BE FIELD VERIFIED BY THE CONTRACTOR. THE CONTRACTOR SHALL CONTACT TEXAS STATE WIDE ONE CALL (811) PRIOR TO THE BEGINNING OF WORK. CONTRACTOR SHALL TAKE FULL RESPONSIBILITY FOR ALL AND ANY DAMAGES THAT MICHI OCCUR BY HIS FAILURE TO ACCURATELY LOCATE ALL EXISTING UNDERGROUND UTILITIES AND PRESERVE
- 2 ALL CONSTRUCTION ACTIVITY SHALL BE MAINTAINED WITHIN THE SAWS EASEMENT UNLESS A TEMPORARY CONSTRUCTION EASEMENT, AGREEMENT, OR RIGHT OF ENTRY PERMITTING IS PROVIDED BY SAWS.
- CONTRACTOR IS RESPONSIBLE FOR MAINTAINING SEWER SERVICE TO EXISTING SEWER MAINS AND SERVICES AT ALL TIMES.
- 4 CONTRACTOR SHALL MAINTAIN VEHICULAR ACCESS THROUGH ALL DRIVEWAYS FOR EMERGENCY ACCESS.
- 5 THE CONTRACTOR SHALL REFER TO THE SEWER LAYOUT AND CONTROL PLAN (SHEETS 4-9) FOR APPROXIMATE LOCATION OF 100 YEAR FLOODPLAIN.
- 6 PROPERTY LINES SHOWN ARE APPROXIMATE.

SAWS LEGEND

REHABILITATE SANITARY SEWER MH REHABILITATE SANITARY SEWER PROPOSED NEW SANITARY SEWER MH

SANITARY SEWER MH

EXISTING

SUGGESTED

SUGGESTED

EASEMENT

FLOODPLAIN

100 YR

SAWS

ACCESS ROUTE

BYPASS ROUTE

EXISTING SANITARY SEWER EXISTING WATER MAIN EXISTING STORM SEWER

LINE/R.O.W.

......

EXISTING

GAS EXISTING OVERHEAD ELECTRIC

EXISTING

FENCE

<--x--x EXISTING \rightarrow RAILROAD

----6" W----

____ 2" G___

201 SCALE IN FEET



THE SEAL APPEARING ON THIS DOCUMENT WAS AUTHORIZED BY LUIS A. CUELLAR P.E. 89656 04/11/2018

klotz associates

4801 NW Loop 410, Suite 910, San Antonio, Texas 78229 T 210.736.0425 • email@klotz.com • Texas PE Firm Reg. #F-929

| / UF | PDATED BID ITEM DESCRIPTION | JP JP | LC | 4/11/18 |
|------|-----------------------------|-------|----------|---------|
| | | | | - 1 |
| + | | | | |
| | | | | |
| No. | Revision | Drown | Approved | Date |

REVISIONS

EASTERN SEWERSHED PACKAGE IV

SEWER PLAN - LINE Z STA. 22+00 TO STA. 26+00

SHEET


54


DEVELOPER. SAN ANTONIO WATER SYSTEM BUDGET PROJ


SUBMITTED 1/5/2018 APPROVED

MAP No. SHEET: 54 OF 61 JOB No. 17-4527 DR. MN CK.

SAWS LEGEND REHABILITATE SANITARY SEWER MH LINE/R.O.W. EXISTING SANITARY SEWER REHABILITATE — 8" SS— SANITARY SEWER PROPOSED NEW EXISTING ----6" W----WATER MAIN SANITARY SEWER MH EXISTING EXISTING SANITARY SEWER MH STORM SEWER SUGGESTED EXISTING ____ 2" G___ ACCESS ROUTE GAS SUGGESTED EXISTING OVERHEAD BYPASS ROUTE ELECTRIC EXISTING SAWS <--x--x FENCE EASEMENT EXISTING 100 YR \rightarrow RAILROAD FLOODPLAIN

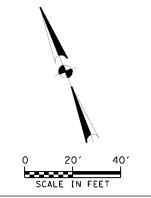

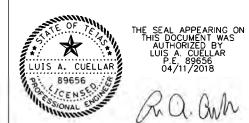

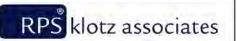

4801 NW Loop 410, Suite 910, San Antonio, Texas 78229 T 210.736.0425 • email@klotz.com • Texas PE Firm Reg. #F-929

| - | REVISI | DNC. | 1,77 | |
|----------|------------------------------|-------|----------|-------|
| No. | Revision | Drawn | Approved | Date |
| | | | | |
| | | | | |
| <u> </u> | UPDATED BID ITEM DESCRIPTION | JP | LC | 4/11/ |

| 57 | 50.11 |
|------|-------|
| HILL | |
| LUU | 5 |

APPROVED

EASTERN SEWERSHED PACKAGE IV

SEWER PLAN - LINE Z STA. 17+00 TO END

DEVELOPER: SAN ANTONIO WATER SYSTEM
CONT. BUDGET PROJ.

SUBMITTED 1/5/2018

 MAP No.
 SHEET

 SECT. No.
 SHEET: 55 OF 61

 DR. MN CK.
 JOB No. 17-4527

NOTES

- THE EXISTING UNDERGROUND UTILITIES SHOWN ON THESE PLANS ARE BASED UPON RECORDED INFORMATION ONLY AND ARE APPROXIMATE. THE EXACT LOCATION OF ALL EXISTING UNDERGROUND UTILITIES SHALL BE FIELD VERIFIED BY THE CONTRACTOR. THE CONTRACTOR SHALL CONTACT TEXAS STATE WIDE ONE CALL (811) PRIOR TO THE BEGINNING OF WORK. CONTRACTOR SHALL TAKE FULL RESPONSIBILITY FOR ALL AND ANY DAMAGES THAT MICHT OCCUR BY HIS FAILURE TO ACCURATELY LOCATE ALL EXISTING UNDERGROUND UTILITIES AND PRESERVE
- 2 ALL CONSTRUCTION ACTIVITY SHALL BE MAINTAINED WITHIN THE SAWS EASEMENT UNLESS A TEMPORARY CONSTRUCTION EASEMENT, AGREEMENT, OR RIGHT OF ENTRY PERMITTING IS PROVIDED BY SAWS.
- 3 CONTRACTOR IS RESPONSIBLE FOR MAINTAINING SEWER SERVICE TO EXISTING SEWER MAINS AND SERVICES AT ALL TIMES.
- 4 CONTRACTOR SHALL MAINTAIN VEHICULAR ACCESS THROUGH ALL DRIVEWAYS FOR EMERGENCY ACCESS.
- 5 THE CONTRACTOR SHALL REFER TO THE SEWER LAYOUT AND CONTROL PLAN (SHEETS 4-9) FOR APPROXIMATE LOCATION OF 100 YEAR FLOODPLAIN.
- 6 PROPERTY LINES SHOWN ARE APPROXIMATE.

ESTIMATED QUANTITIES

| ITEM NO. | DESCRIPTION | | UNIT | QUANT. |
|----------|------------------------|----------------------------------|------|--------|
| 851.1 | MANHOLE ADJUSTMENT | | EA | 1 |
| 866 | | NSPECTION (30" AND LARGER) | LF | 147 |
| 901 | | REHABILITATION (WATER-CURED) ALL | LF | 147 |
| 910.1 | MANHOLE REHABILITATION | | VF | 17 |

4/12/2018 9:27:25 AM T:\\07555 2017 Binelines End Svc PS-\00035-07 W01\\07 00 CADD\ESPA

4/12/2018 9:27:25 AM