

ADDENDUM NO. 3

Date: 21 October 2011

San Antonio Water System

Project Name: **Olmos Basin Central Watershed Sewer Relief Line (C-3), Reaches 1 to 4**

Project No.: **08-2512**

Solicitation No.: **B-11-051-CM**

This addendum, applicable to work referenced above, is an amendment to the bidding documents and as such will be a part of and included in the Contract Documents. Acknowledge receipt of this addendum by entering the addendum number and issue date in the space provided in submitted copies of the proposal.

A. Bidding and Contract Requirement Revisions:

Item 1: Invitation to Bidders, Page IV-1:

- a) The bid opening date has been changed to Thursday, October 27, 2011. Note that there is no change to the location that bids will be received.

DELETE first sentence of fifth paragraph that reads:

“Sealed bids will be received by the Contract Administration Division, 2800 U.S. Hwy 281 North, Customer Center Building, Suite 171, San Antonio, Texas 78212, until **2:00 p.m., October 25, 2011.**”

and REPLACE with the following:

“Sealed bids will be received by the Contract Administration Division, 2800 U.S. Hwy 281 North, Customer Center Building, Suite 171, San Antonio, Texas 78212, until **2:00 p.m., October 27, 2011.**”

Item 2: Special Conditions, Page SC-2

- a) ADD the following special condition:

“10. For construction at the Brackenridge Park Golf Course (Refer to Sheet C-110), construction will not be allowed during weekends. Construction during weekdays, Monday through Friday, will not be allowed between the hours of 8:00 AM and 3:00 PM. Note that work related to the existing irrigation system shall conform to the City of San Antonio Standard Specifications for Construction Item 552, Removing and Relocating Irrigation Systems and the Special Provisions to Item 552 included as part of the Contract Documents. Note that the irrigation work must be performed under the supervision of a person possessing an irrigator’s license issued by the TCEQ. Contractor shall provide documentation of this license.”

Item 3: Specification Section 02504, Fiberglass Reinforced Polymer Mortar Pipe

- a) DELETE Article 1.06 E. 2. that reads “All pipe shall be produced by one manufacturer.”

B. Drawing Revisions:

Item 1: Sheet C-110 – Remove and replace Sheet C-110 with the revised Sheet C-110 attached to this addendum. Revisions include:

- a) Aerial background has been updated. Note the newer aerial shows recent improvements at the golf course.
b) Alignment of proposed lateral reroute was adjusted as shown on Revised Sheet C-110.

This Addendum, including these 2 pages, is 3 pages with attachments in its entirety.

Attachment(s):

Sheet C-110 (1 page)

Each bidder is requested to acknowledge receipt of this Addendum No. 3 by his/her signature affixed hereto and to file same with and attached to his/her bid.



Maridel Reyes Jimenez 10/21/11

Approved by ENGINEER

WESTON SOLUTIONS, INC., TEXAS REGISTERED ENGINEERING FIRM F-3123



The undersigned acknowledges receipt of this Addendum No. 3 and the bid submitted herewith is in accordance with the information and stipulations set forth.

Date

Signature of Bidder

END OF ADDENDUM

- NOTE:
1. CONTRACTOR SHALL RELOCATE EXISTING 6" DIA. S.S. GOLF COURSE LINE (VERIFY LOCATION AND DEPTH) WITH 6" DIA. PVC ASTM D-3034 AND CONNECT TO GOLF COURSE CLUB HOUSE SERVICE (APPROXIMATELY 1340.00 L.F. AT 0.50% MIN SLOPE)
 2. CONTRACTOR SHALL MAINTAIN EXISTING FLOW DURING CONSTRUCTION.
 3. CONTRACTOR SHALL SUBMIT PLAN FOR 6" S.S. SERVICE LINE RELOCATION FOR APPROVAL.
 4. CONTRACTOR SHALL RESTORE SPRINKLER SYSTEM TO PRE-CONSTRUCTION OR BETTER CONDITION (NSP).
 5. CONTRACTOR SHALL REVEGETATE ALL DISTURBED AREAS WITH IN-KIND SODDING.
 6. CONTRACTOR SHALL BE RESPONSIBLE FOR PROTECTING EXISTING FEATURES DURING CONSTRUCTION. ANY FEATURES DAMAGED SHALL BE REPAIRED OR REPLACED AT CONTRACTOR'S EXPENSE.
 7. UNDERGROUND UTILITIES INCLUDING BUT NOT LIMITED TO WATER, GAS, FIBER OPTICS AND TELECOMMUNICATIONS MAY EXIST WITHIN THE WORK AREA. CONTRACTOR SHALL BE RESPONSIBLE FOR VERIFYING THE LOCATION OF ALL UTILITIES. CONTRACTOR SHALL BE RESPONSIBLE FOR DAMAGE TO UTILITIES CAUSED BY CONTRACTORS OPERATIONS.

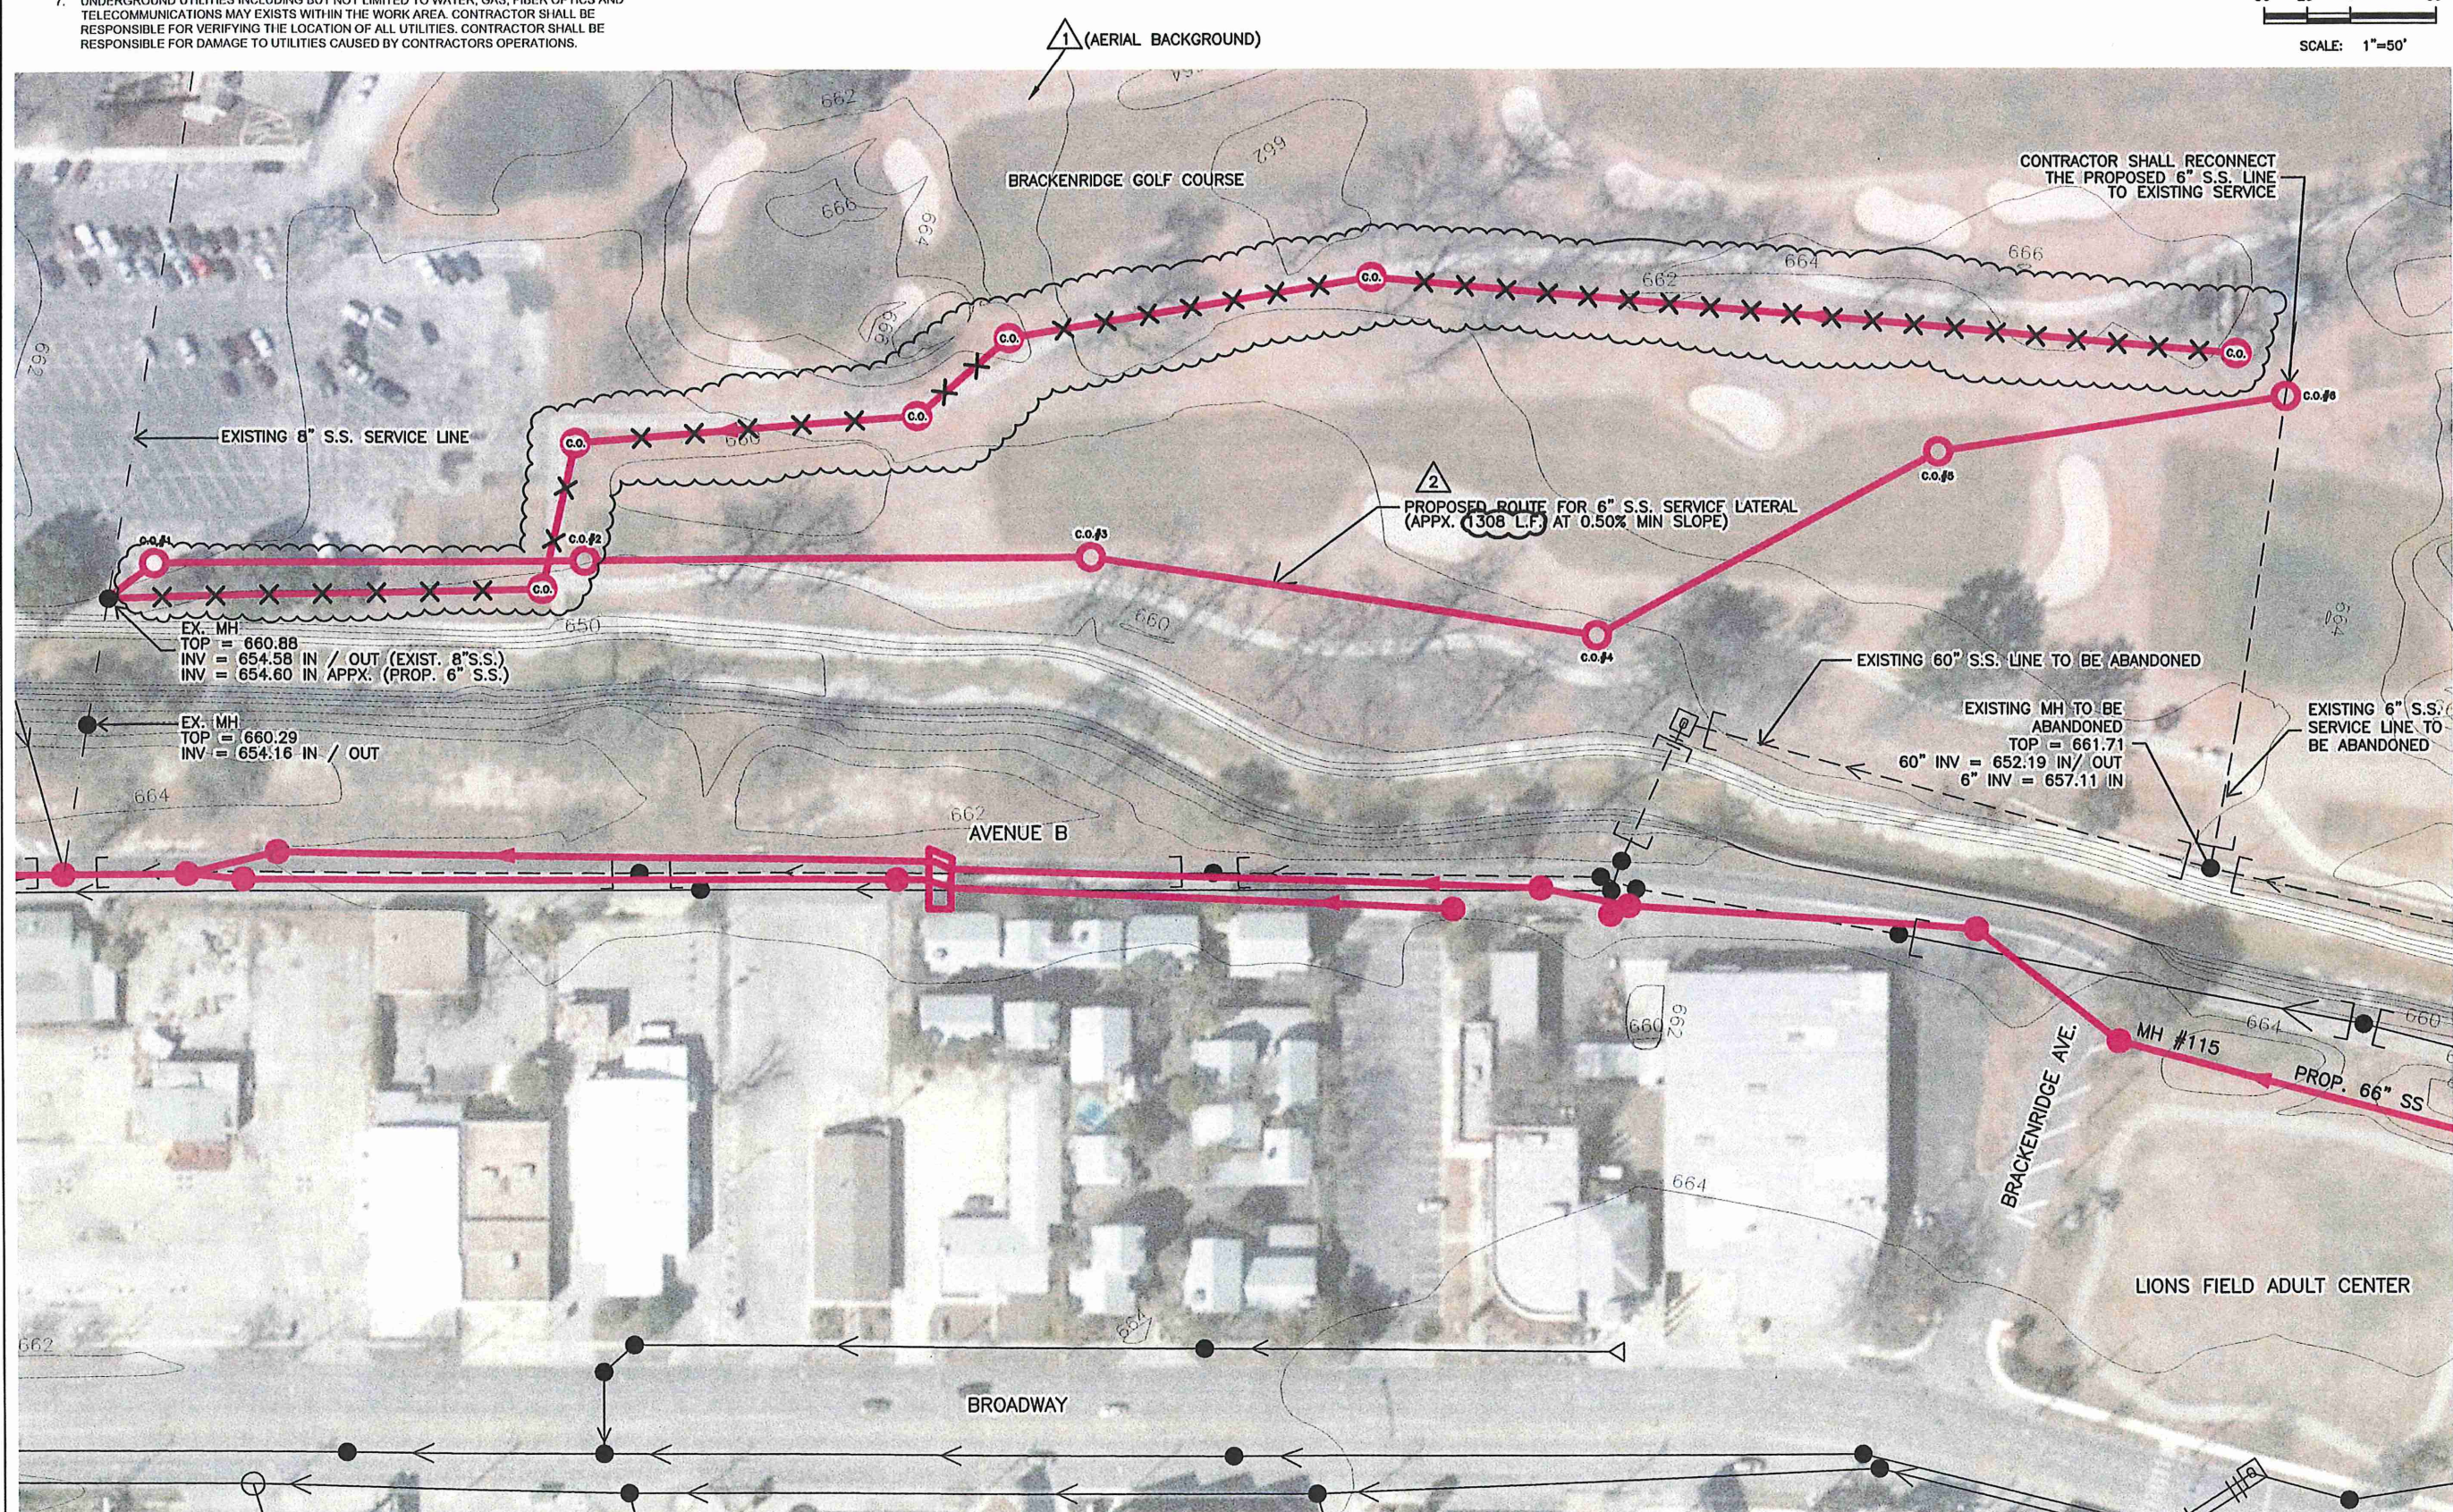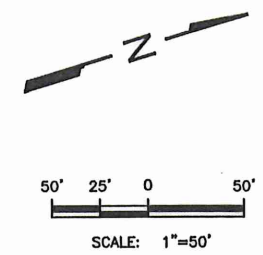

PLAN VIEW

NO.	DATE	REVISION DESCRIPTION
1	10-20-11	Addressum 3
2	10-20-11	Addressum 3

WESTON SOLUTIONS, INC.
 70 NE LOOP 410, SUITE 600
 SAN ANTONIO, TEXAS 78216-5842
 TEXAS REGISTERED ENGINEERING FIRM F-3123

SAWS OLIVOS BASIN CENTRAL WATERSHED
 SEWER RELIEF LINE (C-3) REACHES 1-4
 PROPOSED ROUTE FOR 6" S.S.
 SERVICE LATERAL

San Antonio Water System

NOTES	INITIALS	DATE
DESIGNED BY	AH	10/20/11
REVIEWED BY	MRJ	10/20/11

SCALE: AS SHOWN

SHEET NO. **C-110**
39 OF 123