




- NOTES:
1. THE C.M.S. HAS A COMPUTER FLOOR. ALL CABLING, DATA HIGHWAY, POWER TO BE INSTALLED UNDERNEATH FLOOR.
  2. POWER FOR NEW DCS EQUIPMENT IS TO BE POWERED FROM EXISTING LINE VOLTAGE REGULATORS.
  3. CONNECT GROUND FOR NEW VXi AND WAX TO EXISTING GROUND BUS IN HSR 166.

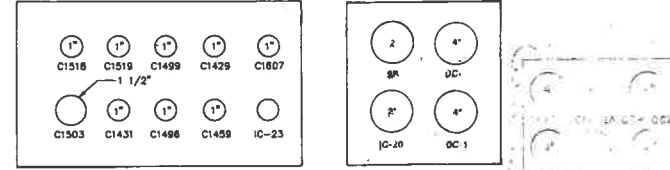

SECTION 2/2 (REVISED)  
NOT TO SCALE

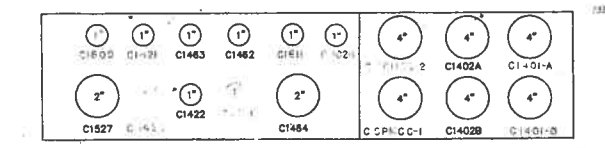

SECTION 3/2 (REVISED)  
NOT TO SCALE

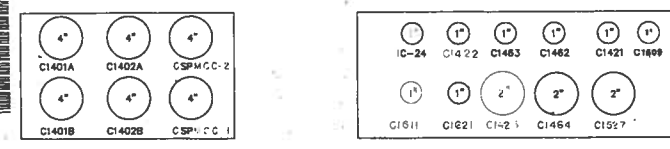

SECTION 4/2 (REVISED)  
NOT TO SCALE

PARTIAL PLAN  
SCALE: 1" = 30'

- NOTES:
1. SEE S-16 FOR EXPOSED CONDUIT ROUTING TO SCRUBBERS NO. 1 & 2.
  2. CONTRACTOR SHALL COORDINATE HEAT TRACING REQUIREMENTS IN THE PIPE RACK FOR SCRUBBER AREA. SEE HEAT TRACING SPECIFICATIONS.
  3. CONDUITS C1503, C1518, C1519, C1520, C1527, C1530, IC20, 23, AND 24 TO BE RIGID CONDUIT, INCLUDING UNDERGROUND DUCT BANK. AT EMB#11 AND #42 CONTRACTOR IS TO PROVIDE ISOLATION PROTECTION FOR C1527, AND IC-24 BY USE OF JUNCTION BOXES AND FLEX CONDUIT.
  4. AT THE C.M.S. THE CONTRACTOR IS TO CORE DRILL THROUGH SOUTH WALL TO EXPOSE 10\"/>

CONFORMED




NO.	BY	DATE	REVISIONS
2	RAN	3/28/80	INCORPORATED ADDENDUM








DEPARTMENT OF ENVIRONMENTAL MANAGEMENT  
SAN ANTONIO, TEXAS  
DOS RIOS FACILITIES  
ODOR CONTROL EXPANSION & MODIFICATIONS

ELECTRICAL  
PARTIAL SITE PLAN,  
SECTIONS AND DETAILS  
SCALE AS NOTED

MALCOLM PIRNIE, INC.  
DATE: \_\_\_\_\_  
E SHEET 2 OF 9  
DWG. NO. 94108-88-022-2

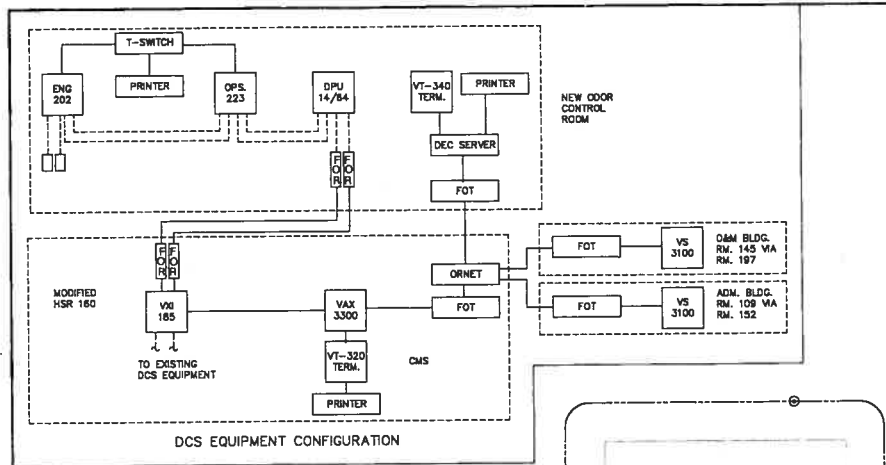

- NOTES:
1. THE FOLLOWING CONDUITS SHALL BE CAPPED AND EXTENDED 2 FEET PAST EAST WALL: C1432, C1434, C1451, C1455, C1457, C1473, C1474, C1475, C1478, C1479, C1480, C1501, C1531, C1618. EACH CONDUIT SHALL HAVE A STAINLESS STEEL TAG BEARING ITS CONDUIT NUMBER FASTENED BY STAINLESS STEEL WIRE.
  2. MINIMUM SIZE OF LIGHTING PANEL CIRCUIT WIRING LEAVING THE BUILDING SHALL BE #10 AWG.
  3. THE FOLLOWING CONDUITS ARE ROUTED TO THE DCS TERMINATION CABINET: C1467, C1468, C1469, C1474, C1475, C1478, C1480, C1481, C1482, C1484, C1485, C1486, C1488, C1494, C1501, C1502, C1503, C1518, C1519, C1520, C1500, C1530, C1531, C1804, C1805, C1808, C1814, AND C1818. APPROX. ENTRY INTO DCS TERM. CABINET IS 13" X 21". CONTRACTOR SHALL KEEP ANALOG WIRES SEPARATE FROM POWER AND CONTROL WIRES. ONLY CONDUITS C1484, C1820C, DC-1, DC-2 AND DC-4 SHALL BE ROUTED TO THE ELECTRONIC SIDE OF DPU 14/84. THE CONTRACTOR SHALL OBSERVE THE MINIMUM RECOMMENDED BENDING RADIUS BY THE MANUFACTURER WHEN HANDLING AND INSTALLING THE DATA HIGHWAY, BOTH COAXIAL AND FIBER OPTICS CABLES.
  4. THE DCS EQUIPMENT GROUNDING SYSTEM SHALL BE A SEPARATE GROUND SYSTEM AND SHALL BE STRICTLY INSTALLED ACCORDING TO MANUFACTURER'S REQUIREMENTS.

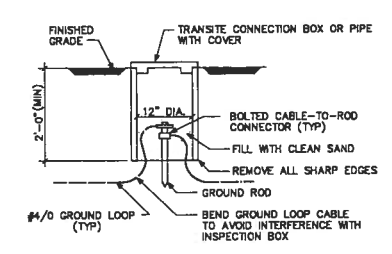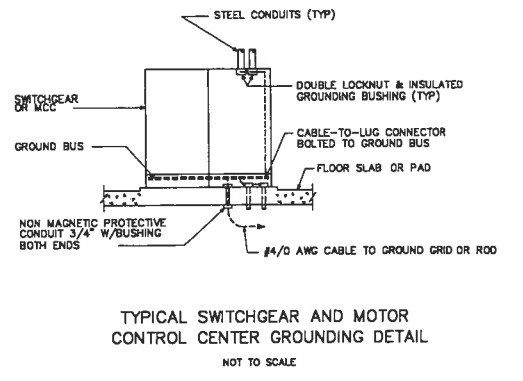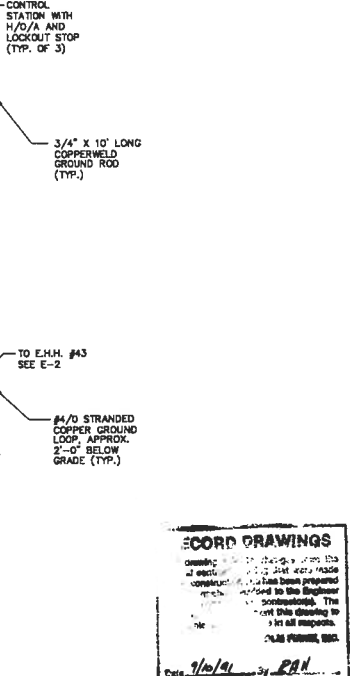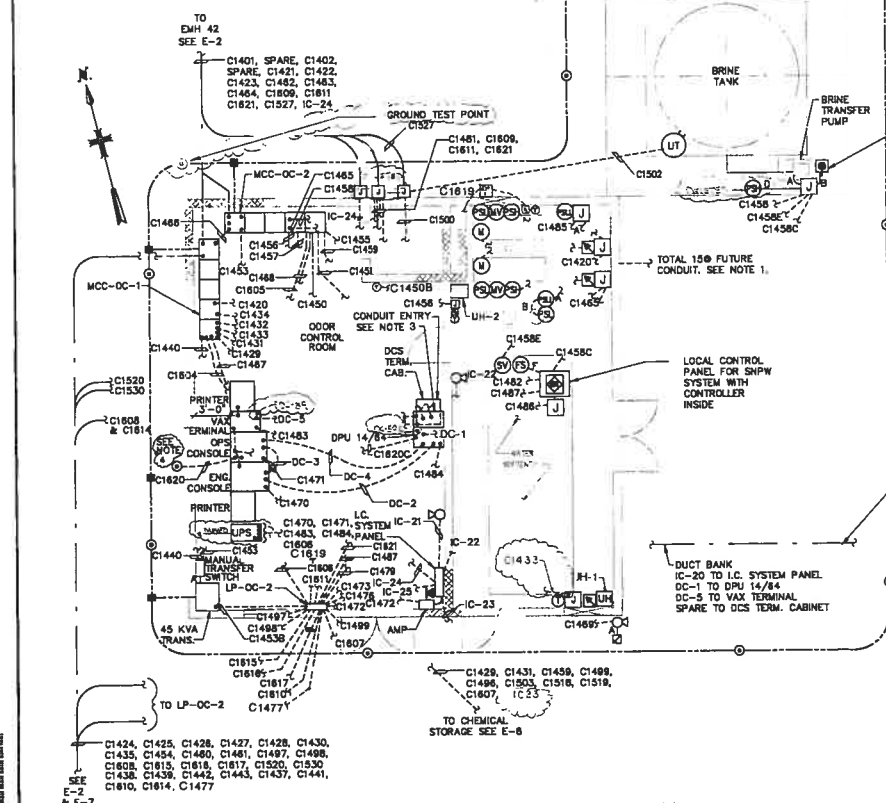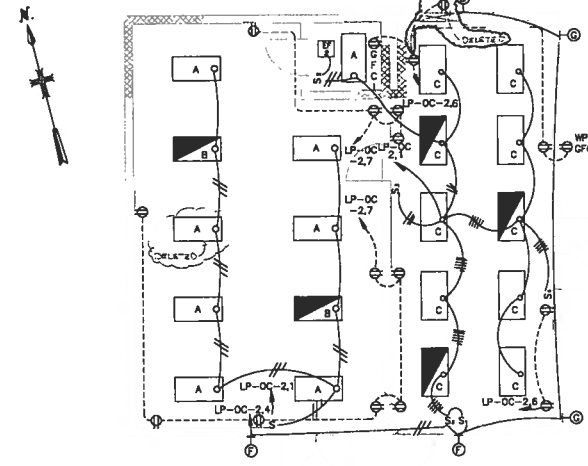

TYPE OF CONNECTION	BOLTED OR COMPRESSION		WELDED
	BURNBY CAT#	TAM CAT#	
CABLE TO LUG	YA	54000 SERIES	LA
CABLE TO ROD	-	53000 SERIES	GT
ROD TO CABLE	GAR	-	GR
CABLE TO CABLE	GX	53000 SERIES	TV OR TA
CABLE TO PIPE	-	-	HA OR VS
CABLE TO PIPE OR CONDUIT	GAR OR GD	3900 SERIES	-
CABLE TO FLAT SURFACE	GB	-	HA OR HS
BRAD TO PIPE	GG	-	-

SEE E-2 & E-7  
 C1424, C1425, C1426, C1427, C1428, C1430, C1435, C1454, C1460, C1481, C1487, C1488, C1808, C1813, C1816, C1817, C1520, C1530, C1438, C1439, C1442, C1443, C1437, C1441, C1815, C1816, C1817, C1477

POWER PLAN  
 SCALE: 3/16" = 1'-0"

LIGHTING PLAN  
 SCALE: 3/16" = 1'-0"

CORD DRAWINGS  
 Date: 9/10/91 by P.H.

DR 88-8501



NO.	DATE	REVISIONS
1	3/28/90	INCORPORATED ADDENDUM




DEPARTMENT OF ENVIRONMENTAL MANAGEMENT  
 SAN ANTONIO, TEXAS  
 DOS RIOS FACILITIES  
 ODOR CONTROL EXPANSION & MODIFICATIONS

CONFORMED

ODOR CONTROL BUILDING  
 POWER AND LIGHTING PLAN  
 AND GROUNDING DETAILS  
 SCALE AS NOTED

MALCOLM PIRNIE, INC.  
 DATE: DECEMBER 1989  
 E SHEET 6 OF 8  
 DWG. NO. 8410M-89-888-2

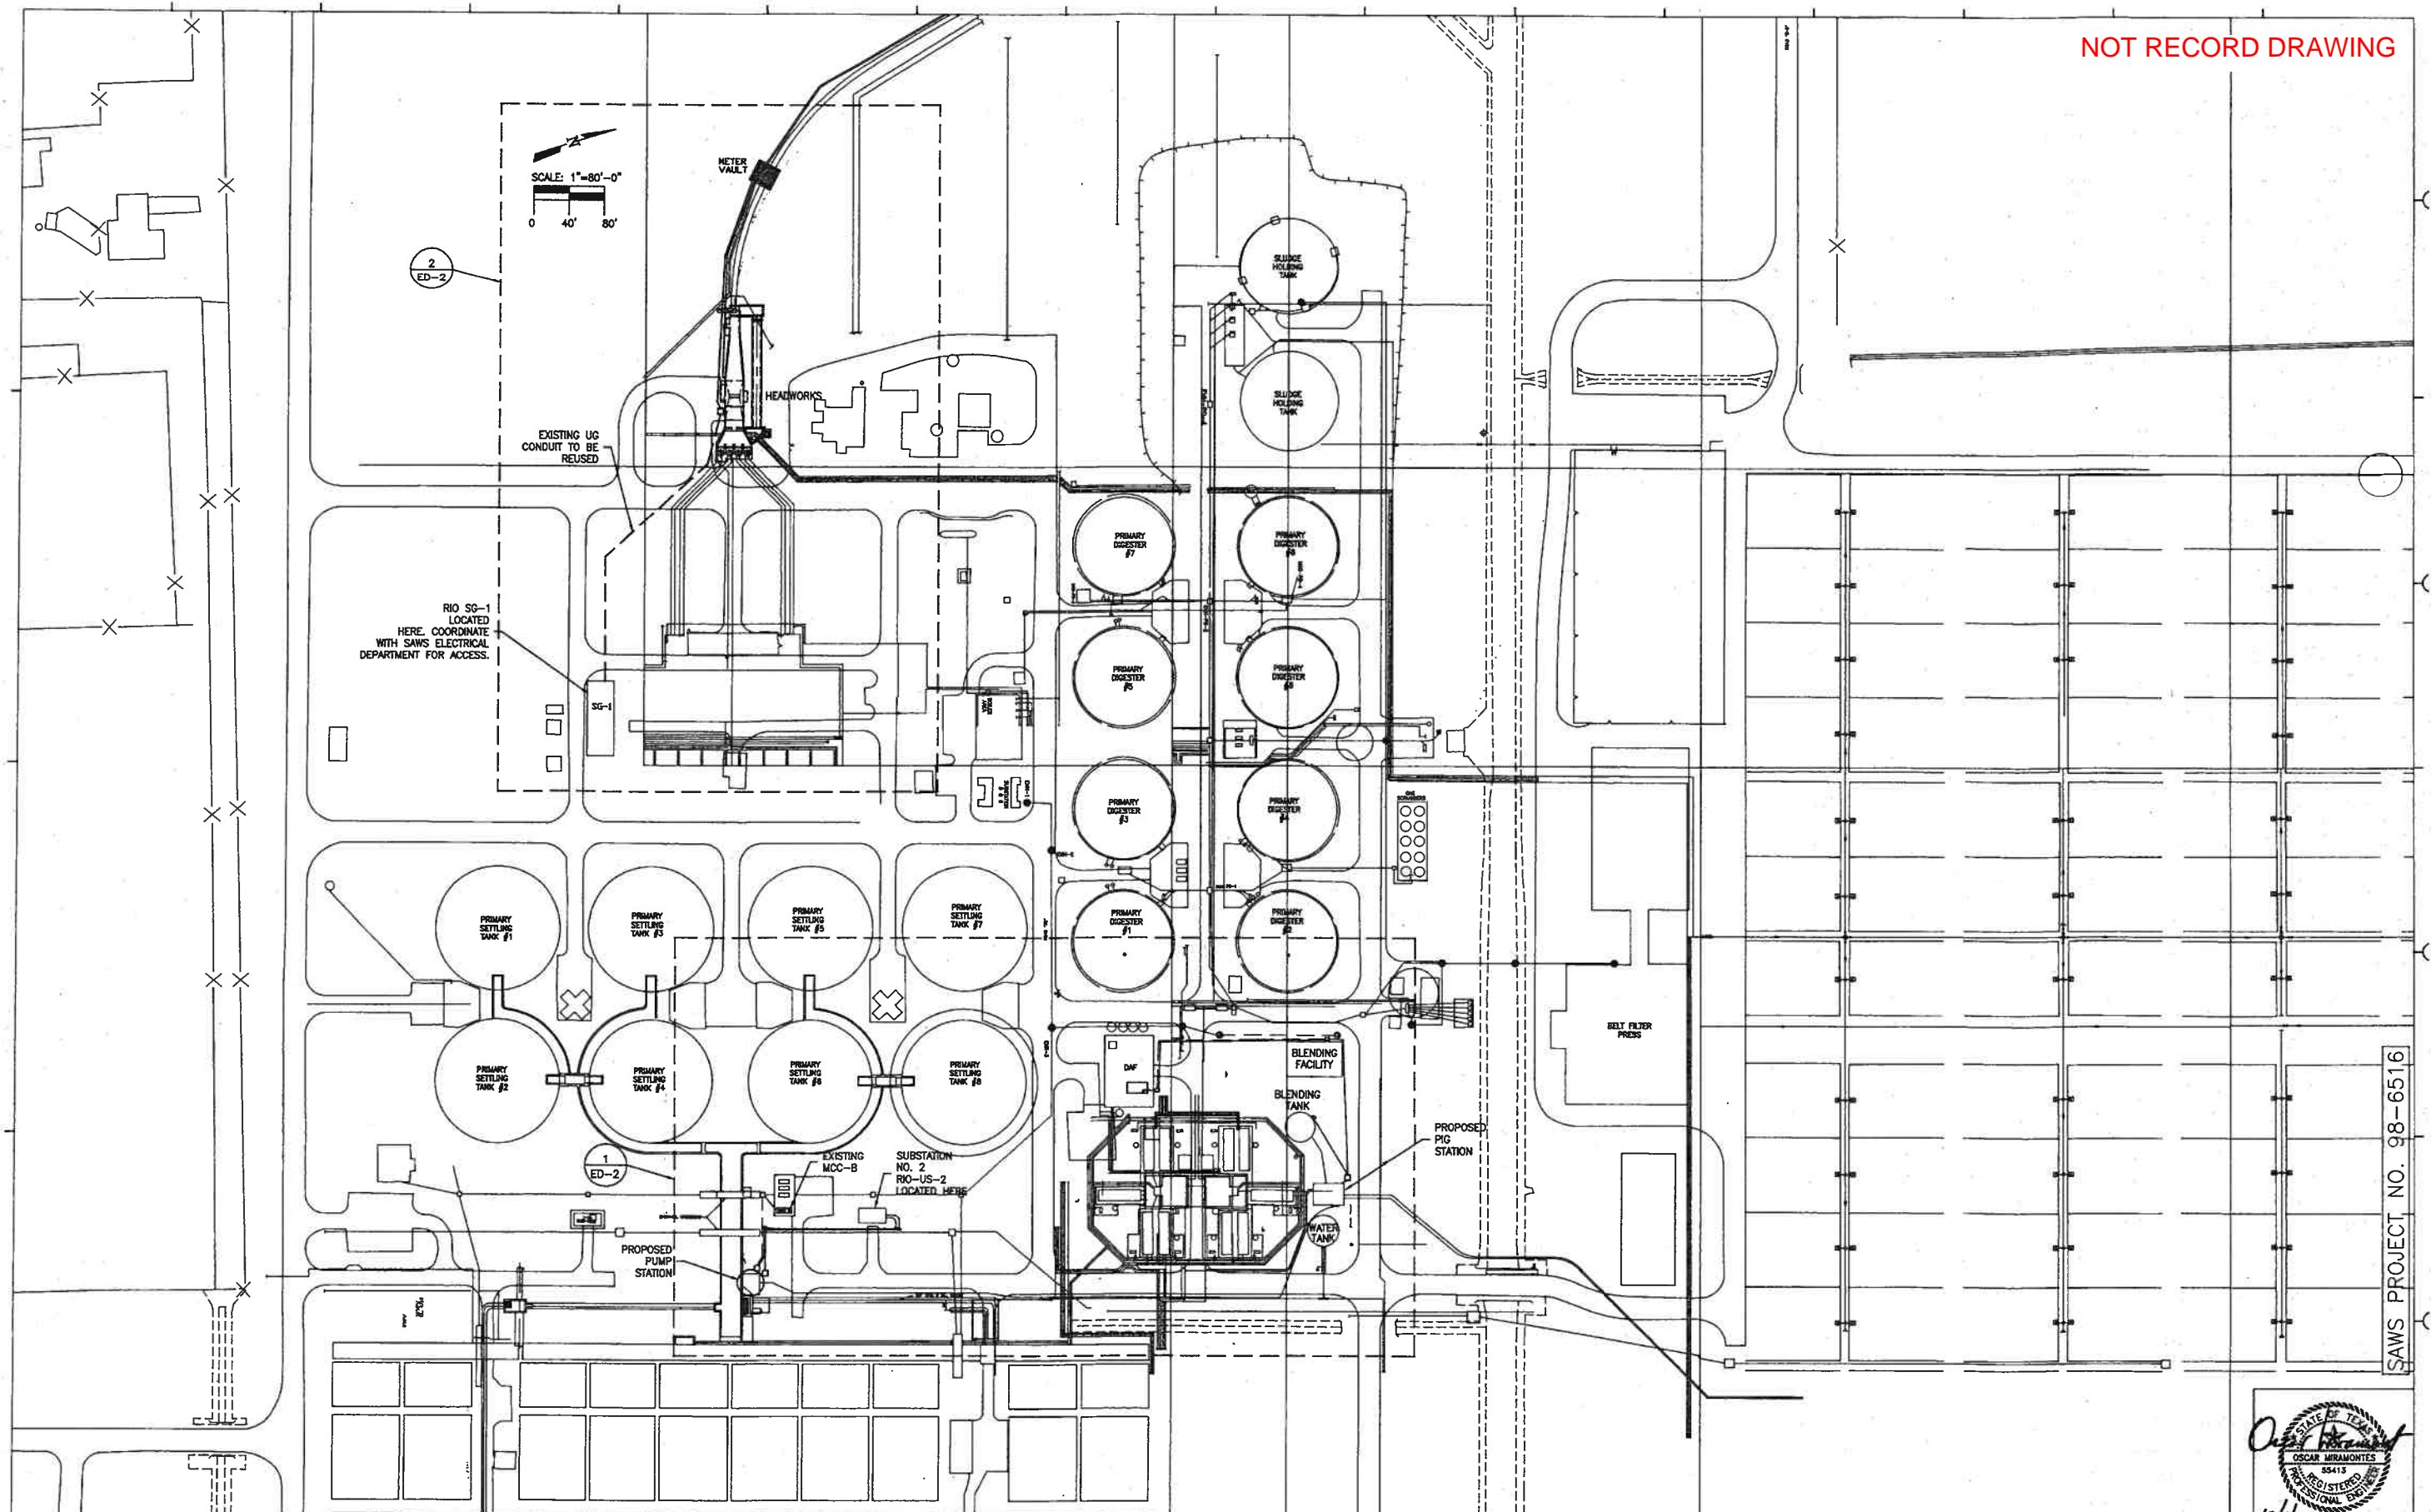

SAWS PROJECT NO. 98-6516

REV. NO.	DATE	DRWN	CHKD	REMARKS



DESIGNED BY: O.M.  
 DRAWN BY: \_\_\_\_\_  
 CHECKED BY: \_\_\_\_\_  
 APPROVED BY: O.M.  
 DATE: OCTOBER 2001

**CAMP DRESSER & McKEE INC.**  
 environmental engineers, architects,  
 planners, & management consultants  
**CDM**

SAN ANTONIO WATER SYSTEM  
**LEON CREEK, SALADO CREEK AND DOS RIOS  
 WATER RECYCLING CENTERS INTERCONNECTIONS  
 MODIFICATIONS PROJECT - PART A**

**DOS RIOS WATER RECYCLING CENTER  
 ELECTRICAL GENERAL SITE PLAN**


PROJECT No: 8246-23741  
 FILE NAME:  
 SHEET No:  
**ED-1**

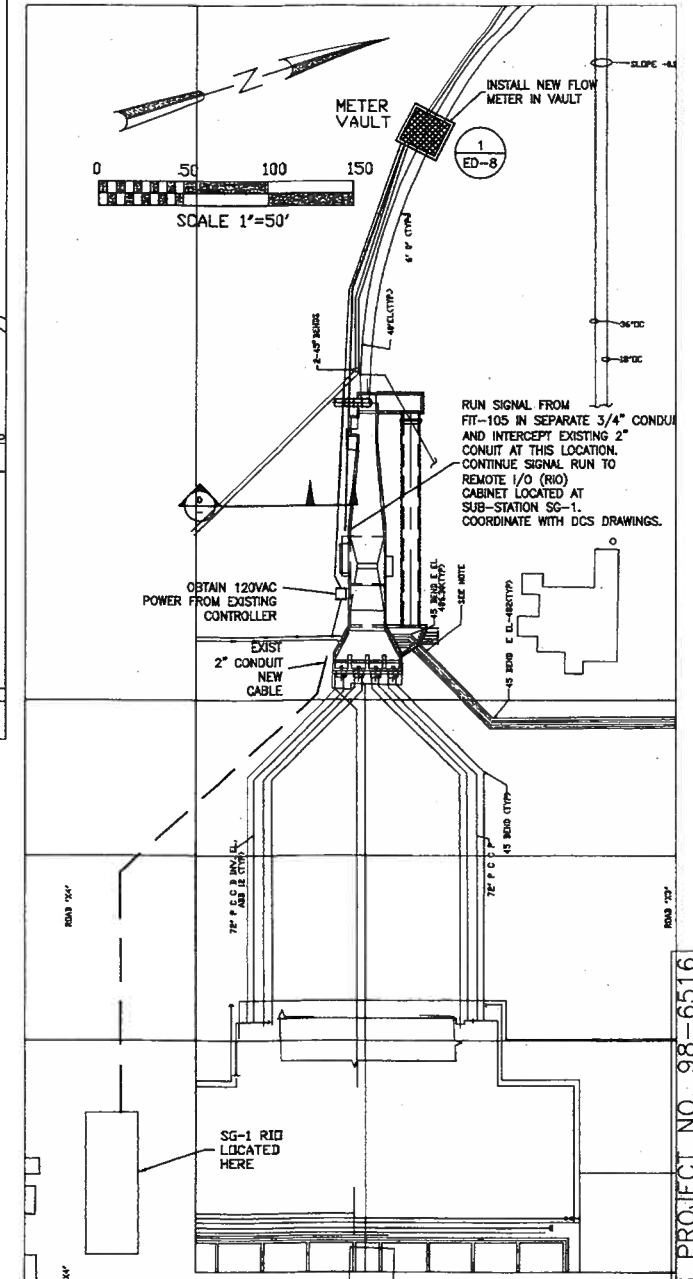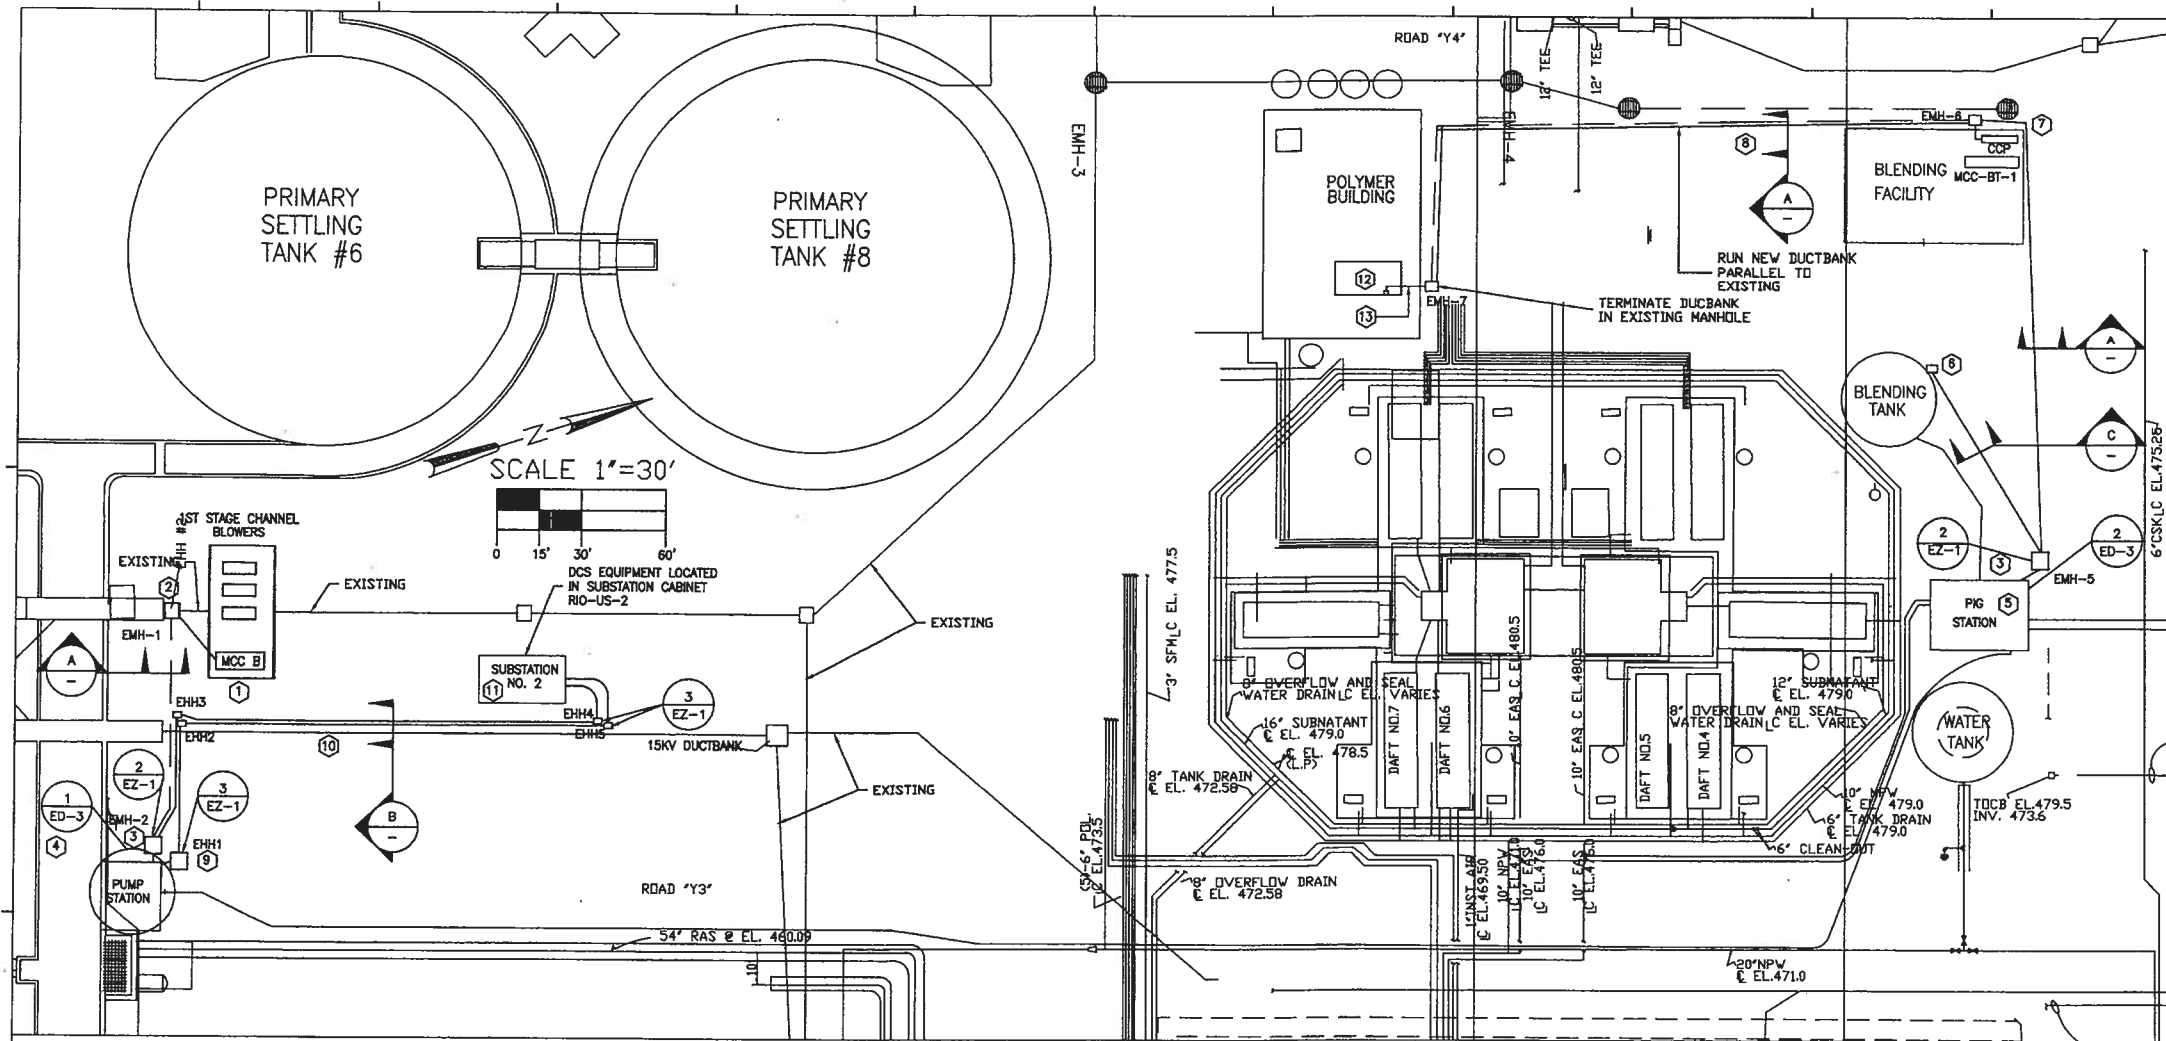

ELECTRICAL KEY NOTES (THIS SHEET ONLY):

- 1 INSTALL CIRCUIT BREAKER IN EXISTING MOTOR CONTROL CENTER (MCC-B) AND RUN CABLE TO EXISTING MANHOLE EMH-1 USING SPARE 3" CONDUIT. REFER TO ELECTRICAL ONE LINE FOR CABLE TYPE AND QUANTITY.
- 2 EXCAVATE AND EXPOSE MANHOLE WALL (EMH-1) AND CORE-DRILL A PENETRATION. INSTALL NEW DUCTBANK AND SEAL AND GROUT PENETRATION.
- 3 INSTALL NEW ELECTRICAL MANHOLE IN APPROXIMATE LOCATION INDICATED. COORDINATE MANHOLE RING AND COVER AND FLUSH TO GRADE. MANHOLE & COVER SHALL BE RATED FOR TRAFFIC LOAD.
- 4 INSTALL NEW MOTOR CONTROL CENTER (MCC-A) & NEW LOCAL PUMP CONTROLLERS. REFER TO ELECTRICAL SCHEMATICS.
- 5 INSTALL NEW LOCAL VALVE CONTROLLERS IN PIG STATION. REFER TO DETAIL.
- 6 RUN CONDUIT AND CABLE TO EXISTING LEVEL TRANSMITTER LOCATED BY BLEND TANK. REFER TO ELECTRICAL SCHEMATICS FOR CABLE TYPE AND QUANTITY. EXTEND CABLE TO DCS EQUIPMENT LOCATED IN POLYMER BLDG.
- 7 RUN CONDUIT AND CABLE TO EXISTING MANHOLE EMH-6 LOCATED BY BLENDING FACILITY. EXTEND CABLES TO DCS EQUIPMENT LOCATED IN POLYMER BLDG. REFER TO ELECTRICAL SCHEMATICS FOR CABLE TYPE AND QUANTITY. INSTALL NEW DUCTBANK FROM EMH-6 TO EMH-7 FOLLOWING SAME APPROXIMATE PATH AS EXISTING DUCTBANK.
- 8 NOT USED
- 9 INSTALL NEW SIGNAL HANDHOLE IN APPROXIMATE LOCATION INDICATED. COORDINATE HANDHOLE RING AND COVER AND FLUSH TO GRADE. HANDHOLE & COVER SHALL BE RATED FOR TRAFFIC LOAD.
- 10 RUN DUCTBANK FROM EMH-2 AND EHH-1 TO SUBSTATION NO. 2. INSTALL CONTROL AND SIGNAL CABLES IN QUANTITIES AND TYPES SHOWN IN ONE-LINE ELECTRICAL SCHEMATIC.
- 11 INSTALL NEW INPUT/OUTPUT MODULES ON EXISTING DCS EQUIPMENT AT RIO-US-2. LOCATED IN SUBSTATION NO. 2. REFER TO INSTRUMENTATION BLOCK DIAGRAM FOR TYPES AND QUANTITIES. TERMINATE DIGITAL AND ANALOG INPUTS ON NEW AND EXISTING INPUT MODULES AS REQUIRED. REFER TO INSTRUMENTATION SHEETS AND INSTRUMENTATION SPECIFICATIONS FOR ADDITIONAL INSTRUCTIONS.
- 12 INSTALL NEW INPUT/OUTPUT MODULES ON EXISTING DCS EQUIPMENT AT CONTROLLER 8/58 LOCATED IN POLYMER BLDG. REFER TO INSTRUMENTATION BLOCK DIAGRAM FOR TYPES AND QUANTITIES. TERMINATE DIGITAL AND ANALOG INPUTS ON NEW AND EXISTING INPUT MODULES AS REQUIRED. REFER TO INSTRUMENTATION SHEETS AND INSTRUMENTATION SPECIFICATIONS FOR ADDITIONAL INSTRUCTIONS.
- 13 RUN 2-2" CONDUITS FROM EMH-7 TO JUNCTION BOX LOCATED INSIDE OF CONTROL ROOM & CONTINUE RUN TO JUNCTION BOX LOCATED NEXT TO CONTROLLER 8/58 CABINET. EXTEND CONTROL AND SIGNAL CABLES ORIGINATING AT PIG STATION AND TERMINATE IN RESPECTIVE I/O TERMINALS.

1 DOS RIOS WRC PUMP STATION  
SCALE: 1"=20'

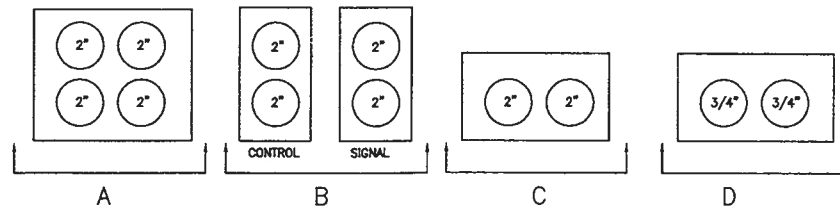

2 DOS RIOS WRC FLOW METER VAULT  
SCALE: 1"=50'

SAWS PROJECT NO. 98-6516

REV. NO.	DATE	DRWN	CHKD	REMARKS

**MIRAMONTES ENGINEERING**  
REGISTERED PROFESSIONAL ENGINEER  
STATE OF TEXAS  
NO. 55413

DESIGNED BY: O.J.M.  
DRAWN BY: \_\_\_\_\_  
CHECKED BY: \_\_\_\_\_  
APPROVED BY: O.J.M.  
DATE: OCTOBER 2001




**CAMP DRESSER & McKEE INC.**  
environmental engineers, scientists,  
planners, & management consultants

**SAN ANTONIO WATER SYSTEM**  
**LEON CREEK, SALADO CREEK AND DOS RIOS**  
**WATER RECYCLING CENTERS INTERCONNECTIONS**  
**MODIFICATIONS PROJECT - PART A**

**DOS RIOS WATER RECYCLING CENTER**  
**ELECTRICAL SITE PLAN**

**STATE OF TEXAS**  
**OSCAR MIRAMONTES**  
REGISTERED PROFESSIONAL ENGINEER  
NO. 55413  
10/1/01

PROJECT No. 98-6516  
FILE NAME:  
SHEET No. **ED-2**

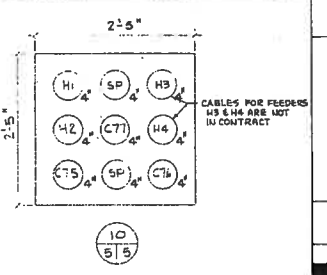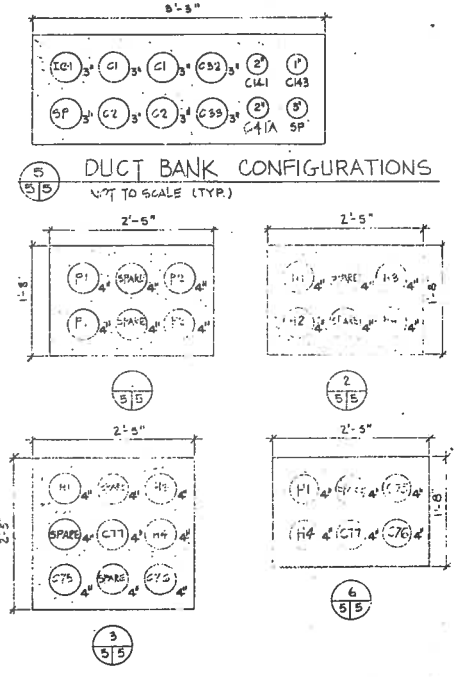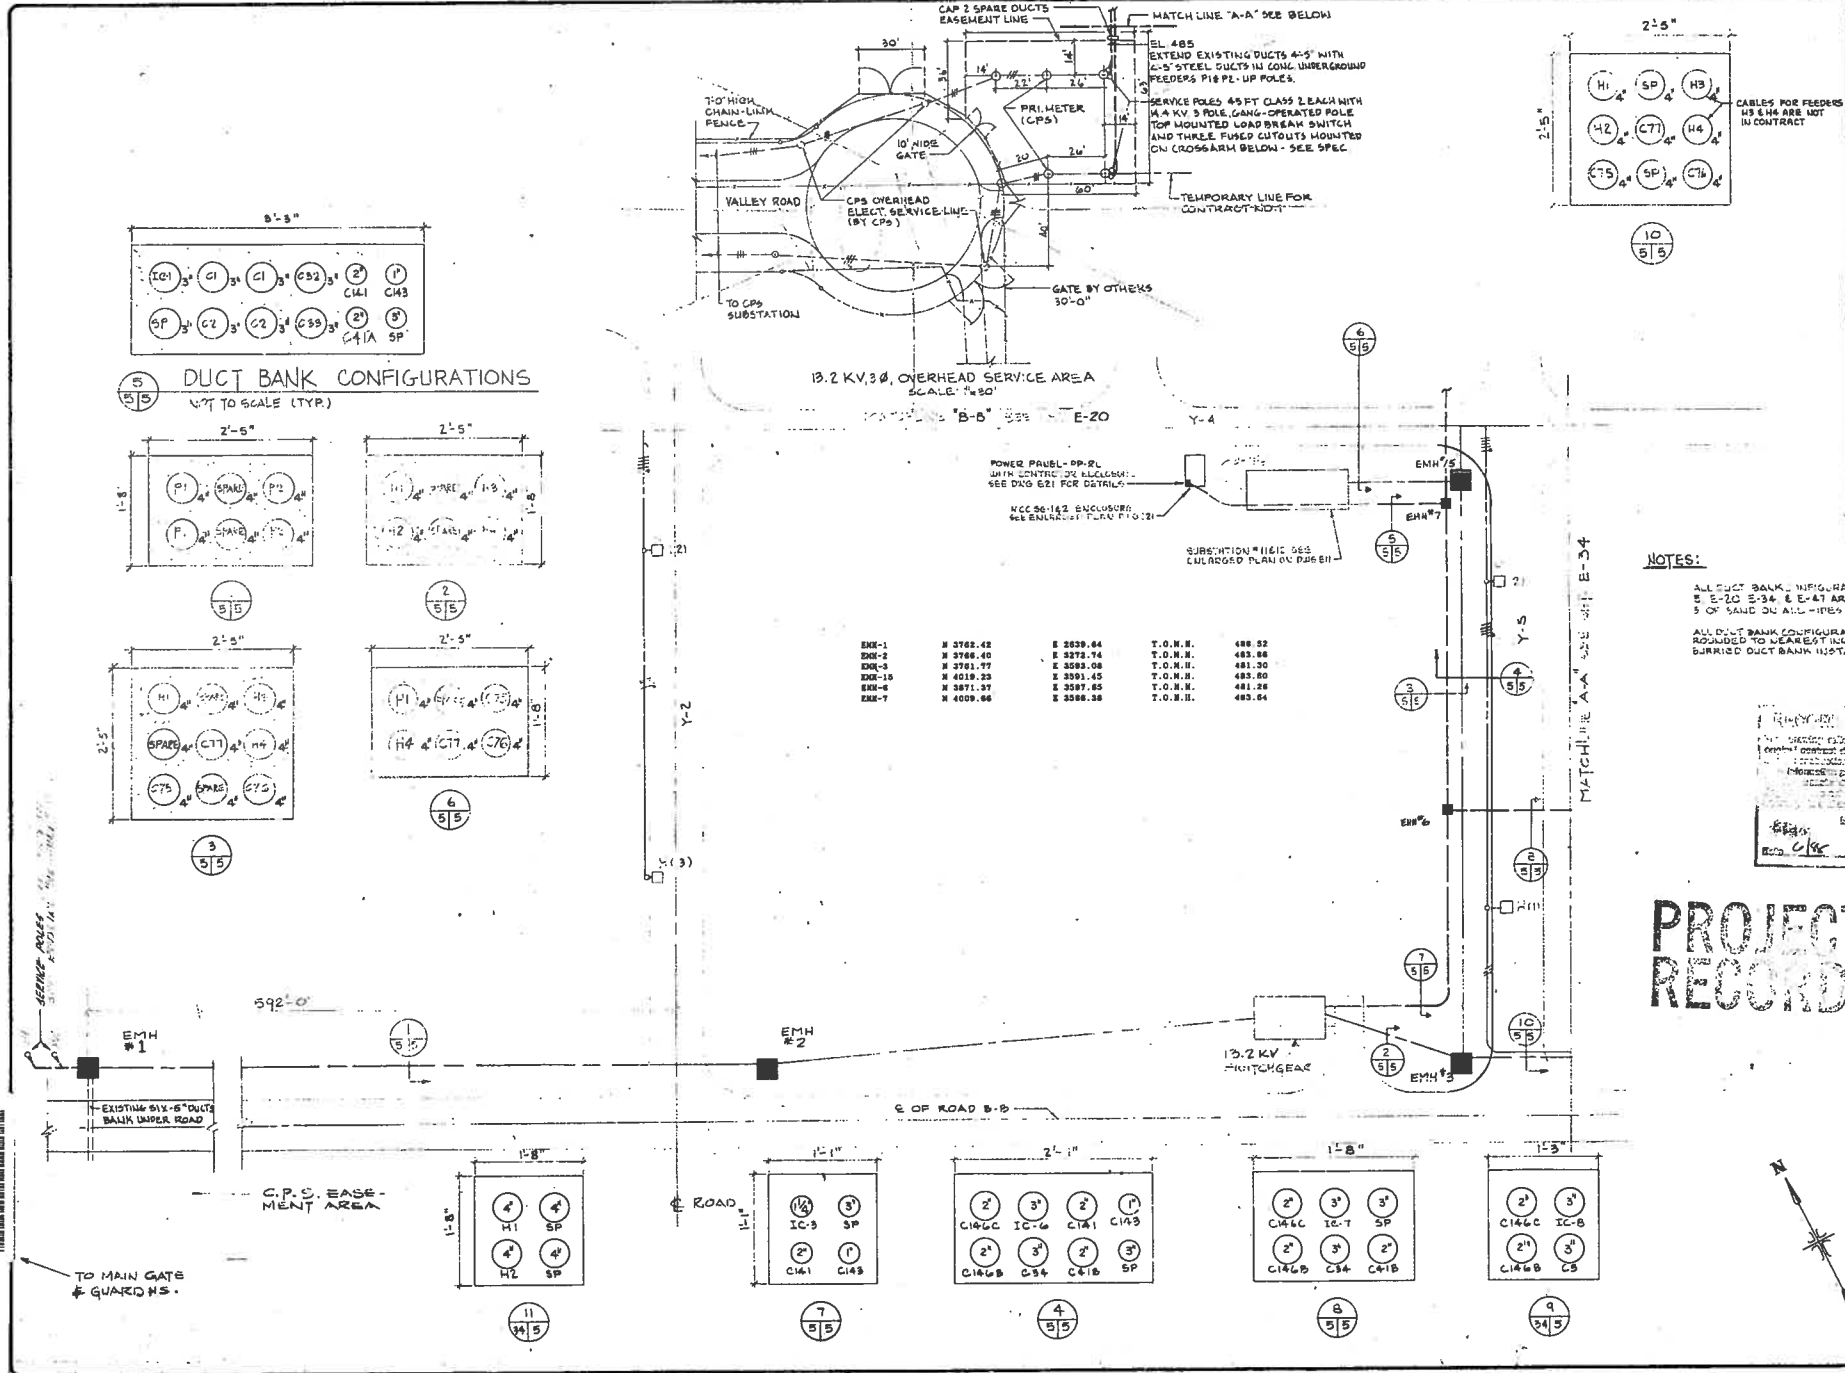

NOTES:  
ALL DUCT BANK CONFIGURATIONS SHOWN ON THIS DRAWING ARE TO BE INSTALLED TO A DEPTH OF 3'-0" UNLESS OTHERWISE NOTED.  
ALL DUCT BANK CONFIGURATIONS DIMENSIONS ARE TO BE ADJUSTED TO DEAREST INCH FOR COMPLETE BURIED DUCT BANK INSTALLATION.

PROJECT RECORD

App.	Revisions
No.	Date
A 11-1-87 By: [Redacted] Project Record	

Drawing No. 410N-83.236-0

WASTEWATER FACILITIES IMPROVEMENTS

SAN ANTONIO

CONTRACT NO. 3

DOS RIOS FACILITY






GENERAL

POWER DISTRIBUTION & AREA LIGHTING

Sheet E-5 of E-56

DR 88-6501

DR 88-6501

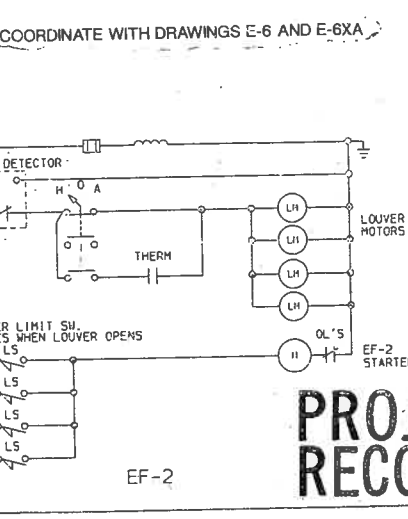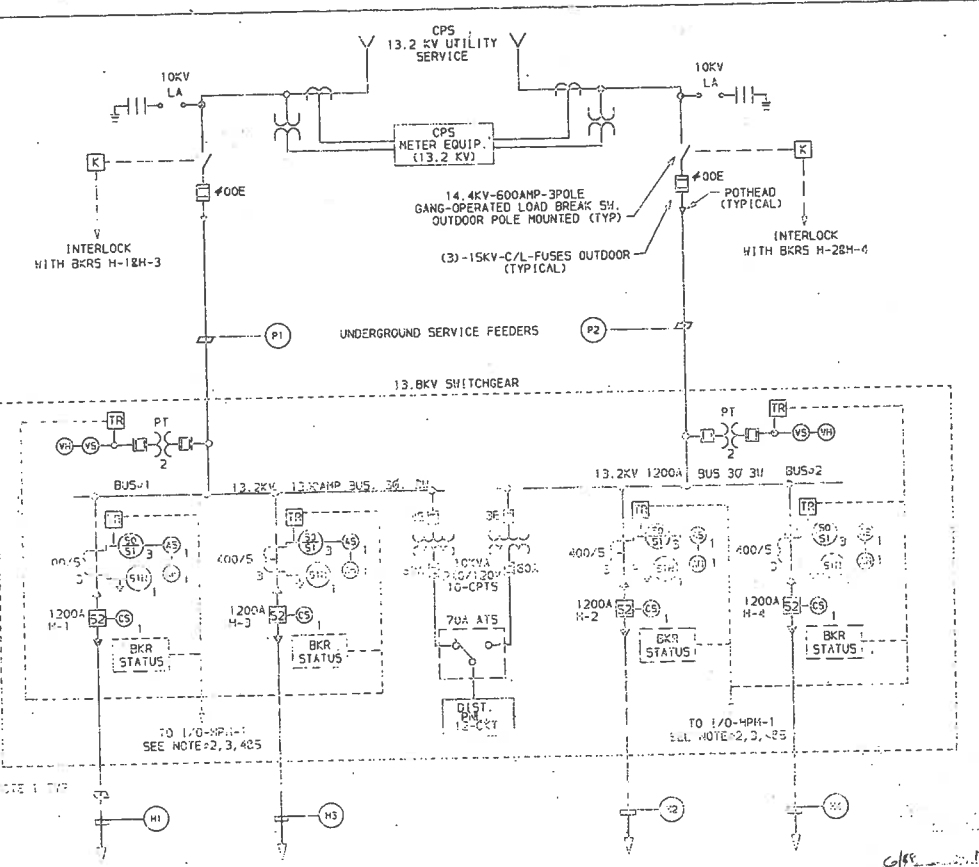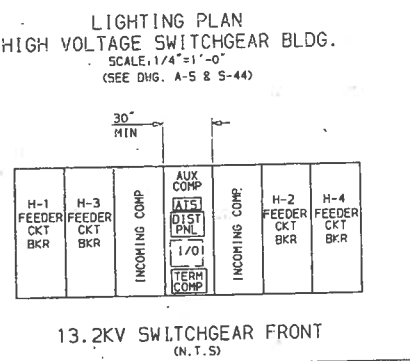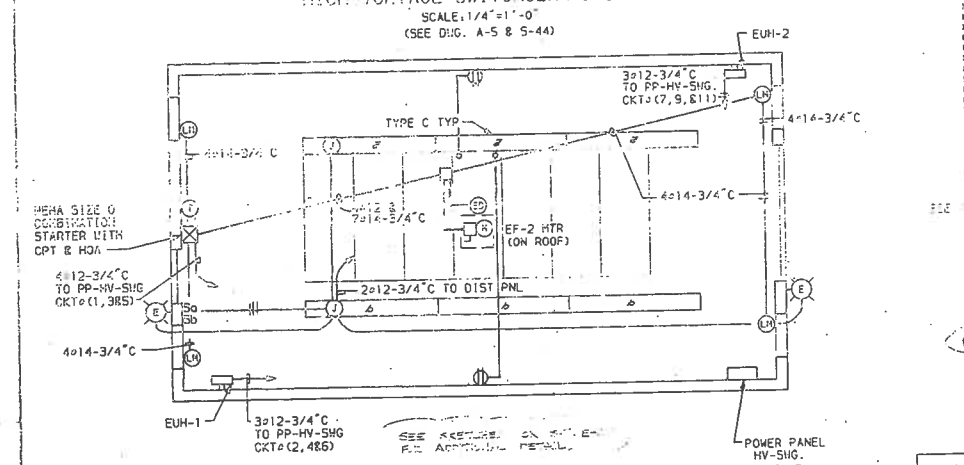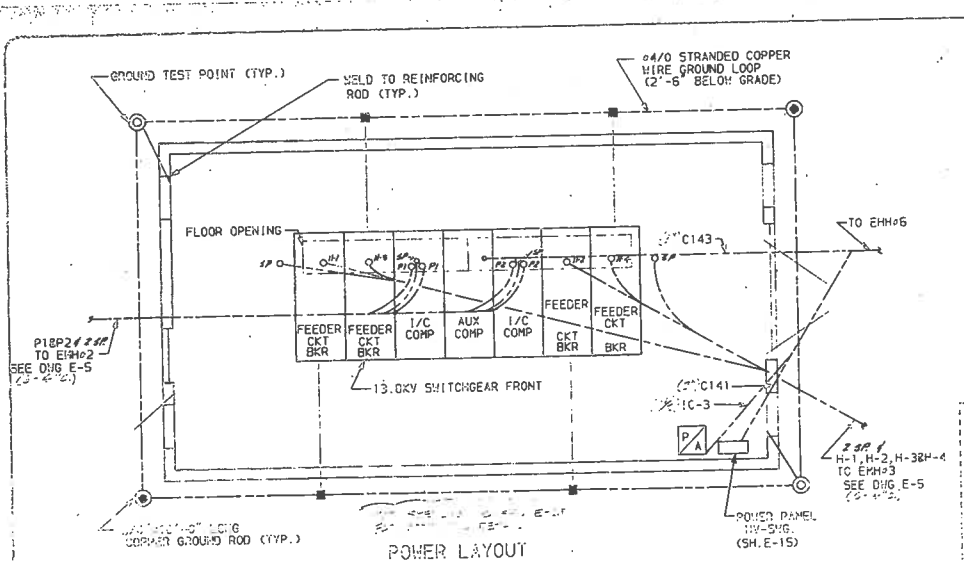

- 13KV PRIMARY SERVICE AND FEEDER SCHEDULE:
- (P1) 2 SETS OF 3-1/2" x 4/0 15KV SHIELDED & 1" x 4/0 GND -2-1/2" CONDUITS
  - (P2) 2 SETS OF 3-1/2" x 4/0 15KV SHIELDED & 1" x 4/0 GND -2-1/2" CONDUITS
  - (H1) 1 SET OF 3-1/2" x 4/0 15KV SHIELDED & 1" x 4/0 GND -1-1/2" CONDUIT
  - (H2) 1 SET OF 3-1/2" x 4/0 15KV SHIELDED & 1" x 4/0 GND -1-1/2" CONDUIT
  - (H3) 1 SET OF 3-1/2" x 4/0 15KV SHIELDED & 1" x 4/0 GND -1-1/2" CONDUIT
  - (H4) 1 SET OF 3-1/2" x 4/0 15KV SHIELDED & 1" x 4/0 GND -1-1/2" CONDUIT


- NOTE:
- 1 CABLE SHALL BE ONE CONTINUOUS SIZE FROM CIRCUIT BREAKER TO EACH SUBSTATION OR PAD MOUNT XFORMER REFER TO DNG E2 FOR LOADS ASSOCIATED WITH EACH FEEDER.
  - 2 SUBSTATION VENDOR SHALL PROVIDE TERMINAL COMPARTMENT WITH 35 TERMINALS OF WHICH 15 ARE ISOLATED TERMINALS FOR SIGNALS OF TRANSFORMERS.
  - 3 SUBSTATION VENDOR SHALL PROVIDE CONTROL WIRING TROUGH THRU EACH SWITCHGEAR COMPARTMENT FOR BREAKER STATUS WIRING.
  - 4 CONTRACTOR SHALL EXTEND CIRCUIT BREAKER STATUS WIRING VIA WIRE TROUGH AND TERMINATE ON TERMINAL STRIP OF TERMINAL COMPARTMENT.
  - 5 CONTRACTOR SHALL ARRANGE AUXILIARY COMPARTMENT OF SWITCHGEAR SUCH THAT 1/0-HPH-1 PROVIDED UNDER CONTRACT#2, CAN BE INSTALLED IN SWITCHGEAR UNDER CONTRACT NO.2.

PROJECT RECORD


DOS RIOS FACILITY  
GENERAL  
13.2 KV DISTRIBUTION SWITCHGEAR

Sheet F-5  
of F-5B



DR 88-6501

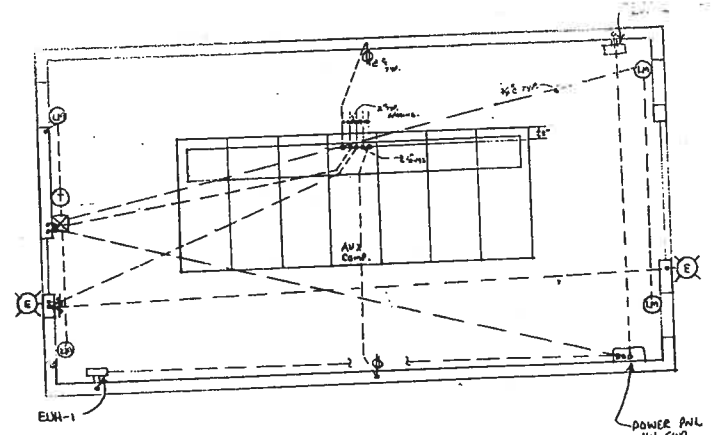

LIGHTING & POWER  
 H.V. SWITCH HOUSE  
 N.T.S. P.C.C. REV. 1  
 2/11/66

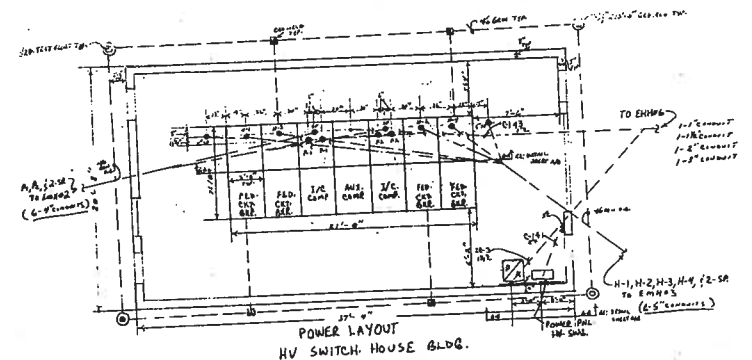


POWER LAYOUT  
 H.V. SWITCH HOUSE BLDG.  
 N.T.S.

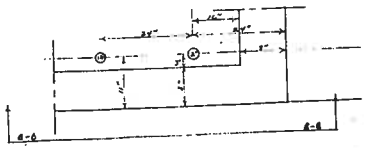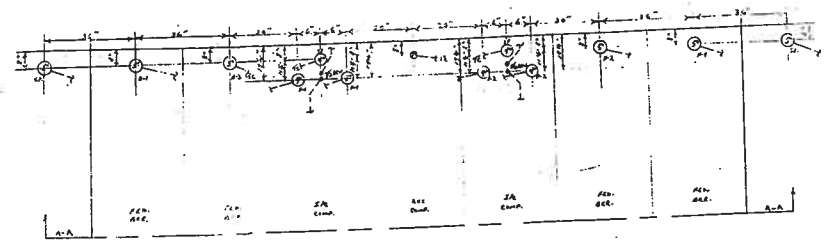

DETAIL SHEET A/B  
 SWITCHGEAR  
 N.T.S. 2/11/66

COORDINATE WITH DRAWING E-6 AND E-6 X

Drawing No.	
<b>MALCOLM PIRNIE</b>	
Date: JUNE 1960	Designed by: P.C.C.
Drawn by: P.C.C.	Checked by: P.C.C.
Scale: N.T.S.	
<b>San Antonio</b>	
<b>WATERWATER FACILITIES IMPROVEMENTS</b>	
CONTRACT NO. 3	
<b>DOS RIOS FACILITY</b>	
H.V. SWITCHGEAR "AS-BUILTS"	
Sheet: E-6	of: 88

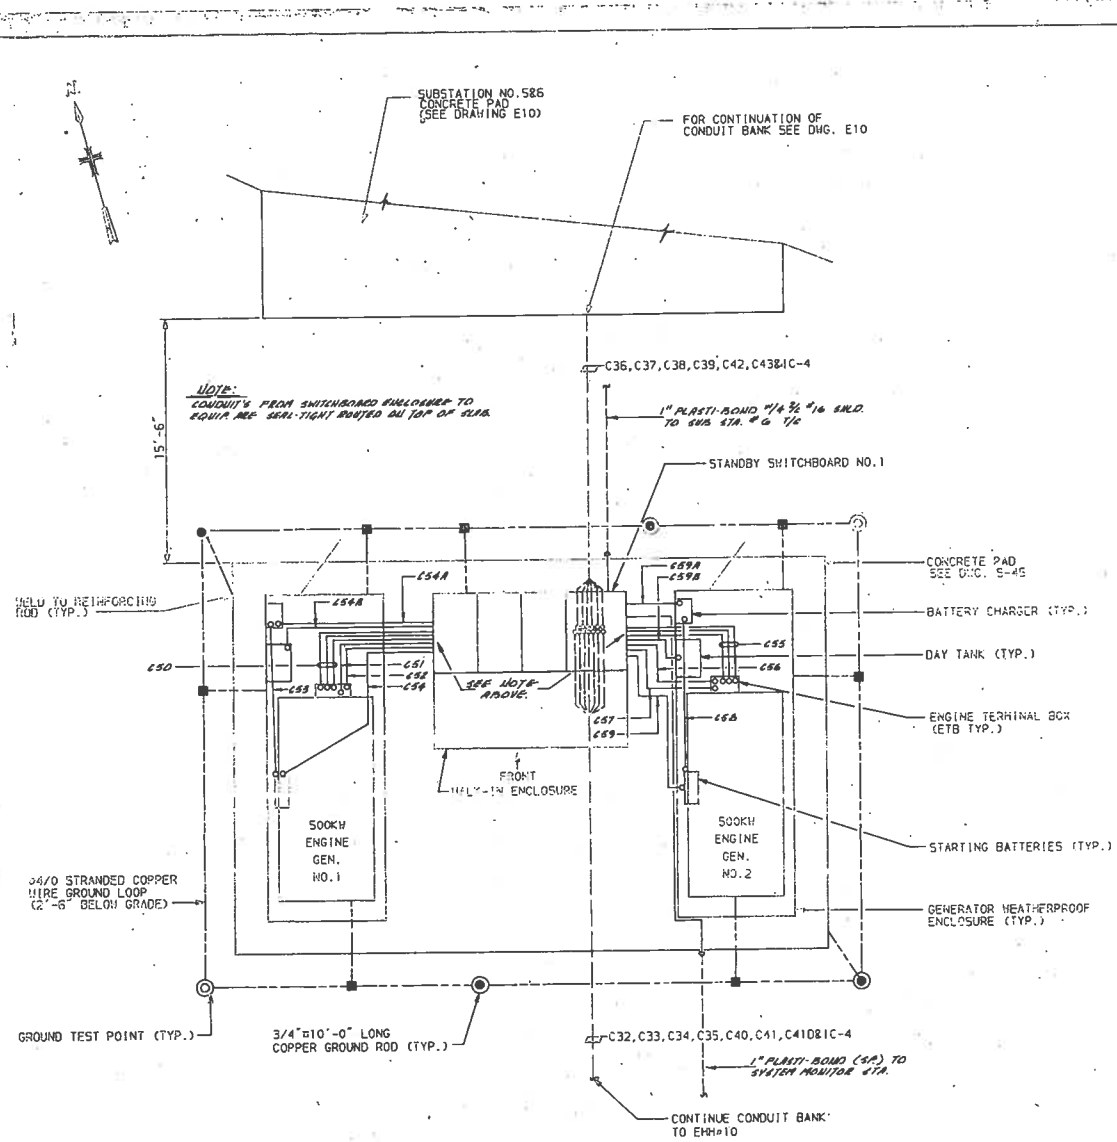

GENERATOR NO. 1 CONTROL SECTION	GENERATOR NO. 2 CONTROL SECTION	MASTER CONTROL SECTION	NCCSG-1 BKR.	NCCSG-2 BKR.
			NCCPS-1 BKR.	NCCPS-2 BKR.
			NCCFT-1 BKR.	NCCFT-2 BKR.
			NCCPD-3 BKR.	NCCPD-4 BKR.
			SPARE	NCC-B1 BKR.
GENERATOR NO. 1 CKT. BKR.	GENERATOR NO. 2 CKT. BKR.	200B/200V. D/147. 1/1402.		
32"	32"	32"	44"	

STANDBY SWITCHBOARD NO. 1  
FRONT VIEW  
(NOT TO SCALE)  
NOTE: DIMENSIONS DEPEND ON EQUIPMENT SELECTED.

Appr.	410N-03.020-0
Rev.	
Des.	
Drawn	

W. BEULSTEIN  
E. S. BARNES  
E. S. BARNES  
E. S. BARNES

CONTRACT NO. 3  
DOS RIOS FACILITY  
GENERAL  
STANDBY GENERATORS #1 & #2

COORDINATE WITH SHEET E-7.

**PROJECT RECORD**

Sheet E-7  
of E-5B

DR 88-6501

STANDBY GENERATOR NO. 1&2 LAYOUT  
SCALE= 1/4"=1'-0"



Drawing No.  
410N-83.244-0


REVISIONS

No.	Date	Description
1	12/28/83	REVISED

RECORD DRAWINGS

This drawing reflects changes from the original design. It is the responsibility of the engineer to ensure that the design is complete and correct. The engineer is not responsible for the accuracy of the information provided to the contractor. The contractor is responsible for the accuracy of the information provided to the contractor. The contractor is responsible for the accuracy of the information provided to the contractor.

Date: 1/18/84 By: MGM

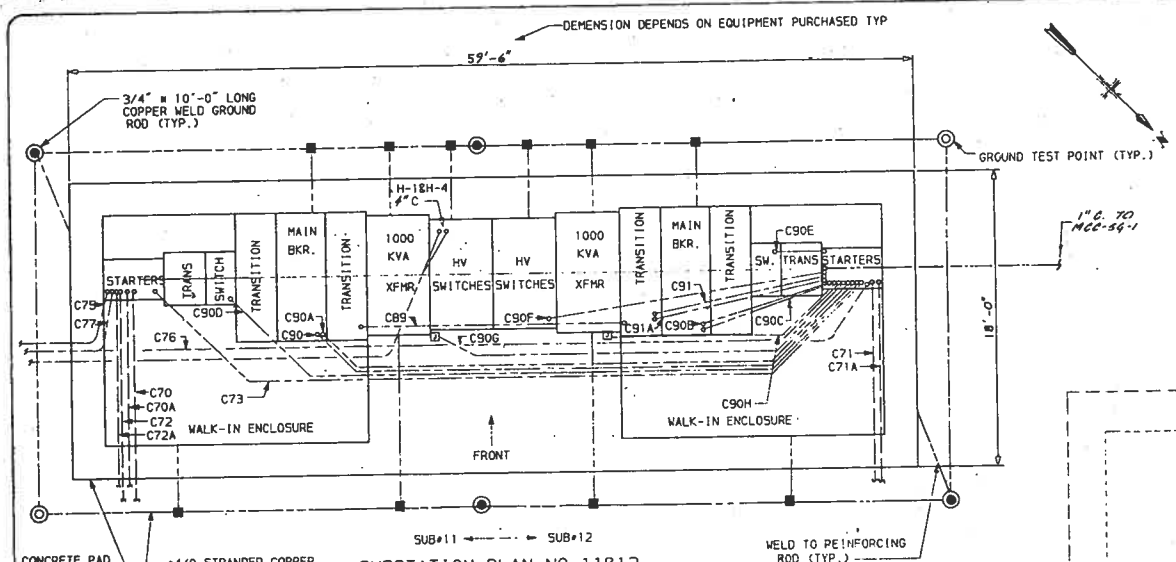

CONCRETE PAD SEE DWG. S-46

#4/0 STRANDED COPPER WIRE GROUND LOOP (2'-6" BELOW GRADE)


WELD TO REINFORCING ROD (TYP.)

SUB#11 → SUB#12

**SUBSTATION PLAN NO. 11&12**

SCALE 1/4"=1'-0"

NOTE: FOR CONTINUATION OF CONDUITS REFER TO DRAWING E21(TYP.).

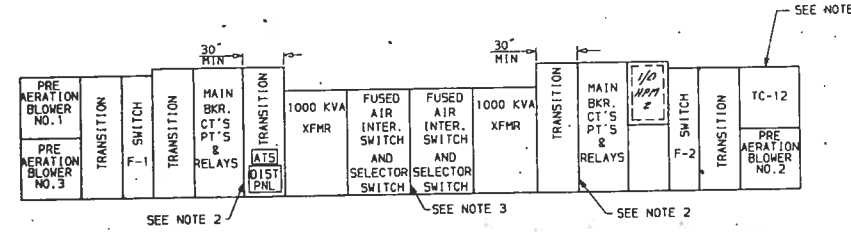


SUB#11 → SUB#12

**SUBSTATION FRONT. NO. 11&12**

SCALE 1/4"=1'-0"

- NOTES:
- 1 PROVIDE TERMINAL COMPARTMENT WITH 80 TERMINALS INCLUDING 10 ISOLATED TERMINALS FOR TRANSDUCER SIGNALS.
  - 2 SUBSTATION VENDOR SHALL PROVIDE (1)-1" INSULATING BUSHING BETWEEN MAIN Ckt BREAKER COMPARTMENT AND TRANSITION COMPARTMENT.
  - 3 SUBSTATION VENDOR SHALL PROVIDE THRU-WALL BARRIER BETWEEN PRIMARY SWITCH COMPARTMENTS FOR HIGH VOLTAGE CABLE CONNECTIONS BETWEEN SWITCHES. REFER TO DWG. E2 FOR CABLE REQUIREMENTS. PROVIDE 1" INSULATING BUSHING BETWEEN SWITCH COMPARTMENTS FOR STATUS WIRING.
  - 4 CONTRACTOR SHALL ARRANGE TRANSITION COMPARTMENT SUCH THAT 1/0 PROVIDED UNDER CONTRACT#2 CAN BE INSTALLED UNDER CONTRACT #2 IN COMPARTMENT.

COORDINATE WITH DRAWINGS E-10&A AND E-11

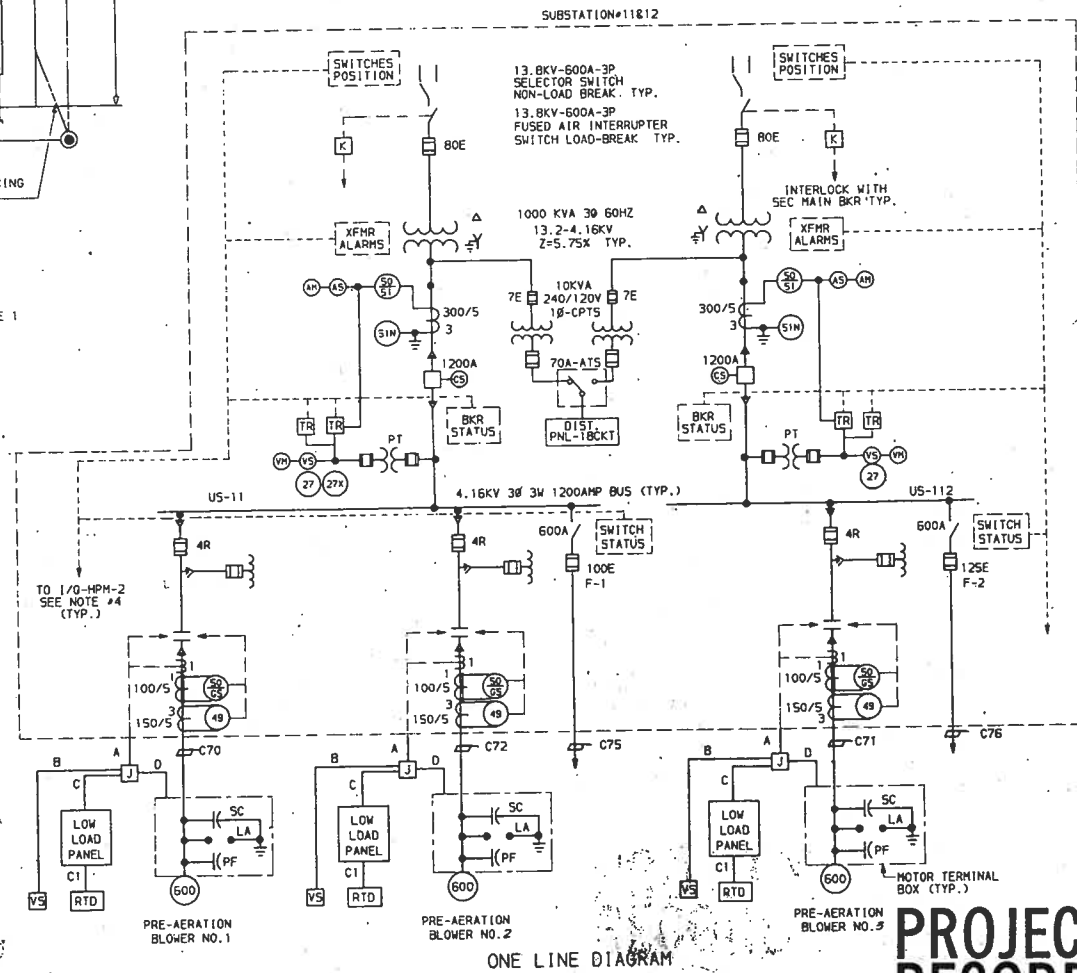

ONE LINE DIAGRAM

CONTRACT NO. 3

**DOS RIOS FACILITY**


GENERAL

SUBSTATION #11 & #12

Sheet E-11X of F-58

**PROJECT RECORD**

DR 88-6801

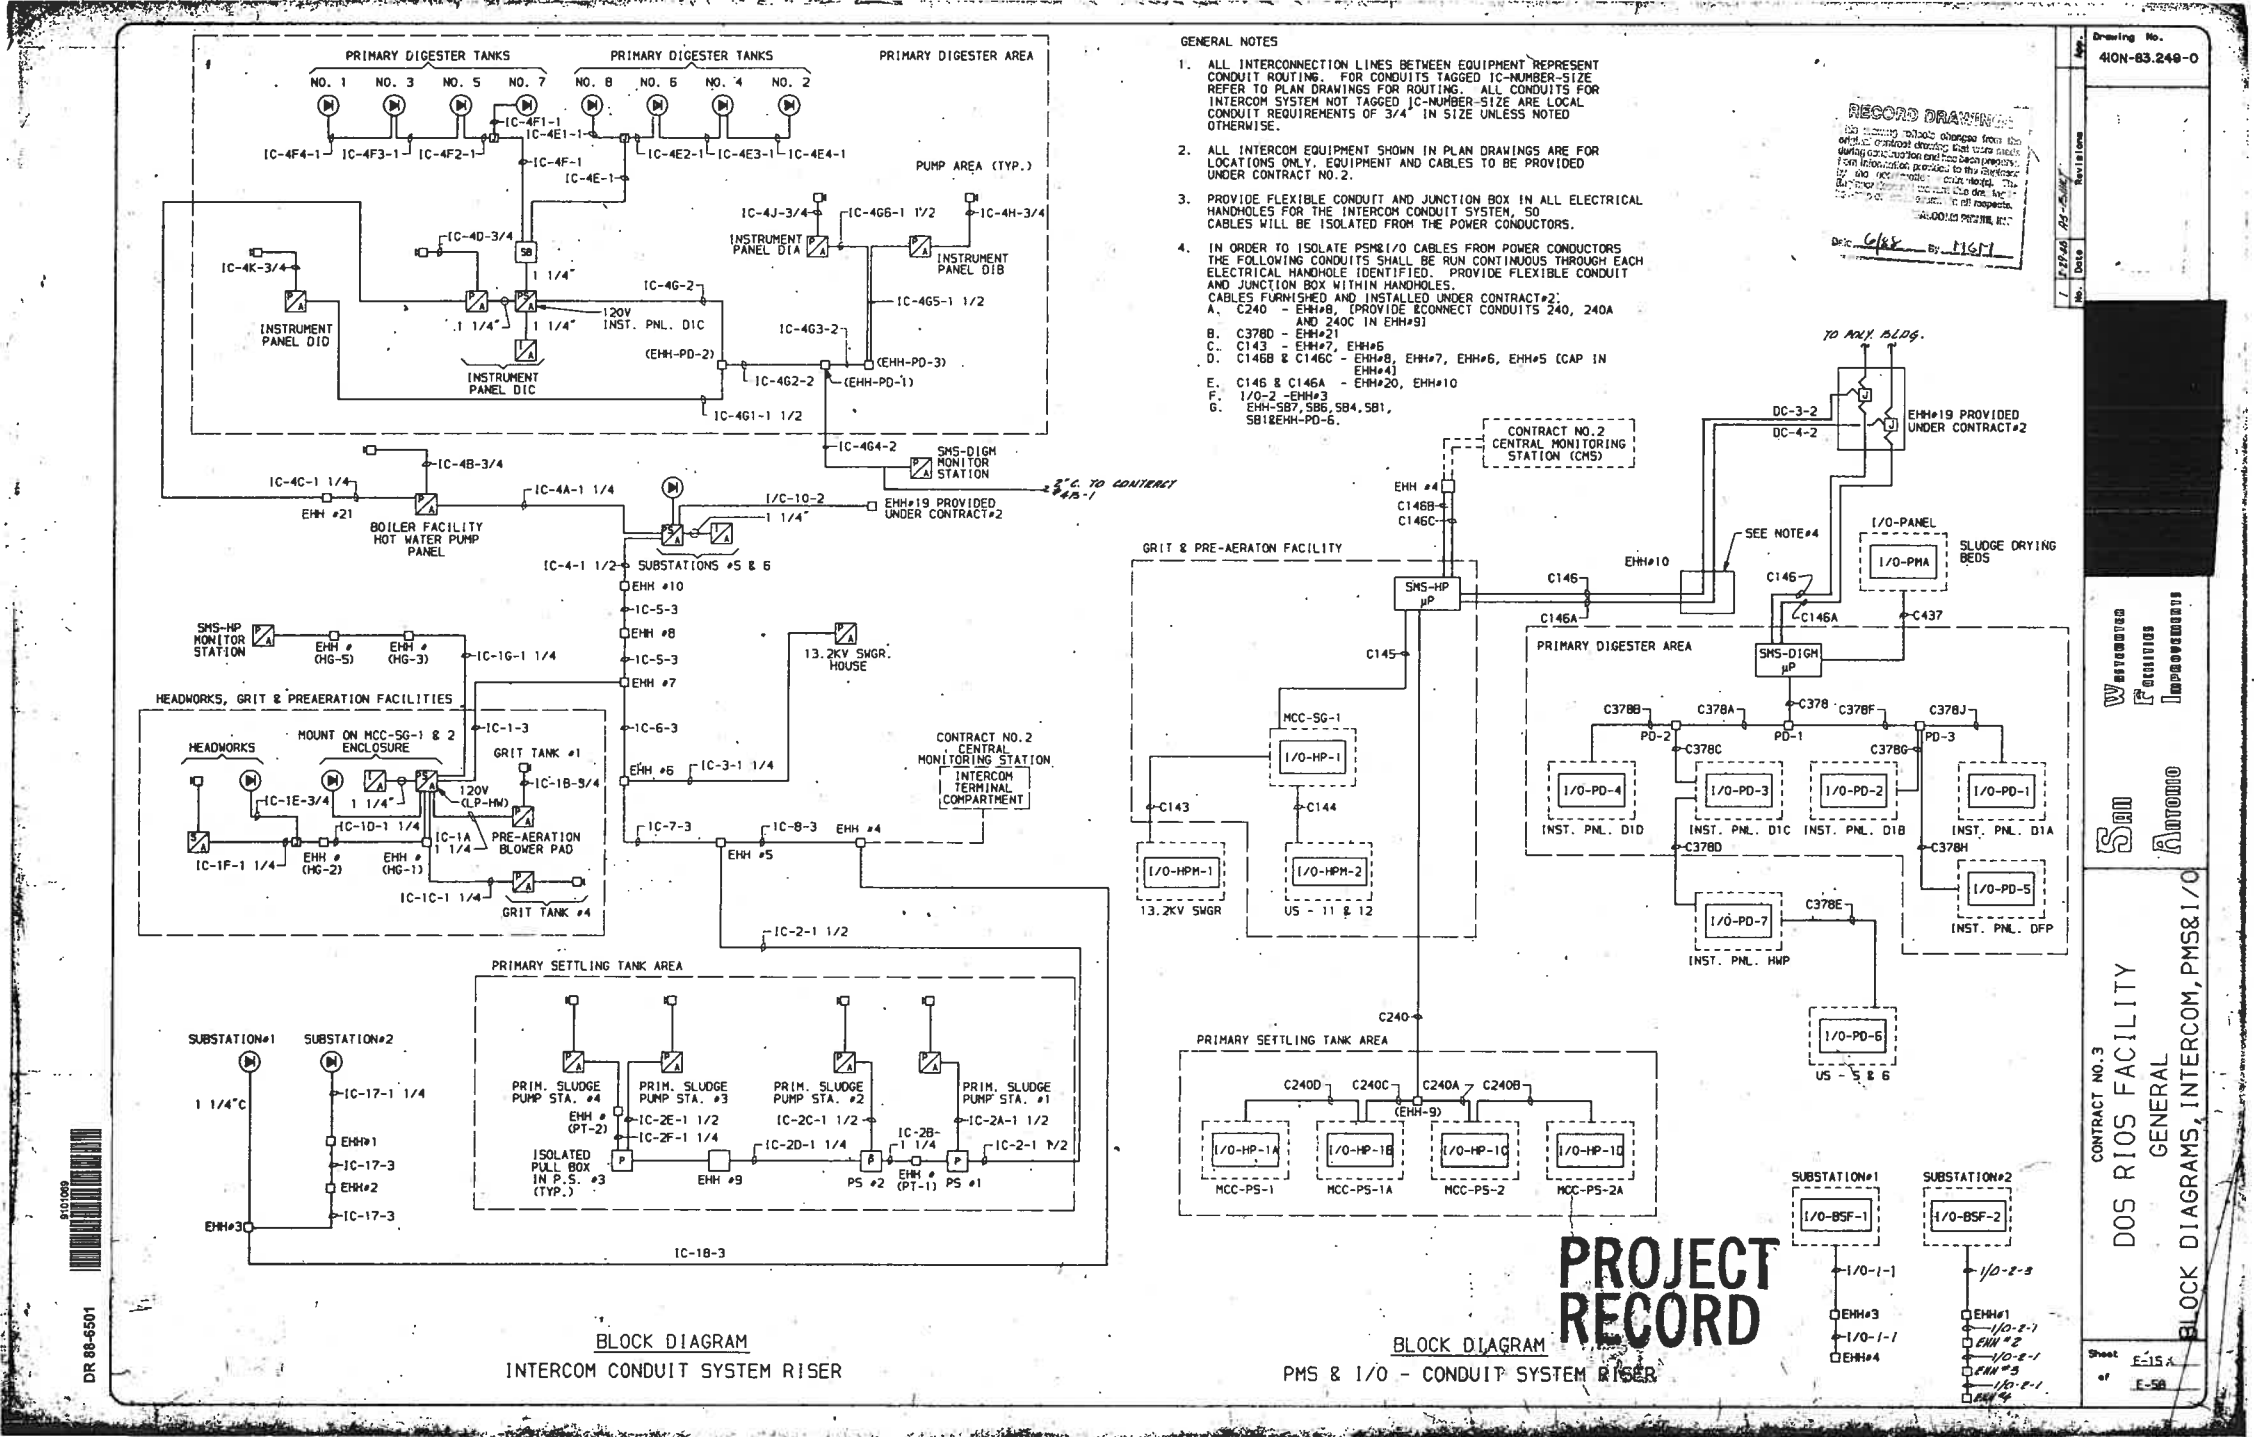

- GENERAL NOTES**
1. ALL INTERCONNECTION LINES BETWEEN EQUIPMENT REPRESENT CONDUIT ROUTING. FOR CONDUITS TAGGED IC-NUMBER-SIZE REFER TO PLAN DRAWINGS FOR ROUTING. ALL CONDUITS FOR INTERCOM SYSTEM NOT TAGGED IC-NUMBER-SIZE ARE LOCAL CONDUIT REQUIREMENTS OF 3/4" IN SIZE UNLESS NOTED OTHERWISE.
  2. ALL INTERCOM EQUIPMENT SHOWN IN PLAN DRAWINGS ARE FOR LOCATIONS ONLY. EQUIPMENT AND CABLES TO BE PROVIDED UNDER CONTRACT NO. 2.
  3. PROVIDE FLEXIBLE CONDUIT AND JUNCTION BOX IN ALL ELECTRICAL HANDHOLES FOR THE INTERCOM CONDUIT SYSTEM. SO CABLES WILL BE ISOLATED FROM THE POWER CONDUCTORS.
  4. IN ORDER TO ISOLATE PMS/I/O CABLES FROM POWER CONDUCTORS THE FOLLOWING CONDUITS SHALL BE RUN CONTINUOUS THROUGH EACH ELECTRICAL HANDHOLE IDENTIFIED. PROVIDE FLEXIBLE CONDUIT AND JUNCTION BOX WITHIN HANDHOLES. CABLES FURNISHED AND INSTALLED UNDER CONTRACT#2.
    - A. C240 - EHH#8, (PROVIDE RECONNECT CONDUITS 240, 240A AND 240C IN EHH#9)
    - B. C378D - EHH#21
    - C. C143 - EHH#7, EHH#5
    - D. C146B & C146C - EHH#8, EHH#7, EHH#6, EHH#5 (CAP IN EHH#4)
    - E. C146 & C146A - EHH#20, EHH#10
    - F. 1/0-2 - EHH#3
    - G. EHH#5B7, 5B6, 5B4, 5B1, 5B1EHH-PD-6.

**RECORD DRAWING**

By: *[Signature]*

Drawing No. 410N-83.248-0



CONTRACT NO. 3  
 DOS RIOS FACILITY  
 GENERAL  
 BLOCK DIAGRAMS, INTERCOM, PMS&I/O

**PROJECT RECORD**



DR 88-6501

Sheet of E-15A  
 of E-58



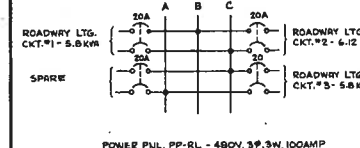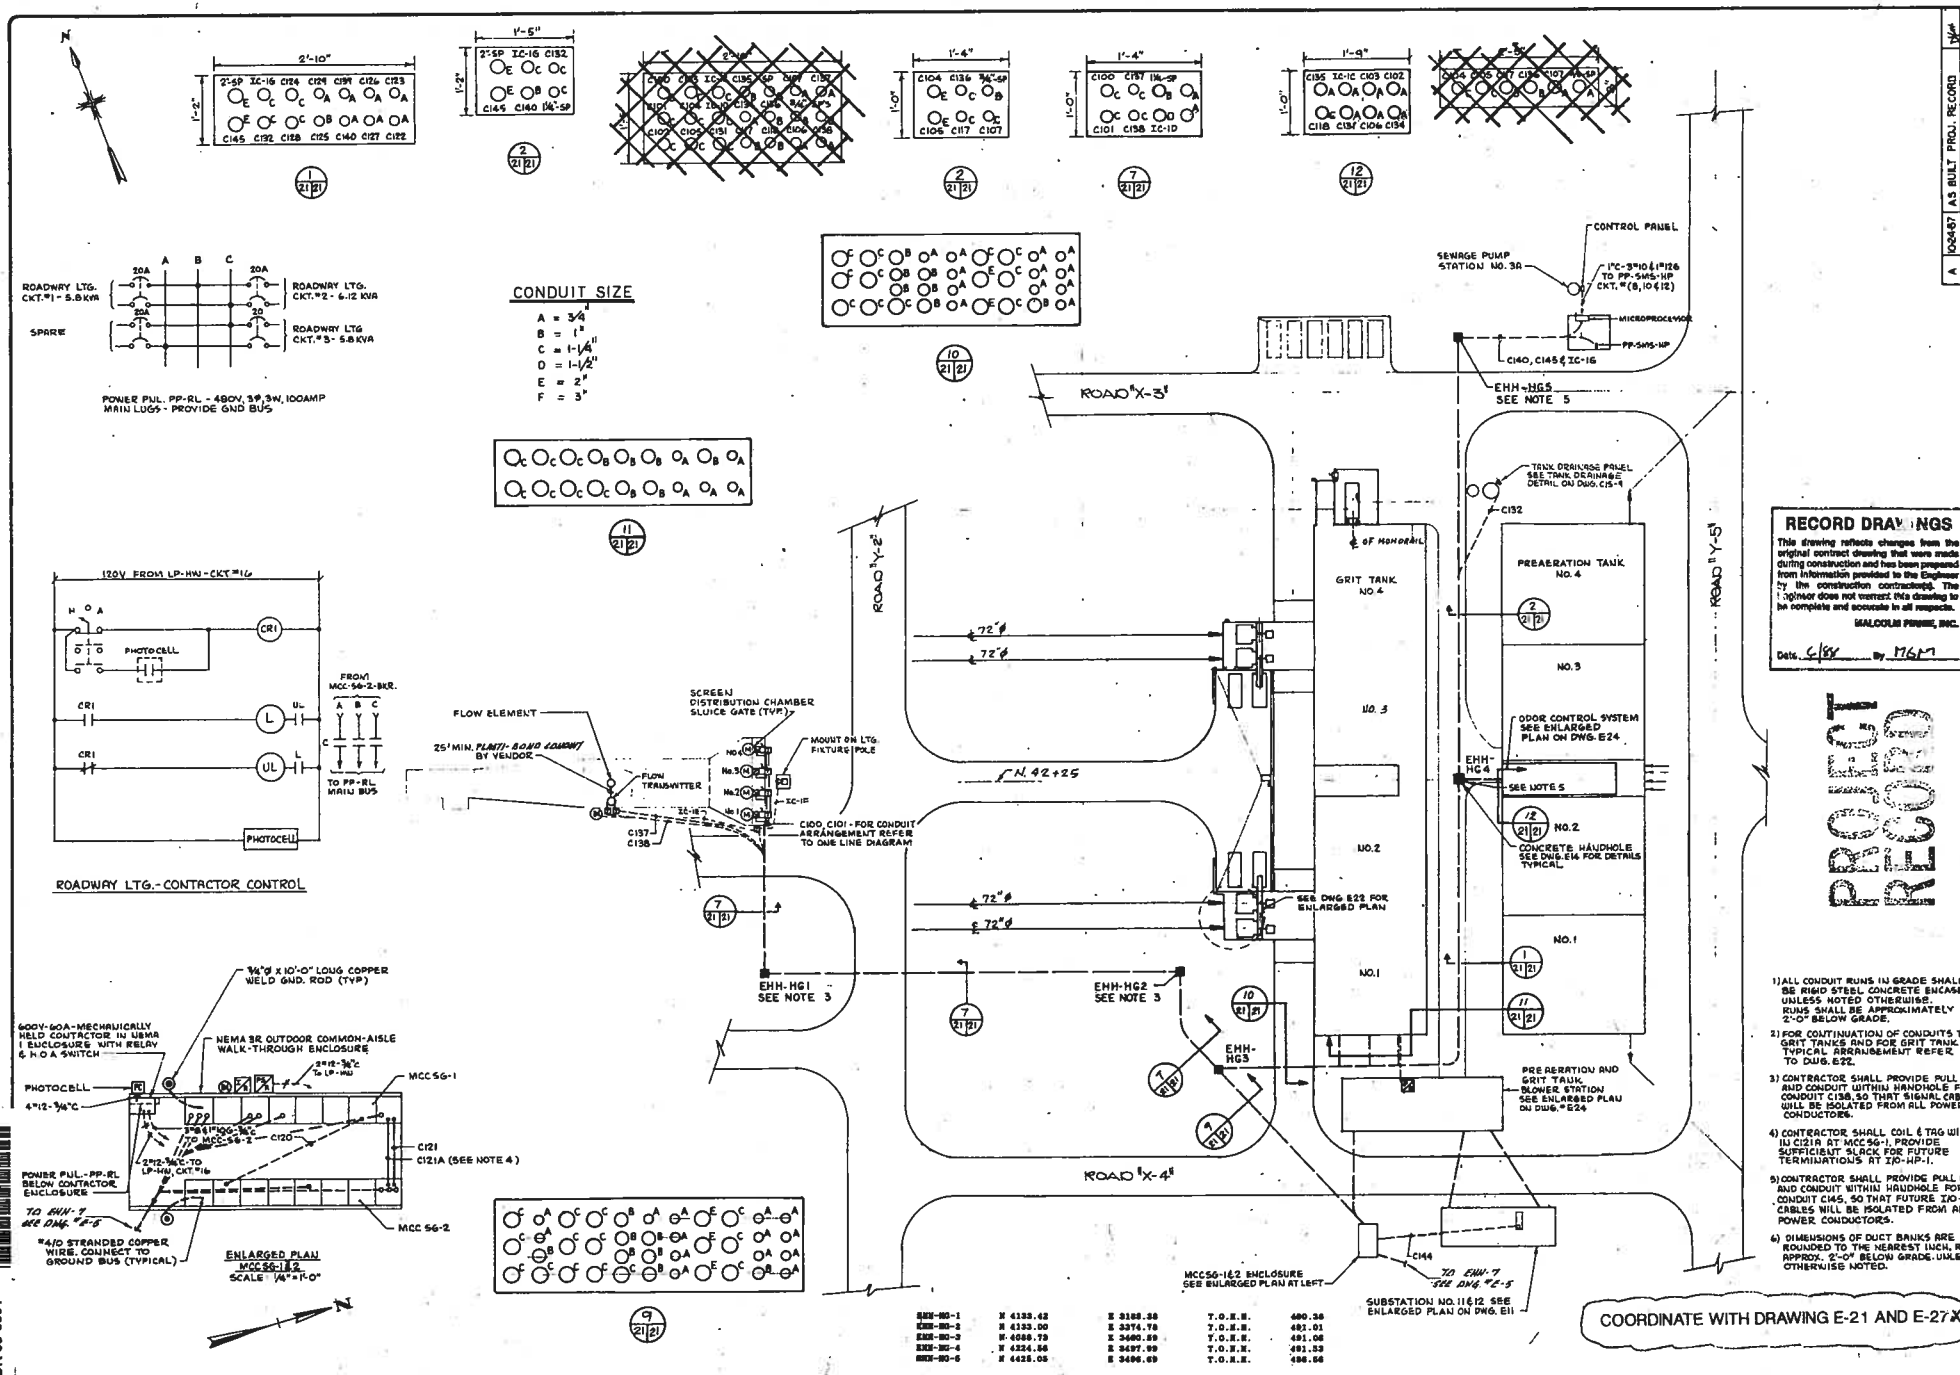

**CONDUIT SIZE**  
 A = 3/4"  
 B = 1"  
 C = 1-1/4"  
 D = 1-1/2"  
 E = 2"  
 F = 3"

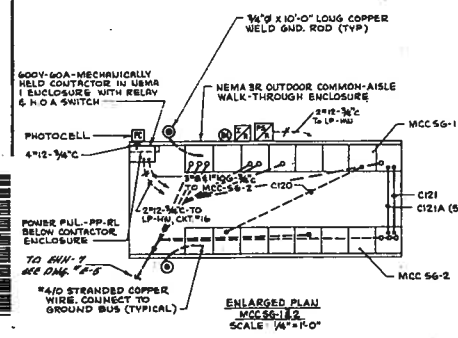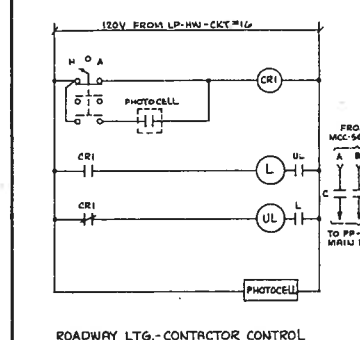

**RECORD DRAWINGS**  
 This drawing reflects changes from the original contract drawing that were made during construction and has been prepared from information provided to the Engineer by the construction contractor. The Engineer does not warrant this drawing to be complete and accurate in all respects.  
 DATE: 6/87 BY: MAM  
 SARGENT & Lundy, INC.

**PROJECT RECORD**

- 1) ALL CONDUIT RUNS IN GRADE SHALL BE RIGID STEEL CONCRETE SHEATHED, UNLESS NOTED OTHERWISE. DUCTS SHALL BE APPROXIMATELY 2'-0" BELOW GRADE.
- 2) FOR CONTINUATION OF CONDUITS TO GRIT TANKS AND FOR GRIT TANK TYPICAL ARRANGEMENT REFER TO DWG. E-22.
- 3) CONTRACTOR SHALL PROVIDE RULL BOX AND CONDUIT WITHIN HANDHOLE FOR CONDUIT C18, SO THAT SIGNIFICANT CABLES WILL BE ISOLATED FROM ALL POWER CONDUCTORS.
- 4) CONTRACTOR SHALL COIL 6 TAG WIRES IN C21 & MCC 56-1, PROVIDE SUFFICIENT SLACK FOR FUTURE TERMINATIONS AT 20'-0".
- 5) CONTRACTOR SHALL PROVIDE RULL BOX AND CONDUIT WITHIN HANDHOLE FOR CONDUIT C145, SO THAT FUTURE 20-CABLES WILL BE ISOLATED FROM ALL POWER CONDUCTORS.
- 6) DIMENSIONS OF DUCT BANKS ARE ROUNDED TO THE NEAREST 1/8" UNLESS APPROX. 2'-0" BELOW GRADE, UNLESS OTHERWISE NOTED.

EHM-NO-1	N 4120.42	E 3188.20	T.O.B.S.	480.00
EHM-NO-2	N 4120.00	E 3274.70	T.O.B.S.	481.01
EHM-NO-3	N 4088.70	E 3480.80	T.O.B.S.	491.00
EHM-NO-4	N 4324.86	E 3487.99	T.O.B.S.	493.53
EHM-NO-5	N 4420.00	E 3496.49	T.O.B.S.	498.00

COORDINATE WITH DRAWING E-21 AND E-27 X

Drawing No. 410N-83.255-0

AS BUILT PROJ. RECORD

DATE: 6/87 BY: MAM

CONTRACT NO. 3


**San Antonio**

WATERWATER FACILITIES IMPROVEMENTS

**DOS RIOS FACILITY**  
 SCREEN, GRIT, & PREPARATION FACILITIES  
 HEADWORKS SCREEN & GRIT, & PREPARATION  
 POWER LAYOUT

Sheet E-21 X of E-58



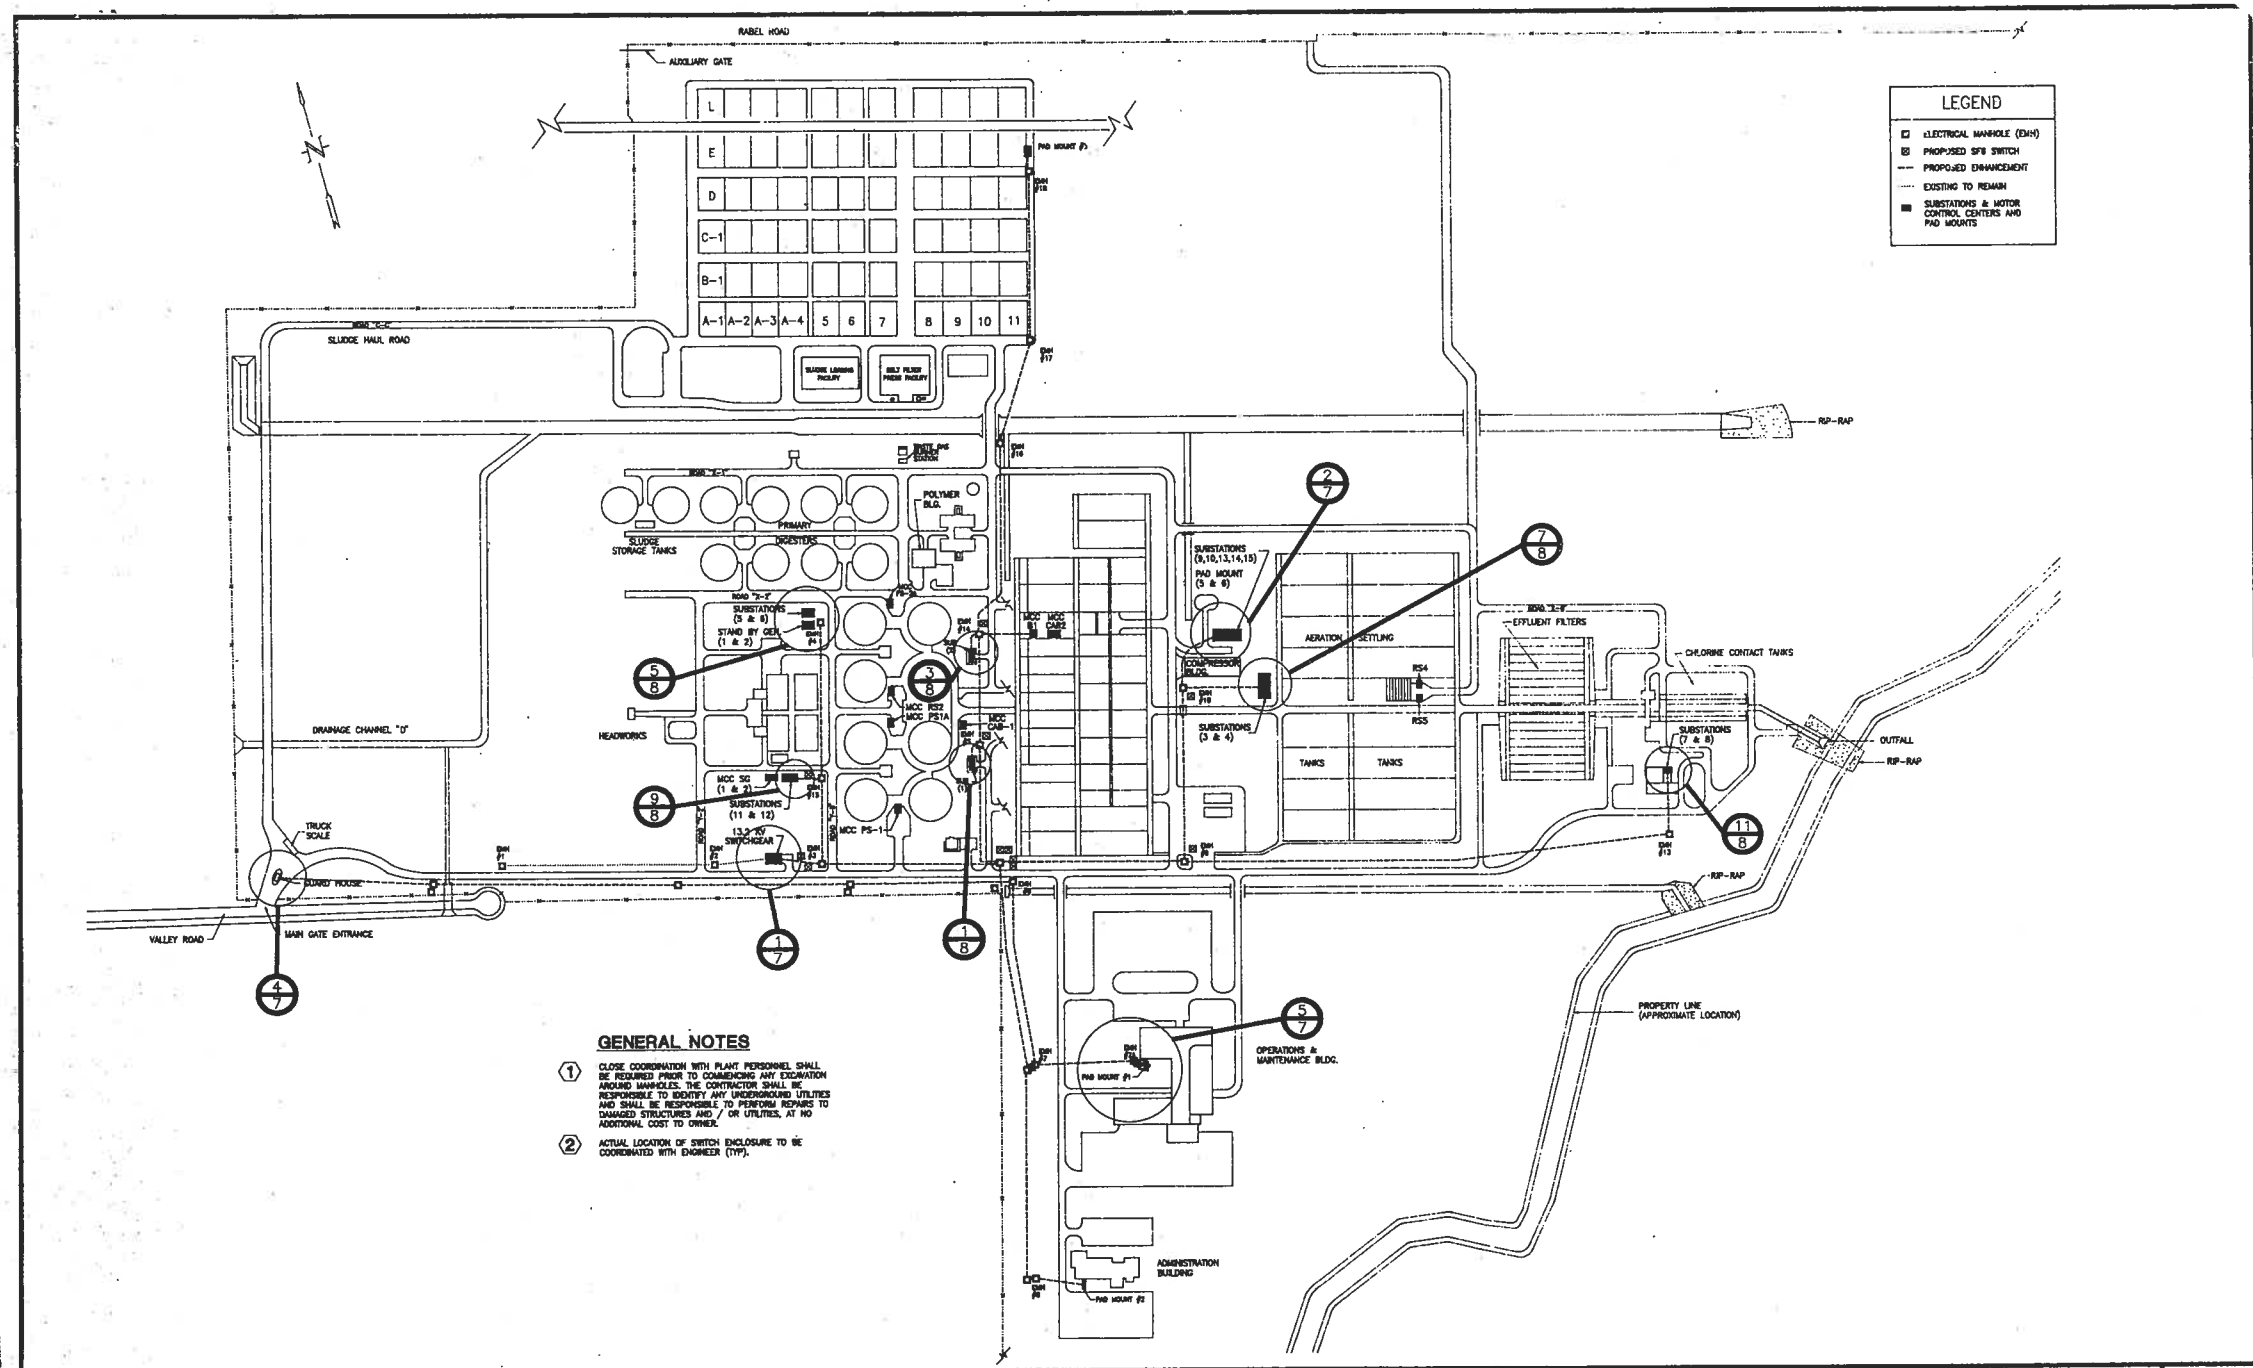

LEGEND	
□	ELECTRICAL MANHOLE (E/M)
⊗	PROPOSED SP# SWITCH
---	PROPOSED ENHANCEMENT
---	EXISTING TO REMAIN
■	SUBSTATIONS & MOTOR CONTROL CENTERS AND PAD MOUNTS

- GENERAL NOTES**
- 1 CLOSE COORDINATION WITH PLANT PERSONNEL SHALL BE REQUIRED PRIOR TO COMMENCING ANY EXCAVATION WORKS. UNLESS THE CONTRACTOR SHALL BE RESPONSIBLE TO IDENTIFY ANY UNDERGROUND UTILITIES AND SHALL BE RESPONSIBLE TO PERFORM REPAIRS TO DAMAGED STRUCTURES AND / OR UTILITIES, AT NO ADDITIONAL COST TO OWNER.
  - 2 ACTUAL LOCATION OF SWITCH ENCLOSURE TO BE COORDINATED WITH ENGINEER (TYP).

DR 92-0534

**PROJECT RE-ISSUED DUE TO SAWS MERGER**

PROJECT NO.	DATE
ACAD FILE	DATE
BASE DATE	DATE
SCALE	DATE
REV. BY	DATE
DESCRIPTION	DATE
DATE	DATE
DATE	DATE



MIRAMONTES  
**Engineering Co., Inc.**  
 ELECTRICAL • MECHANICAL • PROCESS CONTROL  
 CONSULTING ENGINEERS  
 10715 GULFDALE, SUITE 250 • SAN ANTONIO, TEXAS 78216  
 TEL. (210)348-2255 • FAX (210)348-2448



DRAWING TITLE  
**PLOT PLAN**  
 PROJECT TITLE  
**DOS RIOS WASTEWATER TREATMENT PLANT  
 ELECTRICAL ENHANCEMENTS**


SHEET  
**2**  
 OF 8

LEGEND	
	ELECTRICAL MAN HOLE (EMH)
	PROPOSED SFB SWITCH
	PROPOSED ENHANCEMENT
	EXISTING TO REMAIN
	SUBSTATIONS & MOTOR CONTROL CENTERS AND PAD MOUNTS
N	NORTH
E	EAST
EL	ELEVATION
T.O.M.H.	TOP OF MANHOLE

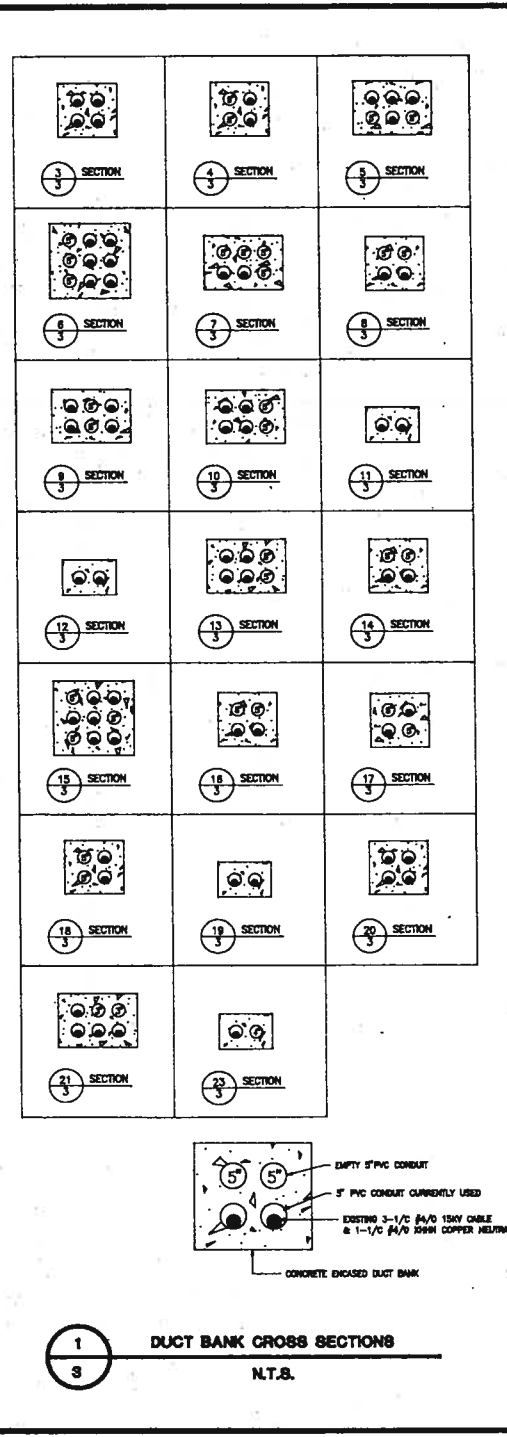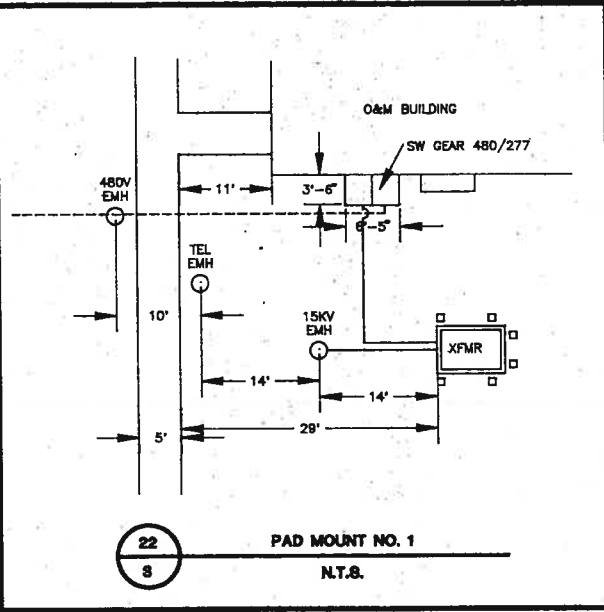

NOTE 1: DUCT BANK CROSS SECTIONS SHOWN HERE INDICATE "AS-BUILT" EXISTING CONDITIONS. THE CONTRACTOR SHALL BE RESPONSIBLE TO SUBMIT DUCT BANK CABLE ASSIGNMENTS AFTER FINAL INSTALLATION. EACH CIRCUIT ASSIGNMENT (H1,H2,H3,OR H4) SHALL BE INDICATED ON FINAL "AS-BUILT" PLANS.

NOTE 2: REFER TO SUBSTATION AND PADMOUNT DETAILS FOR DUCTBANK LAYOUT. THE CONTRACTOR SHALL ASSUME THAT THERE ARE NO SPARE CONDUITS FROM ELECTRICAL MANHOLES TO SUBSTATIONS, PADMOUNTS OR 13.2KV SWITCH ROOM FOR BID PURPOSES. PRIOR TO PREPARING INSTALLATION PHASING PLAN, THE CONTRACTOR SHALL BE RESPONSIBLE TO REMOVE ALL MANHOLE COVERS AND PRIMARY FEEDER PANELS TO EQUIPMENT AND SUBMIT WITH PHASING PLAN FOR APPROVAL.

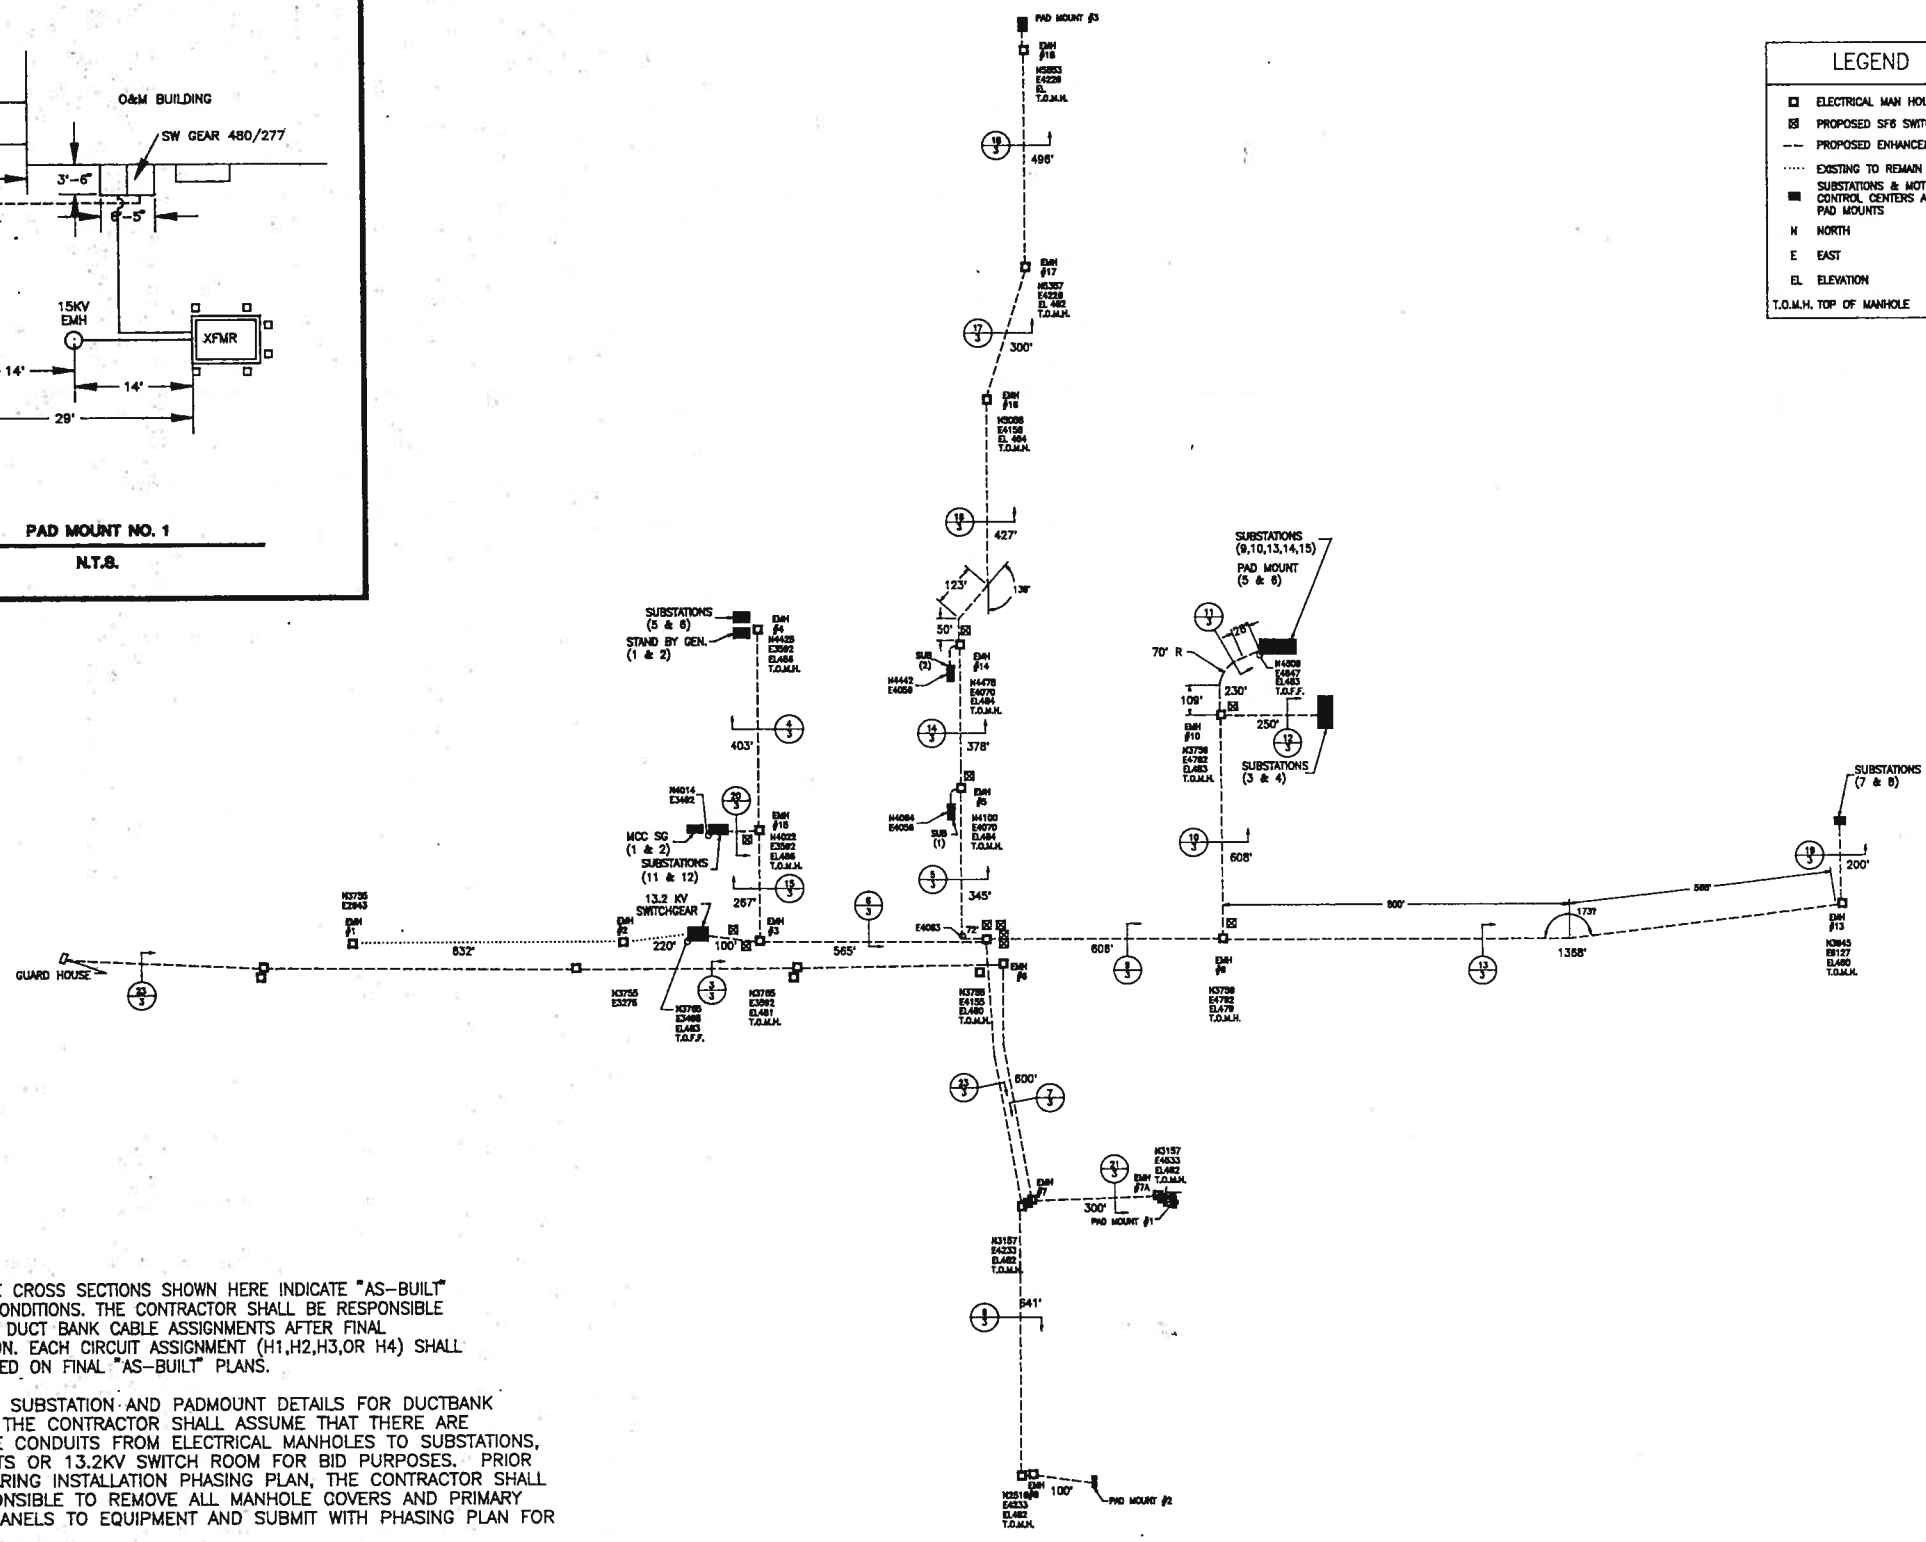

DR 92-0534

**PROJECT RE-ISSUED DUE TO SAWS MERGER**



PROJECT NO.	DESIGNED BY	DATE
ACAD FILE	DRAWN BY	DATE
BASE DATE	CHECKED BY	DATE
SCALE	APPROVED BY	DATE
REV. BY	DESCRIPTION	DATE

**MIRAMONTES Engineering Co., Inc.**  
 ELECTRICAL • MECHANICAL • PROCESS CONTROL  
 CONSULTING ENGINEERS  
 10715 GULFDAL, SUITE 250 • SAN ANTONIO, TEXAS 78218  
 TEL (210)349-2255 • FAX (210)349-2448



DRAWING TITLE  
**ONE LINE DIAGRAM**

PROJECT TITLE  
**DOS RIOS WASTEWATER TREATMENT PLANT  
 ELECTRICAL ENHANCEMENTS**

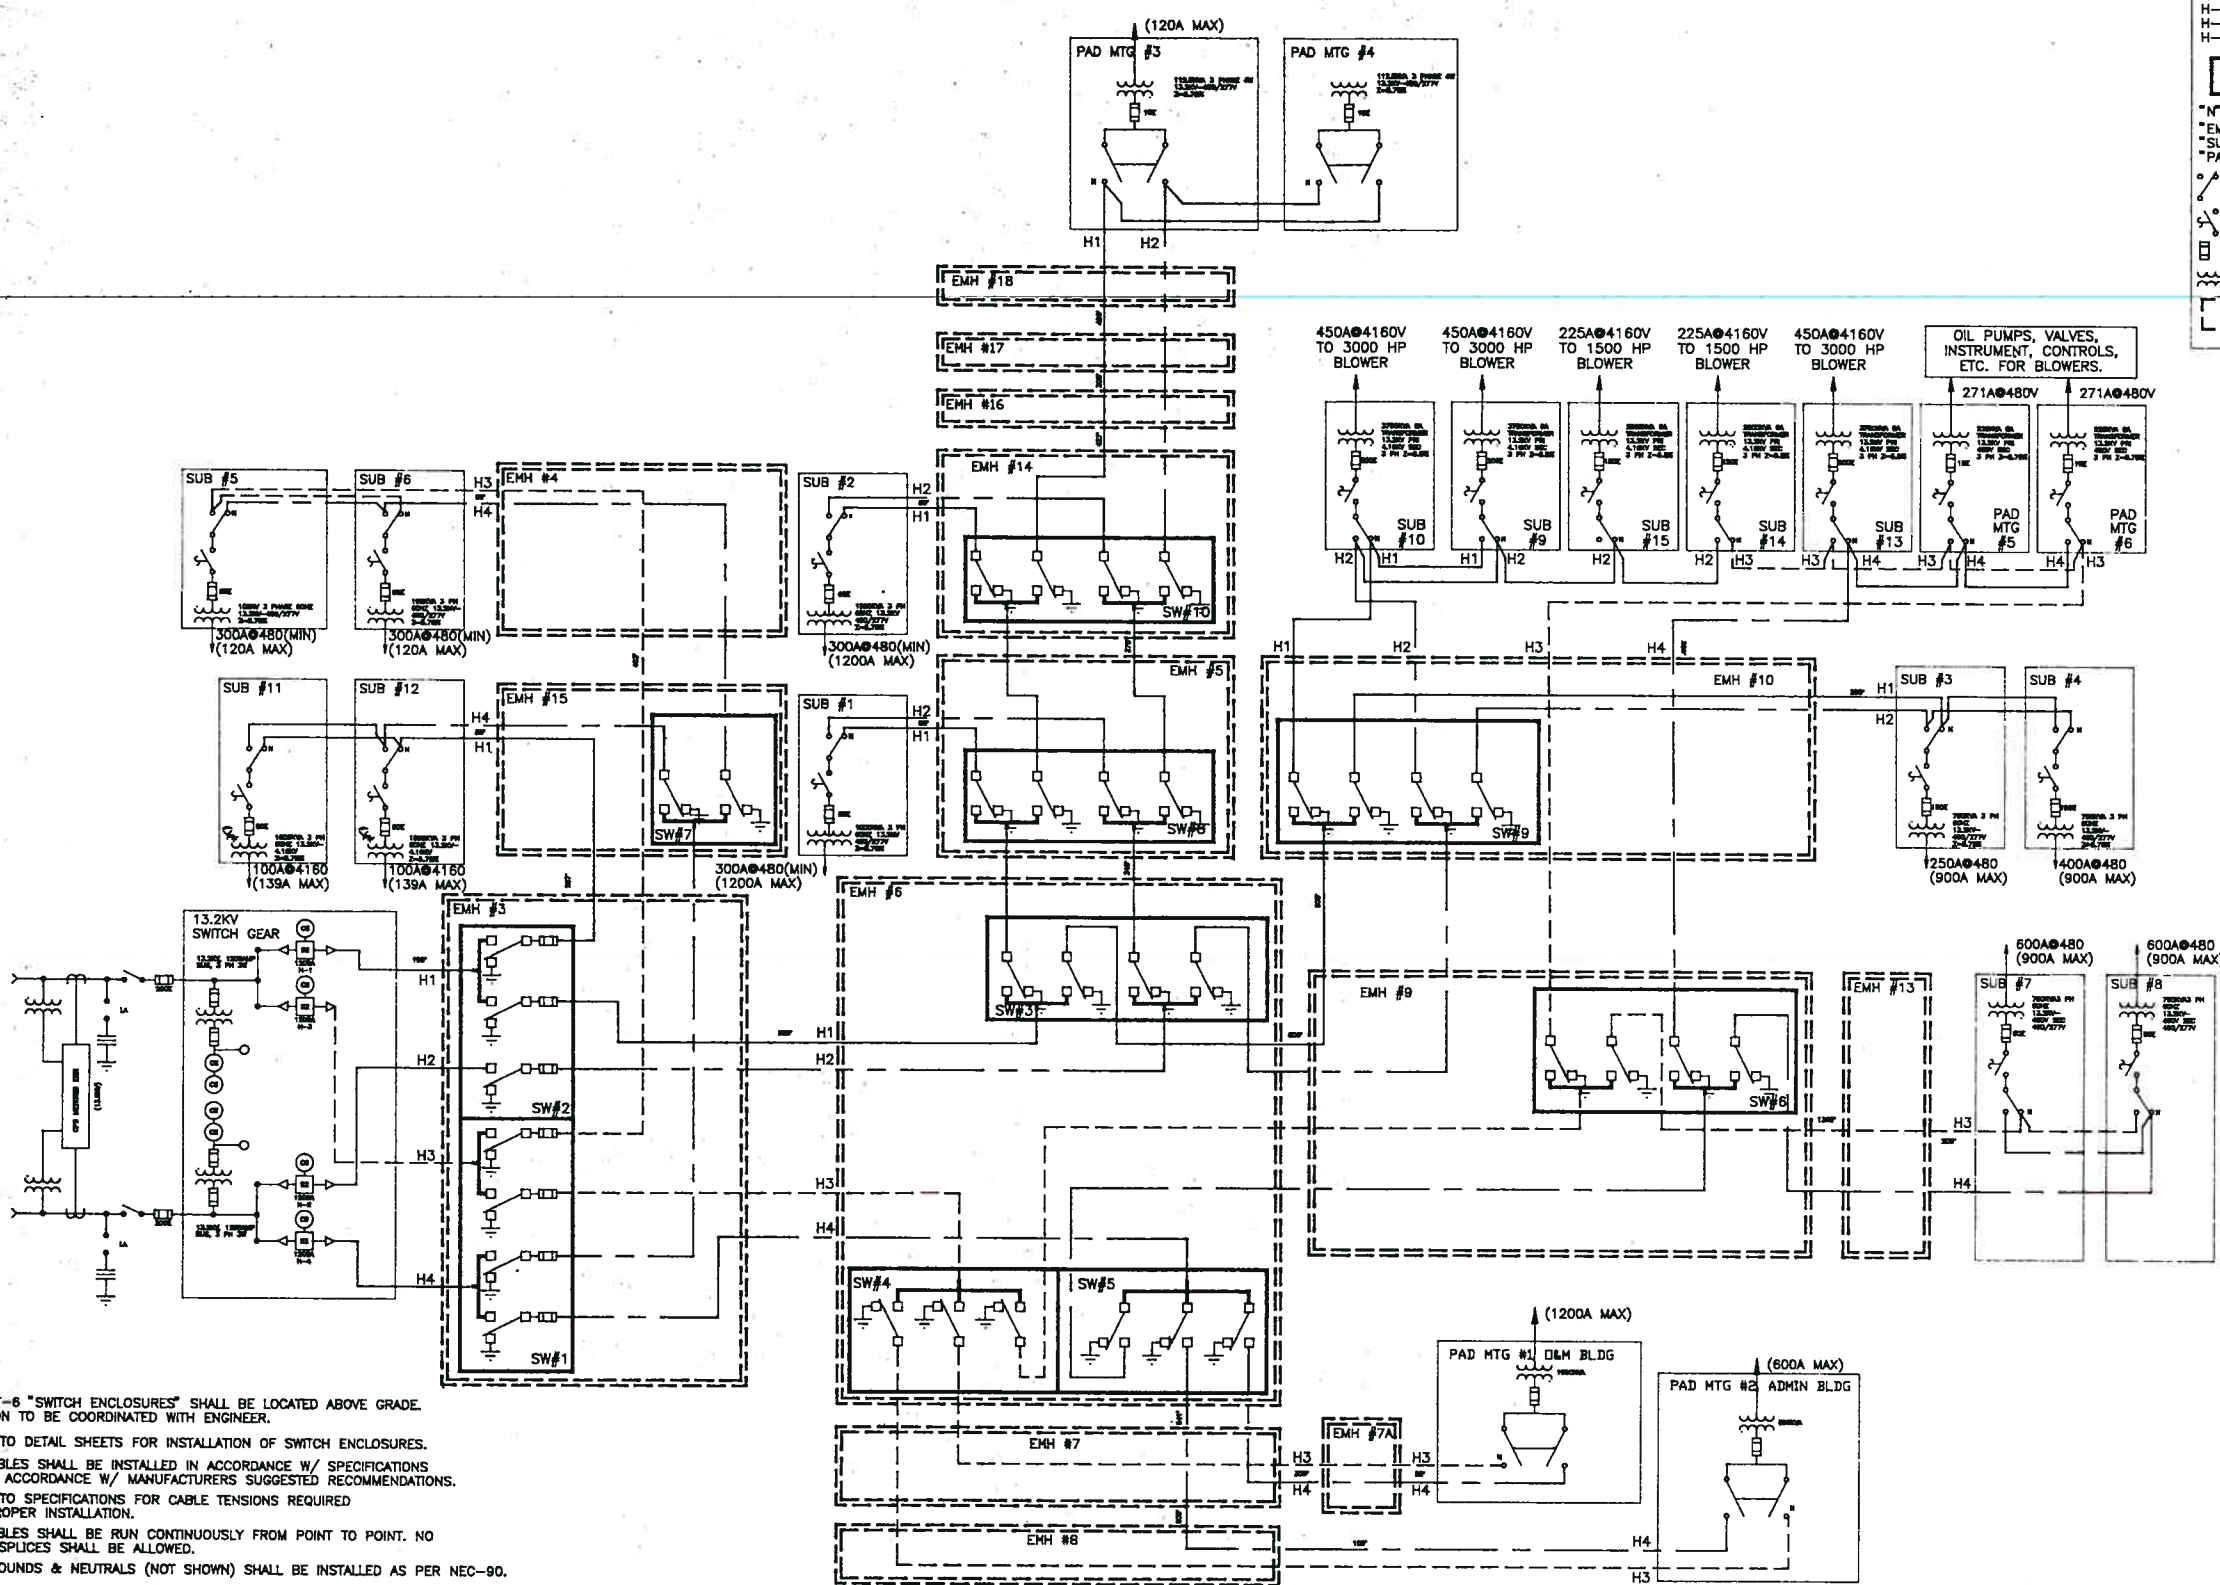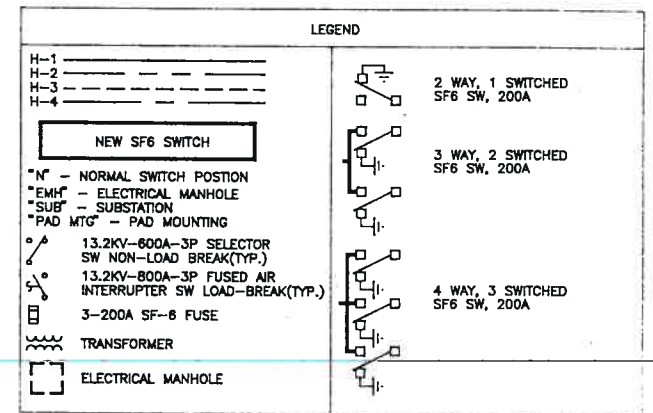


- NOTES:
- NEW SF-6 "SWITCH ENCLOSURES" SHALL BE LOCATED ABOVE GRADE. LOCATION TO BE COORDINATED WITH ENGINEER.
  - REFER TO DETAIL SHEETS FOR INSTALLATION OF SWITCH ENCLOSURES.
  - ALL CABLES SHALL BE INSTALLED IN ACCORDANCE W/ SPECIFICATIONS AND IN ACCORDANCE W/ MANUFACTURERS SUGGESTED RECOMMENDATIONS.
  - REFER TO SPECIFICATIONS FOR CABLE TENSIONS REQUIRED FOR PROPER INSTALLATION.
  - ALL CABLES SHALL BE RUN CONTINUOUSLY FROM POINT TO POINT. NO CABLE SPLICES SHALL BE ALLOWED.
  - ALL GROUNDS & NEUTRALS (NOT SHOWN) SHALL BE INSTALLED AS PER NEC-90.
  - THIS SHEET REFERS TO 15KV CABLE CIRCUITING ONLY. REFER TO DRAWINGS 2 AND 3 FOR 480/277 POWER ROUTING.

PROJECT RE-ISSUED DUE TO SAWS MERGER

PROJECT NO.	DESIGNED BY	DATE
ACAD FILE DRW\M5BLOCK	DRAWN BY	DATE
BASE DATE MARCH 1, 1992	CHECKED BY	DATE
SCALE N.T.S	APPROVED BY	DATE
REV. BY	DESCRIPTION	DATE

DESIGNED BY	DATE
DRAWN BY	DATE
CHECKED BY	DATE
APPROVED BY	DATE
O.M.	JUNE 29, 1993

MIRAMONTES  
**Engineering Co., Inc.**  
ELECTRICAL • MECHANICAL • PROCESS CONTROL  
CONSULTING ENGINEERS  
10715 GULFDALE, SUITE 250 • SAN ANTONIO, TEXAS 78218  
TEL (210)349-2255 • FAX (210)349-2448

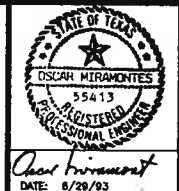


DRAWING TITLE  
**BLOCK DIAGRAM**

PROJECT TITLE  
**DOS RIOS WASTEWATER TREATMENT PLANT  
ELECTRICAL ENHANCEMENTS**

SHEET  
**4**  
OF 8

DR 92-0534




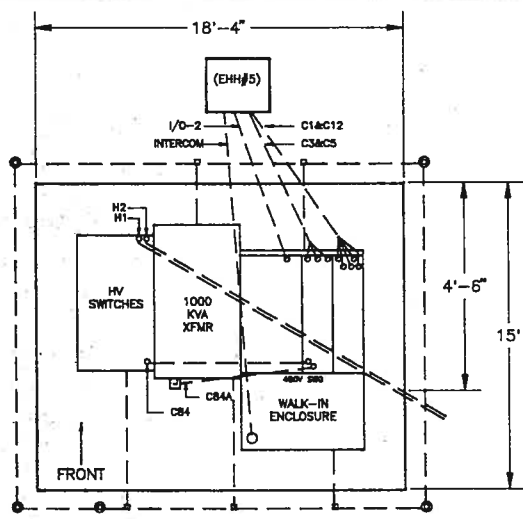

1 SUBSTATION NO. 1 PLAN  
N.T.S.

FUSED AIR INTERRUPTER SWITCH AND SELECTOR SWITCH	1000 KVA TRANSFORMER	TRANSITION	MAIN BUS METERS	MCC B BKR
		DIST. PNL 12-CKT	MCC PS-1 BKR	MCC SG-1 BKR
			MCC RS-1 BKR	BLANK
			TC-1	BLANK


2 SUBSTATION NO. 1 FRONT VIEW  
N.T.S.

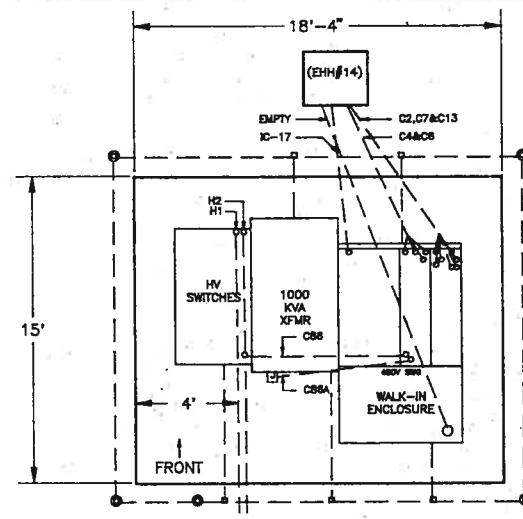

3 SUBSTATION NO. 2 PLAN  
N.T.S.

FUSED AIR INTERRUPTER SWITCH AND SELECTOR SWITCH	1000 KVA TRANSFORMER	TRANSITION	MAIN BUS METERS	MCC B BKR
		DIST. PNL 12-CKT	MCC PS-2 BKR	MCC SG-2 BKR
			MCC RS-2 BKR	MCC RS-2A BKR
			TC-1	BLANK


4 SUBSTATION NO. 2 FRONT VIEW  
N.T.S.

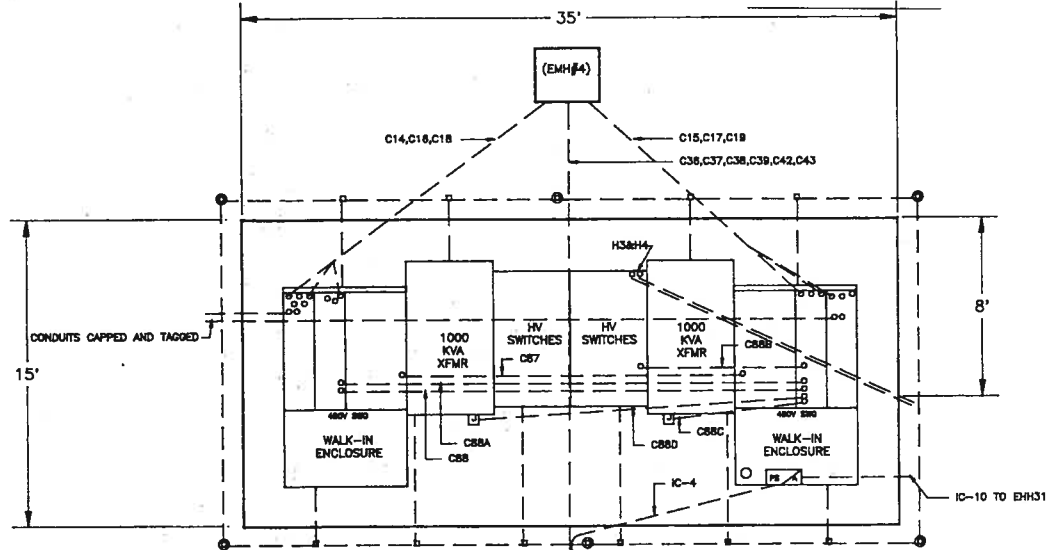


5 UNIT SUBSTATION PLAN  
N.T.S.

MAIN BUS METERS	BLANK	TRANSITION	1000 KVA TRANSFORMER	FUSED AIR INTERRUPTER SWITCH AND SELECTOR SWITCH	FUSED AIR INTERRUPTER SWITCH AND SELECTOR SWITCH	1000 KVA TRANSFORMER	TRANSITION	MAIN BUS METERS	BLANK
MCC PD-1 BKR	MCC FT-1 BKR							MCC PD-2 BKR	MCC PD-4 BKR
MCC PD-3 BKR	BLANK	ATS						MCC FT-2 BKR	BLANK
BLANK	TC-5	DIST. PNL 12-CKT						I/O PD-6	TC-6


6 UNIT SUBSTATION FRONT VIEW  
N.T.S.

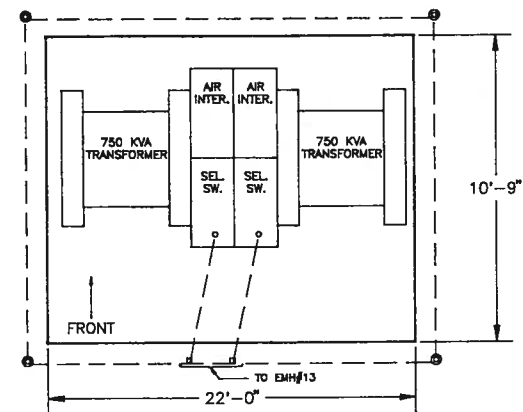

11 SUBSTATIONS NO. 7 AND 8 PLAN  
N.T.S.

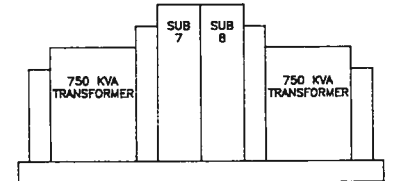


12 SUBSTATIONS NO. 7 AND 8 FRONT VIEW  
N.T.S.

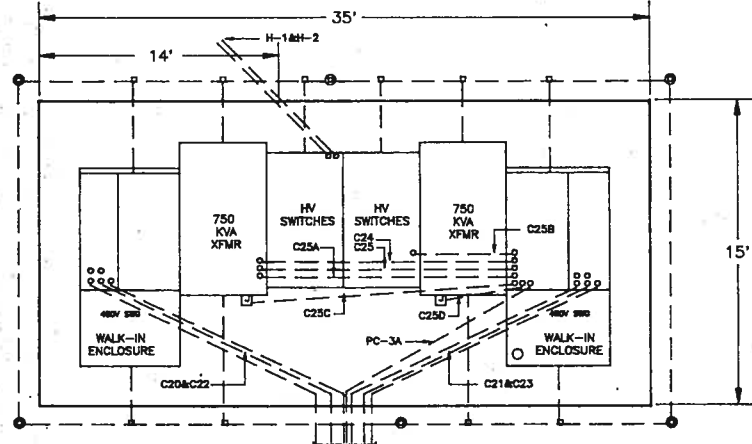

7 UNIT SUBSTATION PLAN  
N.T.S.

BLANK	TRANSITION	750 KVA TRANSFORMER	FUSED AIR INTERRUPTER SWITCH AND SELECTOR SWITCH	FUSED AIR INTERRUPTER SWITCH AND SELECTOR SWITCH	750 KVA TRANSFORMER	TRANSITION	MAIN BUS METERS
MCC AT-1 BKR	CPT						MCC AT-2 BKR
MCC RS-3 BKR	ATS						MCC RS-4 BKR
BLANK	DIST. PNL 12-CKT						I/O PD-6

8 UNIT SUBSTATION FRONT VIEW  
N.T.S.

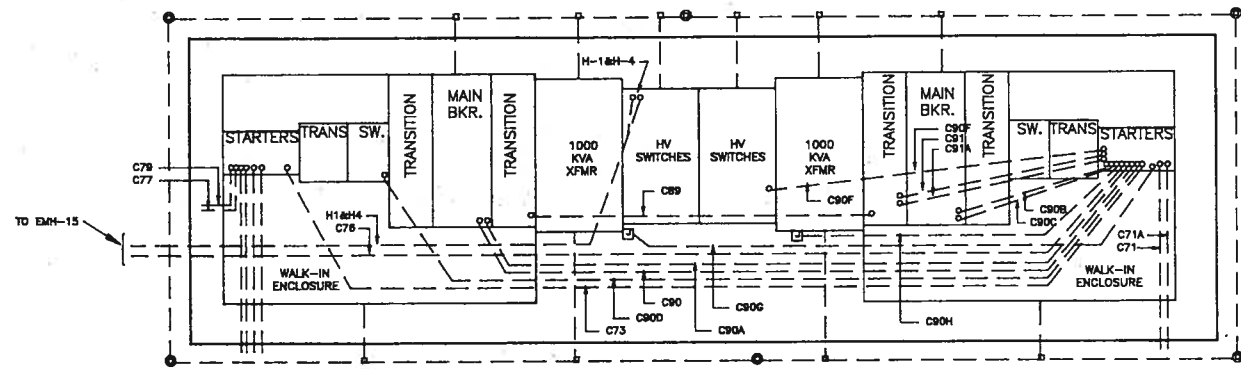

9 UNIT SUBSTATION PLAN  
N.T.S.

PRE AERATION BLOWER NO. 1	TRANSITION	SWITCH F-1	TRANSITION	MAIN BKR. CT'S PT'S & RELAYS	TRANSITION	1000 KVA TRANSFORMER	FUSED AIR INTERRUPTER SWITCH AND SELECTOR SWITCH	FUSED AIR INTERRUPTER SWITCH AND SELECTOR SWITCH	1000 KVA TRANSFORMER	TRANSITION	MAIN BKR. CT'S PT'S & RELAYS	TRANSITION	SWITCH F-2	TRANSITION	TC-12
															PRE AERATION BLOWER NO. 2


10 UNIT SUBSTATION FRONT VIEW  
N.T.S.

PROJECT RE-ISSUED DUE TO SAWS MERGER

PROJECT NO.	DRM/DETAL-2	
ACAD FILE	DRM/DETAL-2	
BASE DATE	MARCH 1, 1992	
SCALE	N.T.S.	
REV. BY	DESCRIPTION	DATE

DESIGNED BY	DATE
DRAWN BY	DATE
CHECKED BY	DATE
APPROVED BY	DATE


MIRAMONTES  
**Engineering Co., Inc.**  
 ELECTRICAL • MECHANICAL • PROCESS CONTROL  
 CONSULTING ENGINEERS  
 10715 GULFDAL, SUITE 250 • SAN ANTONIO, TEXAS 78216  
 TEL. (210)349-2255 • FAX (210)349-2448

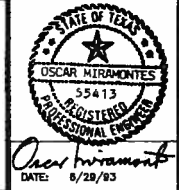

DRAWING TITLE  
**DETAIL**  
 PROJECT TITLE  
**DOS RIOS WASTEWATER TREATMENT PLANT ELECTRICAL ENHANCEMENTS**

DR 92-0534

1	11-10-94	AS-BUILT	SELECTED SLUDGE DRY BEDS
			ROWS A-L, 12-59
			ADDED LEGEND AND
			U.C.S.D.B.

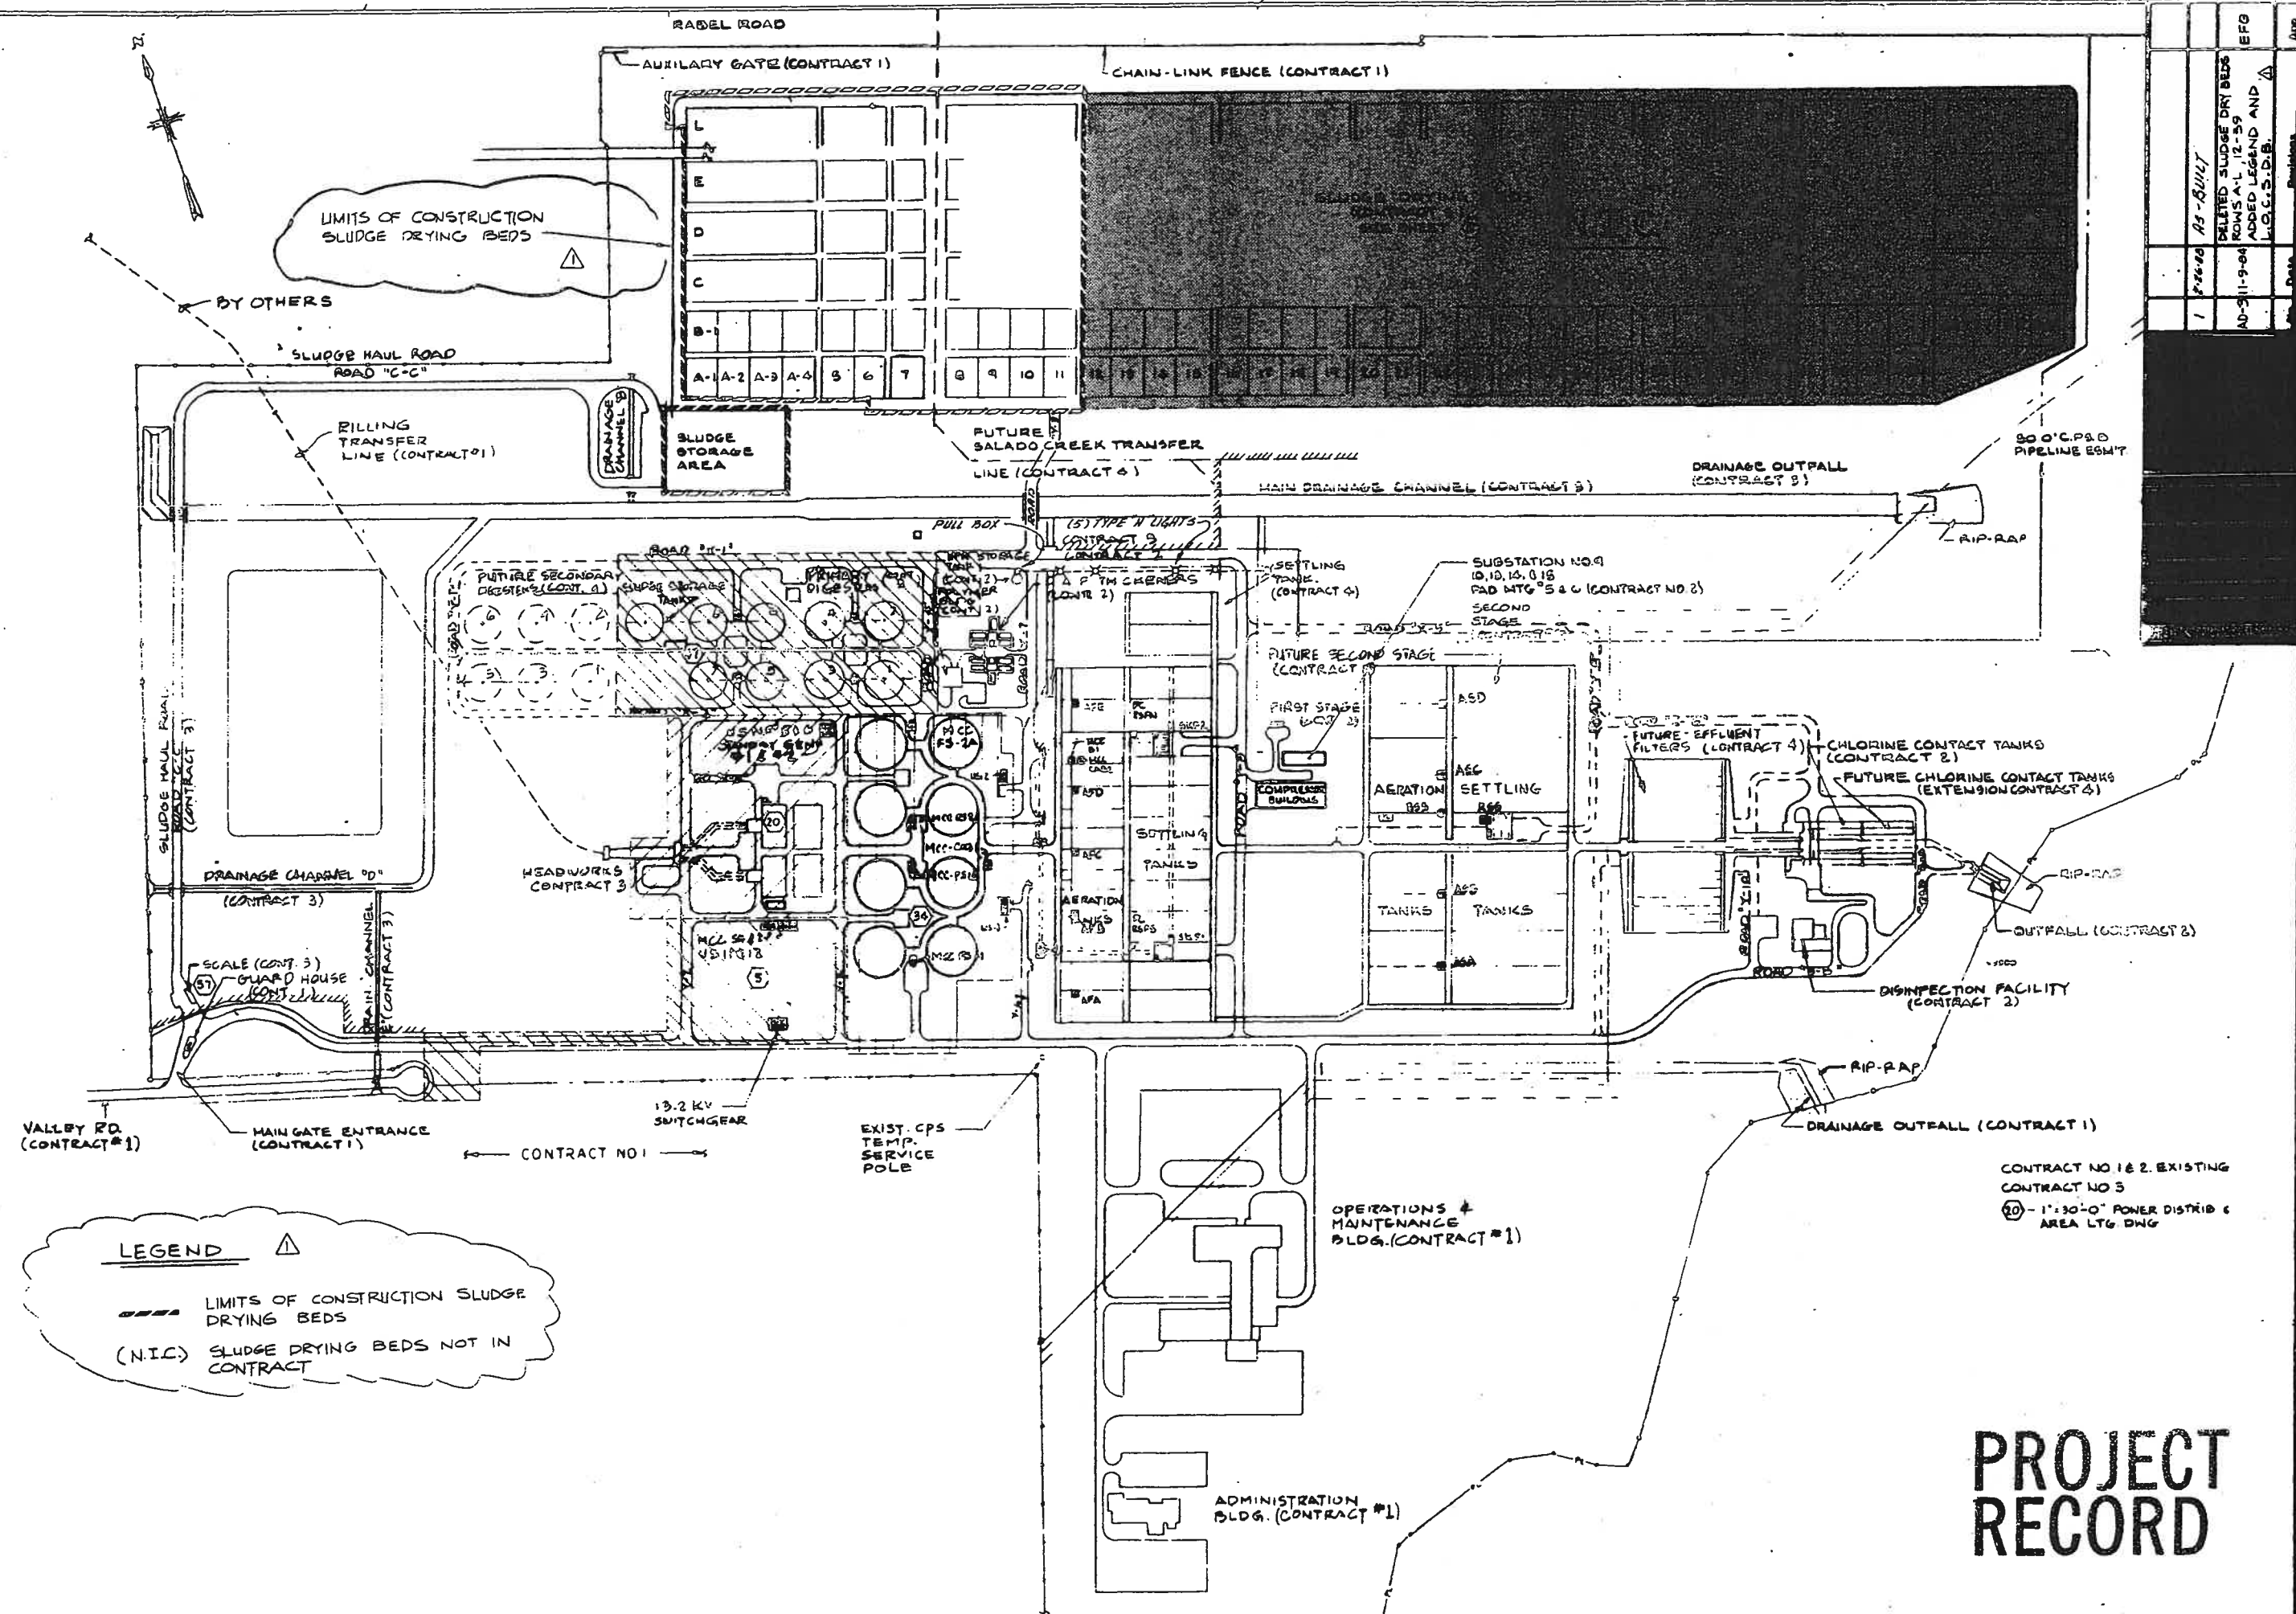

**LEGEND**

▲ LIMITS OF CONSTRUCTION SLUDGE DRYING BEDS

--- (N.I.C.) SLUDGE DRYING BEDS NOT IN CONTRACT

**San Antonio**

WATERWORKS  
FACILITIES  
IMPROVEMENTS

CONTRACT NO. 3

**DOS RIOS FACILITY**

GENERAL

SITE PLAN-ELECTRICAL FACILITIES

**PROJECT RECORD**

**MALCOLM PIRNIE**

**CPI**  
CURTIS NEAL & ASSOCIATES, INC.  
CONSULTING ENGINEERS  
1187 E. COMMERCE  
SAN ANTONIO, TEXAS 78205




Date: NOV 1983  
Designed by: K. W. WILKINSON  
Drawn by: M. H. GEMMEL  
Checked by: C. E. NICHOLS  
Scale: 1" = 30'





**San Antonio**  
WASTEWATER FACILITIES IMPROVEMENTS

**DOS RIOS FACILITY**  
GENERAL IMPROVEMENTS  
POWER DISTRIBUTION & AREA LIGHTING

CONTRACT NO. 3

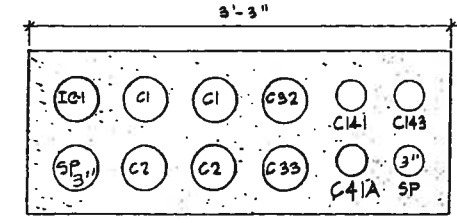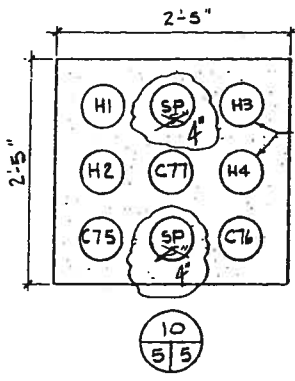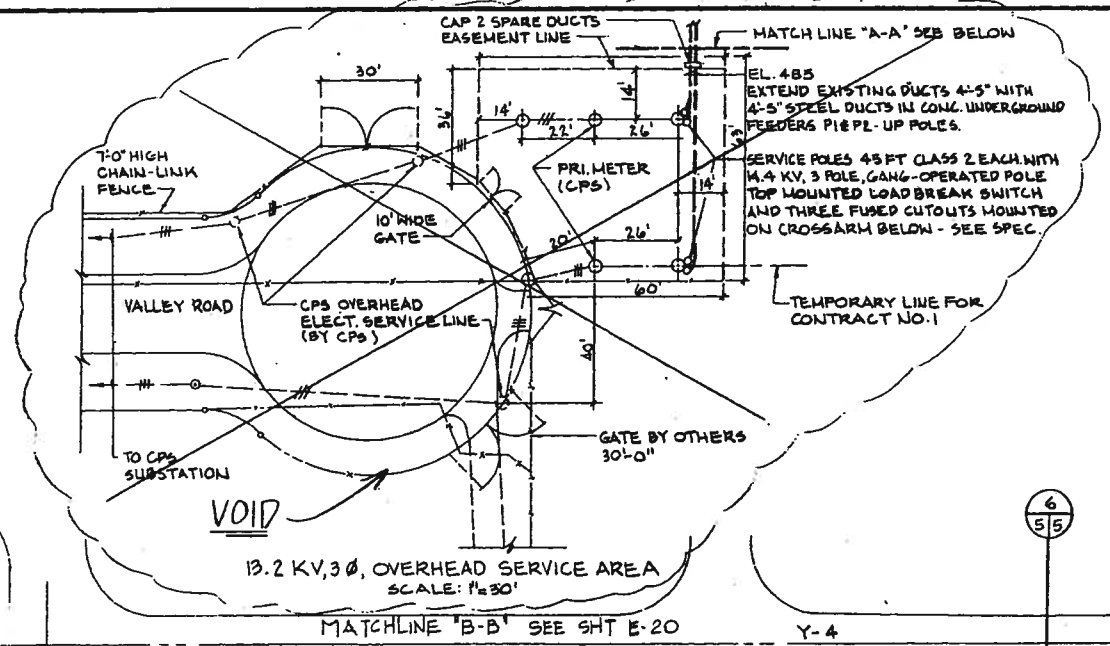


5 DUCT BANK CONFIGURATIONS NOT TO SCALE (TYP.)

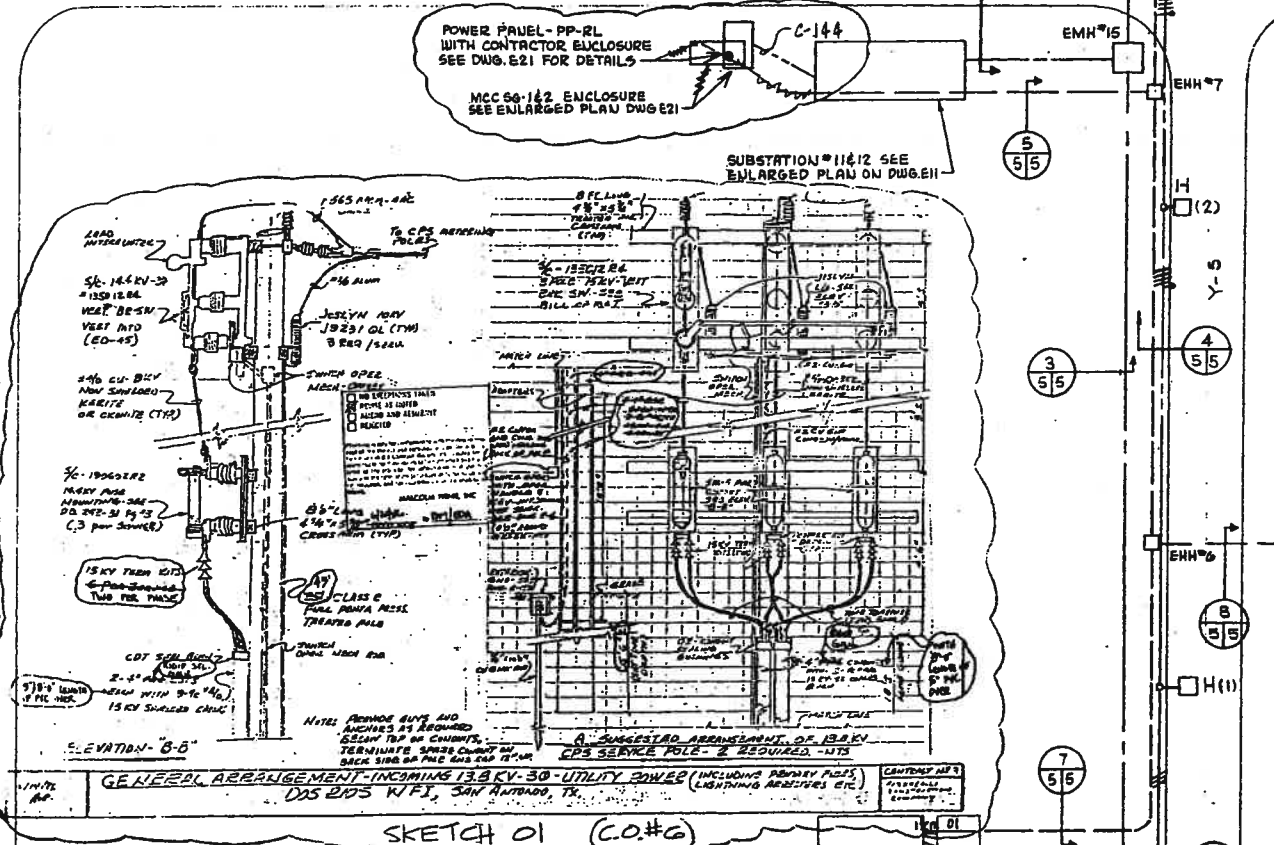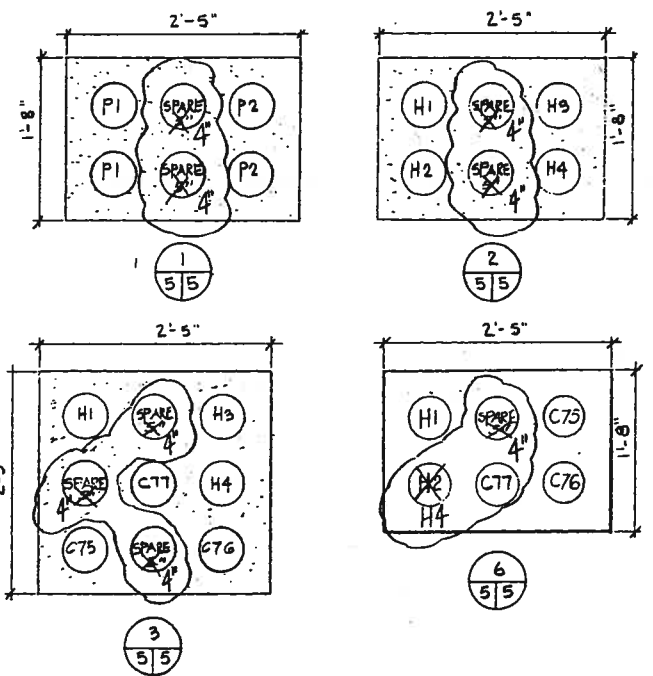


NOTES:  
ALL DUCT BANK CONFIGURATIONS SHOWN ON DWG. E-5, E-20, E-34, & E-47 ARE 1'-4" DEEP, INCLUDING 3" OF SAND ON ALL SIDES UNLESS NOTED OTHERWISE.  
ALL DUCT BANK CONFIGURATION DIMENSIONS ARE ROUNDED TO NEAREST INCH FOR COMPLETE BURIED DUCT BANK INSTALLATION.

REFER TO DRAWING E-5X FOR "AS-BUILT" CONDITIONS






**RECORD DRAWINGS**  
This drawing reflects changes from the original contract drawing that were made during construction and has been prepared from information provided to the Engineer by the construction contractor(s). The Engineer does not warrant this drawing to be complete and accurate in all respects.  
MALCOLM PIRNIE, INC.  
Date 6/88 By HGM

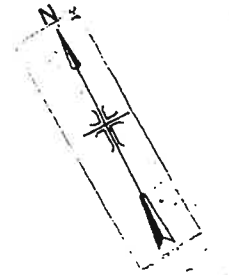

INCOMING POWER SEE SKETCH OF THIS SHEET.

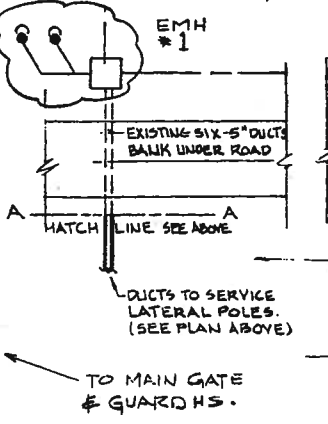

C.P.S. EASEMENT AREA

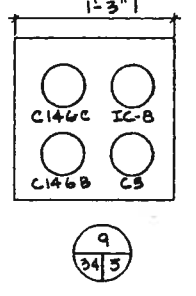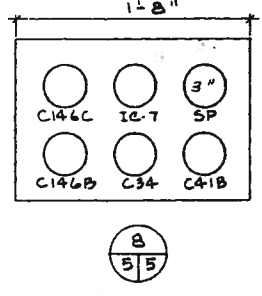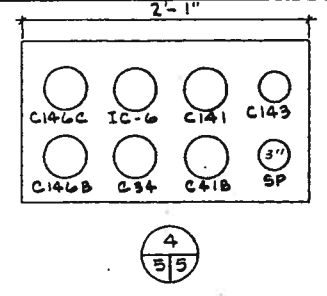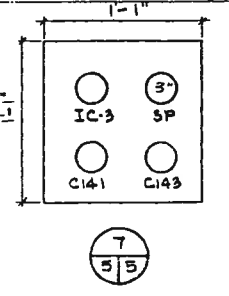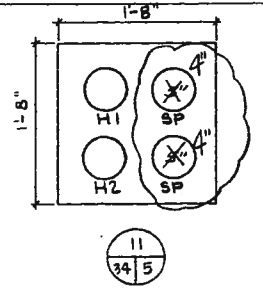

**RECORD DRAWINGS**  
 This drawing reflects changes from the original contract drawing that were made during construction and has been prepared from information provided to the Engineer by the construction contractors. The Engineer does not warrant this drawing to be complete and accurate in all respects.  
 MALCOLM PIRNIE, INC.  
 Date: 4/88 By: MGM

**MALCOLM PIRNIE**






Date: NOV 1983  
 Designed by: FS  
 Drawn by: FS  
 Checked by: [Signature]  
 Scale: NO SCALE



WORKSHEET  
 REVISIONS  
 IMPROVEMENTS

SAN ANTONIO



CONTRACT NO. 3  
 DOS RIOS FACILITY  
 GENERAL  
 13.2 KV DISTRIBUTION SWITCHGEAR

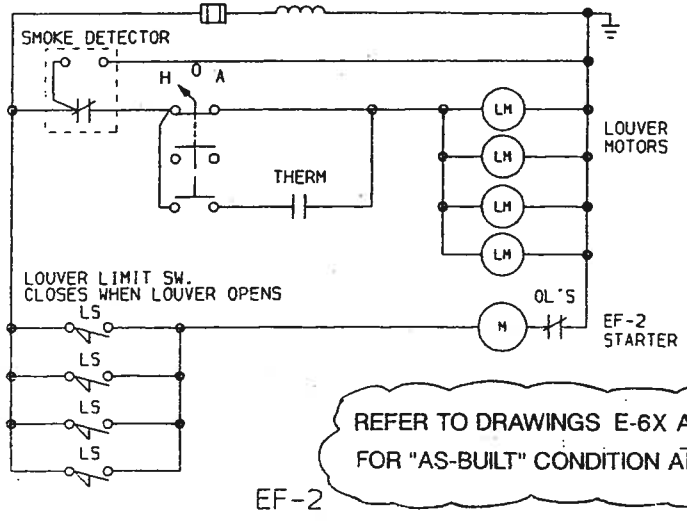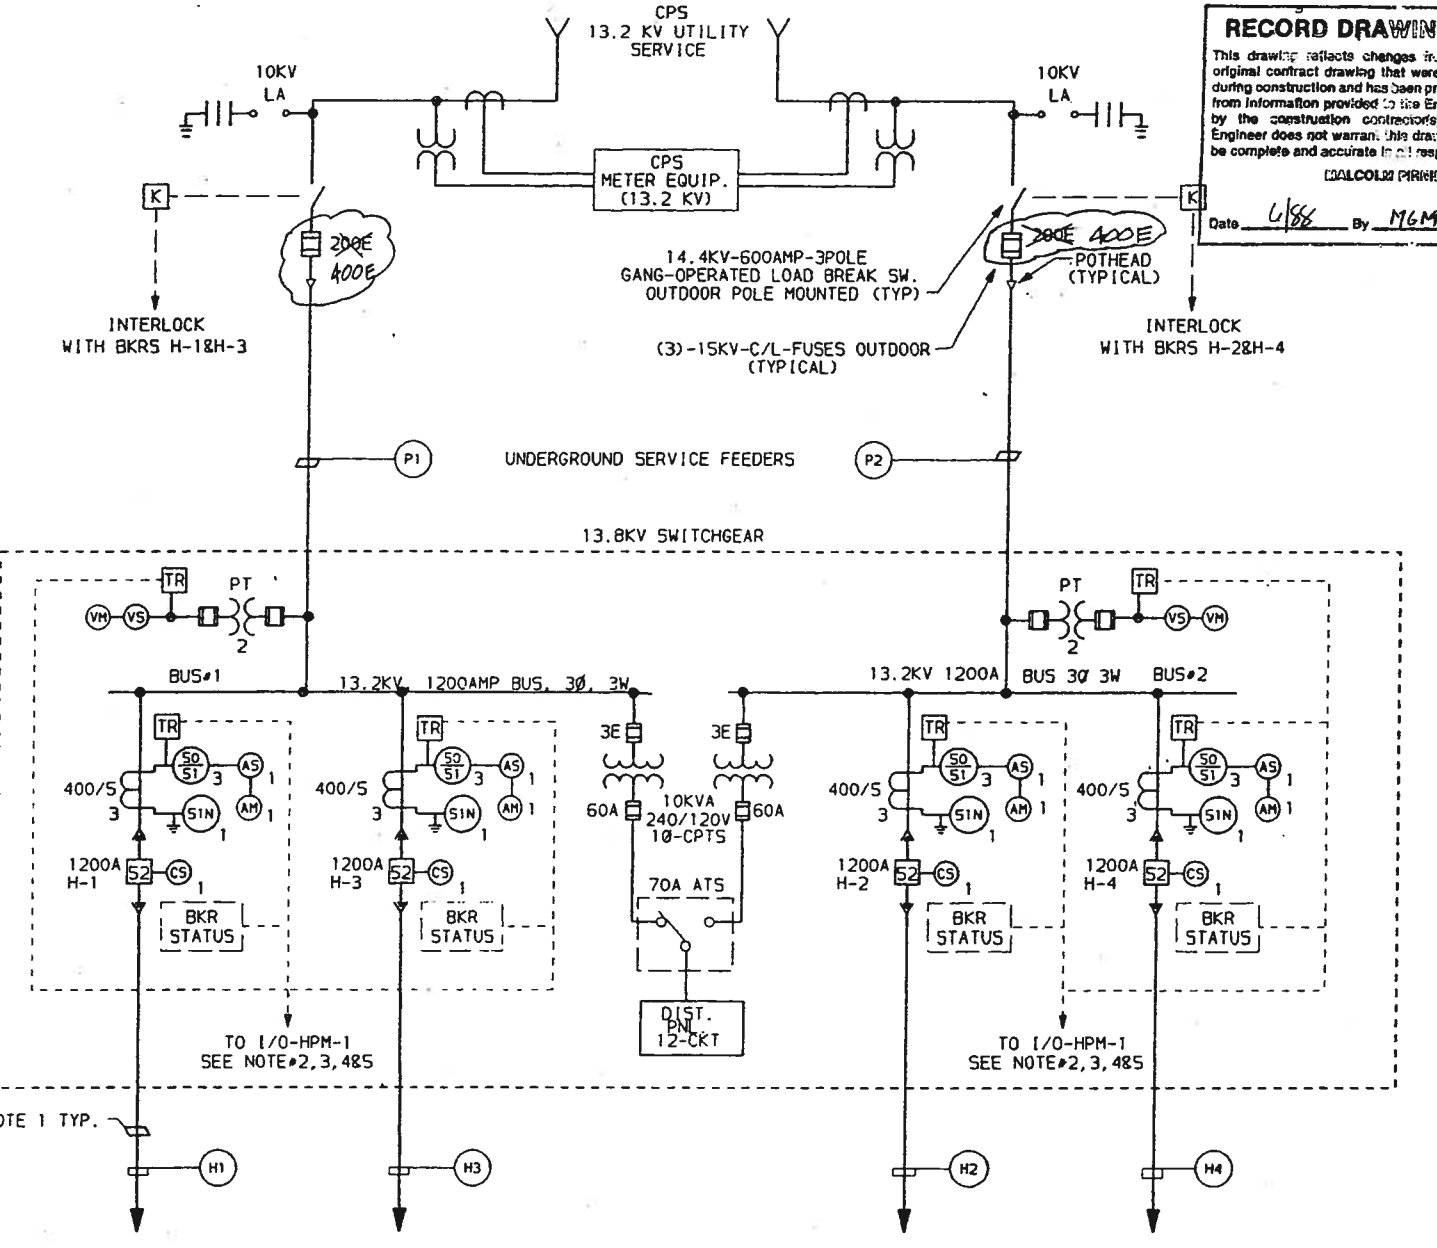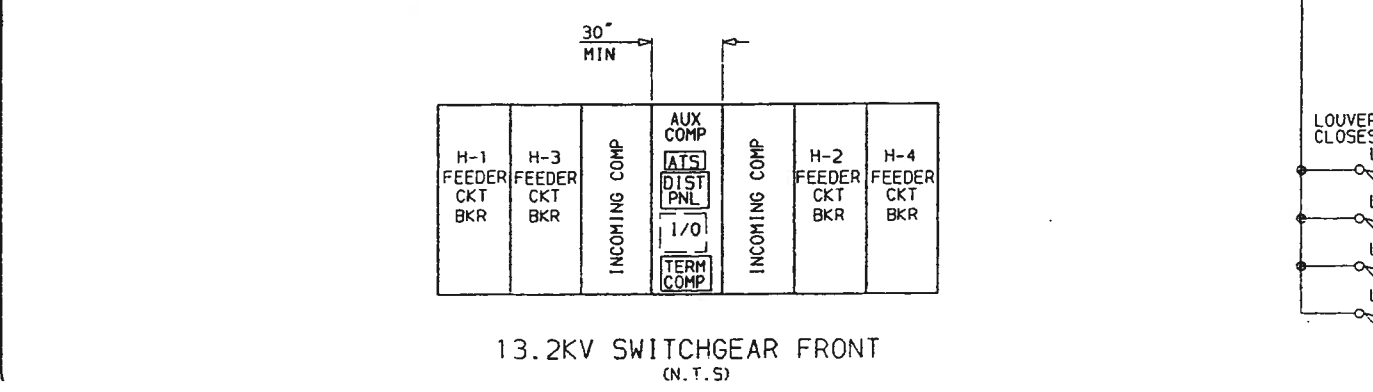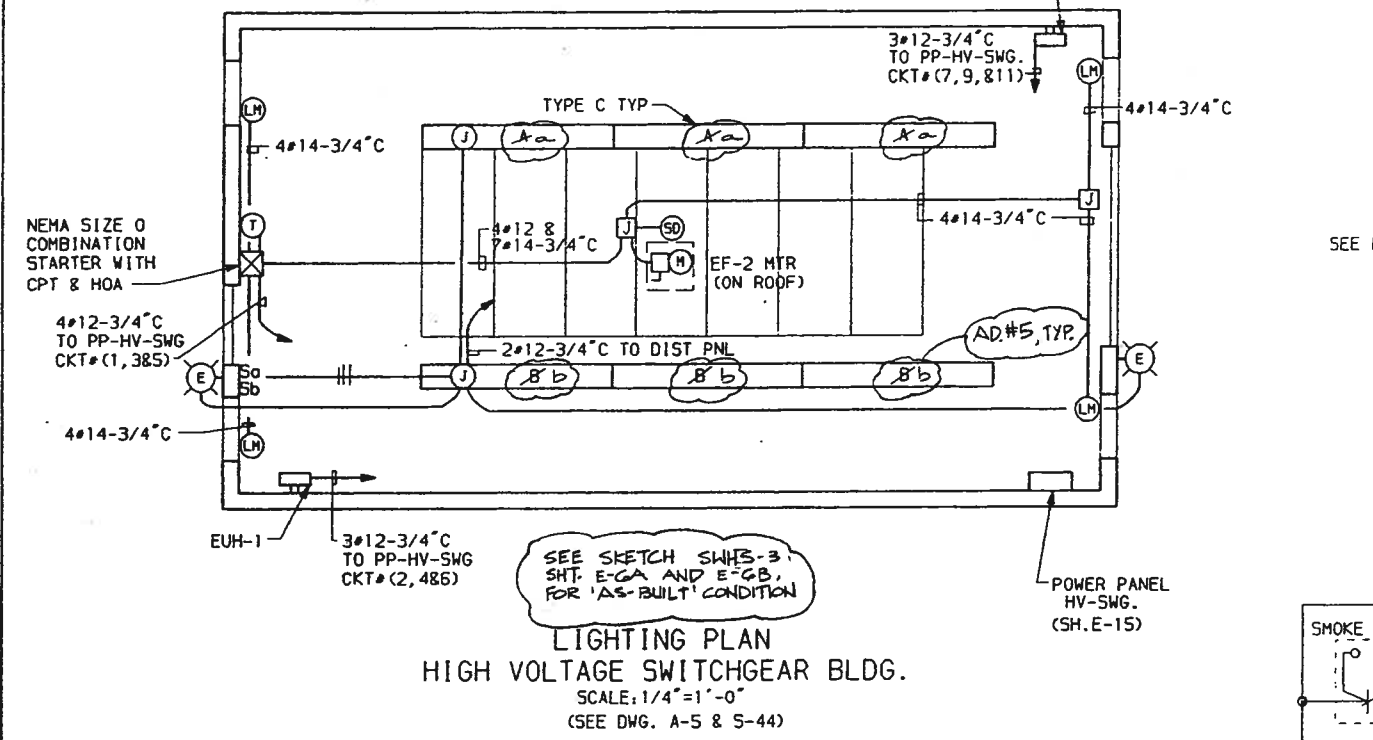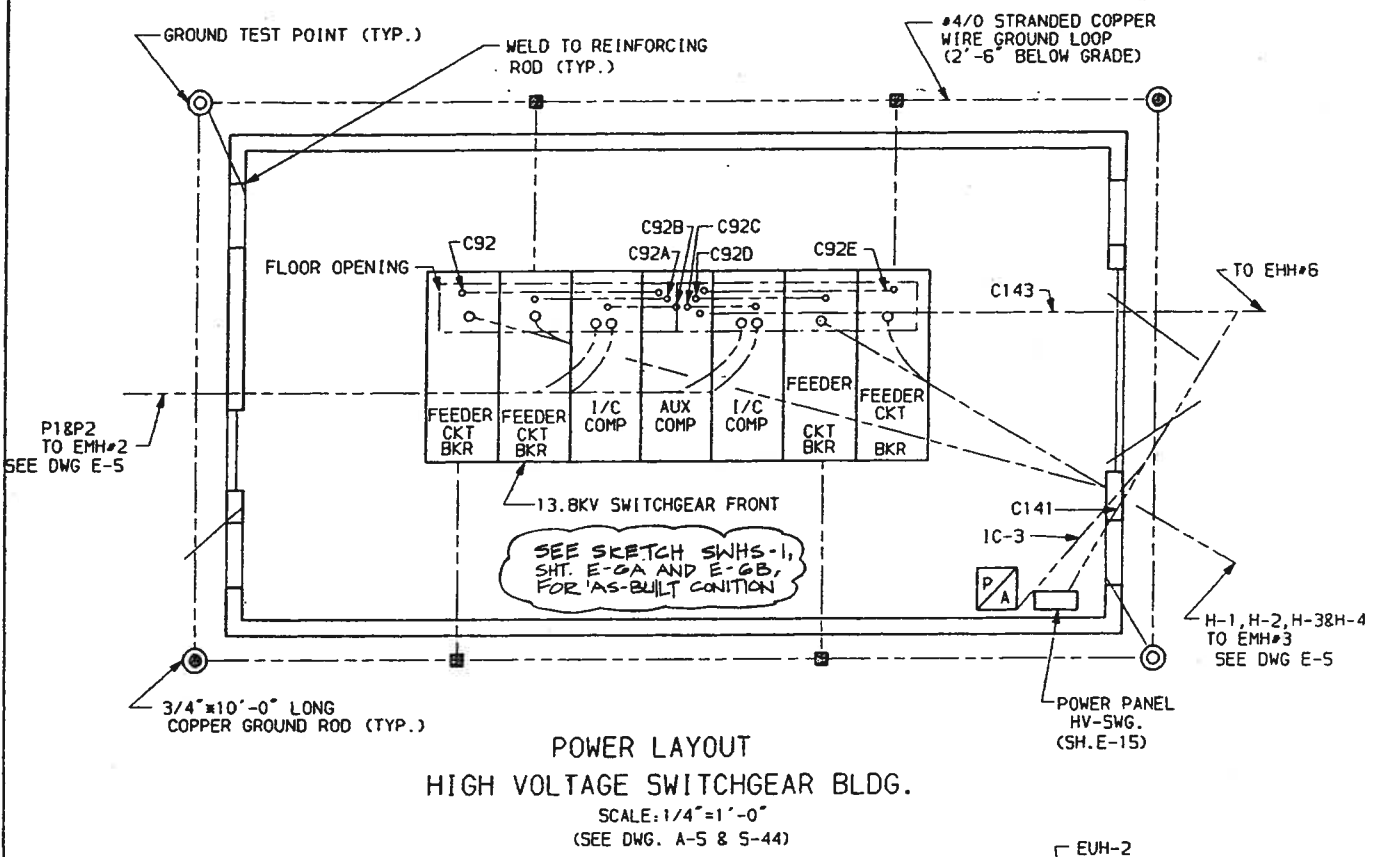


REFER TO DRAWINGS E-6X AND E-6XA FOR "AS-BUILT" CONDITION AND SKETCHES

**NOTE:**  
 1 CABLE SHALL BE ONE CONTINUOUS SIZE FROM CIRCUIT BREAKER TO EACH SUBSTATION OR PAD MOUNT XFMR. REFER TO DWG E2 FOR LOADS ASSOCIATED WITH EACH FEEDER.  
 2 SUBSTATION VENDOR SHALL PROVIDE TERMINAL COMPARTMENT WITH 35 TERMINALS OF WHICH 15 ARE ISOLATED TERMINALS FOR SIGNALS OF TRANSDUCERS.  
 3 SUBSTATION VENDOR SHALL PROVIDE CONTROL WIRING TROUGH THRU EACH SWITCHGEAR COMPARTMENT FOR BREAKER STATUS WIRING.  
 4 CONTRACTOR SHALL EXTEND CIRCUIT BREAKER STATUS WIRING VIA WIRE TROUGH AND TERMINATE ON TERMINAL STRIP OF TERMINAL COMPARTMENT.  
 5 CONTRACTOR SHALL ARRANGE AUXILIARY COMPARTMENT OF SWITCHGEAR SUCH THAT I/O-HPM-1 PROVIDED UNDER CONTRACT#2, CAN BE INSTALLED IN SWITCHGEAR UNDER CONTRACT NO. 2.

DR 83-8502

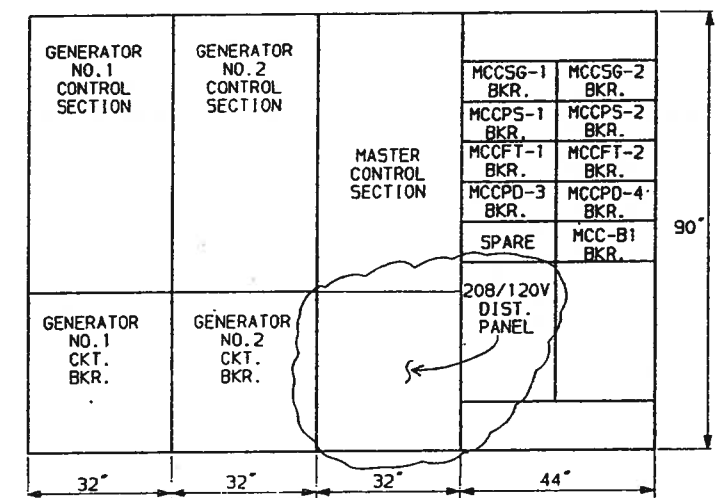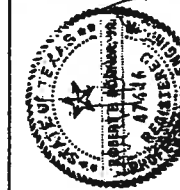


STANDBY SWITCHBOARD NO. 1.  
FRONT VIEW  
(NOT TO SCALE)  
NOTE: DIMENSIONS DEPEND ON EQUIPMENT SELECTED.

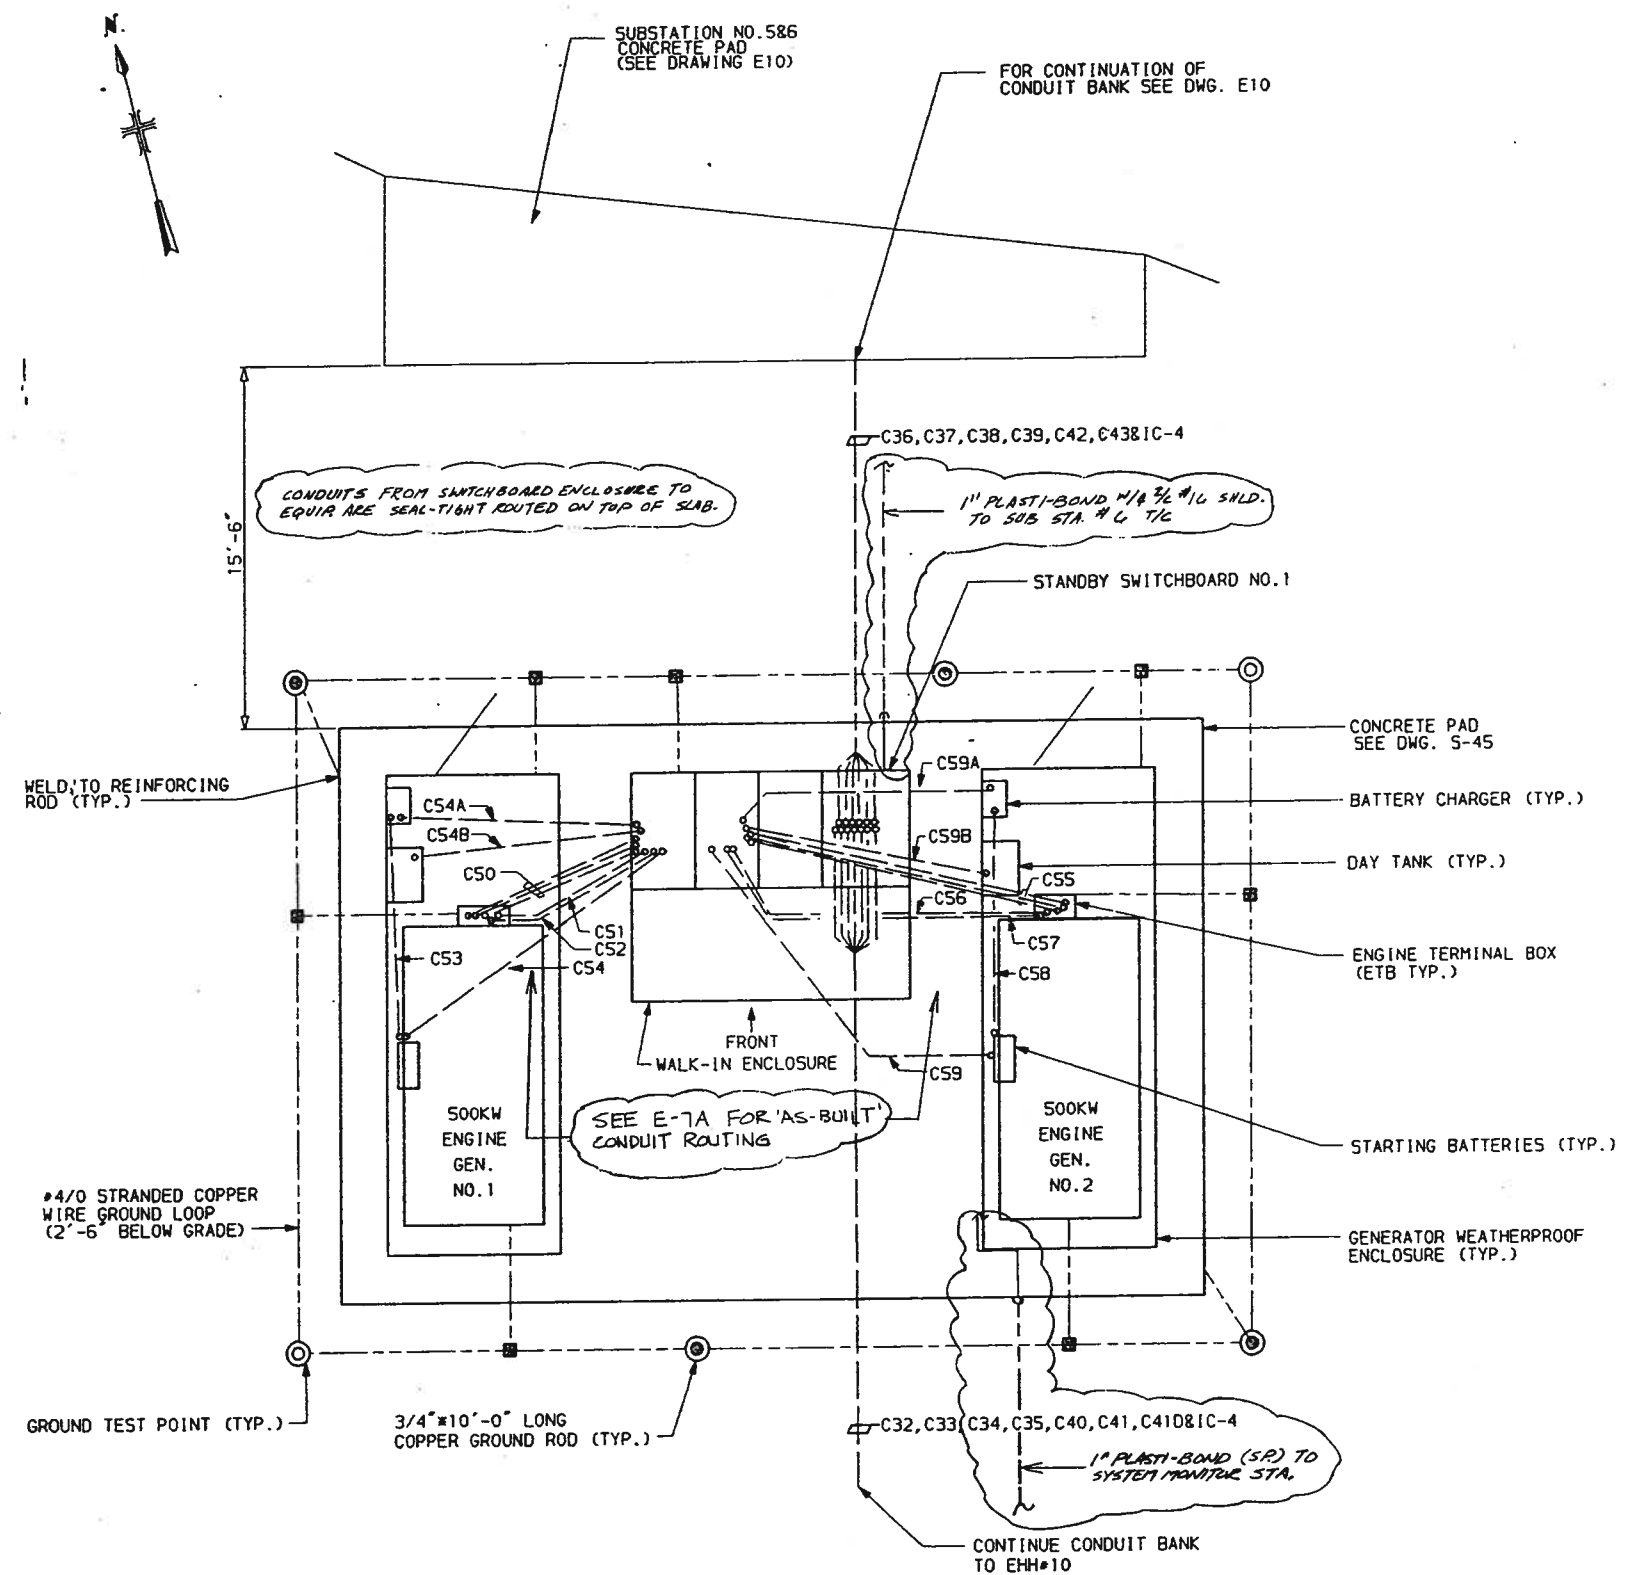



**RECORD DRAWINGS**  
This drawing reflects changes from the original contract drawing that were made during construction and has been prepared from information provided to the Engineer by the construction contractor(s). The Engineer does not warrant this drawing to be complete and accurate in all respects.  
MALCOLM PIRNIE, INC.  
Date 6/84 By M6M

REFER TO DRAWING E-7X FOR "AS-BUILT" CONDITION


DR 83-6502

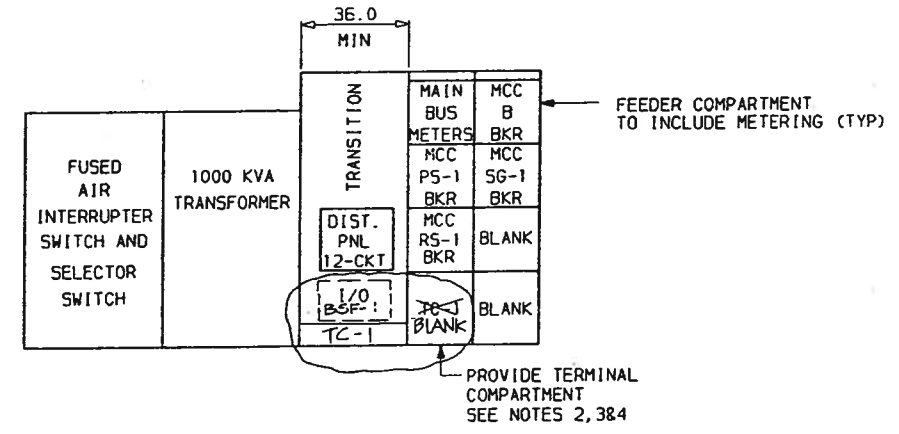

SUBSTATION NO.1 FRONT VIEW  
 SCALE: 3/8"=1'-0"

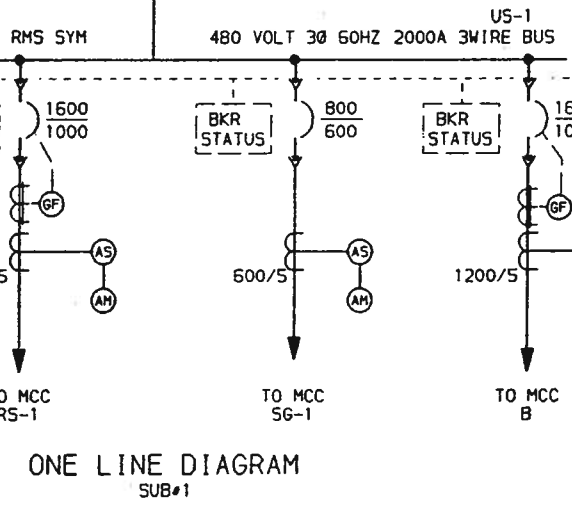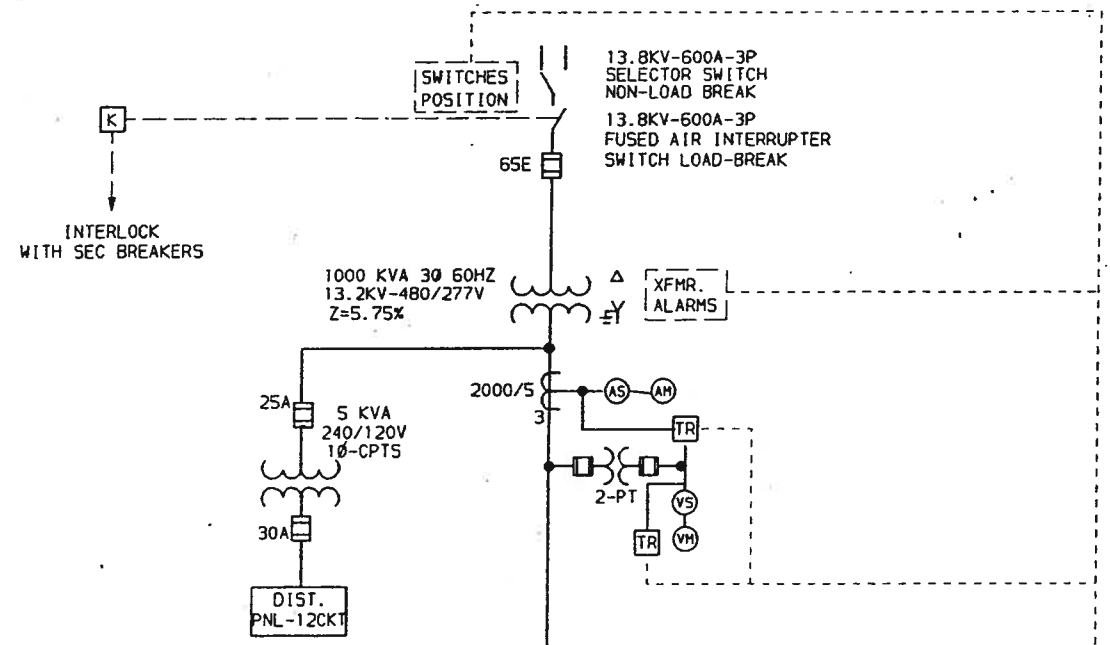


ONE LINE DIAGRAM  
 SUB#1

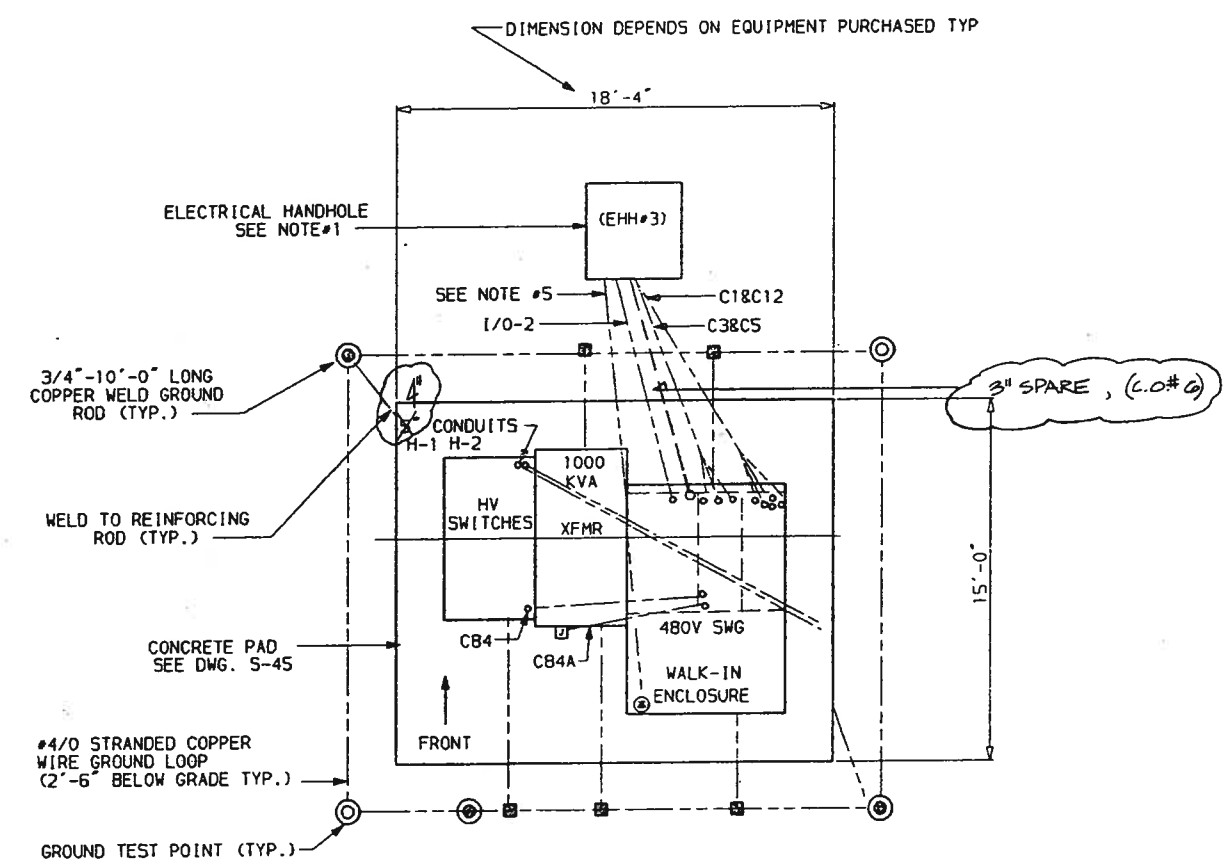


SUBSTATION NO.1 PLAN  
 SCALE: 1/4"=1'-0"

**RECORD DRAWINGS**  
 This drawing reflects changes from the original contract drawing that were made during construction and has been prepared from information provided to the Engineer by the construction contractor(s). The Engineer does not warrant this drawing to be complete and accurate in all respects.  
 MALCOLM PIRNIE, INC.  
 Date 1/88 By MGM


- NOTE:
- FOR ACTUAL LOCATION AND SIZE OF ELECTRICAL HANDHOLE NO. 3 REFER TO DRAWINGS E-14 & E-34.
  - SUBSTATION VENDOR SHALL TERMINATE STATUS WIRING FROM MCC CKT. BREAKERS & TRANSDUCER SIGNALS ON TERMINAL STRIPS OF TERMINAL COMPARTMENT. UTILIZE ONE COMMON SIDE FOR EACH GROUP OF SIGNALS FROM EACH CKT. BREAKER. IDENTIFY ALL WIRING AT TERMINATIONS. PROVIDE 40 TERMINALS IN TC-1.
  - TRANSDUCER SIGNALS SHALL BE ISOLATED FROM REMAINING TERMINALS. PROVIDE 6 ISOLATED TERMINALS IN TC-1.
  - SUBSTATION VENDOR SHALL PROVIDE (1)-1" & (1)-2" INSULATING BUSHINGS BETWEEN TERMINAL COMPARTMENT AND ITS RESPECTIVE TRANSITION COMPARTMENT.
  - PROVIDE 1-1/4" EMPTY CONDUIT FOR CONTRACT#2 INTERCOM INTERCONNECTIONS, CONNECT TO JUNCTION BOX IN EHH#3. REFER TO INTERCOM BLOCK DIAGRAM.
  - CONTRACTOR SHALL ARRANGE TRANSITION COMPARTMENT SUCH THAT I/O PROVIDED UNDER CONTRACT#2 CAN BE INSTALLED UNDER CONTRACT #2 IN COMPARTMENT.

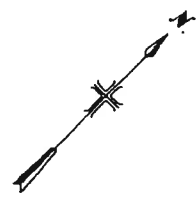



DR 83-6502

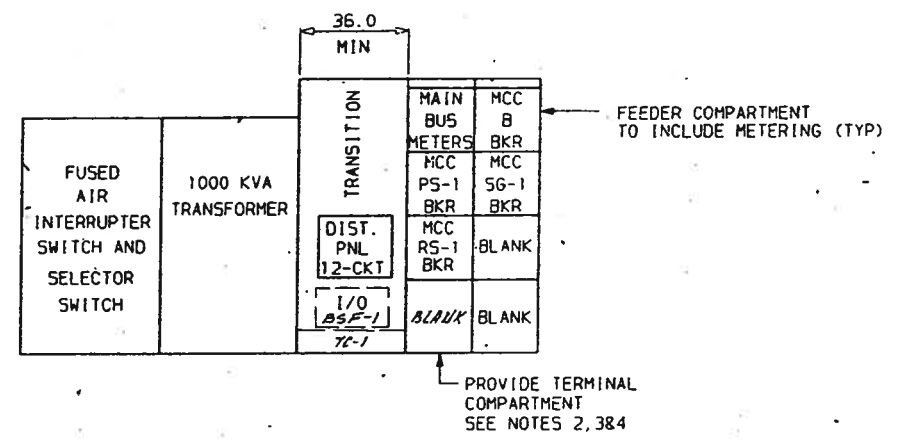

SUBSTATION NO.1 FRONT VIEW  
 SCALE: 3/8"=1'-0"

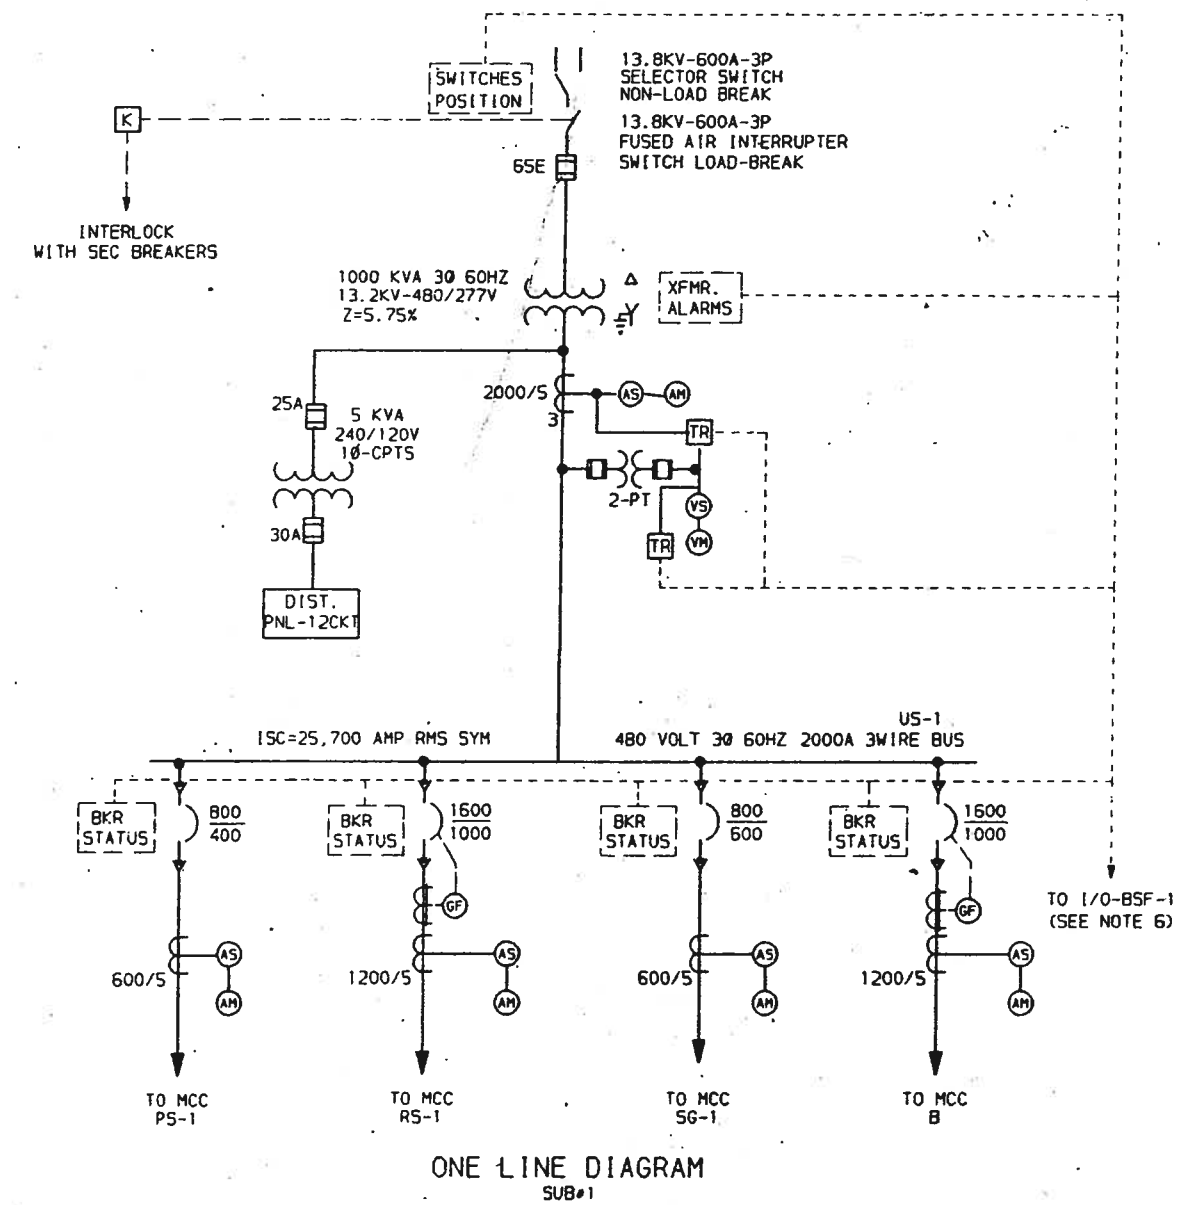

ONE LINE DIAGRAM  
 SUB#1

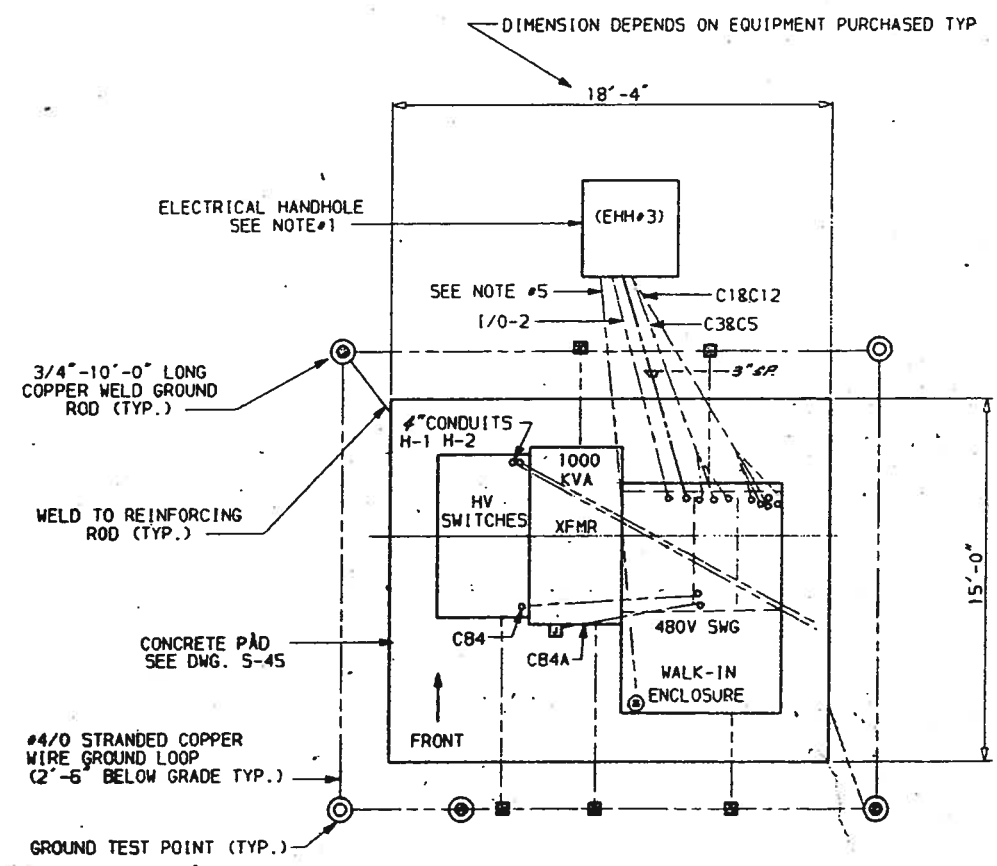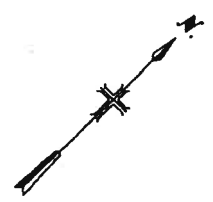

SUBSTATION NO.1 PLAN  
 SCALE: 1/4"=1'-0"


- NOTE:
- 1 FOR ACTUAL LOCATION AND SIZE OF ELECTRICAL HANDHOLE NO.3 REFER TO DRAWINGS E-14 & E-34.
  - 2 SUBSTATION VENDOR SHALL TERMINATE STATUS WIRING FROM MCC CKT. BREAKERS & TRANSDUCER SIGNALS ON TERMINAL STRIPS OF TERMINAL COMPARTMENT. UTILIZE ONE COMMON SIDE FOR EACH GROUP OF SIGNALS FROM EACH CKT. BREAKER. IDENTIFY ALL WIRING AT TERMINATIONS. PROVIDE 40 TERMINALS IN TC-1.
  - 3 TRANSDUCER SIGNALS SHALL BE ISOLATED FROM REMAINING TERMINALS. PROVIDE 6 ISOLATED TERMINALS IN TC-1.
  - 4 SUBSTATION VENDOR SHALL PROVIDE (1)-1" & (1)-2" INSULATING BUSHINGS BETWEEN TERMINAL COMPARTMENT AND ITS RESPECTIVE TRANSITION COMPARTMENT.
  - 5 PROVIDE 1-1/4" EMPTY CONDUIT FOR CONTRACT#2 INTERCOM INTERCONNECTIONS. CONNECT TO JUNCTION BOX IN EHH#3. REFER TO INTERCOM BLOCK DIAGRAM.
  - 6 CONTRACTOR SHALL ARRANGE TRANSITION COMPARTMENT SUCH THAT 1/0 PROVIDED UNDER CONTRACT#2 CAN BE INSTALLED UNDER CONTRACT #2 IN COMPARTMENT.

**PROJECT RECORD**

DR 83-6502

**MALCOLM  
PIRNIE**


No. Date Revisions  
Date: NOV 1983  
Designed by: FS  
Drawn by: FS  
Checked by: [Signature]  
Scale: NO SCALE

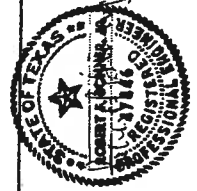


WATERWORKS  
FACILITIES  
IMPROVEMENTS

SAN ANTONIO

CONTRACT NO. 3  
DOS RIOS FACILITY  
GENERAL  
SUBSTATION #2

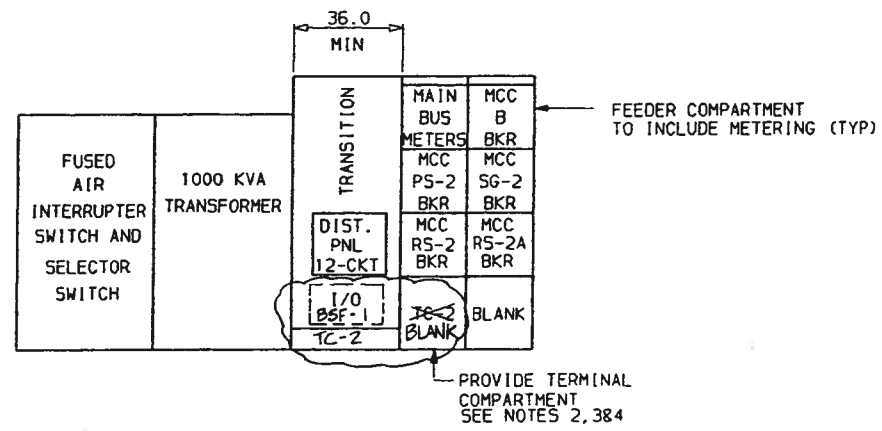



SUBSTATION NO.2 FRONT VIEW  
SCALE: 3/8"=1'-0"

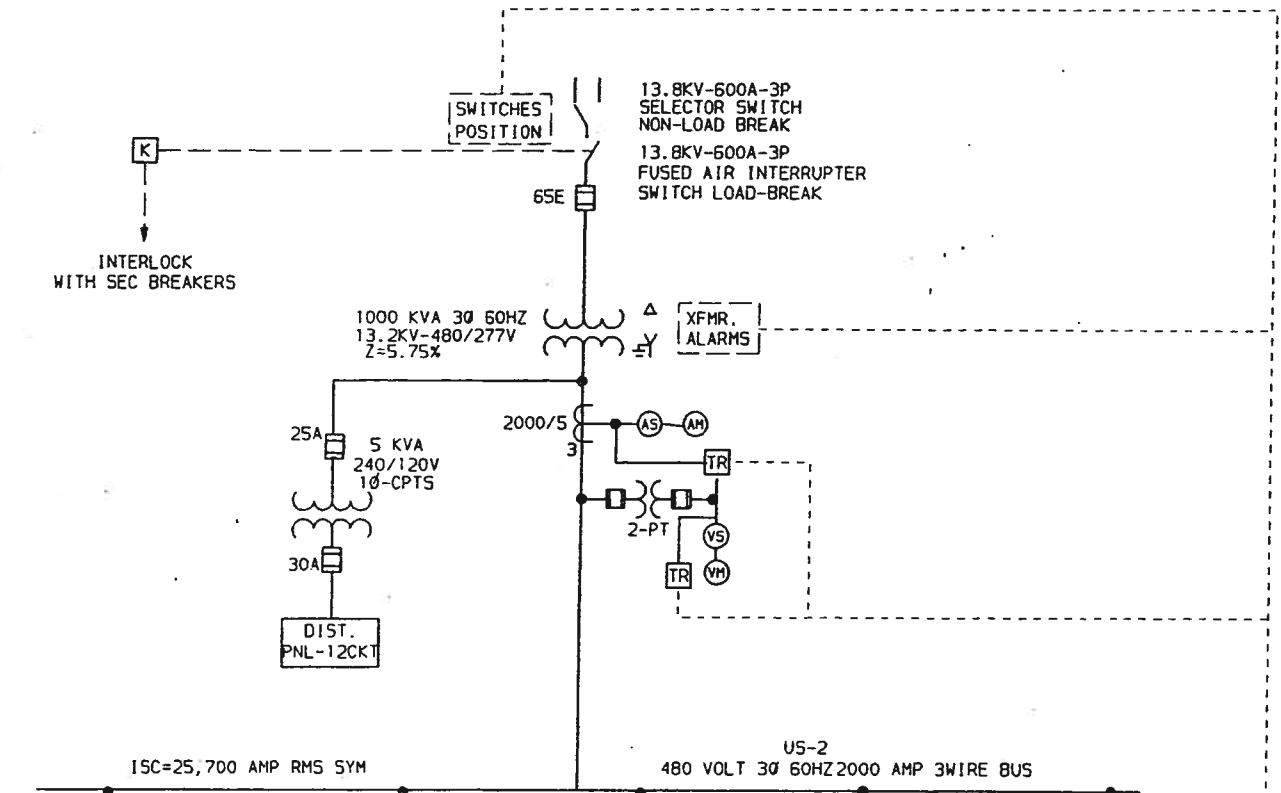

ONE LINE DIAGRAM  
SUB#2

**RECORD DRAWINGS**  
This drawing reflects changes from the original contract drawing that were made during construction and has been prepared from information provided to the Engineer by the construction contractor(s). The Engineer does not warrant this drawing to be complete and accurate in all respects.  
MALCOLM PIRNIE, INC.  
Date 6/84 By H617


- NOTE:
- FOR ACTUAL LOCATION AND SIZE OF ELECTRICAL HANDHOLE NO.1 REFER TO DRAWINGS E-14 & E-34.
  - SUBSTATION VENDOR SHALL TERMINATE STATUS WIRING FROM MCC CKT. BREAKERS & TRANSDUCER SIGNALS ON TERMINAL STRIPS OF TERMINAL COMPARTMENT. UTILIZE ONE COMMON SIDE FOR EACH GROUP OF SIGNALS FROM EACH CKT. BREAKER. IDENTIFY ALL WIRING AT TERMINATIONS. PROVIDE 40 TERMINALS IN TC-2.
  - TRANSDUCER SIGNALS SHALL BE ISOLATED FROM REMAINING TERMINALS. PROVIDE 6 ISOLATED TERMINALS IN TC-2.
  - SUBSTATION VENDOR SHALL PROVIDE (1)-1" & (1)-2" INSULATING BUSHINGS BETWEEN TERMINAL COMPARTMENT AND ITS RESPECTIVE TRANSITION COMPARTMENT.
  - PROVIDE 1" EMPTY CONDUIT FOR CONTRACT#2 1/0 INTERCONNECTIONS, TERMINATE IN EHH#1.
  - CONTRACTOR SHALL ARRANGE TRANSITION COMPARTMENT SUCH THAT 1/0 PROVIDED UNDER CONTRACT#2 CAN BE INSTALLED UNDER CONTRACT #2 IN COMPARTMENT.

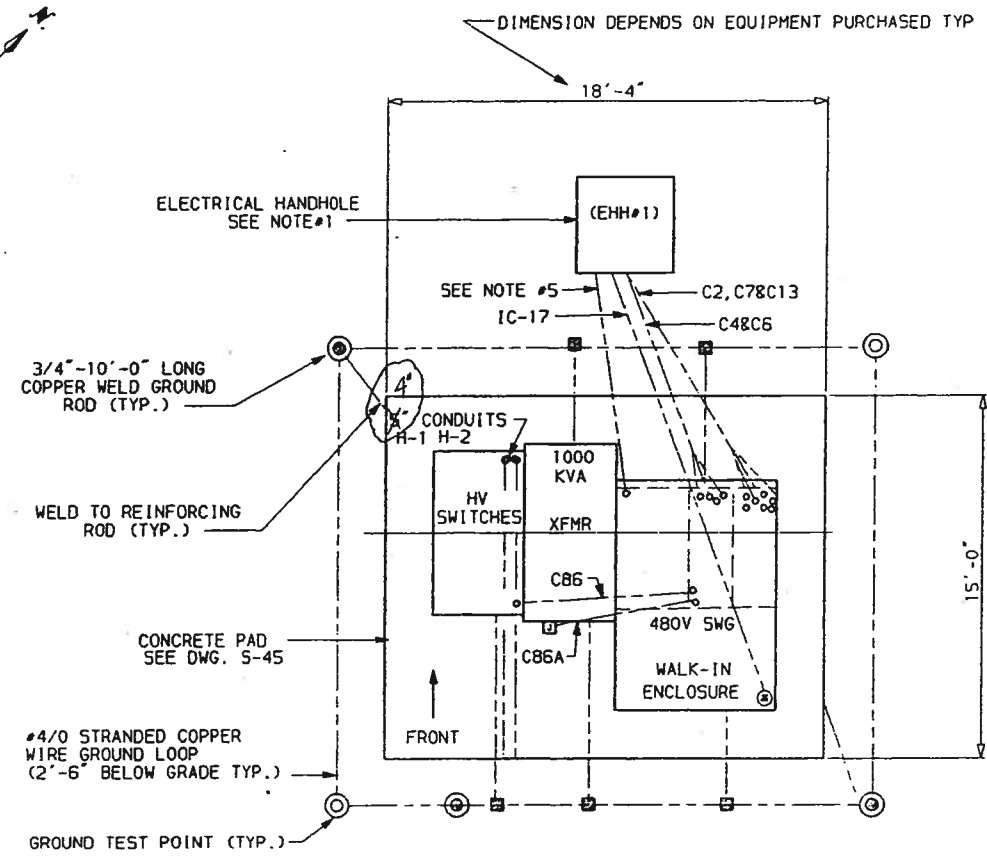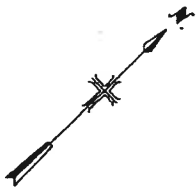


SUBSTATION NO.2 PLAN  
SCALE: 1/4"=1'-0"

DR 83-8502




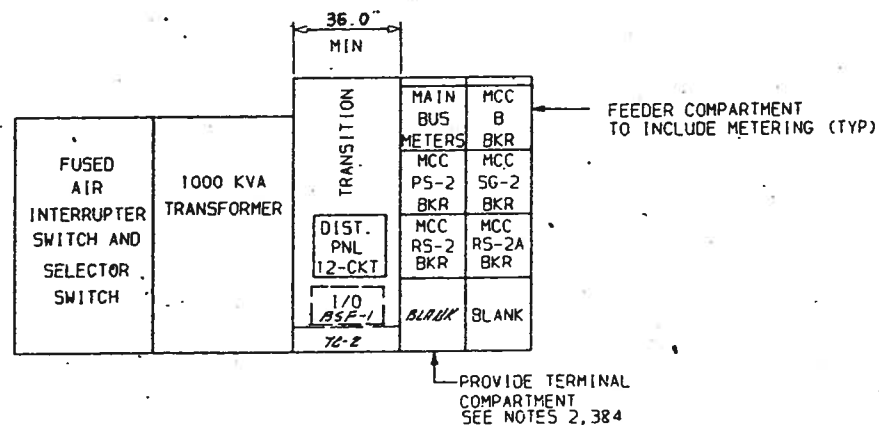

SUBSTATION NO.2 FRONT VIEW  
 SCALE: 3/8"=1'-0"

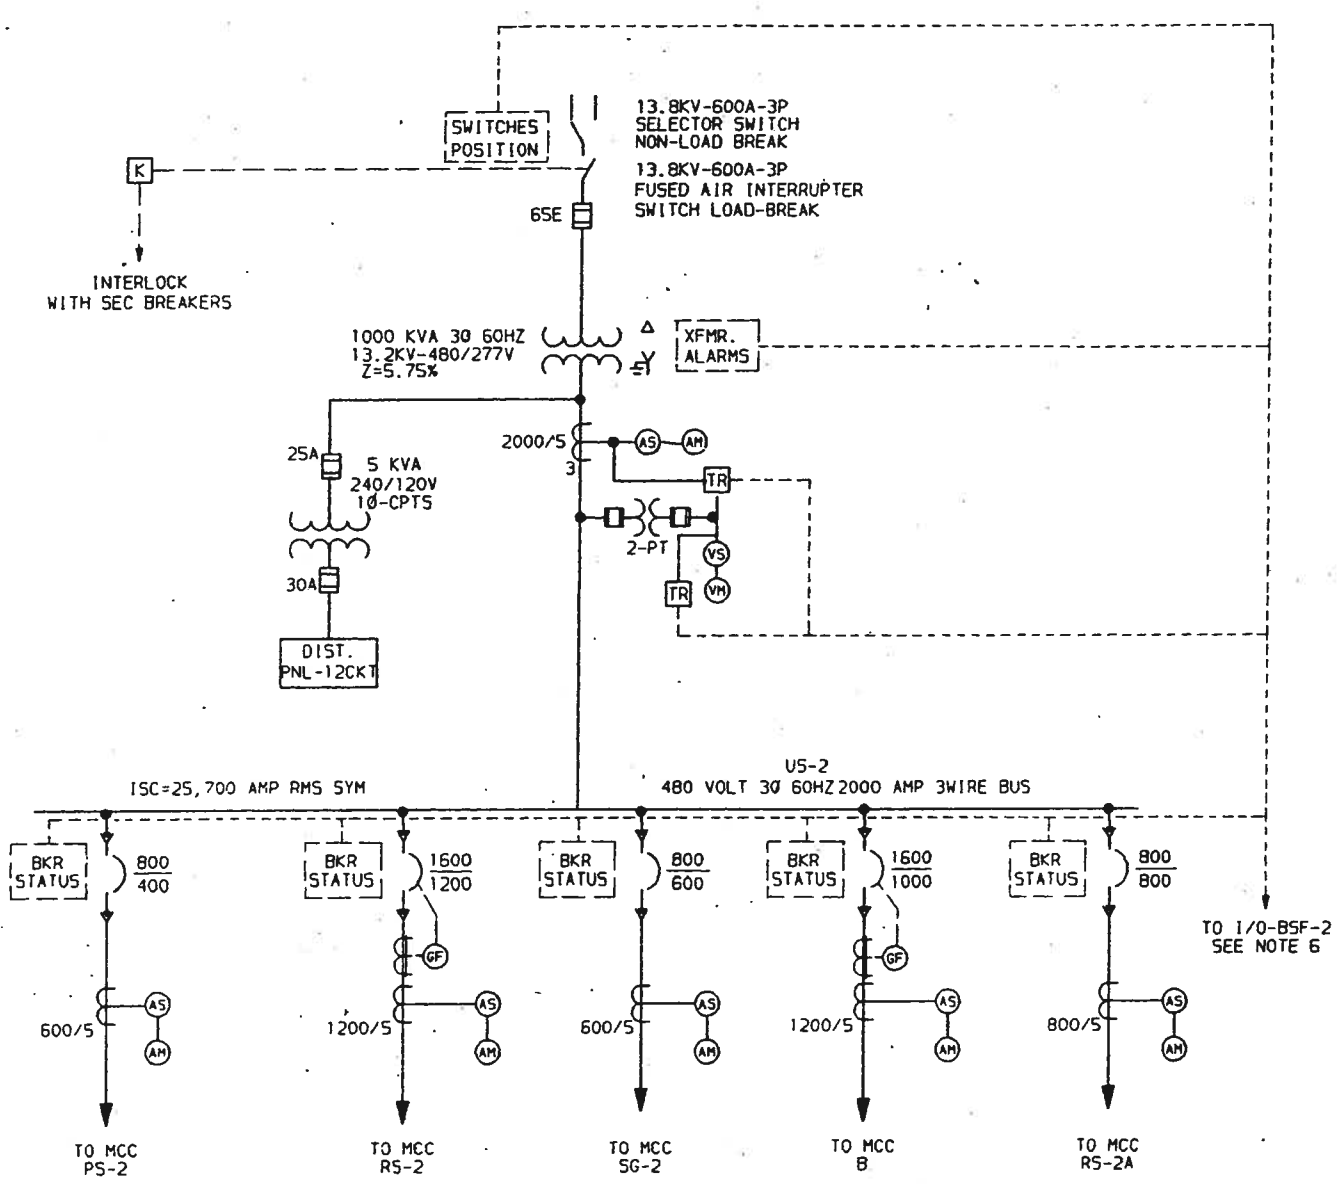

ONE LINE DIAGRAM  
 SUB#2

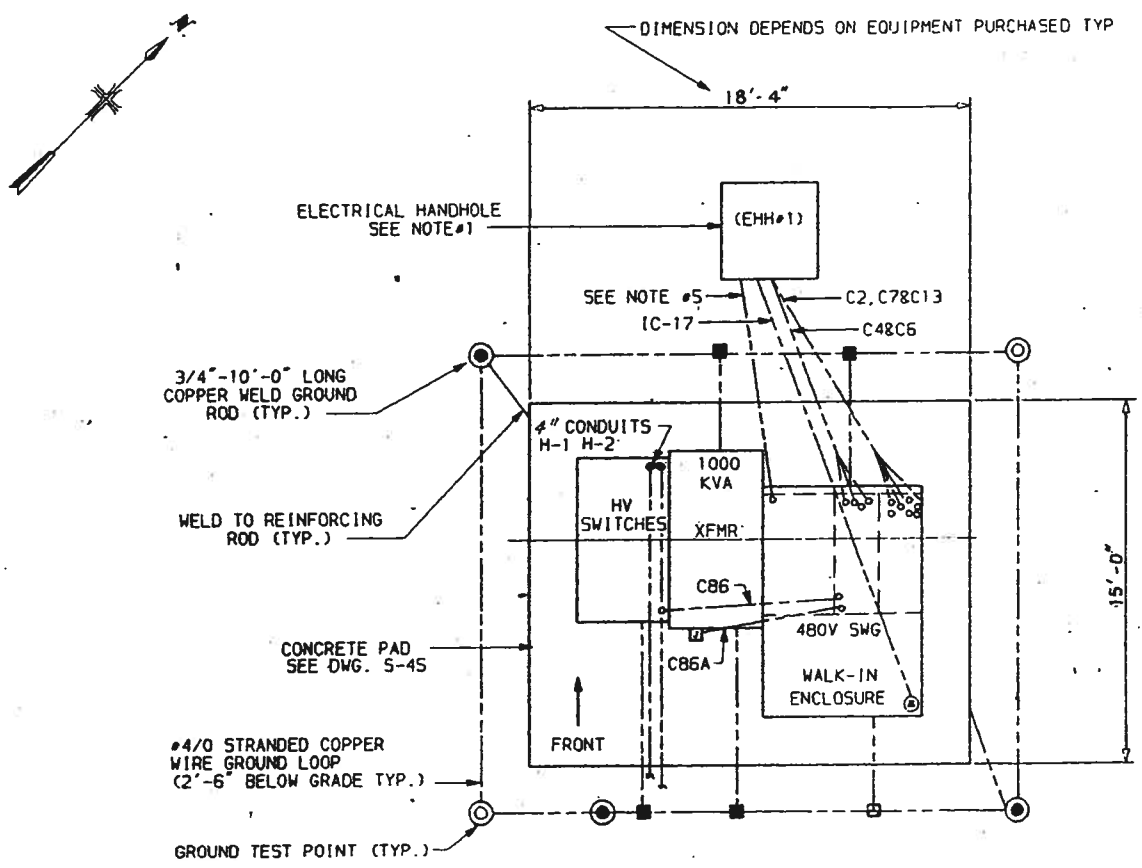

SUBSTATION NO.2 PLAN  
 SCALE: 1/4"=1'-0"


- NOTE:
- 1 FOR ACTUAL LOCATION AND SIZE OF ELECTRICAL HANDHOLE NO.1 REFER TO DRAWINGS E-14 & E-34.
  - 2 SUBSTATION VENDOR SHALL TERMINATE STATUS WIRING FROM MCC CKT. BREAKERS & TRANSDUCER SIGNALS ON TERMINAL STRIPS OF TERMINAL COMPARTMENT. UTILIZE ONE COMMON SIDE FOR EACH GROUP OF SIGNALS FROM EACH CKT. BREAKER. IDENTIFY ALL WIRING AT TERMINATIONS. PROVIDE 40 TERMINALS IN TC-2.
  - 3 TRANSDUCER SIGNALS SHALL BE ISOLATED FROM REMAINING TERMINALS. PROVIDE 6 ISOLATED TERMINALS IN TC-2.
  - 4 SUBSTATION VENDOR SHALL PROVIDE (1)-1" & (1)-2" INSULATING BUSHINGS BETWEEN TERMINAL COMPARTMENT AND ITS RESPECTIVE TRANSITION COMPARTMENT.
  - 5 PROVIDE 1" EMPTY CONDUIT FOR CONTRACT#2 I/O INTERCONNECTIONS, TERMINATE IN EHH#1.
  - 6 CONTRACTOR SHALL ARRANGE TRANSITION COMPARTMENT SUCH THAT I/O PROVIDED UNDER CONTRACT#2 CAN BE INSTALLED UNDER CONTRACT #2 IN COMPARTMENT.

**PROJECT RECORD**

WARRANTED  
 FINISHES  
 IMPROVEMENTS

CONTRACT NO. 3  
 DOS RIOS FACILITY  
 GENERAL  
 SUBSTATION #2

DR 83-6502

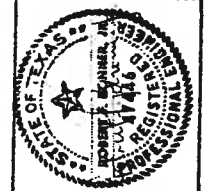


Waste Water Facilities Improvements

San Antonio


CONTRACT NO. 3  
 DOS RIOS FACILITY  
 GENERAL  
 SUBSTATION #11 & #12

**RECORD DRAWINGS**  
 This drawing reflects changes from the original contract drawing that were made during construction and has been prepared from information provided to the Engineer by the construction contractor(s). The Engineer does not warrant this drawing to be complete and accurate in all respects.  
 MALCOLM PIRNIE, INC.  
 Date: 6/85 By: RGM

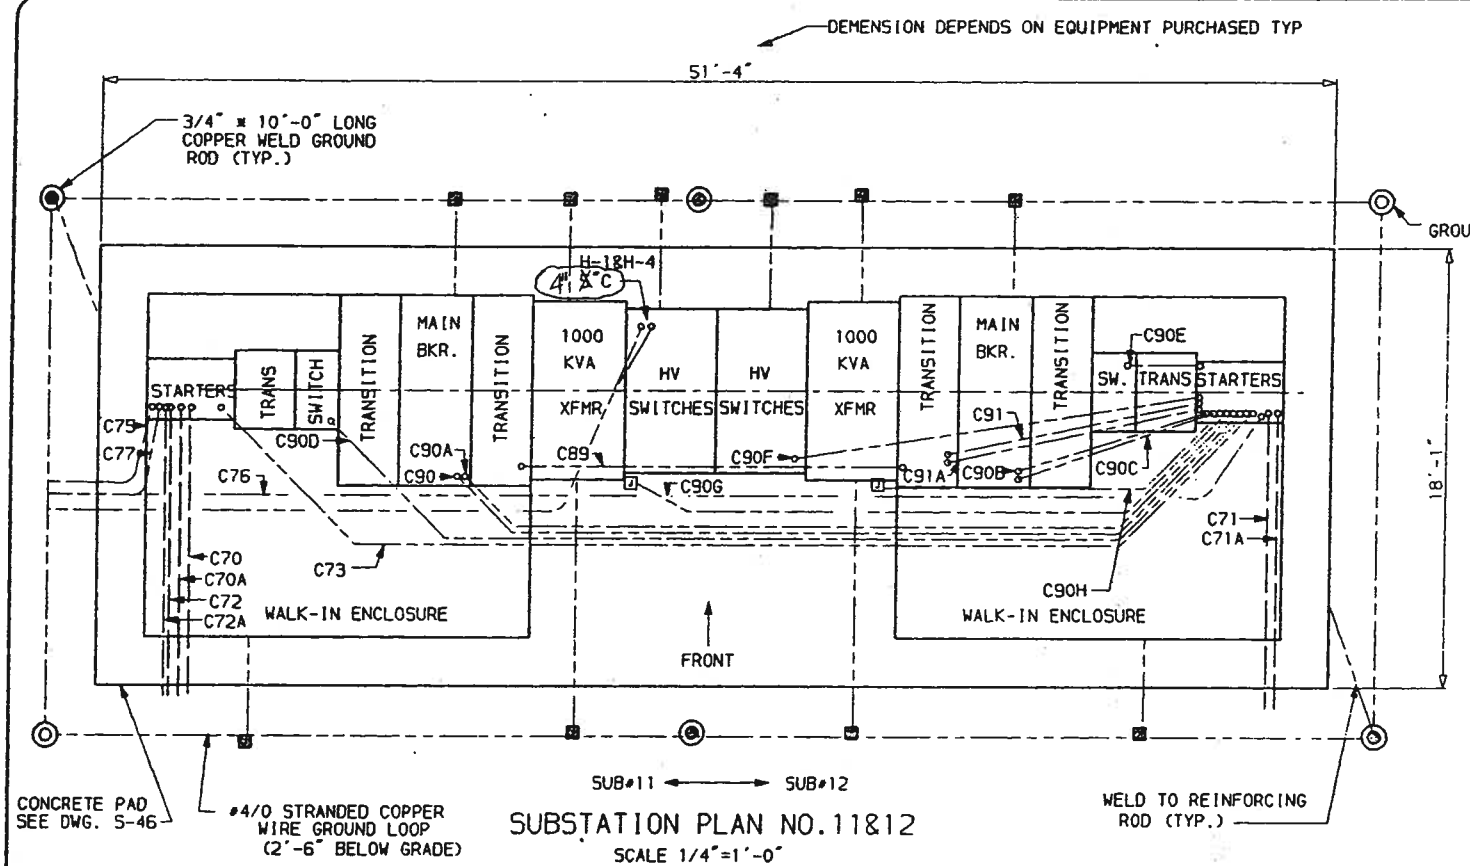

**SUBSTATION PLAN NO. 11&12**  
 SCALE 1/4"=1'-0"


NOTE: FOR CONTINUATION OF CONDUITS REFER TO DRAWING E21(TYP.).

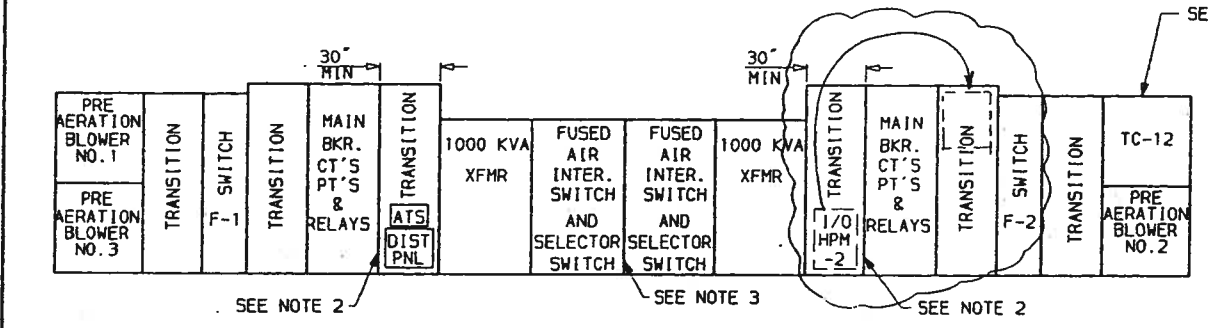

**SUBSTATION FRONT NO. 11&12**  
 SCALE 1/4"=1'-0"

- NOTES:
- 1 PROVIDE TERMINAL COMPARTMENT WITH 80 TERMINALS INCLUDING 10 ISOLATED TERMINALS FOR TRANSDUCER SIGNALS.
  - 2 SUBSTATION VENDOR SHALL PROVIDE (1)-1" INSULATING BUSHING BETWEEN MAIN CKT BREAKER COMPARTMENT AND TRANSITION COMPARTMENT.
  - 3 SUBSTATION VENDOR SHALL PROVIDE THRU-WALL BARRIER BETWEEN PRIMARY SWITCH COMPARTMENTS FOR HIGH VOLTAGE CABLE CONNECTIONS BETWEEN SWITCHES. REFER TO DWG. E2 FOR CABLE REQUIREMENTS. PROVIDE 1" INSULATING BUSHING BETWEEN SWITCH COMPARTMENTS FOR STATUS WIRING.
  - 4 CONTRACTOR SHALL ARRANGE TRANSITION COMPARTMENT SUCH THAT 1/0 PROVIDED UNDER CONTRACT #2 CAN BE INSTALLED UNDER CONTRACT #2 IN COMPARTMENT.

REFER TO DRAWINGS E-10XA AND E-11X FOR "AS-BUILT" CONDITION AND SKETCHES

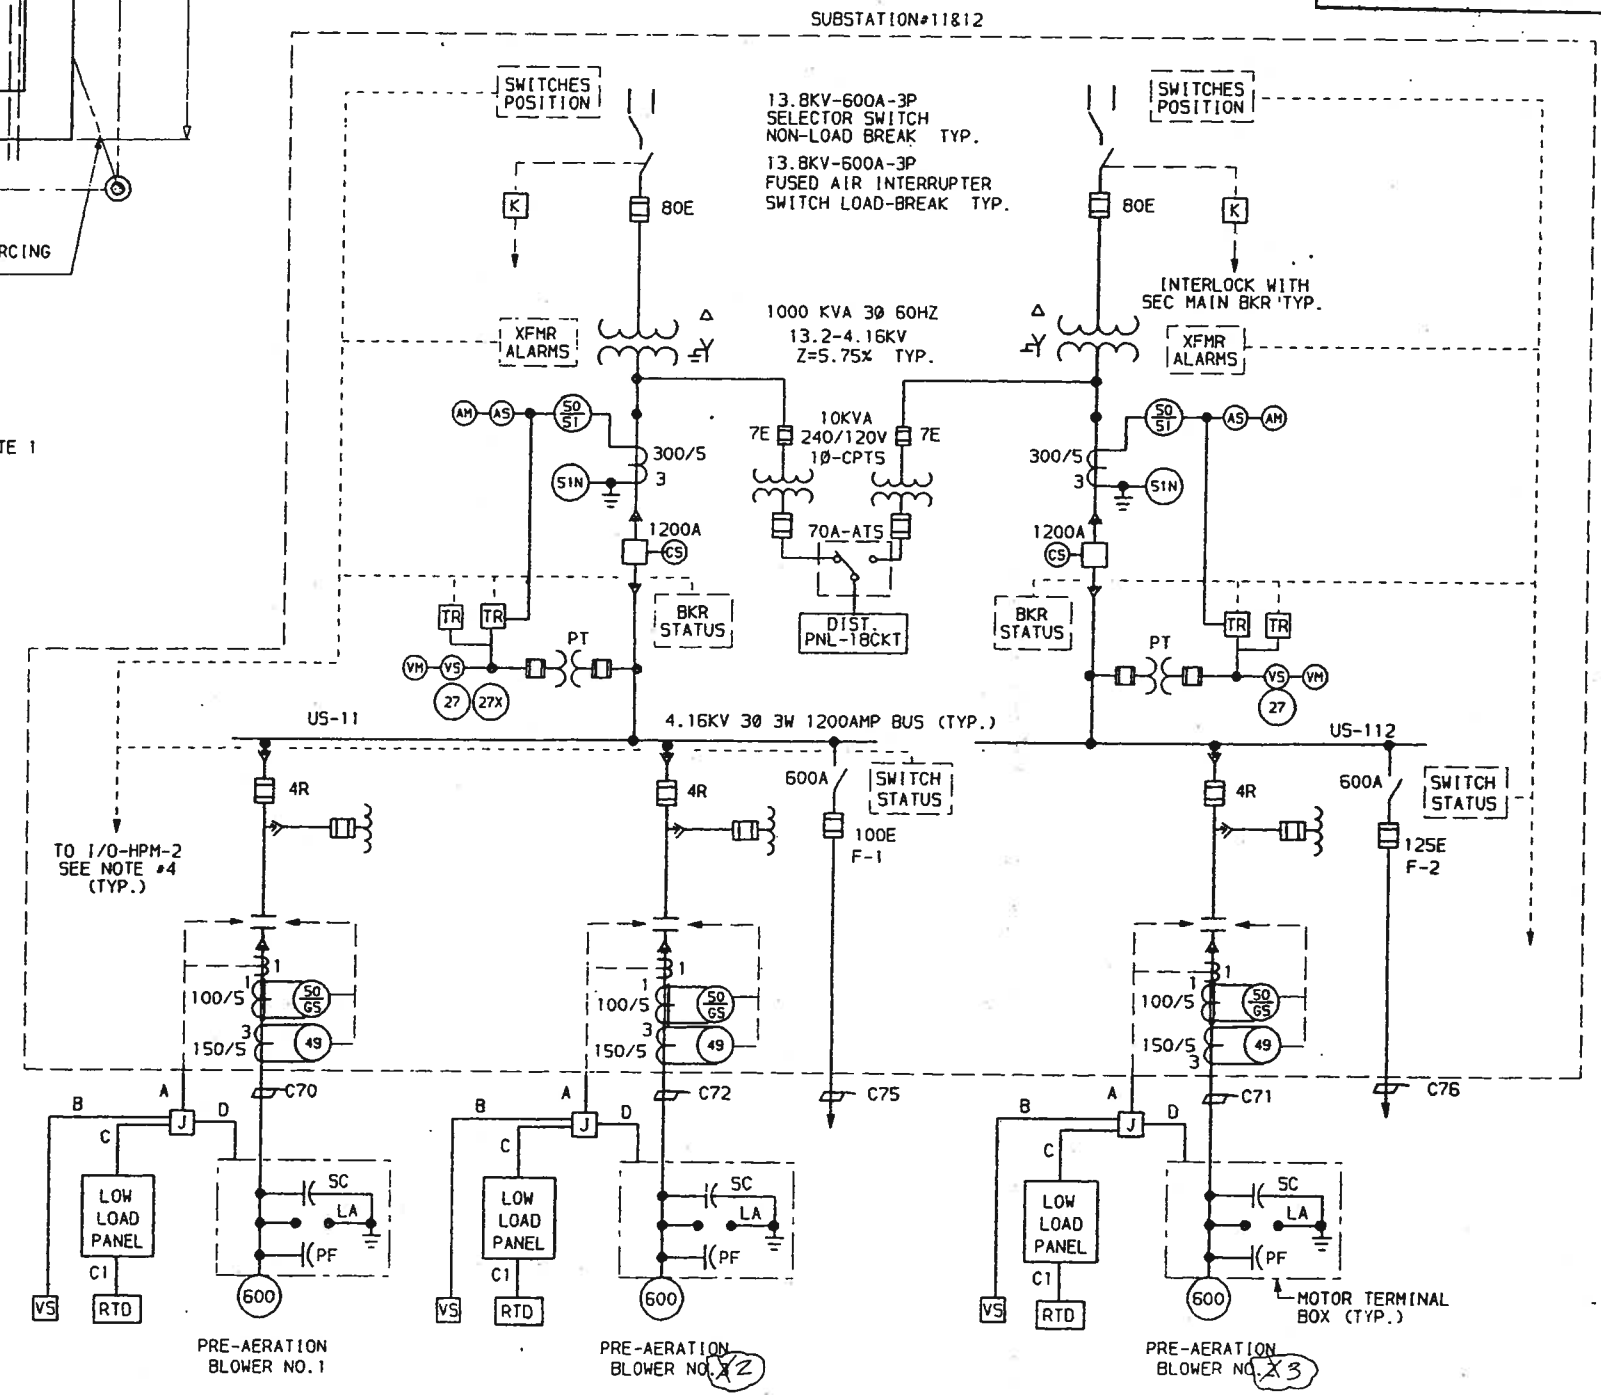


**ONE LINE DIAGRAM**

DR 83-6502

MALCOLM PIRNIE

NO SCALE

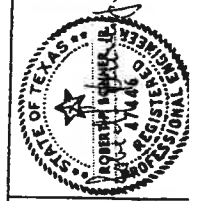

WARRANTOR FOR IMPROVEMENTS

San Antonio

CONTRACT NO. 3 DOS RIOS FACILITY GENERAL & CABLE SCHEDULE

CONDUIT		CABLE		FROM	VIA	TO	PURPOSE	REMARKS	CONDUIT		CABLE		FROM	VIA	TO	PURPOSE	REMARKS
NO.	SIZE IN.	QTY.	SIZE						NO.	SIZE IN.	QTY.	SIZE					
C1	(2)-3	6	350MCM	SUBSTATION #1		MCC-SG-1	POWER	PARALLEL FEED									
C2	(2)-3	6	350MCM	SUBSTATION #1		MCC-SG-1	GND	PARALLEL FEED									
C3	(2)-3	6	350MCM	SUBSTATION #2		MCC-SG-2	POWER										
C3A	(2)-3	6	350MCM	SUBSTATION #2		MCC-SG-2	GND										
C4	(2)-3	6	350MCM	SUBSTATION #1		MCC-PS-1	POWER										
C4A	(2)-3	6	350MCM	SUBSTATION #1		MCC-PS-1	GND										
C5	(2)-3	6	350MCM	SUBSTATION #2		MCC-PS-2	POWER										
C6	(2)-3	6	350MCM	SUBSTATION #2		MCC-PS-2	GND										
C7	(2)-3	6	350MCM	SUBSTATION #2		MCC-RS-2	POWER										
C12	(2)-3	6	350MCM	SUBSTATION #2		MCC-RS-2	GND										
C13	(2)-3	6	350MCM	SUBSTATION #1		MCC-B	POWER										
C14	(2)-3	6	350MCM	SUBSTATION #1		MCC-B	GND										
C15	(2)-3	6	350MCM	SUBSTATION #2		MCC-B	POWER										
C16	(2)-3	6	350MCM	SUBSTATION #2		MCC-B	GND										
C17	(2)-3	6	350MCM	SUBSTATION #5		MCC-PD-1	POWER										
C18	(2)-3	6	350MCM	SUBSTATION #5		MCC-PD-1	GND										
C19	(2)-3	6	350MCM	SUBSTATION #6		MCC-PD-2	POWER										
C32	(2)-3	6	350MCM	SUBSTATION #6		MCC-PD-2	GND										
C33	(2)-3	6	350MCM	SUBSTATION #5		MCC-PD-3	POWER										
C34	(2)-3	6	350MCM	SUBSTATION #5		MCC-PD-3	GND										
C35	(2)-3	6	350MCM	SUBSTATION #6		MCC-PD-4	POWER										
C36	(2)-3	6	350MCM	SUBSTATION #6		MCC-PD-4	GND										
C37	(2)-3	6	350MCM	SUBSTATION #5		MCC-FT-1	POWER										
C38	(2)-3	6	350MCM	SUBSTATION #5		MCC-FT-1	GND										
C39	(2)-3	6	350MCM	SUBSTATION #6		MCC-FT-2	POWER										
C54B	(2)-3	6	350MCM	SUBSTATION #1	[ATS]	MCC-PS-2	POWER										
C55	(2)-3	6	350MCM	SUBSTATION #1	[ATS]	MCC-PS-2	GND										
C56	(2)-3	6	350MCM	SUBSTATION #1	[ATS]	MCC-PS-2	POWER										

**RECORD DRAWINGS**  
 This drawing reflects changes from the original contract drawing that were made during construction and has been prepared from information provided to the Engineer by the construction contractor(s). The Engineer does not warrant this drawing to be complete and accurate in all respects.  
 MALCOLM PIRNIE, INC.

Date 6/88 By MGM

DR 83-6502

**MALCOLM PIRNIE**

**CURTIS NEAL & ASSOCIATES, INC.**  
CONSULTING ENGINEERS  
1157 E. COMMERCE  
SAN ANTONIO, TEXAS 78205




**WASTE WATER FACILITIES IMPROVEMENTS**

**SAN ANTONIO**

**DOS RIOS FACILITY**  
GENERAL  
MANHOLE, HANDHOLE AND UNDERGROUND  
DUCT INSTALLATION DETAILS

CONTRACT NO. 3





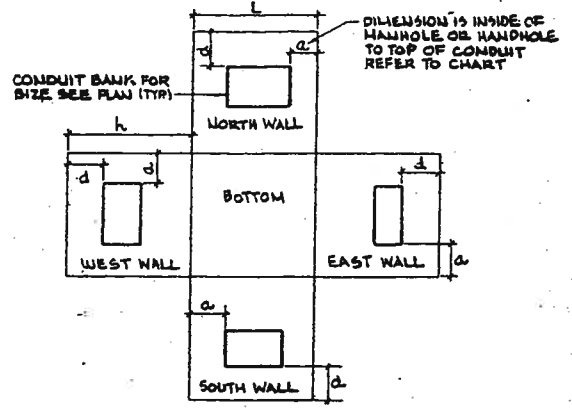


**MANHOLE OR HANDHOLE EXPLODED VIEW**  
NO SCALE

NOTE: ALL DIMENSIONS SHOWN IN MANHOLE AND HANDHOLE CHARTS ARE APPROXIMATE, ACTUAL DIMENSIONS TO BE FIELD DETERMINED.

MANHOLE No.	NORTH WALL		SOUTH WALL		EAST WALL		WEST WALL		WALLS	
	d	a	d	a	d	a	d	a	h	L
1	—	—	2'-9"	3'-0"	0'-3"	3'-0"	—	—	7'-6"	8'-0"
2	—	—	—	—	2'-3"	3'-0"	0'-3"	3'-0"	7'-6"	8'-0"
3	1'-3"	3'-0"	—	—	0'-3"	3'-0"	0'-3"	3'-0"	7'-6"	8'-0"
4	0'-3"	3'-0"	2'-0"	3'-0"	—	—	—	—	7'-6"	8'-0"
5	1'-0"	3'-0"	—	—	—	—	—	—	7'-6"	8'-0"
14	—	—	1'-0"	3'-0"	2'-0"	3'-0"	—	—	7'-6"	8'-0"
15	0'-9"	3'-5"	2'-9"	3'-0"	—	—	0'-9"	3'-0"	7'-6"	8'-0"
16	4'-9"	3'-5"	1'-0"	3'-5"	—	—	—	—	7'-6"	8'-0"
17	1'-3"	3'-5"	2'-3"	3'-5"	—	—	—	—	7'-6"	8'-0"
18	1'-9"	3'-5"	1'-9"	3'-5"	1'-3"	3'-5"	—	—	7'-6"	8'-0"
A	—	—	—	—	2'-3"	3'-5"	1'-3"	3'-5"	7'-6"	8'-0"
20	2'-3"	3'-5"	—	—	—	—	2'-3"	3'-5"	7'-6"	8'-0"


HANDHOLE NO.	NORTH WALL		SOUTH WALL		EAST WALL		WEST WALL		WALLS	
	d	a	d	a	d	a	d	a	h	L
1	4'-0"	1'-0"	1'-3"	1'-2"	1'-3"	1'-2"	—	—	4'-0"	6'-0"
2	8'-3"	2'-2"	2'-3"	1'-9"	7'-3"	2'-3"	8'-3"	2'-8"	10'-0"	8'-0"
3	0'-9"	1'-9"	0'-9"	2'-0"	0'-9"	1'-9"	—	—	4'-0"	6'-0"
4	0'-3"	2'-0"	—	—	—	—	0'-3"	2'-9"	4'-0"	6'-0"
5	1'-9"	1'-5"	3'-9"	2'-0"	1'-9"	1'-10"	1'-9"	1'-5"	4'-0"	4'-0"
6	1'-9"	1'-2"	1'-0"	1'-6"	2'-9"	1'-5"	—	—	4'-0"	4'-0"
7	0'-9"	0'-10"	2'-9"	1'-5"	—	—	0'-9"	1'-2"	4'-0"	5'-0"
8	2'-6"	0'-7"	2'-6"	0'-10"	2'-6"	0'-10"	—	—	4'-0"	5'-0"
9	1'-3"	1'-1"	1'-3"	1'-3"	1'-3"	0'-9"	1'-3"	0'-7"	4'-0"	4'-0"
10	*	*	0'-9"	0'-7"	—	—	—	—	4'-0"	4'-0"
11	2'-3"	3'-0"	*	*	1'-3"	2'-6"	0'-9"	2'-2"	7'-6"	8'-0"
20	0'-9"	0'-9"	2'-4"	1'-8"	—	—	1'-3"	1'-0"	4'-0"	4'-0"
21	0'-9"	0'-6"	—	—	0'-9"	0'-6"	—	—	4'-0"	5'-0"
HG-1	0'-9"	1'-0"	1'-9"	2'-9"	0'-9"	1'-6"	0'-9"	1'-7"	4'-0"	4'-0"
HG-2	0'-9"	1'-6"	—	—	1'-0"	1'-6"	—	—	4'-0"	4'-0"
HG-3	0'-9"	1'-6"	1'-6"	0'-10"	0'-9"	0'-6"	—	—	4'-0"	4'-0"
HG-4	—	—	0'-9"	1'-6"	0'-9"	1'-6"	—	—	4'-0"	4'-0"
HG-5	—	—	0'-9"	1'-6"	3'-6"	1'-6"	—	—	4'-0"	4'-0"
PT-1	1'-9"	1'-6"	1'-9"	1'-6"	—	—	—	—	4'-0"	4'-0"
PT-2	1'-9"	1'-6"	1'-9"	1'-6"	—	—	—	—	4'-0"	4'-0"
PD-1	*	*	—	—	0'-9"	3'-9"	0'-9"	2'-1"	7'-6"	6'-0"
PD-2	1'-9"	1'-0"	1'-9"	0'-8"	0'-3"	3'-1"	0'-3"	1'-8"	7'-6"	6'-0"
PD-3	1'-9"	2'-6"	1'-9"	2'-6"	0'-3"	2'-5"	1'-3"	3'-6"	7'-6"	6'-0"
PD-4	—	—	0'-3"	2'-0"	0'-3"	0'-8"	2'-5"	0'-8"	4'-0"	4'-0"
PD-5	2'-0"	1'-9"	0'-3"	1'-4"	—	—	—	—	4'-0"	4'-0"
PD-6	0'-3"	1'-9"	0'-3"	2'-0"	0'-3"	2'-0"	—	—	4'-0"	4'-0"
SB-1	5'-5"	1'-9"	—	—	0'-9"	1'-9"	—	—	6'-0"	4'-0"
SB-2	0'-9"	2'-0"	1'-0"	1'-9"	—	—	0'-9"	1'-9"	4'-0"	4'-0"
SB-3	—	—	0'-9"	2'-0"	0'-9"	2'-0"	—	—	4'-0"	4'-0"
SB-4	0'-9"	2'-0"	1'-3"	2'-0"	0'-9"	1'-6"	0'-9"	2'-0"	4'-0"	4'-0"
SB-5	0'-9"	2'-0"	0'-9"	2'-0"	—	—	—	—	4'-0"	4'-0"
SB-6	1'-0"	1'-4"	—	—	0'-9"	1'-4"	1'-9"	1'-6"	4'-0"	4'-0"
SB-7	0'-9"	2'-0"	1'-9"	2'-0"	1'-9"	1'-2"	1'-9"	1'-4"	4'-0"	4'-0"
SB-8	0'-9"	2'-0"	0'-9"	2'-0"	—	—	—	—	4'-0"	4'-0"
SB-9	1'-9"	2'-0"	—	—	1'-9"	1'-7"	1'-9"	1'-9"	4'-0"	4'-0"
SB-10	0'-9"	2'-0"	0'-9"	2'-0"	—	—	—	—	4'-0"	4'-0"
SB-11	—	—	—	—	1'-9"	1'-7"	0'-9"	1'-7"	4'-0"	4'-0"
SB-12	1'-9"	2'-0"	1'-9"	2'-0"	—	—	1'-9"	1'-7"	4'-0"	4'-0"
SB-13	0'-9"	2'-0"	0'-9"	2'-0"	—	—	—	—	4'-0"	4'-0"
HG-6	0'-9"	1'-0"	0'-9"	1'-0"	—	—	—	—	4'-0"	4'-0"

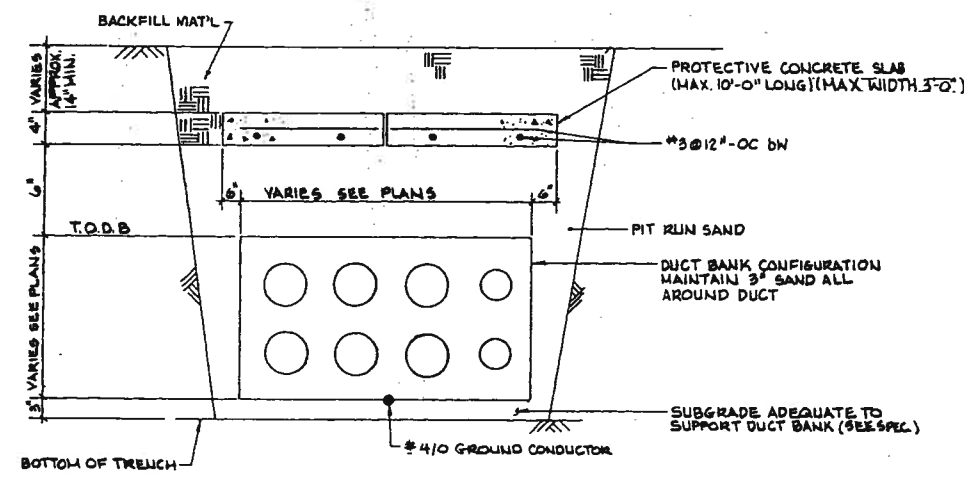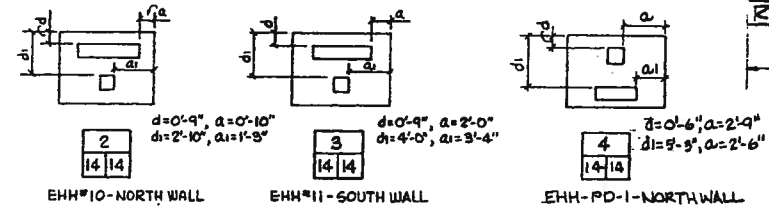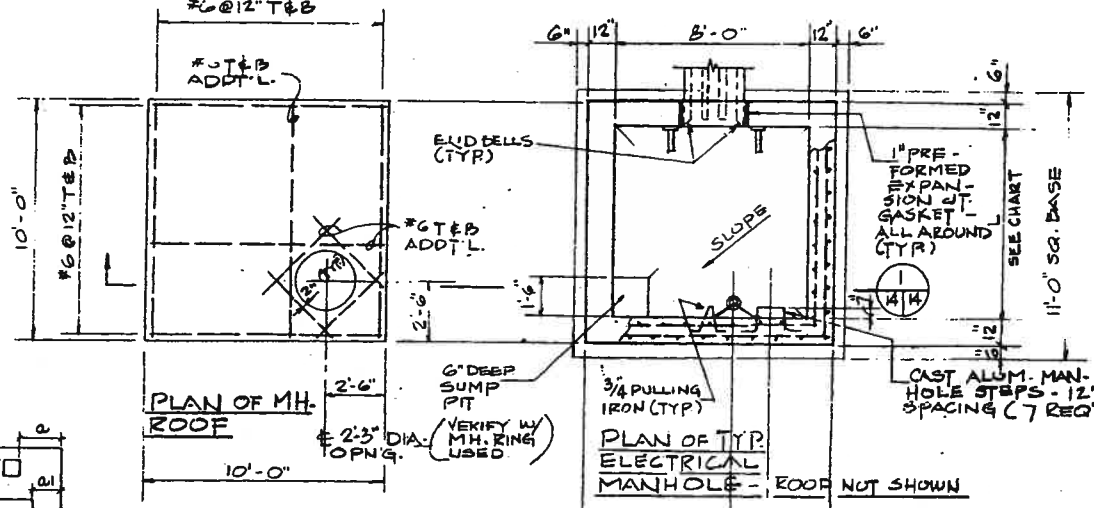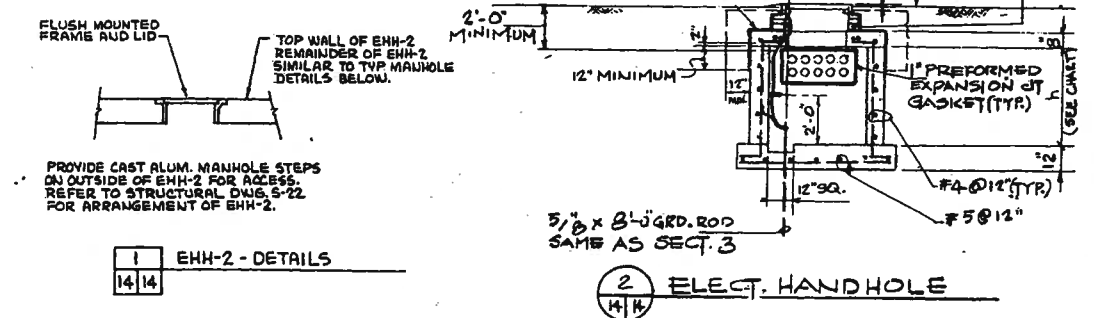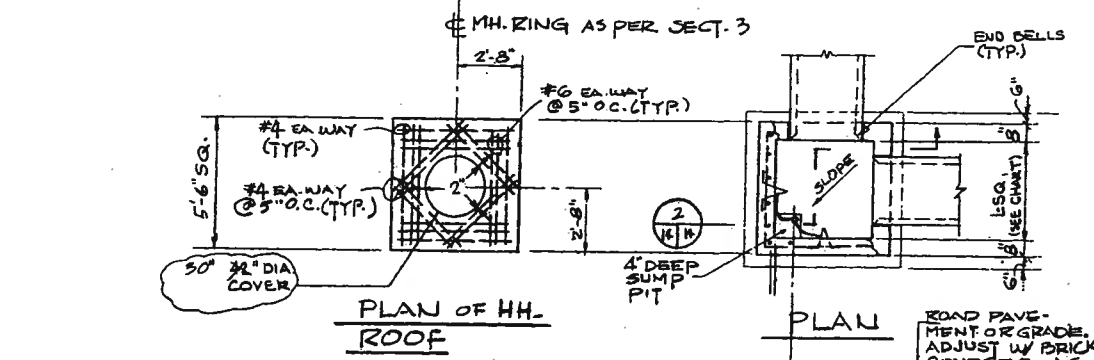

**TYPICAL DETAIL OF UNDERGROUND DUCT INSTALLATION**

NOT TO SCALE

**RECORD DRAWINGS**  
This drawing reflects changes from the original contract drawing that were made during construction and has been prepared from information provided to the Engineer by the construction contractor(s). The Engineer does not warrant this drawing to be complete and accurate in all respects.  
MALCOLM PIRNIE, INC.  
Date 1/88 By MPM

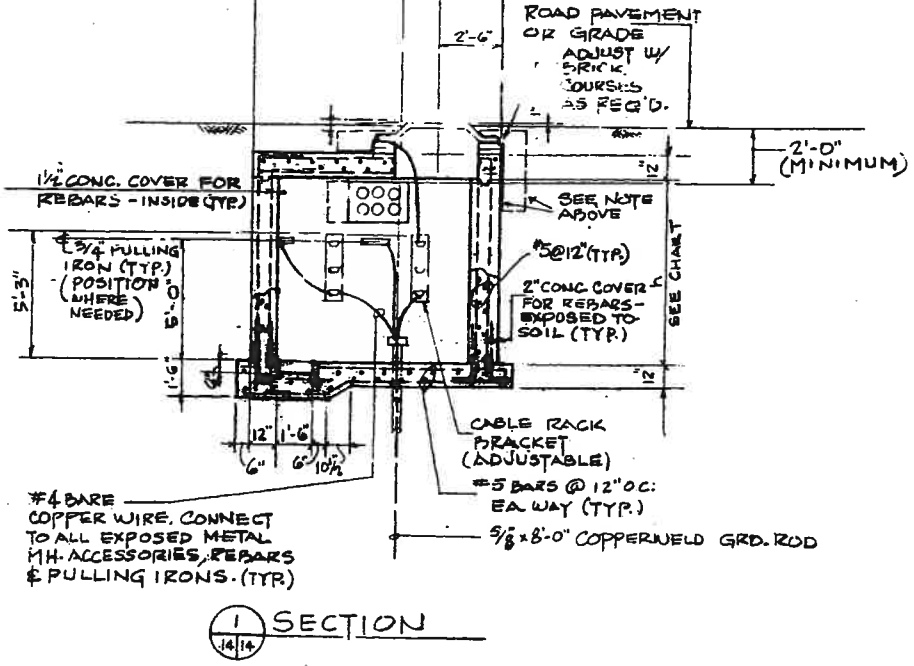


**SECTION**

DR 83-6502




GENERAL NOTES

1. ALL INTERCONNECTION LINES BETWEEN EQUIPMENT REPRESENT CONDUIT ROUTING. FOR CONDUITS TAGGED IC-NUMBER-SIZE REFER TO PLAN DRAWINGS FOR ROUTING. ALL CONDUITS FOR INTERCOM SYSTEM NOT TAGGED IC-NUMBER-SIZE ARE LOCAL CONDUIT REQUIREMENTS OF 3/4" IN SIZE UNLESS NOTED OTHERWISE.
2. ALL INTERCOM EQUIPMENT SHOWN IN PLAN DRAWINGS ARE FOR LOCATIONS ONLY. EQUIPMENT AND CABLES TO BE PROVIDED UNDER CONTRACT NO.2.
3. PROVIDE FLEXIBLE CONDUIT AND JUNCTION BOX IN ALL ELECTRICAL HANDHOLES FOR THE INTERCOM CONDUIT SYSTEM, SO CABLES WILL BE ISOLATED FROM THE POWER CONDUCTORS.
4. IN ORDER TO ISOLATE PSM&I/O CABLES FROM POWER CONDUCTORS THE FOLLOWING CONDUITS SHALL BE RUN CONTINUOUS THROUGH EACH ELECTRICAL HANDHOLE IDENTIFIED. PROVIDE FLEXIBLE CONDUIT AND JUNCTION BOX WITHIN HANDHOLES.  
CABLES FURNISHED AND INSTALLED UNDER CONTRACT#2.  
A. C240 - EHH#8, [PROVIDE &CONNECT CONDUITS 240, 240A AND 240C IN EHH#9]  
B. C378D - EHH#21  
C. C143 - EHH#7, EHH#6  
D. C146B & C146C - EHH#8, EHH#7, EHH#6, EHH#5 [CAP IN EHH#4]  
E. C146 & C146A - EHH#20, EHH#10  
F. I/O-2 - EHH#3  
G. EHH-SB7, SB6, SB4, SB1, SB1&EHH-PD-6.

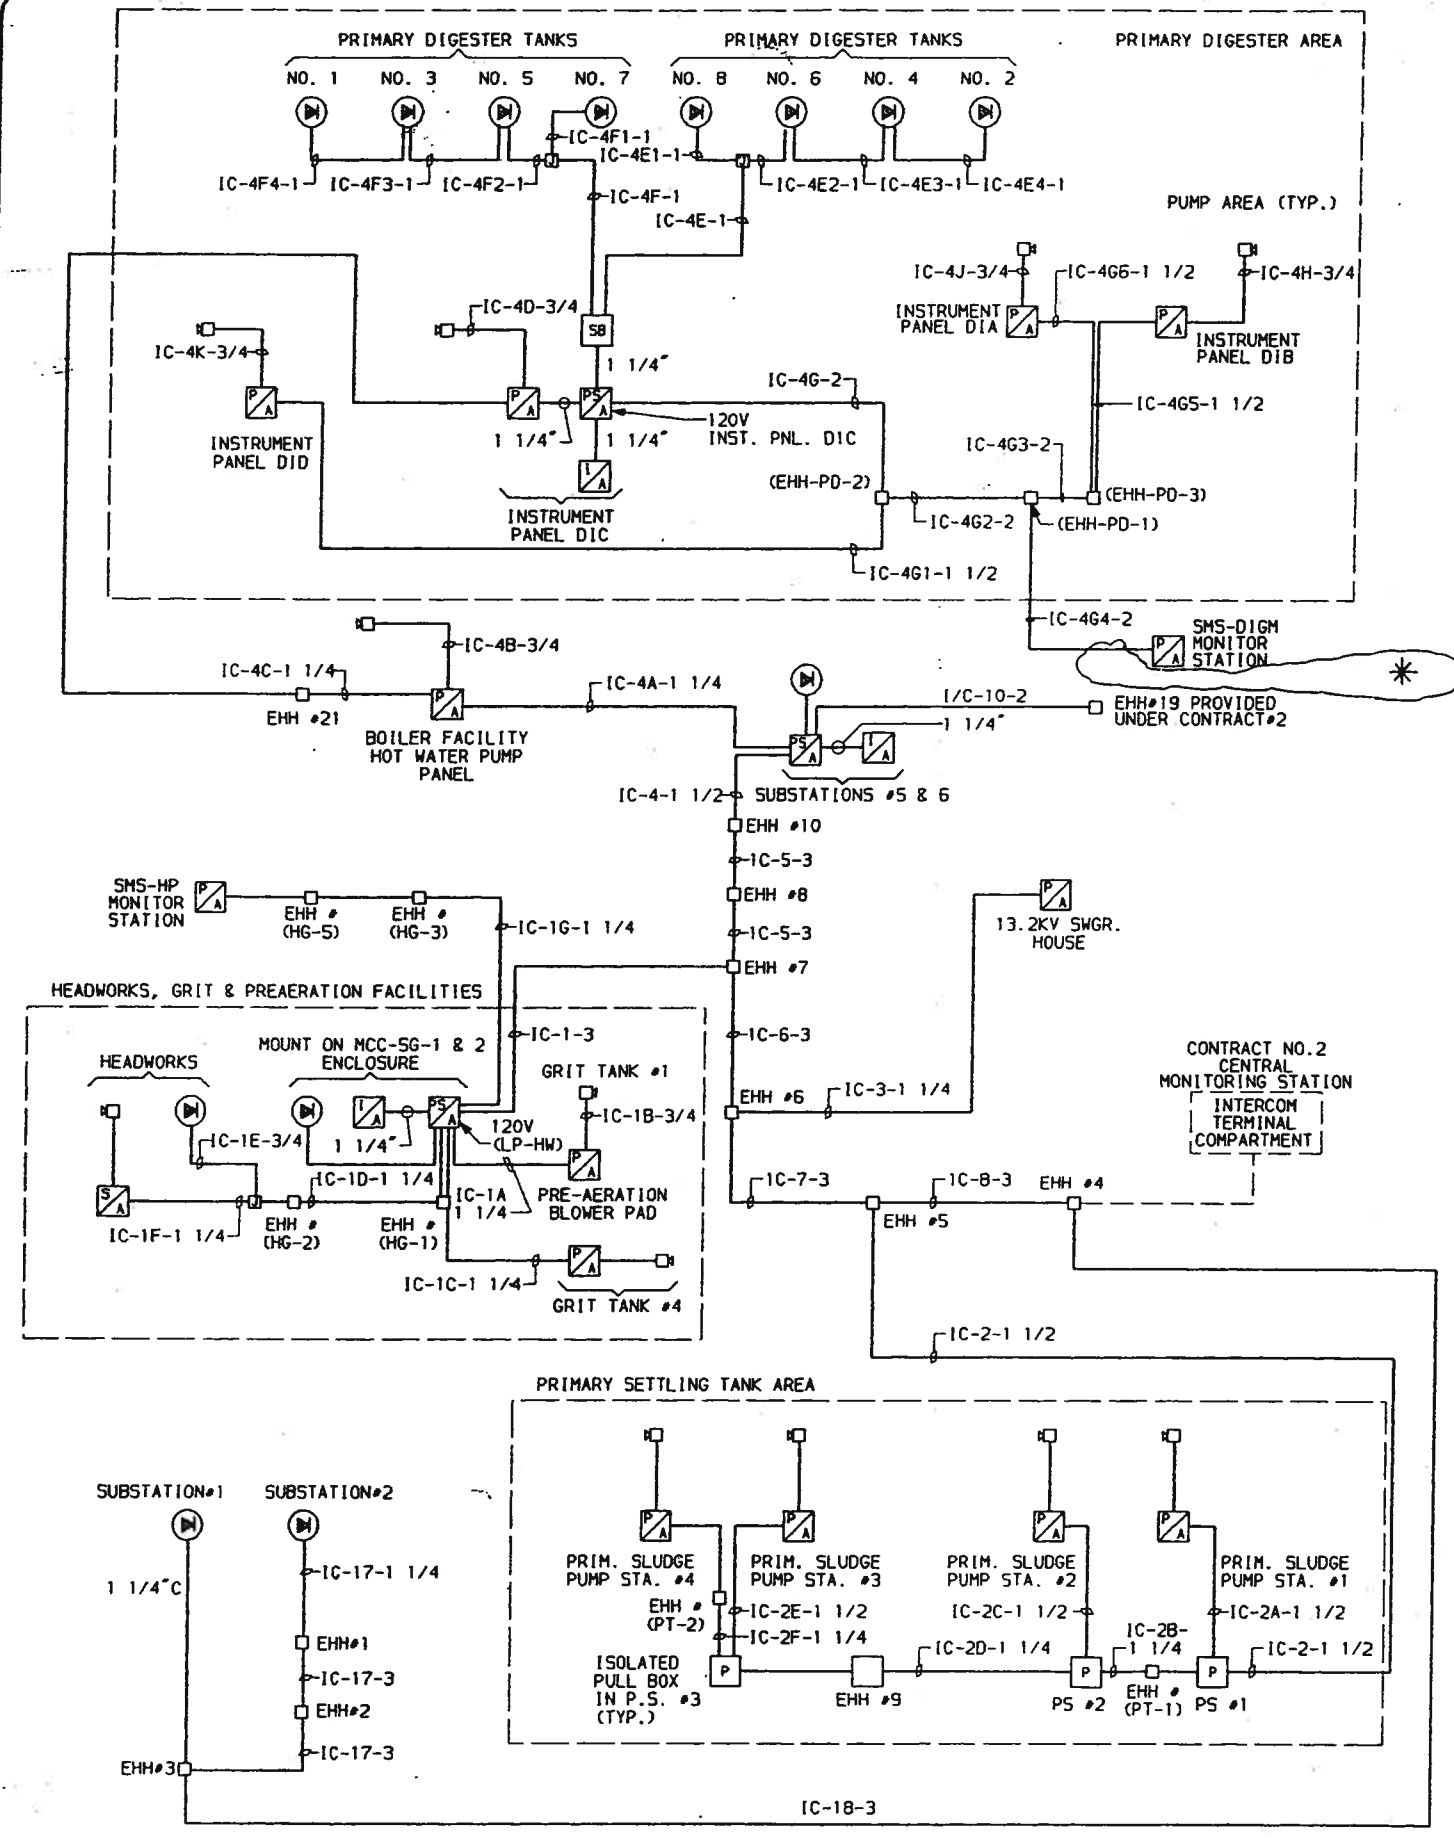

BLOCK DIAGRAM  
INTERCOM CONDUIT SYSTEM RISER

\* REFER TO DRAWING E-15X FOR "AS-BUILT" CONDITIONS

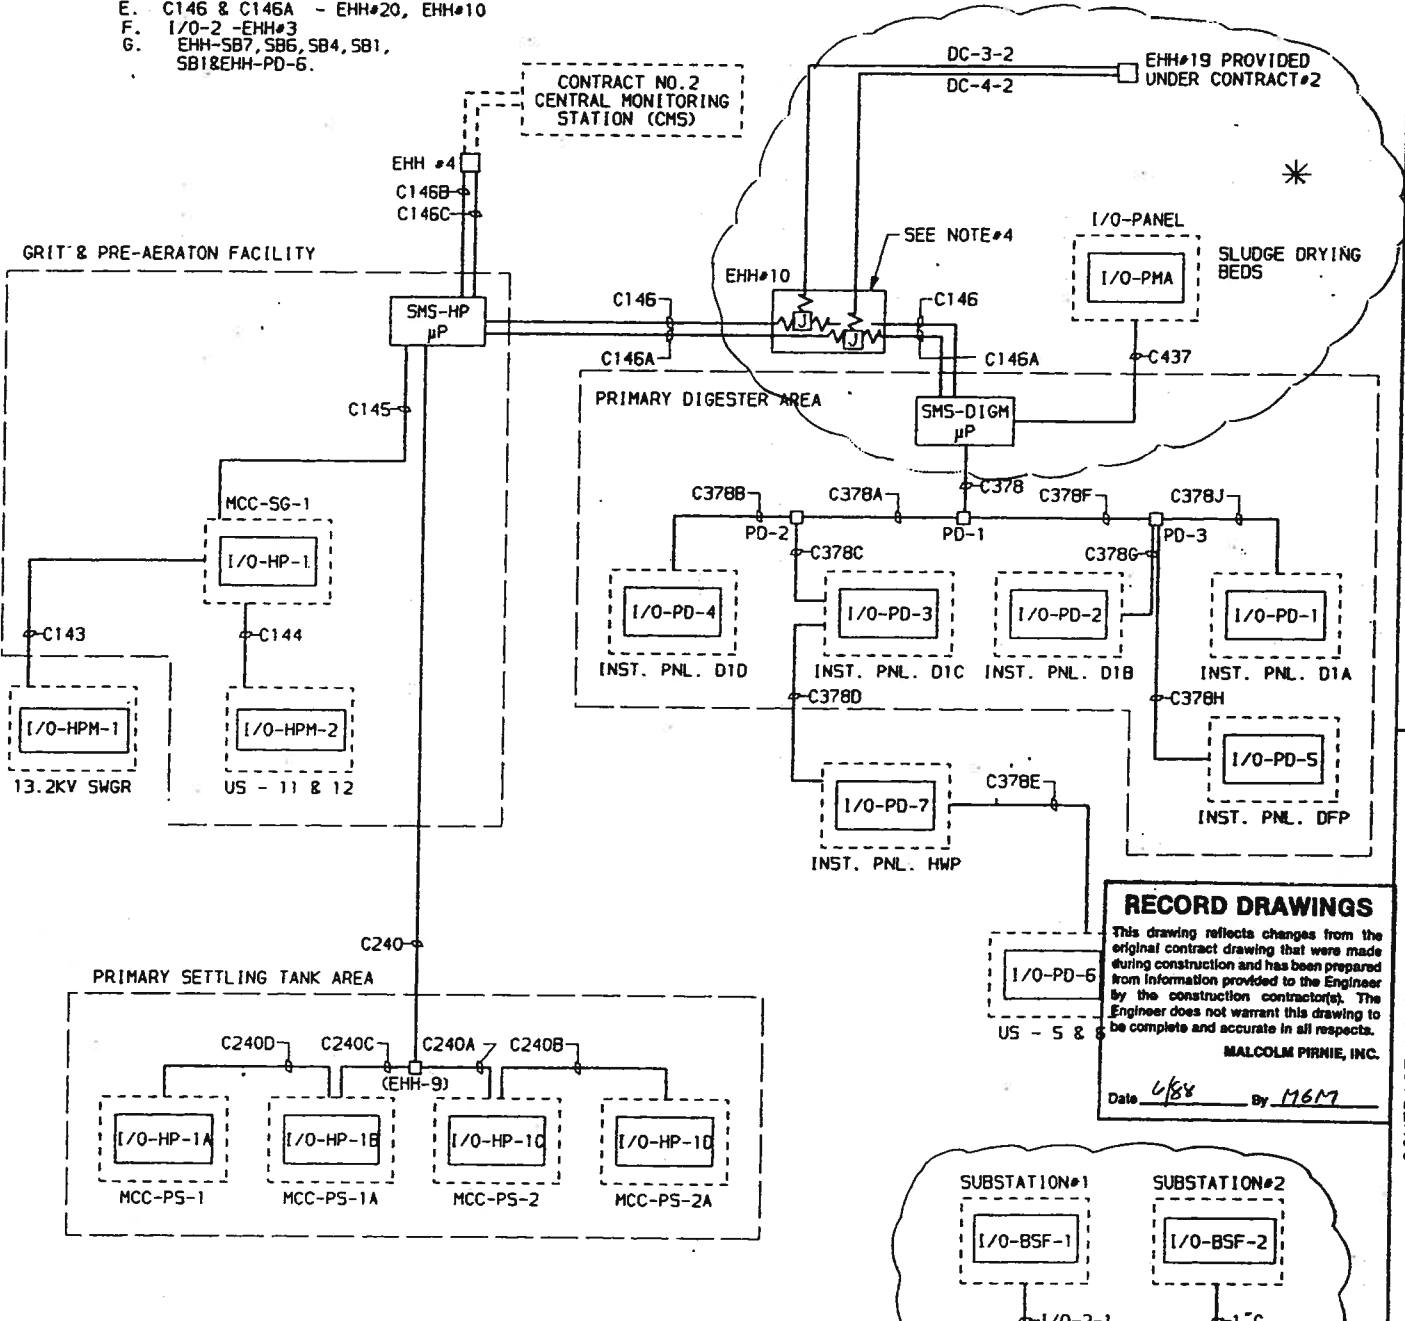

BLOCK DIAGRAM  
PMS & I/O - CONDUIT SYSTEM RISER

**RECORD DRAWINGS**  
This drawing reflects changes from the original contract drawing that were made during construction and has been prepared from information provided to the Engineer by the construction contractor(s). The Engineer does not warrant this drawing to be complete and accurate in all respects.  
MALCOLM PIRNIE, INC.  
Date 4/84 By M6M

DR 83-6502

MALCOLM PIRNIE



Date: NOV 1983  
 Designed by: FS  
 Drawn by: FS  
 Checked by: [Signature]  
 Scale: NO SCALE



WARRANTED  
 FACILITIES  
 IMPROVEMENTS

SAN ANTONIO

CONTRACT NO. 3  
 DOS RIOS FACILITY  
 SCREEN, GRIT, &  
 PREARATION FACILITIES  
 MCC 5G-1 ONE-LINE

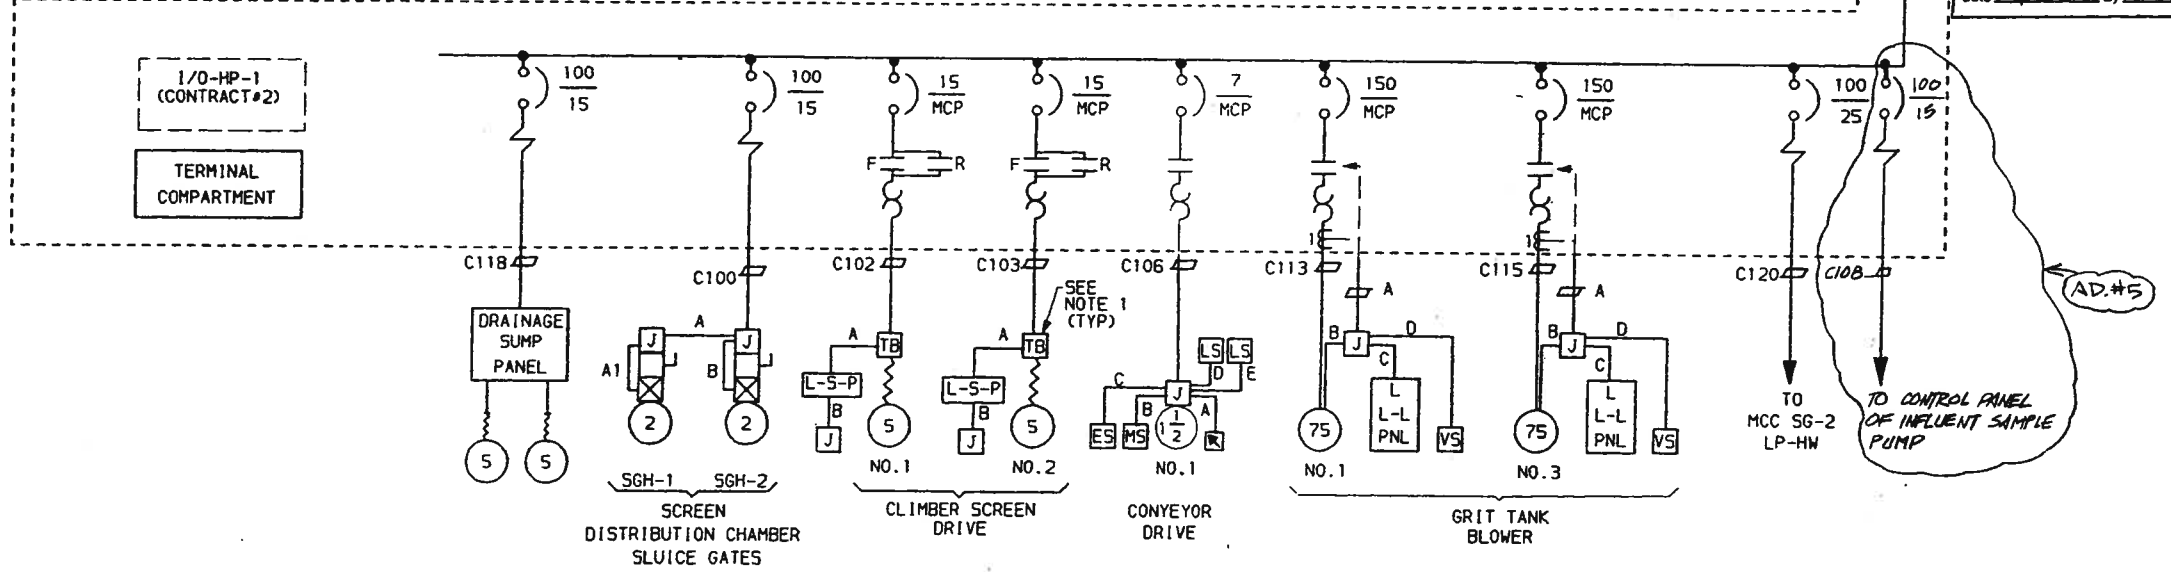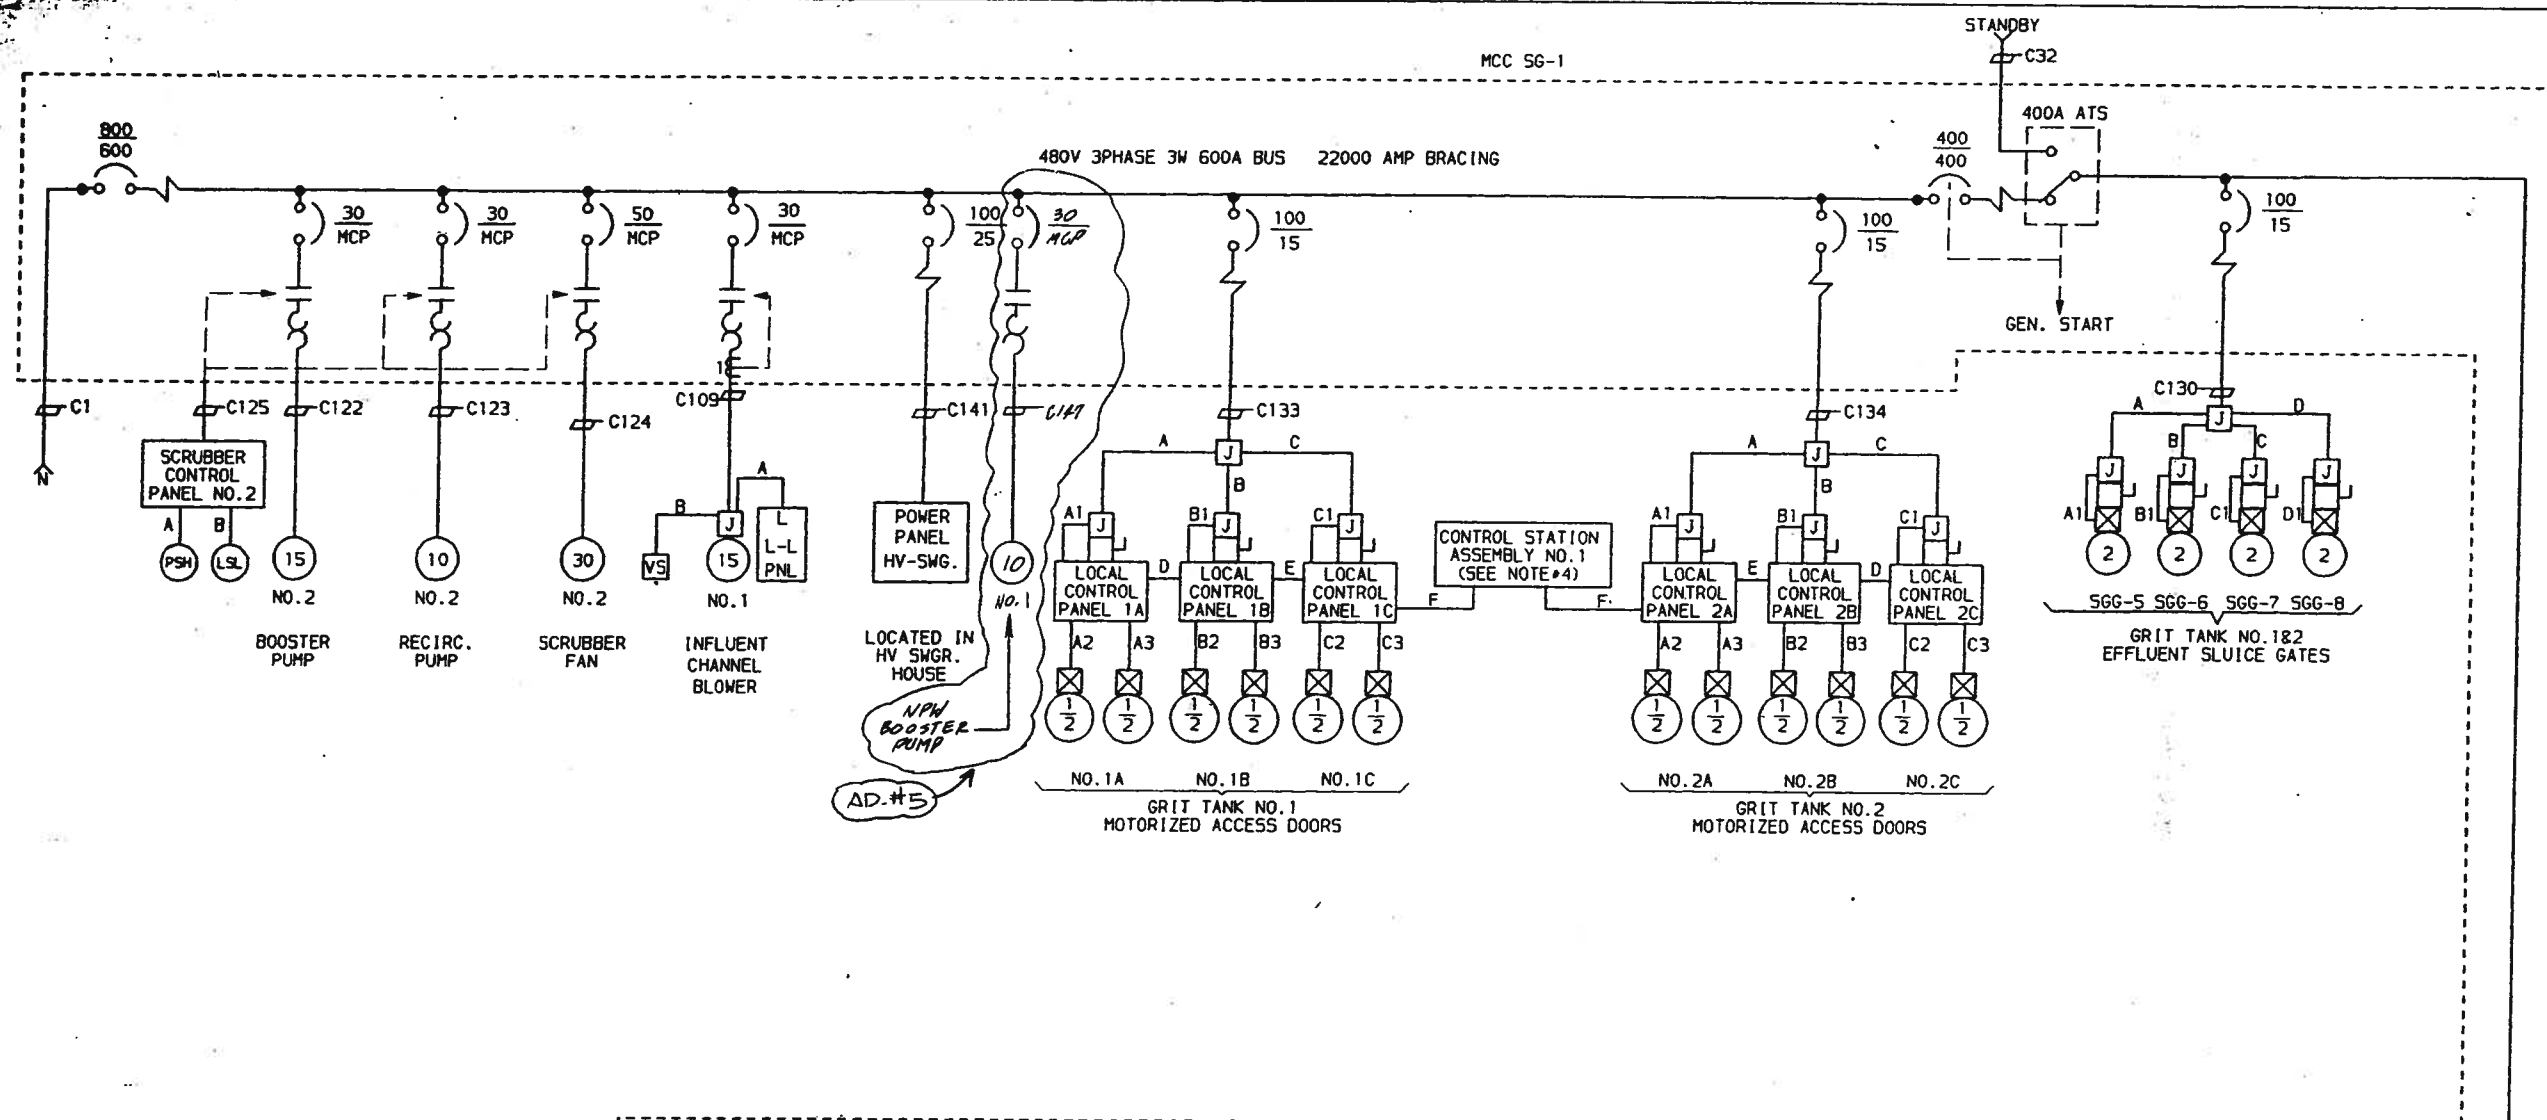



**RECORD DRAWINGS**  
 This drawing reflects changes from the original contract drawing that were made during construction and has been prepared from information provided to the Engineer by the construction contractor(s). The Engineer does not warrant this drawing to be complete and accurate in all respects.  
 MALCOLM PIRNIE, INC.  
 Date: 6/88 By: HGM/1

- NOTES
- 1 CONTRACTOR SHALL PROVIDE TERMINAL BOX FOR WIRE TO CABLE TERMINATIONS FOR MOTOR CONNECTIONS ONLY. CABLE TO BE SUPPLIED BY SCREEN MANUFACTURER.
  - 2 L-S-P INDICATES LOCAL SCREEN PANEL.
  - 3 L L-L PNL INDICATES LOCAL LOW LOAD PANEL.
  - 4 CONTRACTOR SHALL PROVIDE ONE OPEN-STOP-CLOSE OILTIGHT PUSHBUTTON PER PANEL, SIMILAR TO SPECIAL ASSEMBLY GE#CR2940 WITH NEMA 4 STAINLESS STEEL ENCLOSURE. PROVIDE LOCK-OUT FEATURE ON OPEN BUTTON TO PREVENT OPENING OF DOORS WHEN LOCKED.

DR 03-0502

MCC 5G-1

480V 3PHASE 3W 600A BUS 22000 AMP BRACING

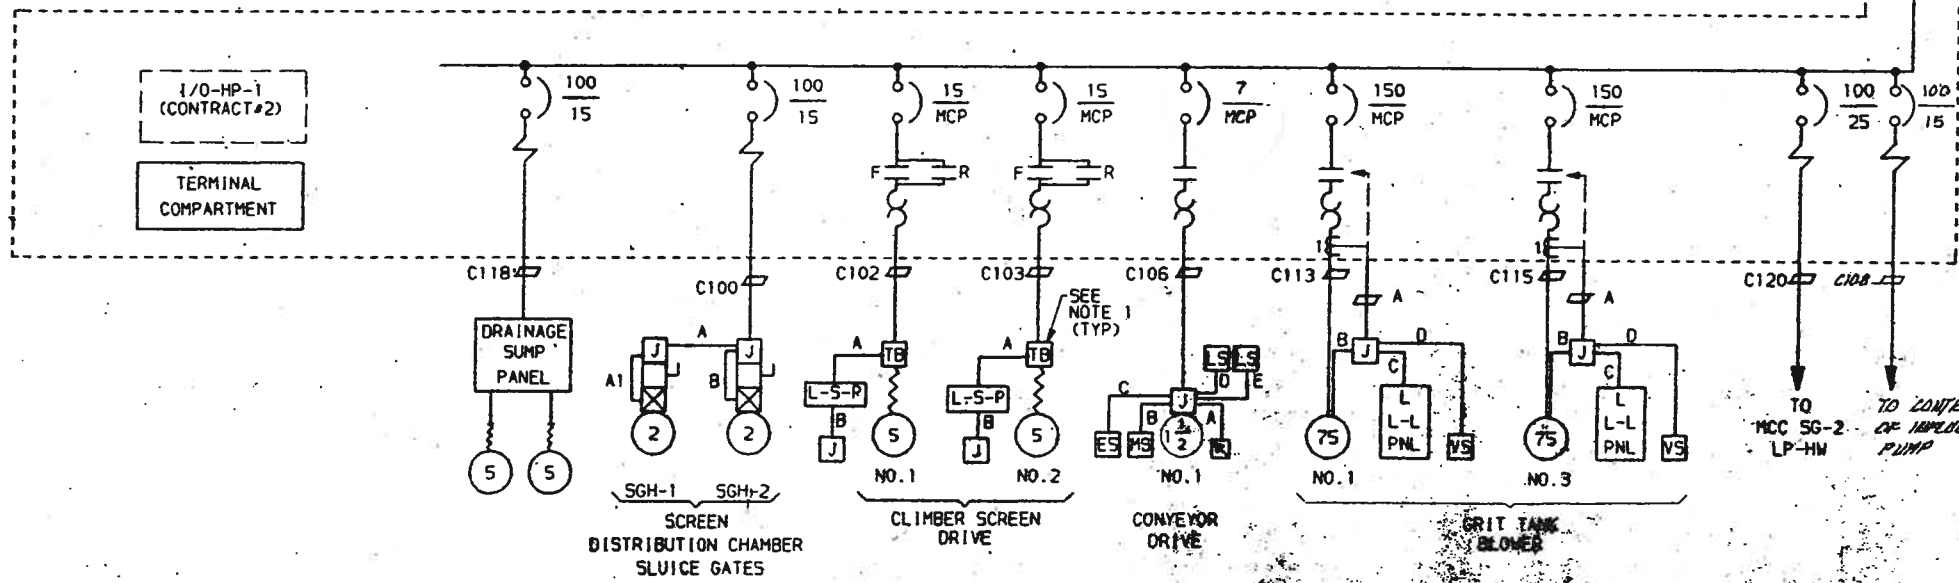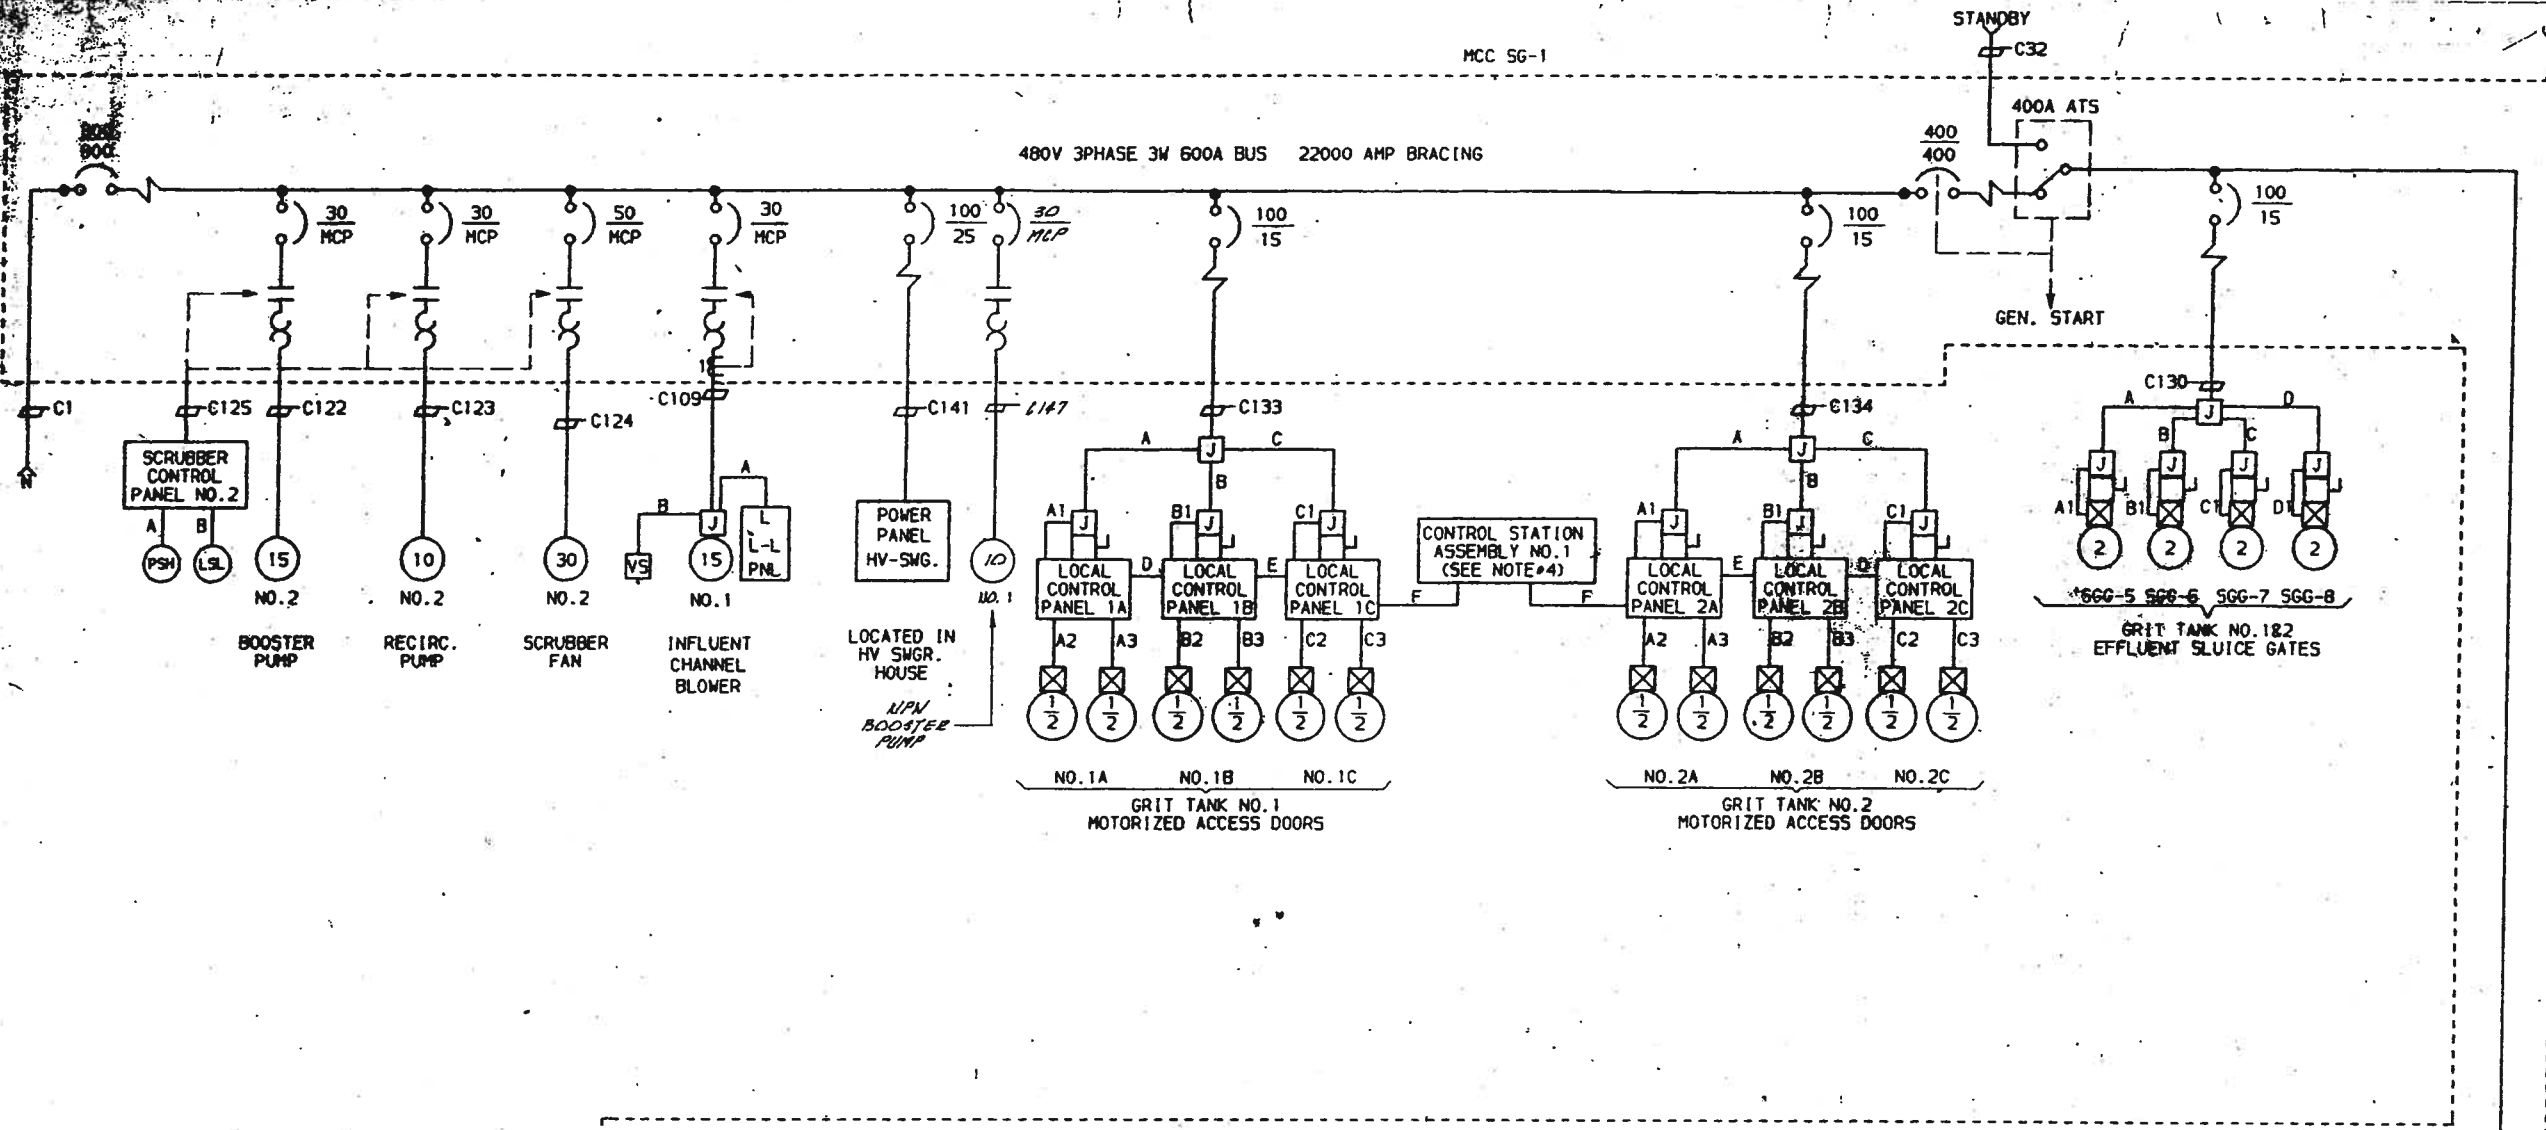

- NOTES**
1. CONTRACTOR SHALL PROVIDE TERMINAL BOX FOR ALL 20 CABLE TERMINATIONS FOR WATER CONNECTIONS ONLY. CABLE TO BE SUPPLIED BY SCREEN MANUFACTURER.
  2. L-S-P INDICATES LOCAL SCREEN PANEL.
  3. L-L-PN INDICATES LOCAL LOW VOLTAGE PANEL.
  4. CONTRACTOR SHALL PROVIDE ONE (1) OPEN-STOP-CLOSE ON-LOCK (OSCO) SWITCH PER PANEL. TERMINALS TO BE PROVIDED BY MANUFACTURER. SEE DRAWING FOR ALL SWITCHES AND CONNECTIONS TO PREVENT SHORTS.

**PROJECT RECORD**

WASTEWATER FACILITIES IMPROVEMENTS  
 SAN ANTONIO  
 CONTRACT NO. 3  
 DOS RIOS FACILITY  
 SCREEN, GRIT, & PREAERATION FACILITIES  
 MCC 5G-1 ONE-LINE

DR 83-6502




WATERWORKS  
FACILITIES  
IMPROVEMENTS

San Antonio

CONTRACT NO. 3  
DOS RIOS FACILITY  
SCREEN, GRIT, &  
PREARATION FACILITIES  
MCC 5G-2 ONE-LINE

MCC 5G-2

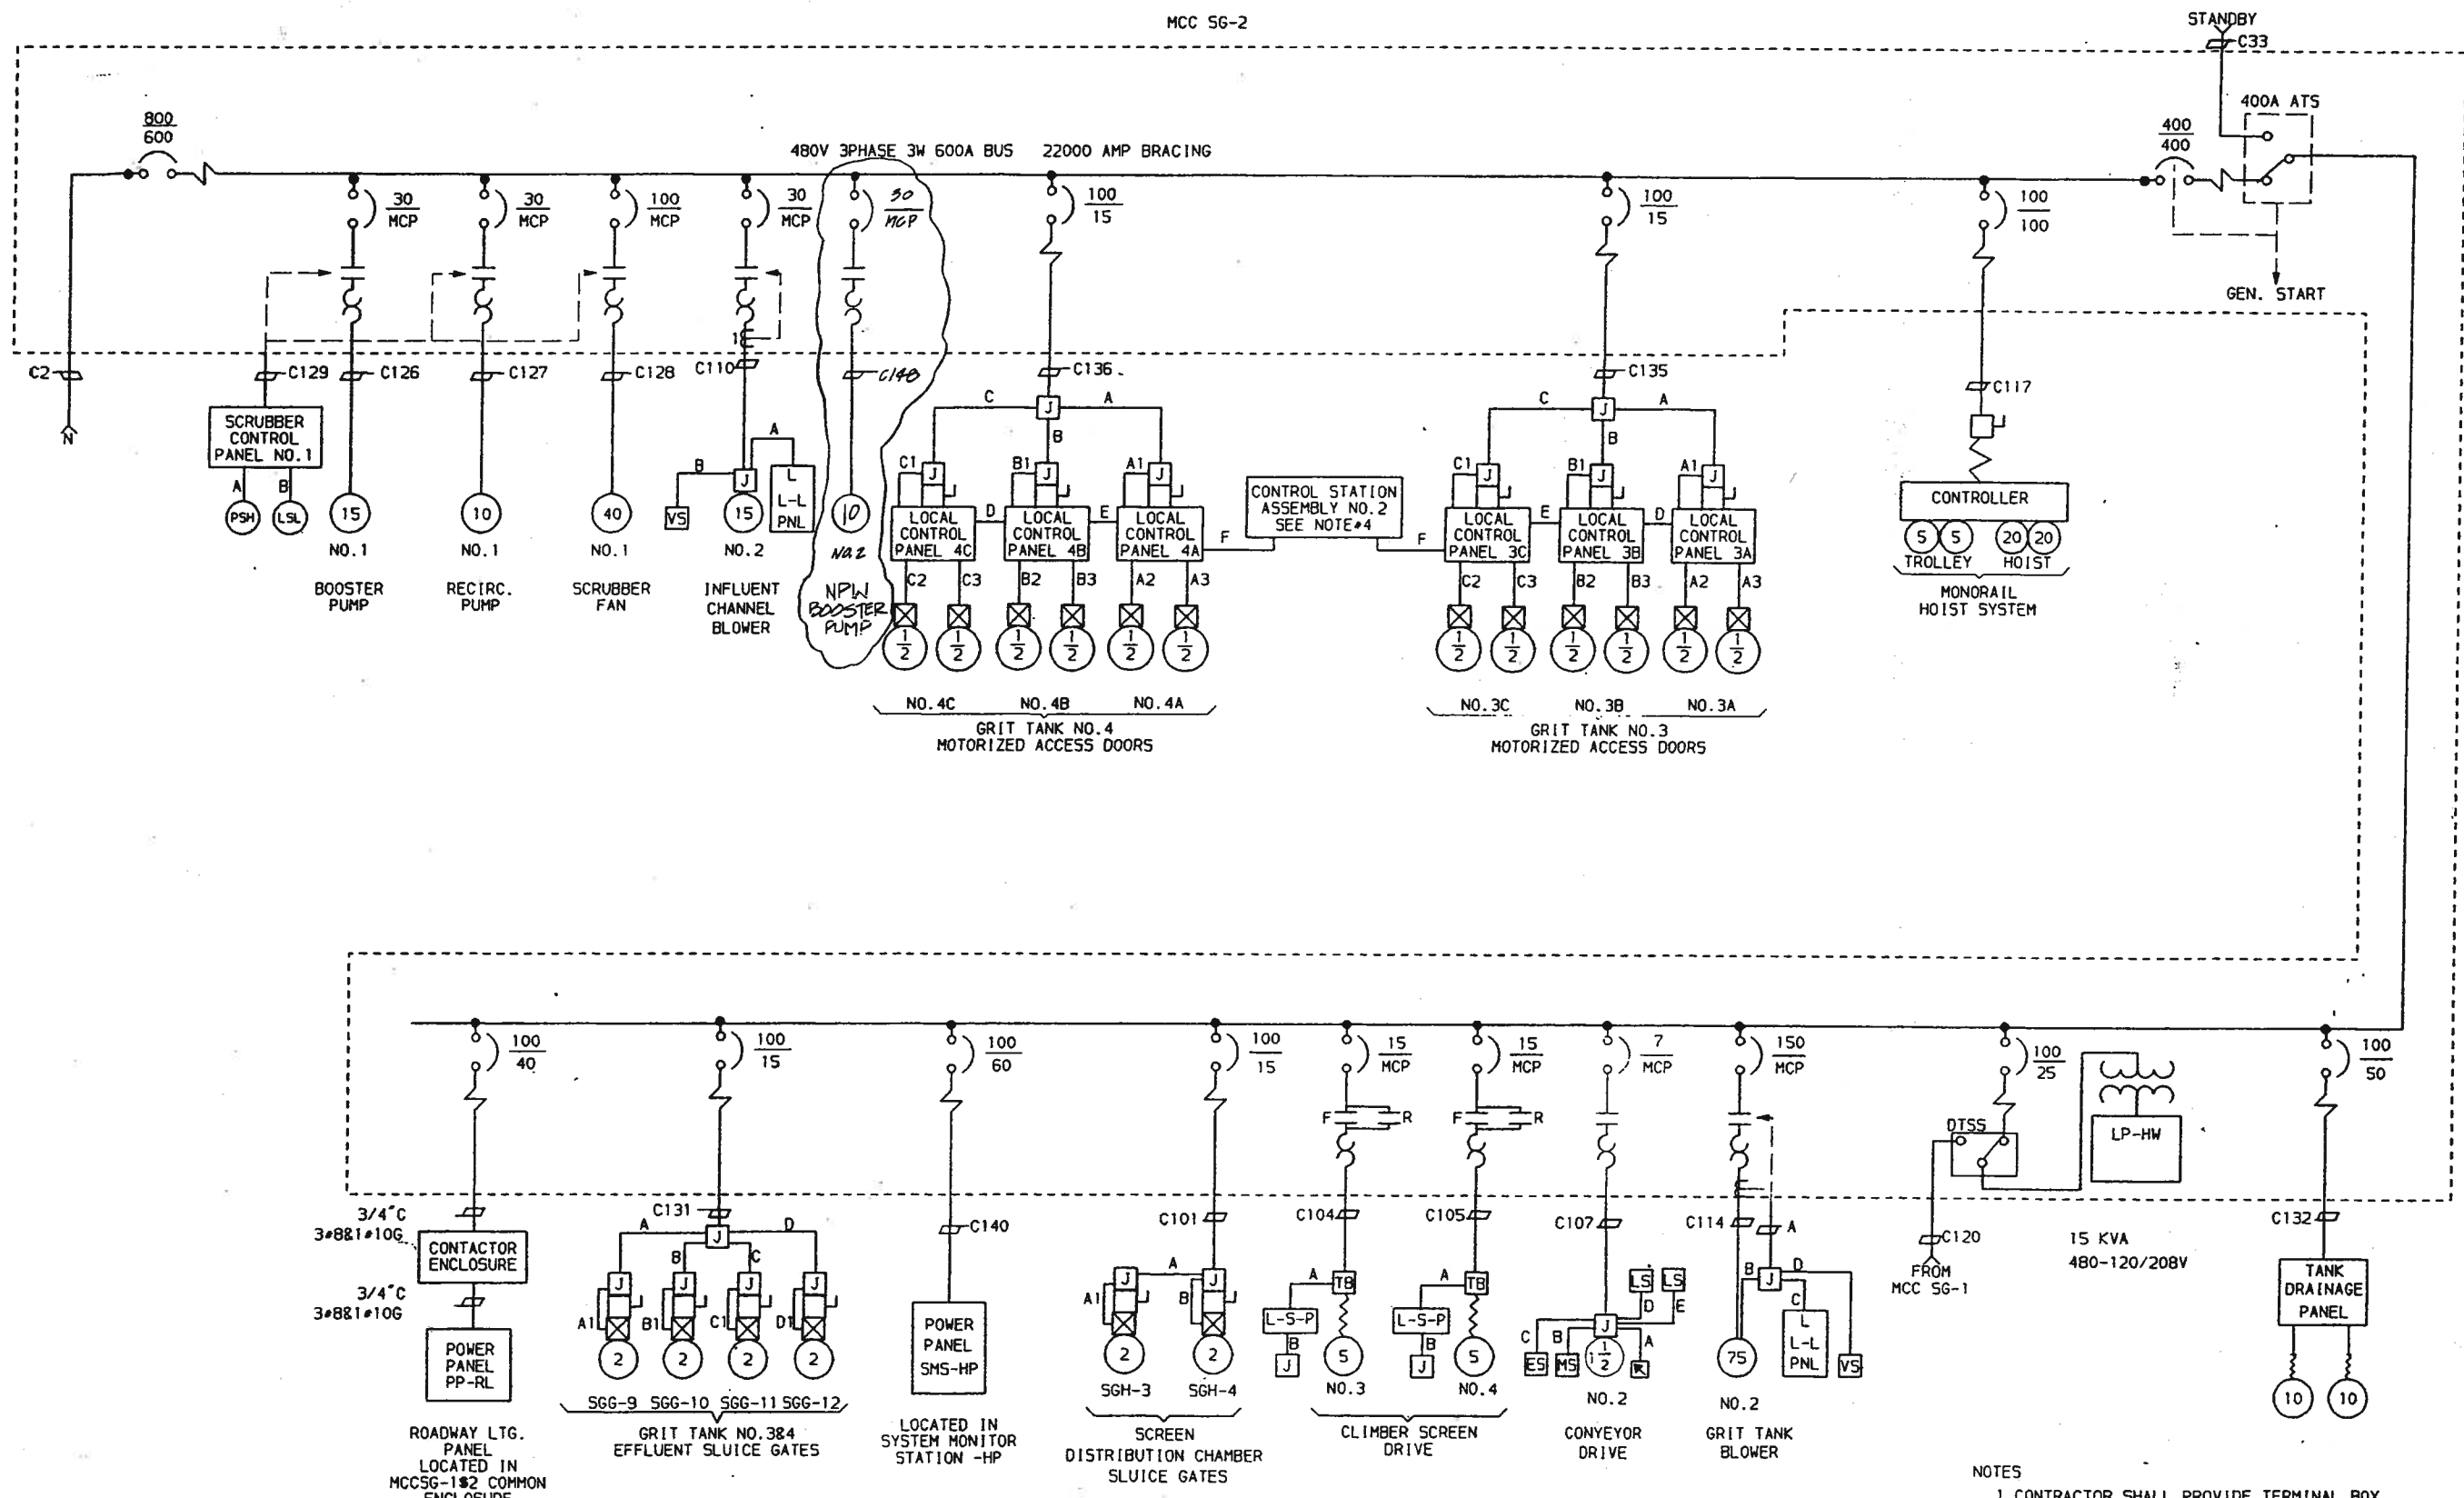


- NOTES
- 1 CONTRACTOR SHALL PROVIDE TERMINAL BOX FOR WIRE TO CABLE TERMINATIONS FOR MOTOR CONNECTIONS ONLY. CABLE TO BE SUPPLIED BY SCREEN MANUFACTURER.
  - 2 L-S-P INDICATES LOCAL SCREEN PANEL.
  - 3 L L-L PNL INDICATES LOCAL LOW LOAD PANEL.
  - 4 CONTRACTOR SHALL PROVIDE ONE OPEN-STOP-CLOSE OILTIGHT PUSHBUTTON PER PANEL, SIMILAR TO SPECIAL ASSEMBLY GE#CR2940 WITH NEMA 4 STAINLESS STEEL ENCLOSURE. PROVIDE LOCK-OUT FEATURE ON OPEN BUTTON TO PREVENT OPENING OF DOORS WHEN LOCKED.

**RECORD DRAWINGS**  
This drawing reflects changes from the original contract drawing that were made during construction and has been prepared from information provided to the Engineer by the construction contractor(s). The Engineer does not warrant this drawing to be complete and accurate in all respects.  
MALCOLM PIRNIE, INC.  
Date: 6/88 By: HLT

DR 83-6502



MCC 56-2

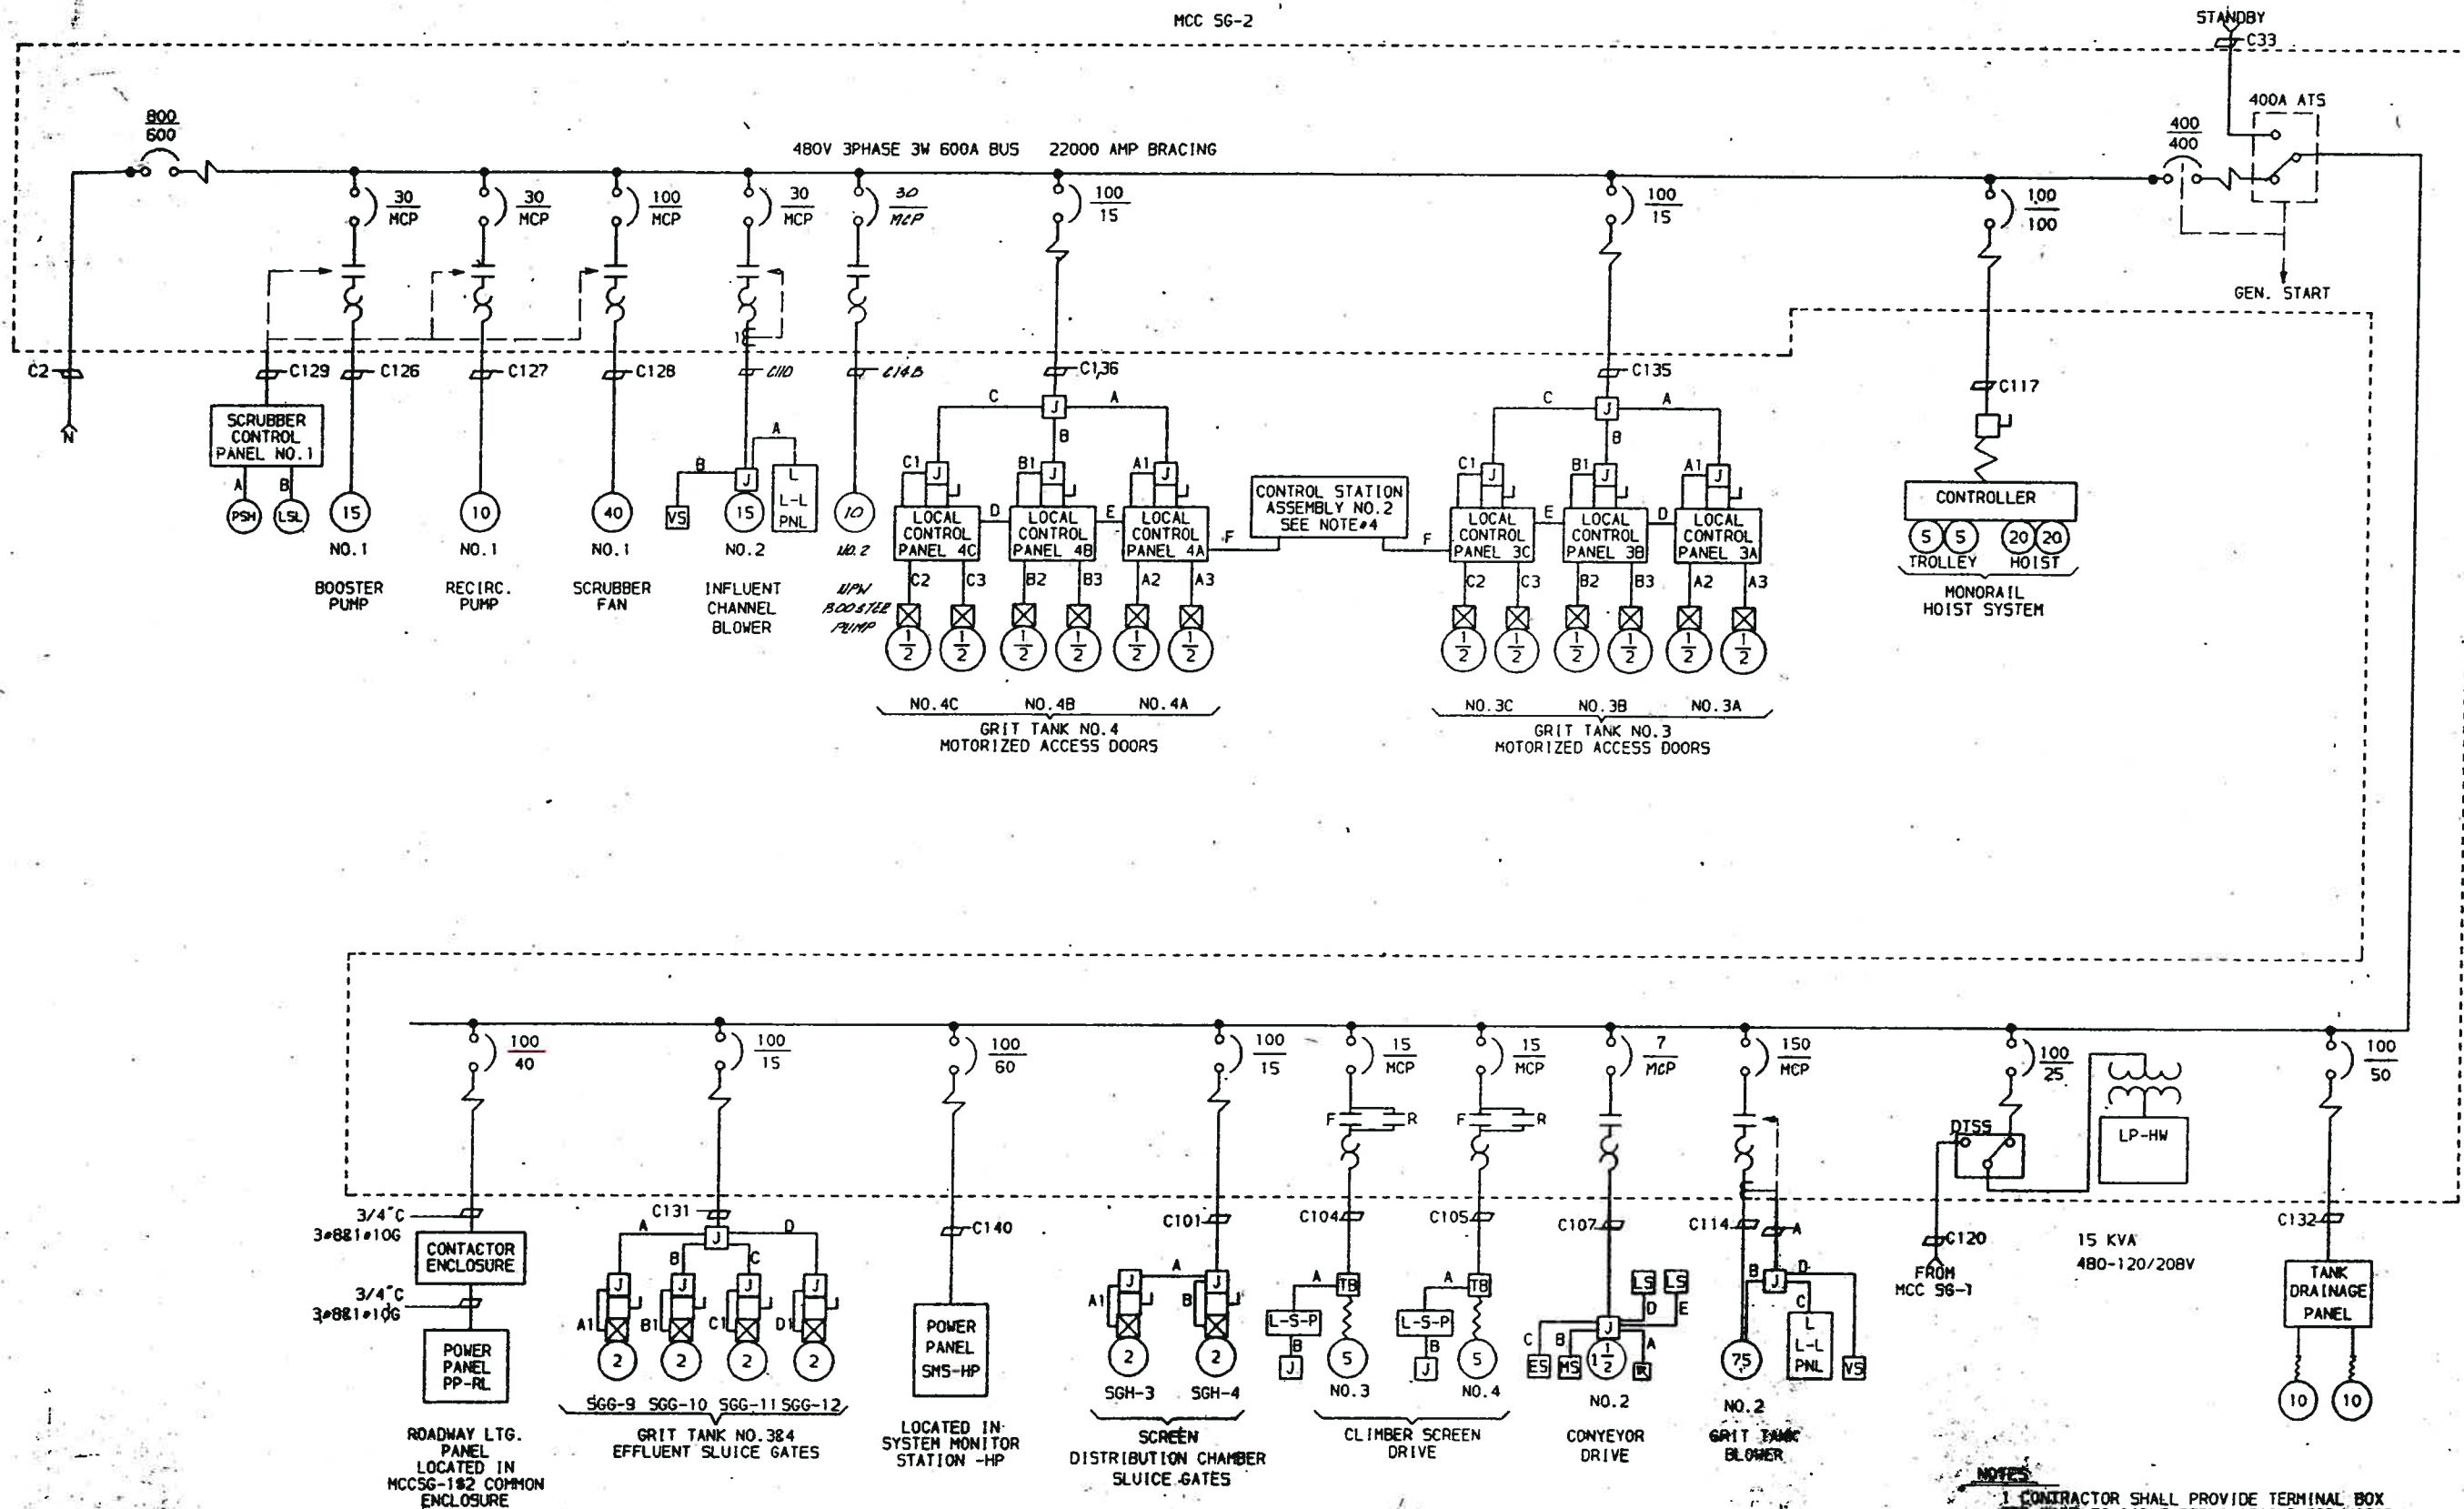

- NOTES**
- CONTRACTOR SHALL PROVIDE TERMINAL BOX FOR WIRE TO CABLE TERMINATIONS FOR MOTOR CONNECTIONS ONLY. CABLE TO BE SUPPLIED BY SCREEN MANUFACTURER.
  - L-S-P INDICATES LOCAL SCREEN PANEL.
  - L-L PNL INDICATES LOCAL LOW LOAD PANEL.
  - CONTRACTOR SHALL PROVIDE ONE OPEN-STOP-CLOSE EIGHT PUSHBUTTON PER PANEL SIMILAR TO SPECIAL ASSEMBLY GE-CR2940 WITH NEMA 4 STAINLESS STEEL ENCLOSURE. PROVIDE LOCK-OUT DEVICE ON OPEN BUTTON TO PREVENT OPENING WHEN LOCKED.

**PROJECT RECORD**

No.	Date	Revisions
1	3-1-86	App-5/11

Wastewater  
Solutions  
Improvements

SAN ANTONIO

CONTRACT NO. 3  
DOS RIOS FACILITY  
SCREEN, GRIT, &  
PREARATION FACILITIES  
MCC 56-2 ONE-LINE

DR 83-6502

**MALCOLM  
PIRNIE**

**CNA**  
CURTIS NEAL &  
ASSOCIATES, INC.  
CONSULTING ENGINEERS  
1157 E. COMMERCE  
SAN ANTONIO, TEXAS 78205





Date: NOV. 1983  
Designed by: K. MALAMUK  
Drawn by: M. HANLSON  
Checked by: C. E. N. [Signature]  
Scale: 1" = 30'










**W**ASTEWATER  
**F**ACILITIES  
**I**MPROVEMENTS

**SAN** ANTONIO

CONTRACT NO. 3  
**DOS RIOS FACILITY**  
SCREEN, GRIT, & PREARATION FACILITIES  
POWER DISTRIBUTION & AREA LIGHTING

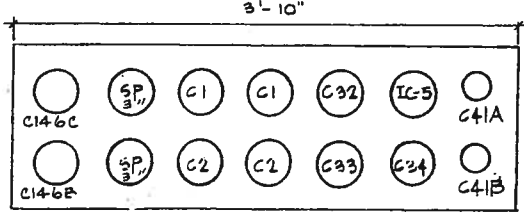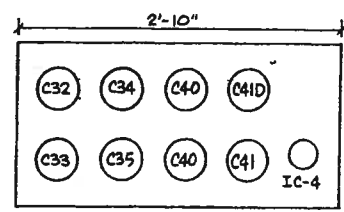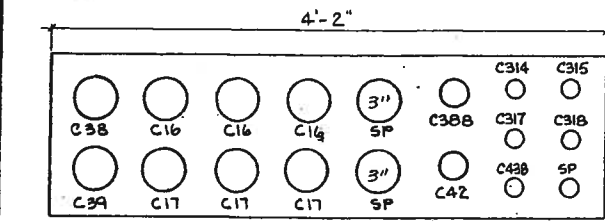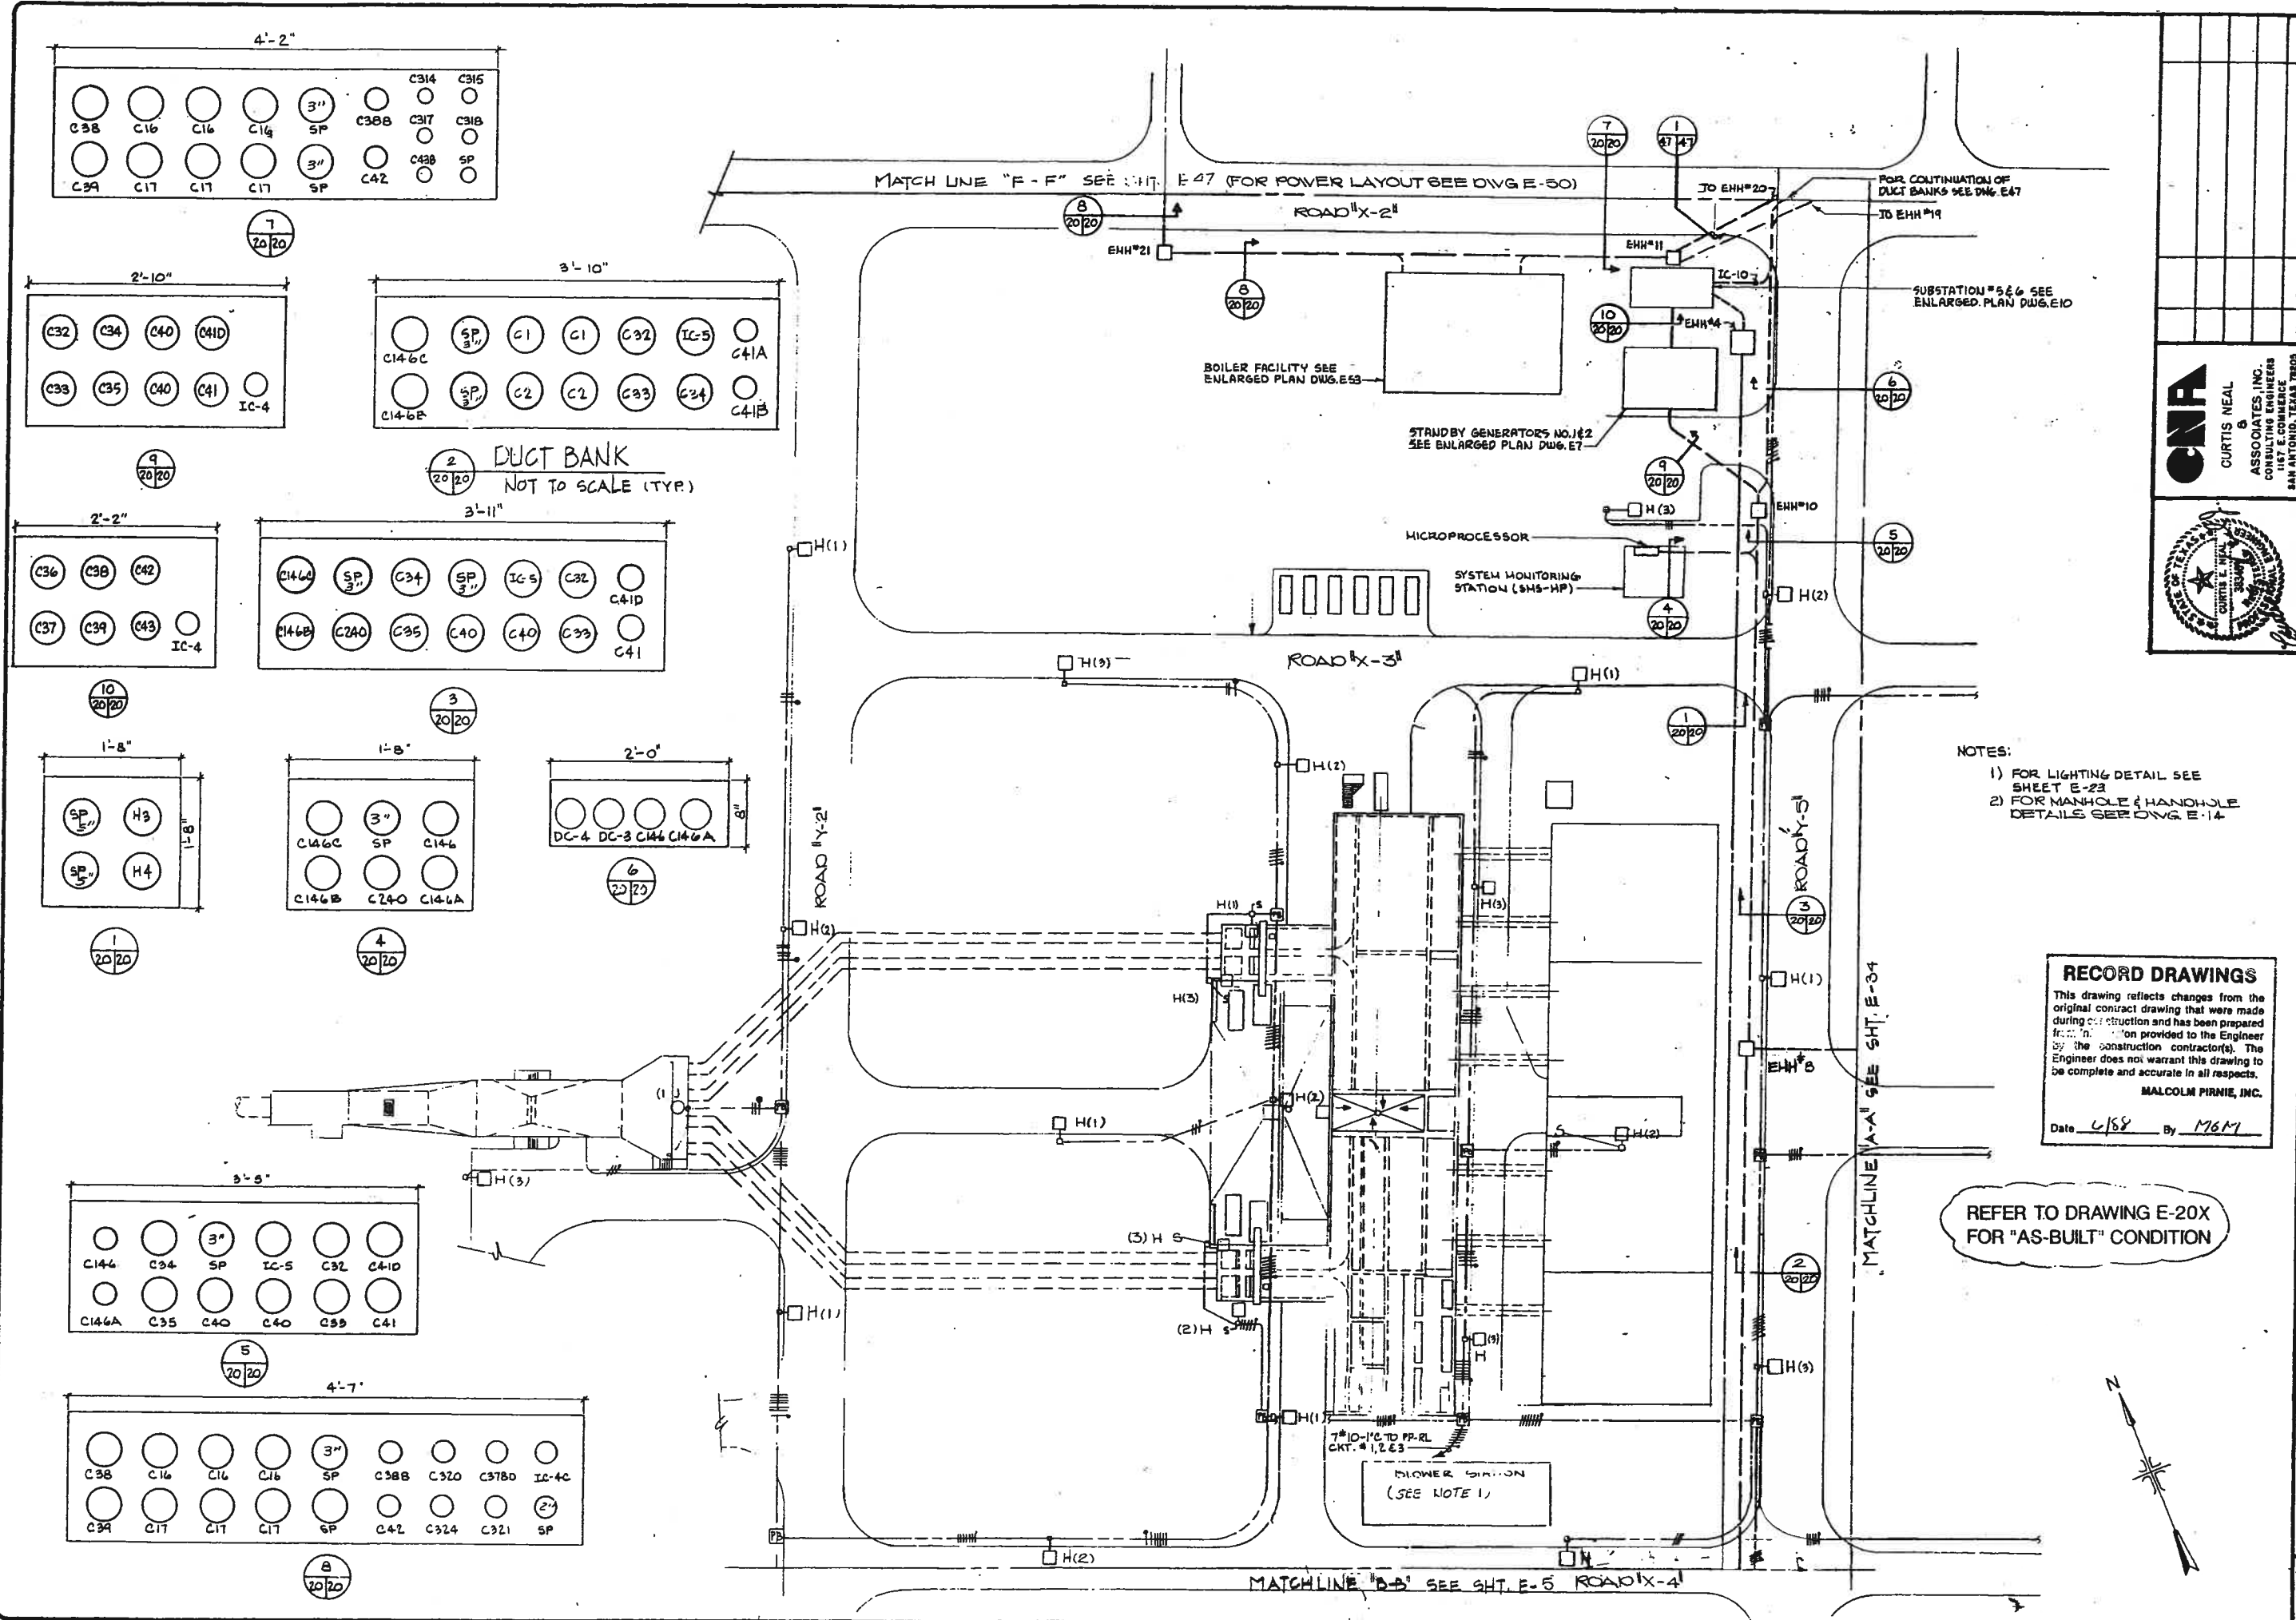


DUCT BANK  
NOT TO SCALE (TYP.)

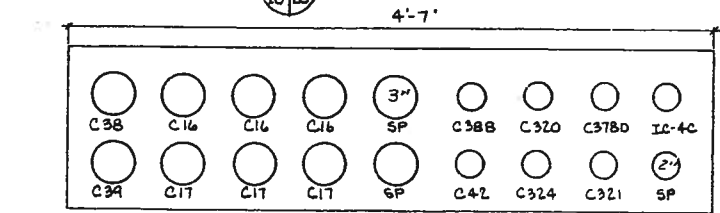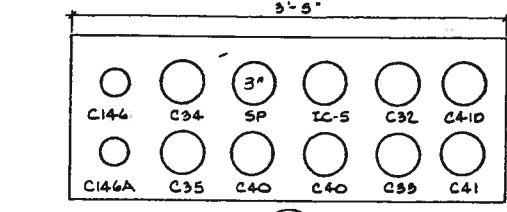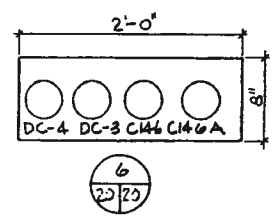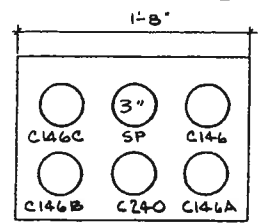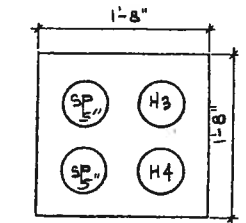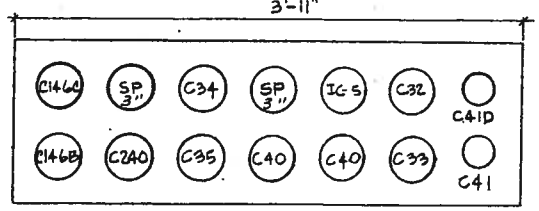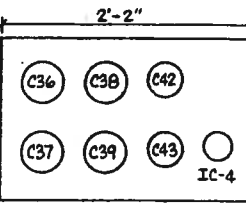


- NOTES:
- 1) FOR LIGHTING DETAIL SEE SHEET E-23
  - 2) FOR MANHOLE & HANDHOLE DETAILS SEE DWG. E-14

**RECORD DRAWINGS**  
This drawing reflects changes from the original construction drawing that were made during construction and has been prepared from information provided to the Engineer by the construction contractor(s). The Engineer does not warrant this drawing to be complete and accurate in all respects.  
MALCOLM PIRNIE, INC.  
Date: 1/88 By: M6M

REFER TO DRAWING E-20X FOR "AS-BUILT" CONDITION

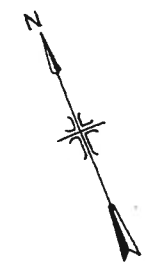

DH 83-0004

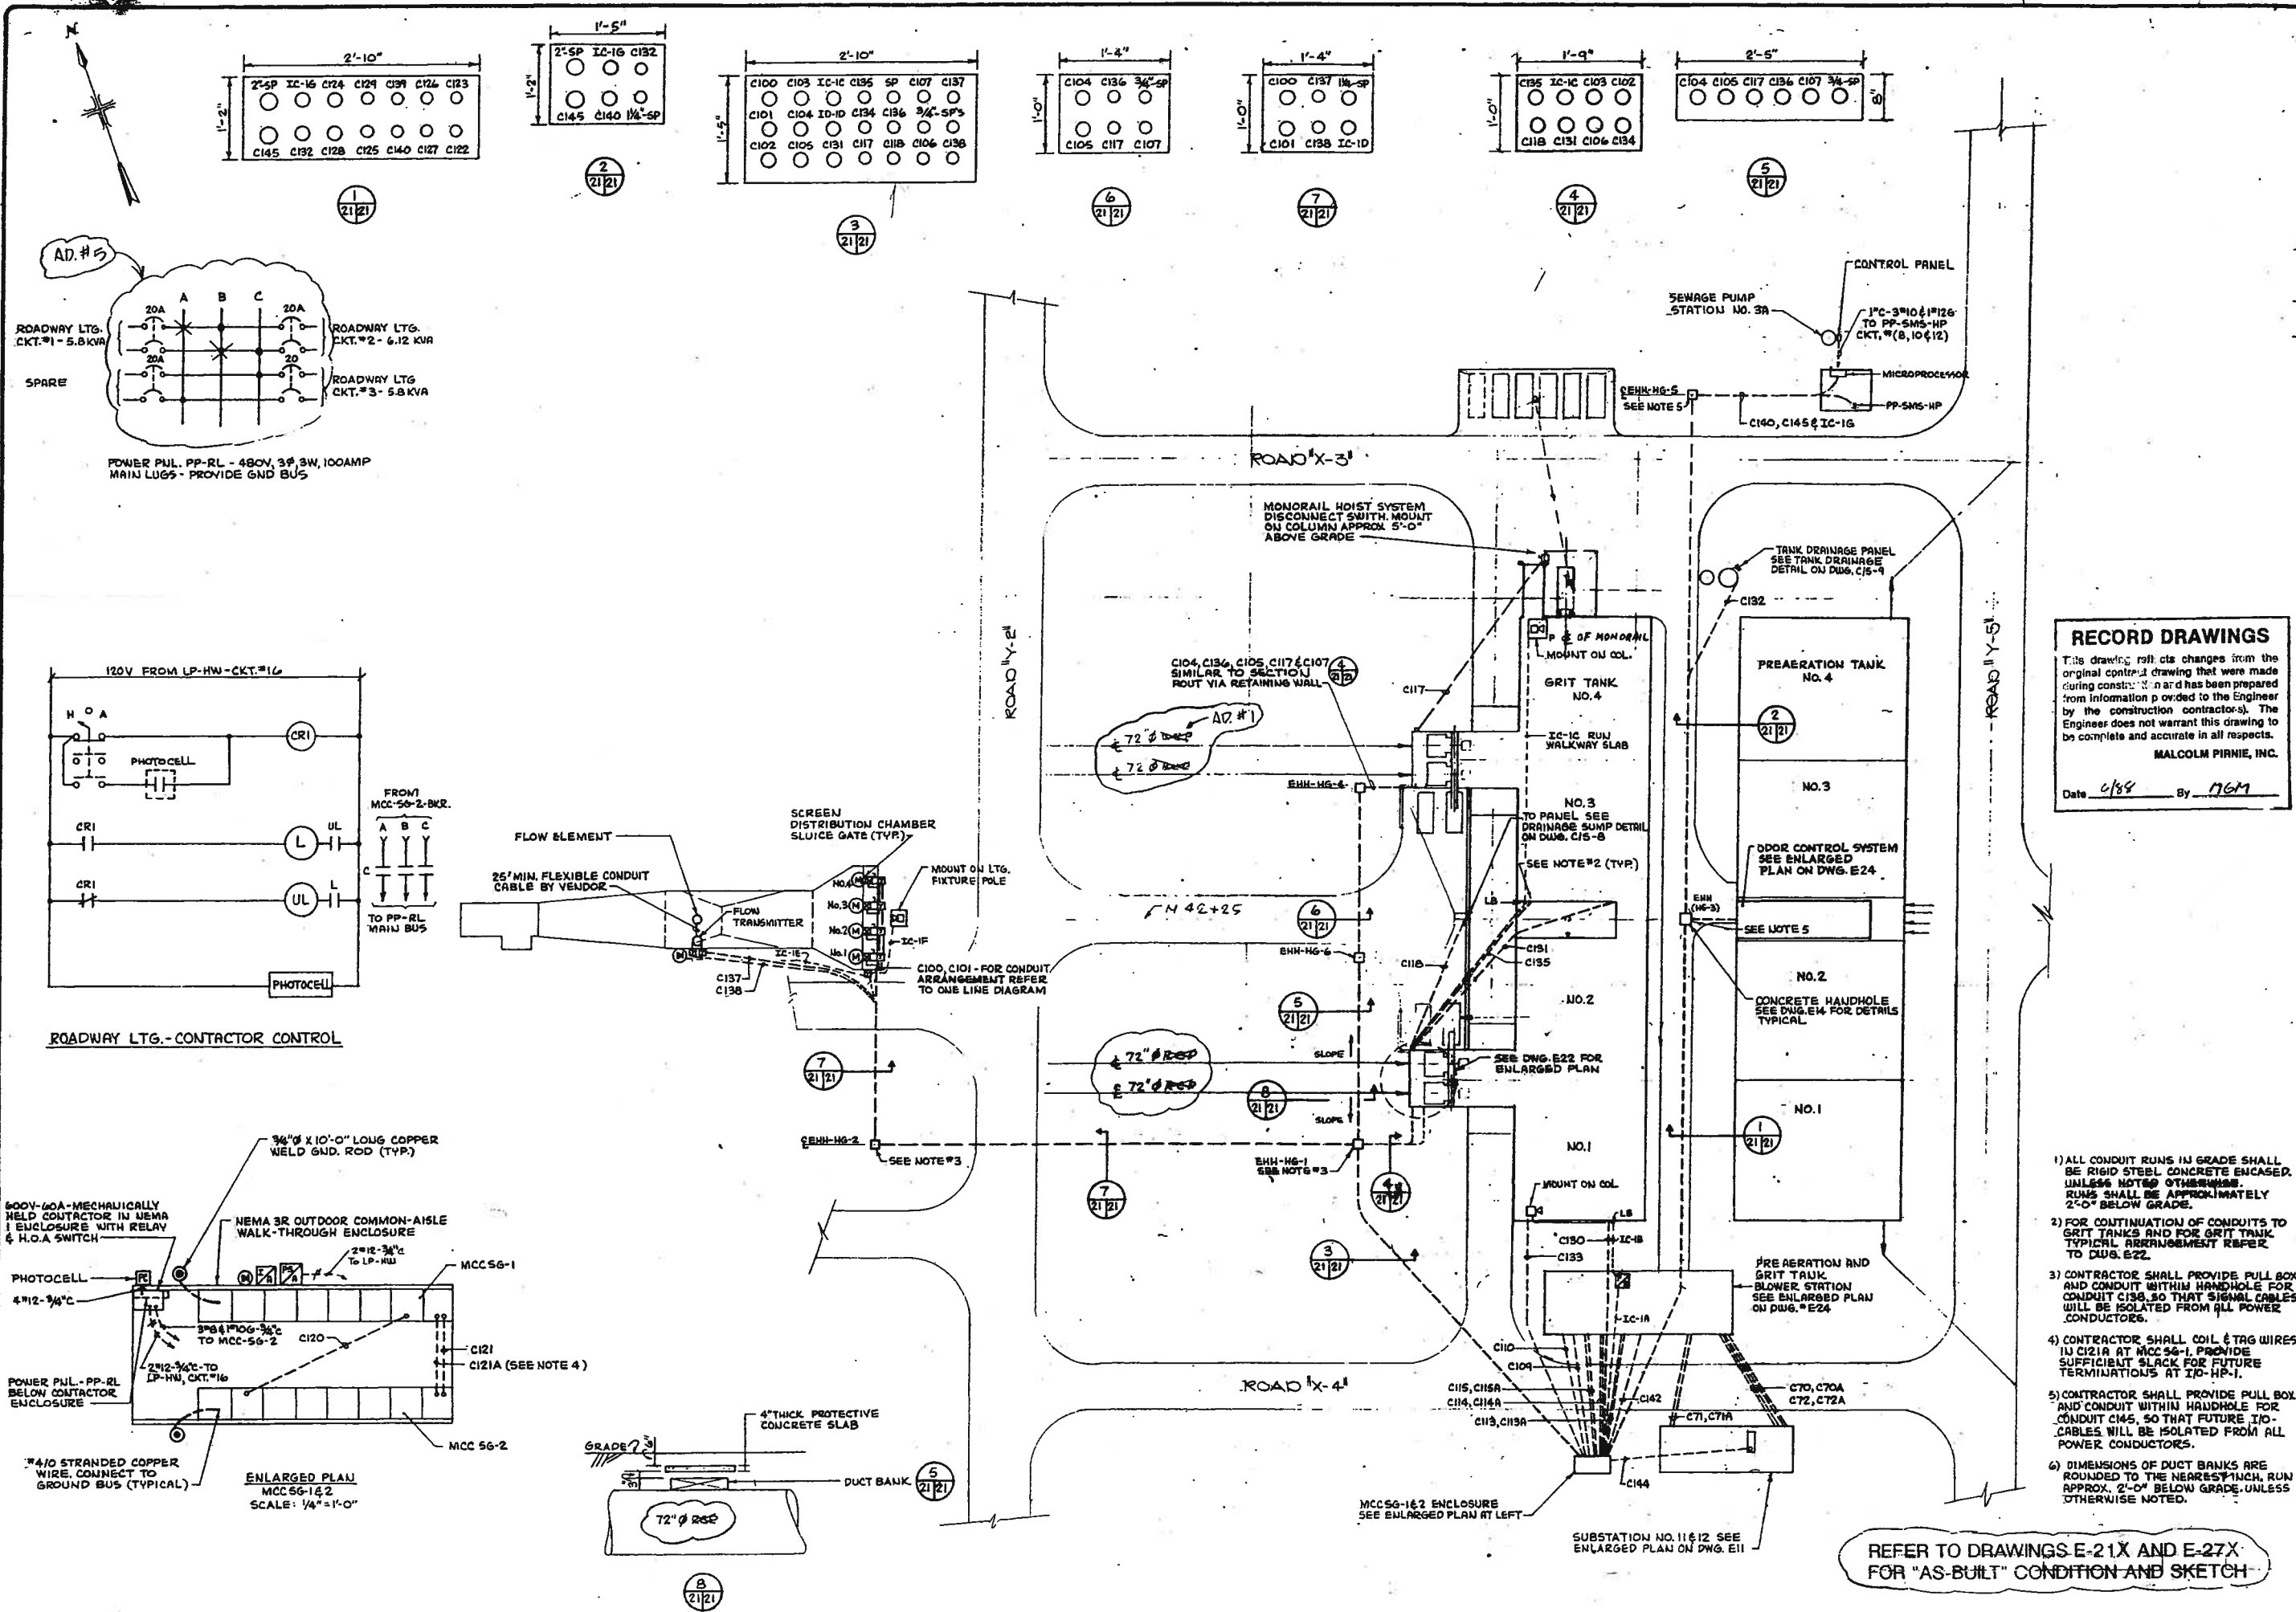


**RECORD DRAWINGS**  
 This drawing reflects changes from the original contract drawing that were made during construction and has been prepared from information provided to the Engineer by the construction contractor. The Engineer does not warrant this drawing to be complete and accurate in all respects.  
**MALCOLM PIRNIE, INC.**  
 Date: 1/84 By: [Signature]

- 1) ALL CONDUIT RUNS IN GRADE SHALL BE RIGID STEEL CONDUIT ENCASED, UNLESS NOTED OTHERWISE. RUNS SHALL BE APPROXIMATELY 2'-0" BELOW GRADE.
- 2) FOR CONTINUATION OF CONDUITS TO GRIT TANKS AND FOR GRIT TANK TYPICAL ARRANGEMENT REFER TO DWG. E22.
- 3) CONTRACTOR SHALL PROVIDE PULL BOX AND CONDUIT WITHIN HANDHOLE FOR CONDUIT C138 SO THAT SIGNAL CABLES WILL BE ISOLATED FROM ALL POWER CONDUCTORS.
- 4) CONTRACTOR SHALL COIL & TAG WIRES IN C121A AT MCC 56-1. PROVIDE SUFFICIENT SLACK FOR FUTURE TERMINATIONS AT I/O-HP-1.
- 5) CONTRACTOR SHALL PROVIDE PULL BOX AND CONDUIT WITHIN HANDHOLE FOR CONDUIT C145, SO THAT FUTURE I/O CABLES WILL BE ISOLATED FROM ALL POWER CONDUCTORS.
- 6) DIMENSIONS OF DUCT BANKS ARE ROUNDED TO THE NEAREST 1/4" INCH, RUN APPROX. 2'-0" BELOW GRADE, UNLESS OTHERWISE NOTED.

REFER TO DRAWINGS E-21X AND E-27X FOR "AS-BUILT" CONDITION AND SKETCH

DR 83-6502

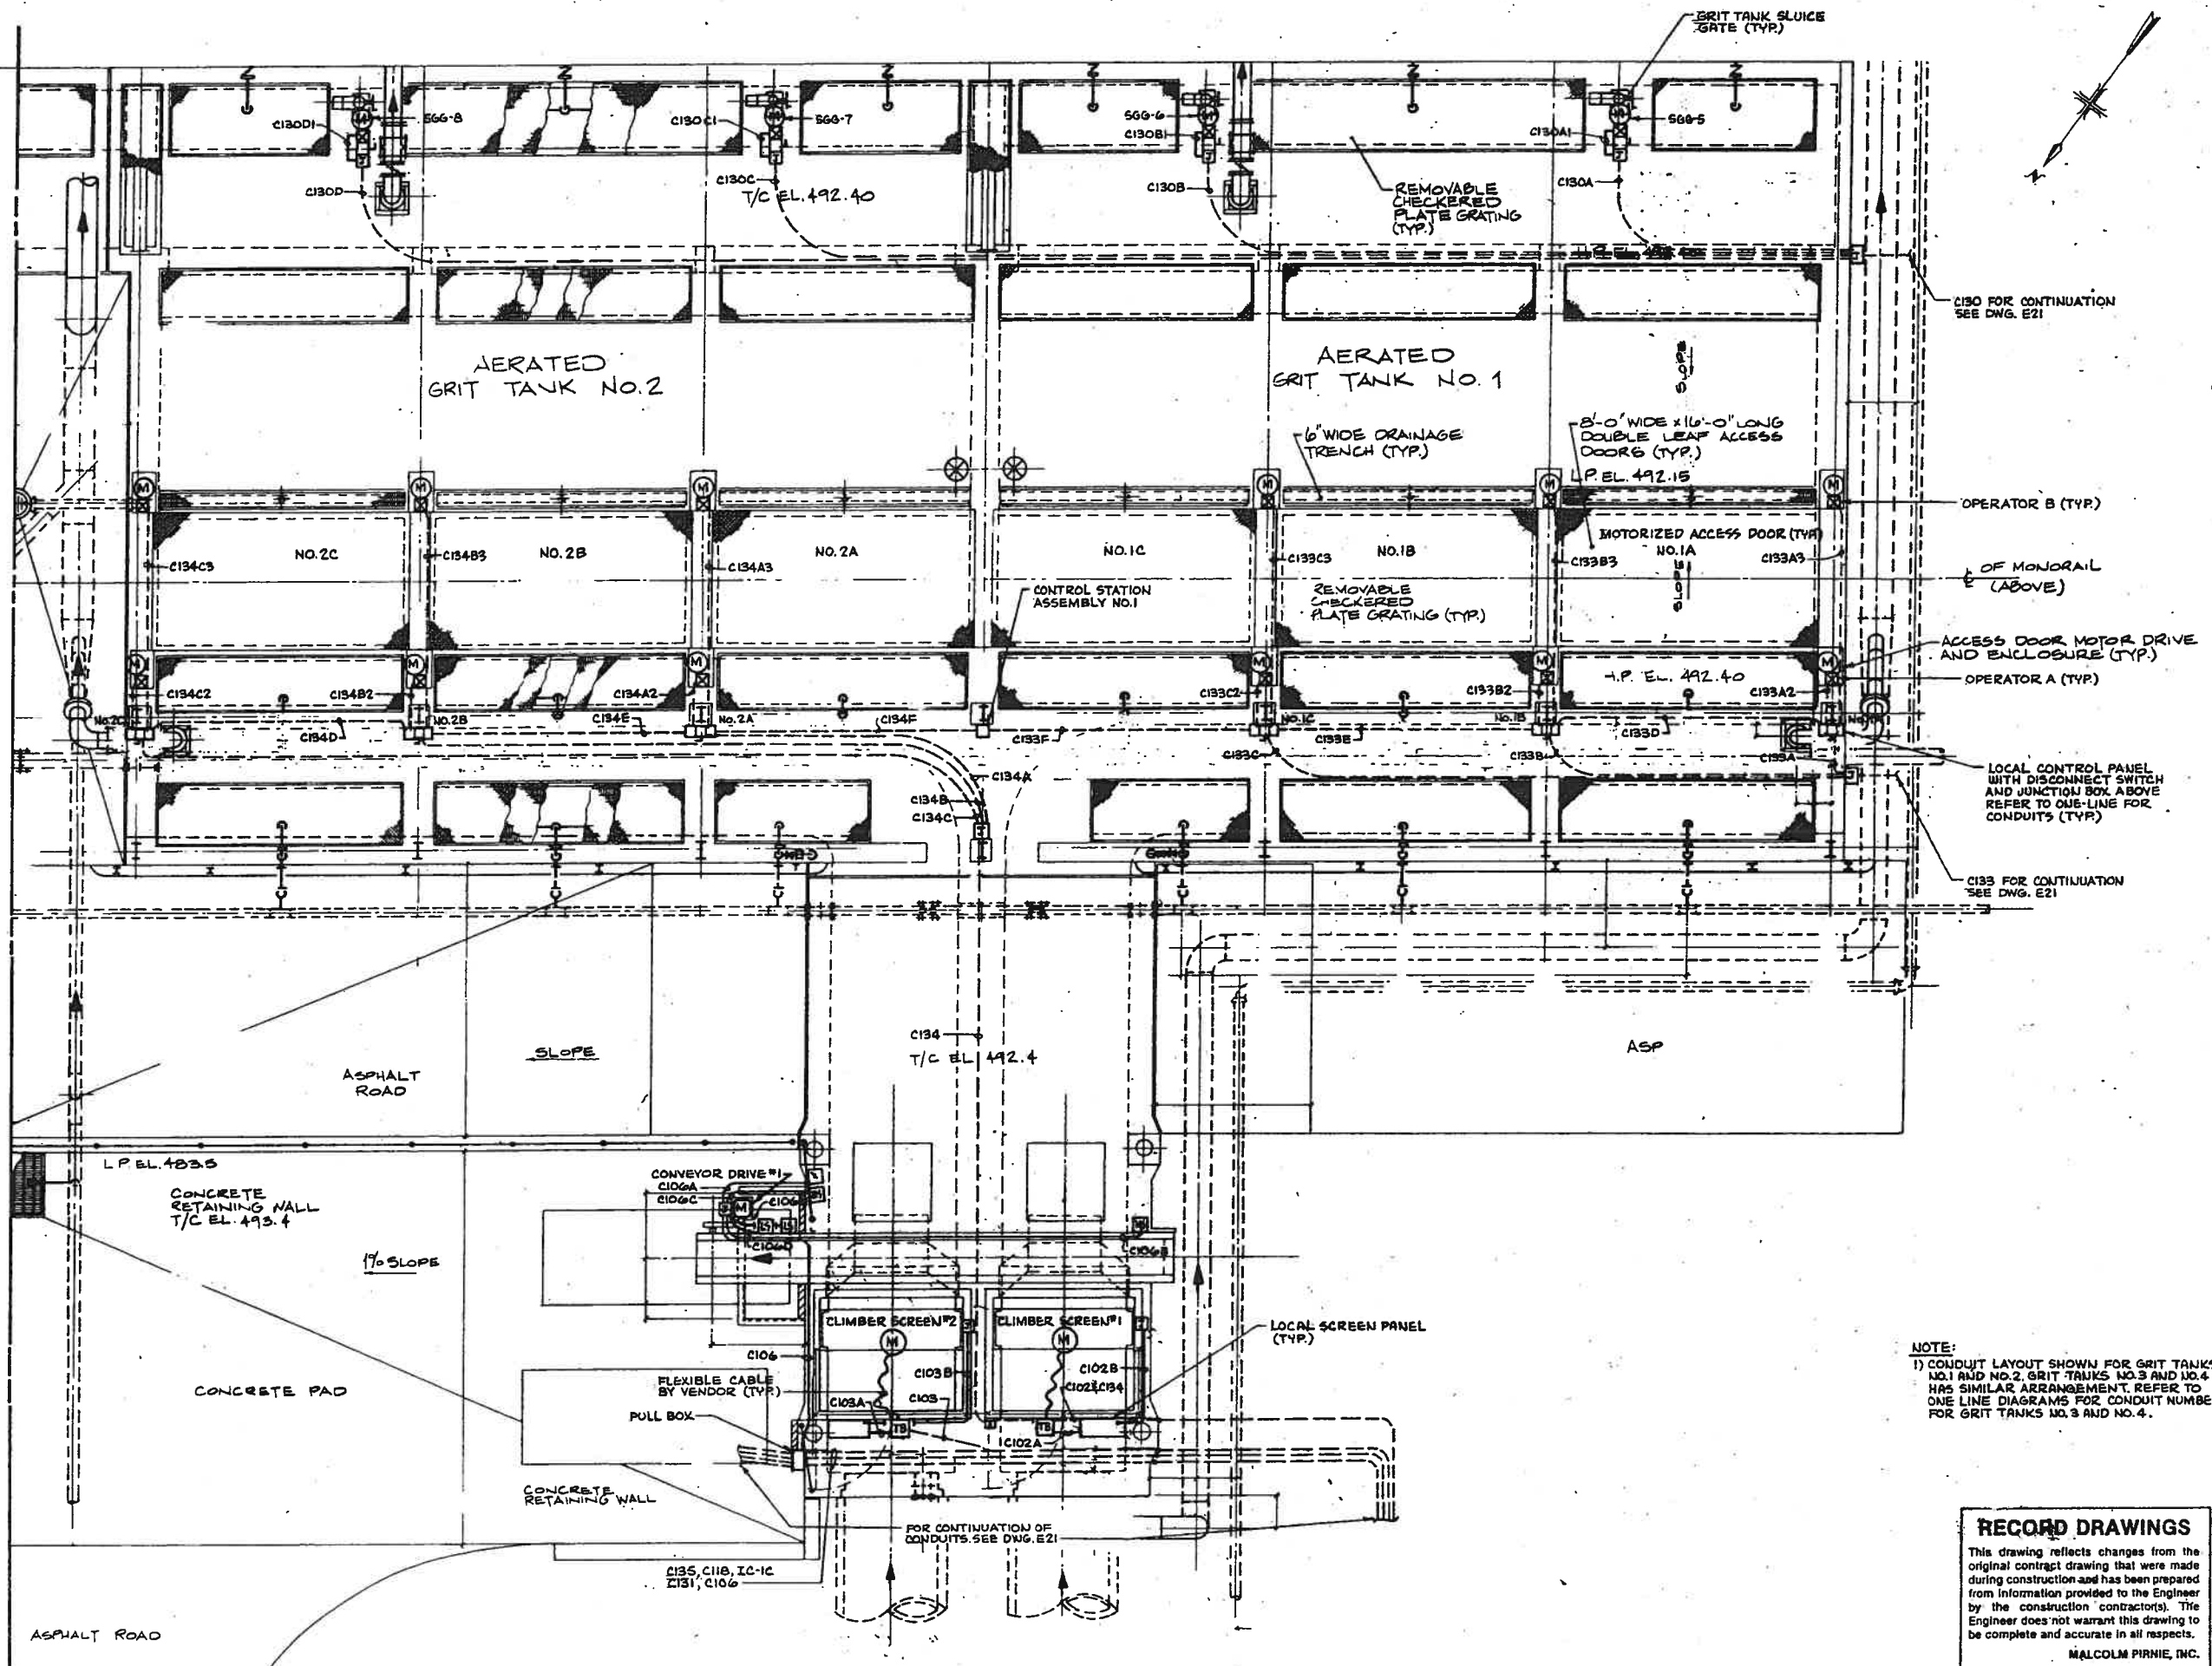


NOTE:  
 1) CONDUIT LAYOUT SHOWN FOR GRIT TANKS NO.1 AND NO.2. GRIT TANKS NO.3 AND NO.4 HAS SIMILAR ARRANGEMENT. REFER TO ONE LINE DIAGRAMS FOR CONDUIT NUMBERS FOR GRIT TANKS NO.3 AND NO.4.

**RECORD DRAWINGS**  
 This drawing reflects changes from the original contract drawing that were made during construction and has been prepared from information provided to the Engineer by the construction contractor(s). The Engineer does not warrant this drawing to be complete and accurate in all respects.  
 MALCOLM PIRNIE, INC.

Date 6/18/87 By PLM

App. No.	410N-83.256-0
Revisions	
Date	1983
Designed by	F7
Drawn by	F7
Checked by	<i>[Signature]</i>
Scale	3/16" = 1'-0"
<b>MALCOLM PIRNIE</b>	
<b>San Antonio</b>	
<b>WASTEWATER FACILITIES IMPROVEMENTS</b>	
<b>CONTRACT NO. 3</b>	
<b>DOS RIOS FACILITY SCREEN, GRIT, &amp; PREPARATION FACILITIES TYPICAL PLAN SCREEN &amp; GRIT FACILITIES POWER LAYOUT</b>	
Sheet	E-22
of	E-58

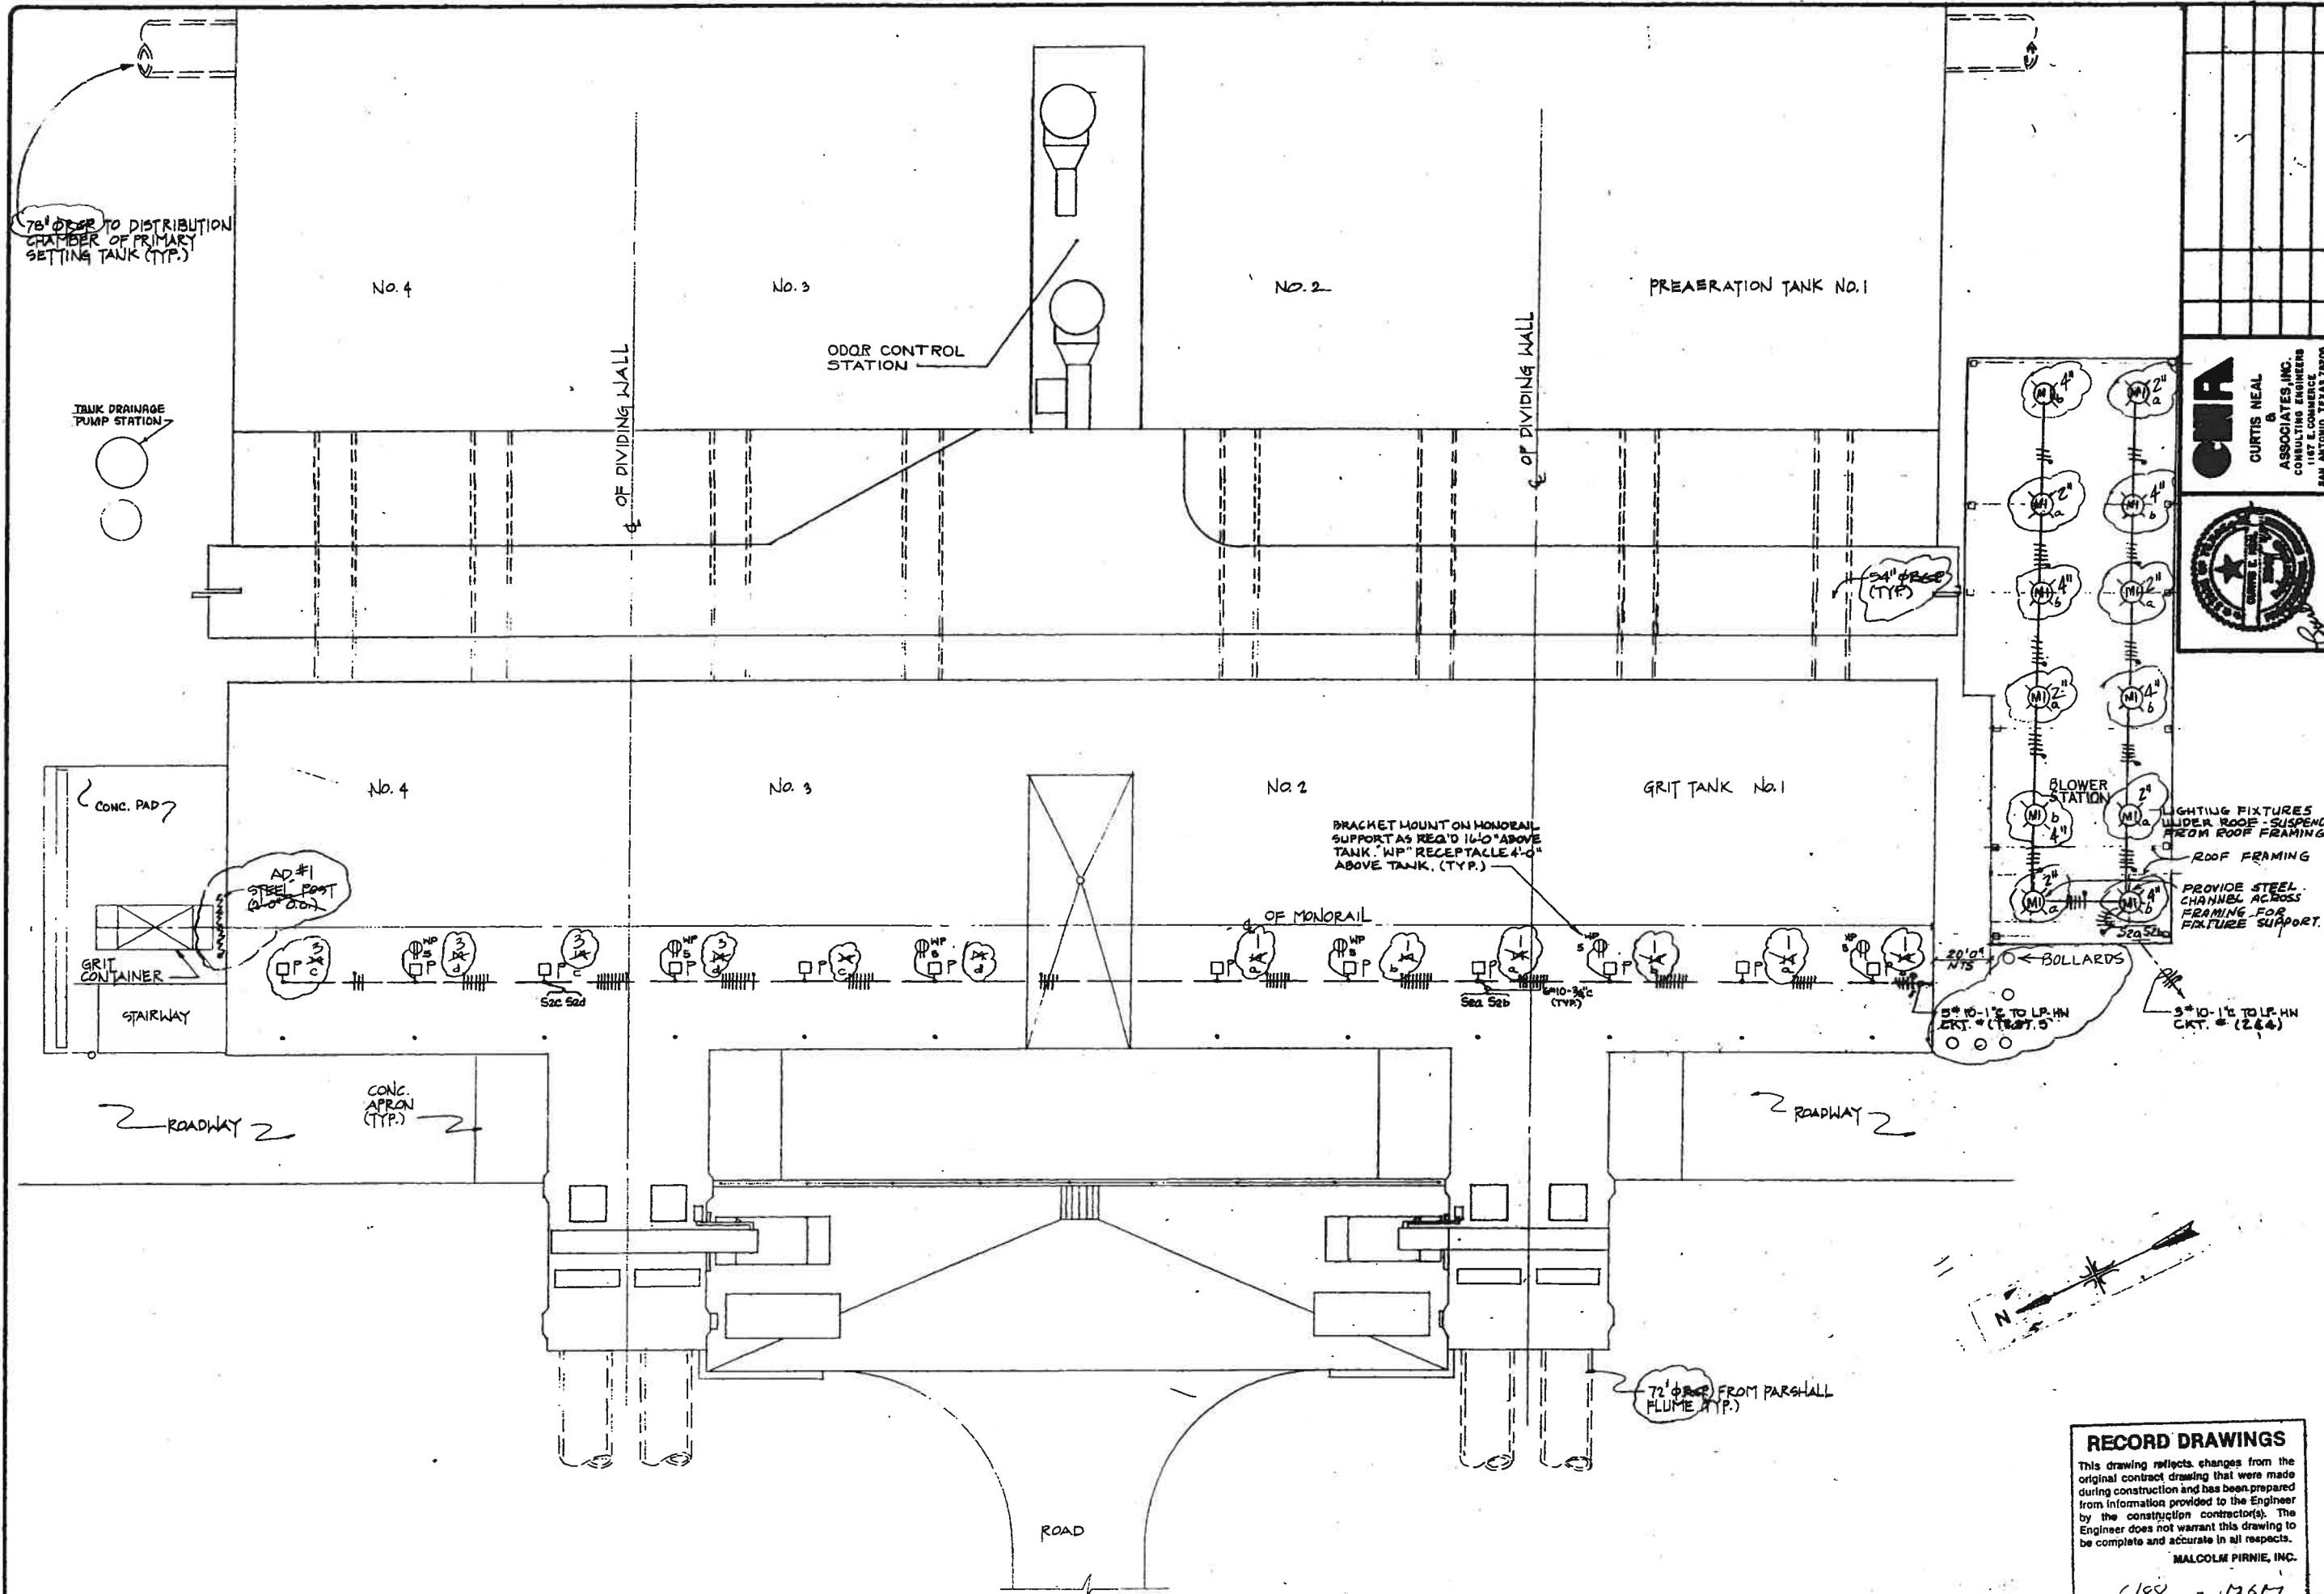


**RECORD DRAWINGS**  
 This drawing reflects changes from the original contract drawing that were made during construction and has been prepared from information provided to the Engineer by the construction contractor(s). The Engineer does not warrant this drawing to be complete and accurate in all respects.  
 MALCOLM PIRNIE, INC.  
 Date 6/84 By 17617

Drawing No 410N-83.257-0	
<b>MALCOLM PIRNIE</b>	
App.	Revisions
No.	Date
<b>CMA</b> CURTIS NEAL & ASSOCIATES, INC. CONSULTING ENGINEERS 1187 E. COMMERCE SAN ANTONIO, TEXAS 78206 Date: NOV. 1983 Designed by: K.N. Drawn by: A. MOSES Checked by: A.E. 108 Scale: 1/32" = 1'-0"	

**San Antonio**  
 WASTEWATER FACILITIES IMPROVEMENTS


CONTRACT NO. 3  
 DOS RIOS FACILITY  
 PRIMARY SETTLING TANKS  
 GRIT TANKS & BLOWER STATION -  
 LIGHTING PLAN

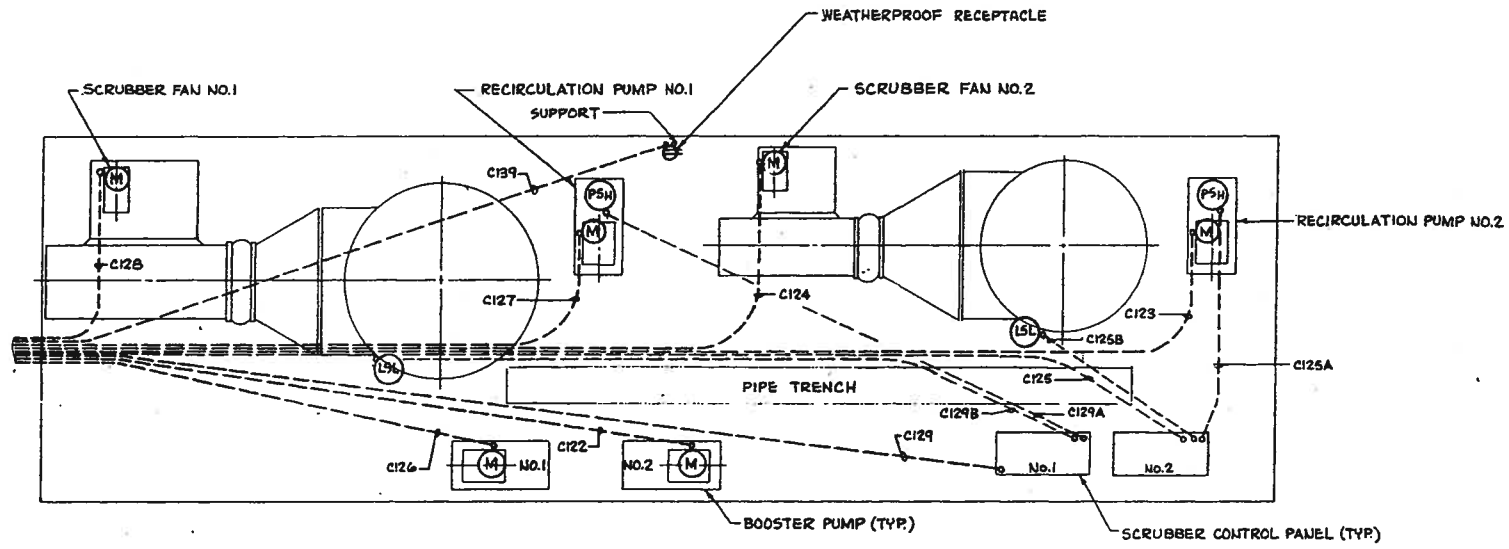

**ODOR CONTROL SYSTEM**

SCALE: 1/4"=1'-0"

NOTE: FOR CONTINUATION OF CONDUITS SEE DWG. E21

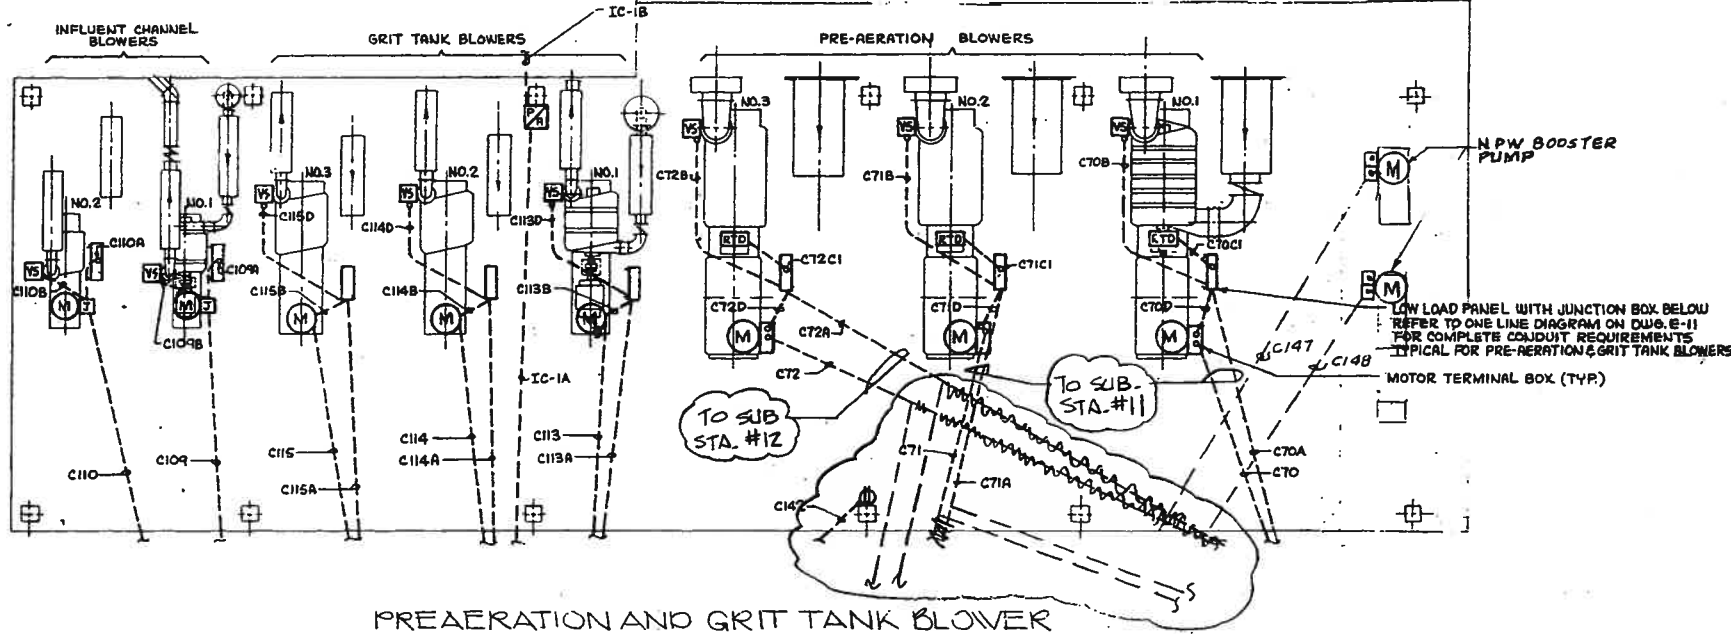

**PREAERATION AND GRIT TANK BLOWER STATION**

SCALE: 3/16"=1'-0"

NOTE: FOR CONTINUATION OF CONDUITS SEE DWG. E21

**RECORD DRAWINGS**  
 This drawing reflects changes from the original contract drawing that were made during construction and has been prepared from information provided to the Engineer by the construction contractor(s). The Engineer does not warrant this drawing to be complete and accurate in all respects.  
 MALCOLM PIRNIE, INC.  
 Date 6/88 By MGM

NO.	DATE	REVISIONS
1	NOV. 1983	AS NOTED
2	F5	
3	F5	

*[Handwritten signature]*

**WASTEWATER FACILITIES IMPROVEMENTS**

**SAN ANTONIO**

**DOS RIOS FACILITY SCREEN, GRIT, & PREAERATION FACILITIES - BLOWER & CONTROL INSTALLATIONS - POWER LAYOUT**

CONDUIT		CABLE		FROM	VIA	TO	PURPOSE	REMARKS	CONDUIT		CABLE		FROM	VIA	TO	PURPOSE	REMARKS
NO.	SIZE IN.	QTY.	SIZE						NO.	SIZE IN.	QTY.	SIZE					
C100	1-1/4	4	12	MCC-SG-1		JOB & DISC	OPERATOR SGH-2	POWER & GND									
		20	14	MCC-SG-1			JUNCTION BOX	CONTROL & IND									
		4	14	MCC-SG-1			JUNCTION BOX	INTERLOCKS	CLIMBER SCREEN								
C100A	1	4	12	JUNCTION BOX		JOB & DISC	OPERATOR SGH-1	POWER & GND									
		10	14	JUNCTION BOX			JUNCTION BOX	CONTROL & IND									
		2	14	JUNCTION BOX			JUNCTION BOX	INTERLOCKS	CLIMBER SCREEN								
C100A1	3/4	12	14	JUNCTION BOX			OPERATOR SGH-1	CONT, IND & INT									
C100B	3/4	12	14	JUNCTION BOX			OPERATOR SGH-2										
C101	1-1/4	4	12	MCC-SG-2		JOB & DISC	OPERATOR SGH-4	POWER & GND									
		20	14	MCC-SG-2			JUNCTION BOX	CONTROL & IND									
		4	14	MCC-SG-2			JUNCTION BOX	INTERLOCKS	CLIMBER SCREEN								
C101A	1	4	12	MCC-SG-2		JOB & DISC	OPERATOR SGH-3	POWER & GND									
		10	14	JUNCTION BOX			JUNCTION BOX	CONTROL & IND									
		2	14	JUNCTION BOX			JUNCTION BOX	INTERLOCKS	CLIMBER SCREEN								
C101A1	3/4	12	14	JUNCTION BOX			OPERATOR SGH-3	CONT, IND & INT									
C101B	3/4	12	14	JUNCTION BOX			OPERATOR SGH-4										
C102	1-1/4	4	12	MCC-SG-1			TERMINAL BOX	POWER & GND									
		20	14	MCC-SG-1			TERMINAL BOX	CONTROL & IND									
		3	10	MCC-SG-1			TERMINAL BOX	120 V PWR & GND									
C102A	1	18	14	TERMINAL BOX			LOCAL SCREEN PANEL	CONTROL & IND									
		3	10	TERMINAL BOX			LOCAL SCREEN PANEL	120 V PWR & GND									
C102B	3/4	8	14	LOCAL SCREEN PNL			SCREEN MTD JB	CONTROL	LIMIT SWITCHES								
C103	1-1/4	4	12	MCC-SG-1			TERMINAL BOX	POWER & GND									
		20	14	MCC-SG-1			TERMINAL BOX	CONTROL & IND									
		3	10	MCC-SG-1			TERMINAL BOX	120 V PWR & GND									
C103A	1	18	14	TERMINAL BOX			LOCAL SCREEN PANEL	CONTROL & IND									
		3	10	TERMINAL BOX			LOCAL SCREEN PANEL	120 V PWR & GND									
C103B	3/4	8	14	LOCAL SCREEN PNL			SCREEN MTD JB	CONTROL	LIMIT SWITCHES								
C104	1-1/4	4	12	MCC-SG-2			TERMINAL BOX	POWER & GND									
		20	14	MCC-SG-2			TERMINAL BOX	CONTROL & IND									
		3	10	MCC-SG-2			TERMINAL BOX	120 V PWR & GND									
C104A	1-1/4	3	8	MCC-SG-2			TERMINAL BOX	120 V PWR & GND	FROM LP-HW								
		3	8	TERMINAL BOX			LOCAL SCREEN PANEL	CONTROL & IND									
		3	8	TERMINAL BOX			LOCAL SCREEN PANEL	120 V PWR & GND									
C104B	3/4	8	14	LOCAL SCREEN PNL			SCREEN MTD JB	CONTROL	LIMIT SWITCHES								
C105	1-1/4	4	12	MCC-SG-2			TERMINAL BOX	POWER & GND									
		20	14	MCC-SG-2			TERMINAL BOX	CONTROL & INC									
		3	8	MCC-SG-2			TERMINAL BOX	120 V PWR & GND	FROM LP-HW								
C105A	1-1/4	18	14	TERMINAL BOX			LOCAL SCREEN PANEL	CONTROL & IND									
		3	8	TERMINAL BOX			LOCAL SCREEN PANEL	120 V PWR & GND									
C105B	3/4	8	14	LOCAL SCREEN PNL			SCREEN MTD JB	CONTROL	LIMIT SWITCHES								
C106	3/4	4	12	MCC-SG-1		JUNCTION BOX	CONVEYOR DRIVE 1	POWER & GND									
		8	14	MCC-SG-1		JUNCTION BOX	JUNCTION BOX	CONTROL & IND									
C106A	3/4	3	14	JUNCTION BOX			CONTROL STATION	CONTROL									
C106B	3/4	3	14	JUNCTION BOX			MOTION SWITCH	CONTROL									
C106C	3/4	2	14	JUNCTION BOX			PULL-CORD-STOP	CONTROL									
C106D	3/4	2	14	JUNCTION BOX			GUARD LIMIT SW	CONTROL									
C106E	3/4	2	14	JUNCTION BOX			BELT LIMIT SW	CONTROL									
C107	3/4	4	12	MCC-SG-2		JUNCTION BOX	CONVEYOR DRIVE 2	POWER & GND									
		8	14	MCC-SG-2		JUNCTION BOX	JUNCTION BOX	CONTROL & IND									
C107A	3/4	3	14	JUNCTION BOX			CONTROL STATION	CONTROL									
C107B	3/4	3	14	JUNCTION BOX			MOTION SWITCH	CONTROL									
C107C	3/4	2	14	JUNCTION BOX			PULL-CORD-STOP	CONTROL									
C107D	3/4	2	14	JUNCTION BOX			GUARD LIMIT SW	CONTROL									
C107E	3/4	2	14	JUNCTION BOX			BELT LIMIT SW	CONTROL									
C108	3/4	2	14	MCC-SG-2		JUNCTION BOX	INF BLOWER MOTOR 1	POWER & GND									
		4	10	MCC-SG-2		JUNCTION BOX	JUNCTION BOX	CONTROL									
		12	14	MCC-SG-1		JUNCTION BOX	JUNCTION BOX	CONTROL									
C109A	3/4	1	14	JUNCTION BOX		JOB & DISC	LOCAL LOW-LOAD PANEL	CONTROL									
C109B	3/4	3	14	JUNCTION BOX		JOB & DISC	VIBRATION SWITCH	CONTROL									
C110	1	4	10	MCC-SG-2		JUNCTION BOX	INF BLOWER MOTOR 2	POWER & GND									
		12	14	MCC-SG-2		JUNCTION BOX	JUNCTION BOX	CONTROL									
		3	14	MCC-SG-2		JUNCTION BOX	JUNCTION BOX	CONTROL									
C110A	3/4	1	14	JUNCTION BOX		JOB & DISC	LOCAL LOW-LOAD PANEL	CONTROL									
C110B	3/4	3	14	JUNCTION BOX		JOB & DISC	VIBRATION SWITCH	CONTROL									
C113	1-1/2	3	1/0	MCC-SG-1			GRIT BLOWER MOTOR 1	POWER									
		5	5	MCC-SG-1			GRIT BLOWER MOTOR 1	GND									
C113A	3/4	1	14	MCC-SG-1			JUNCTION BOX	CONTROL									
C113B	3/4	4	14	JUNCTION BOX			MOTOR	CONTROL									
C113C	3/4	1	14	JUNCTION BOX			LOCAL LOW-LOAD PANEL	CONTROL									
C113D	3/4	3	14	JUNCTION BOX			VIBRATION SWITCH	CONTROL									
C114	1-1/2	3	1/0	MCC-SG-2			GRIT BLOWER MOTOR 2	POWER									
		5	5	MCC-SG-2			GRIT BLOWER MOTOR 2	GND									
C114A	3/4	1	14	MCC-SG-2			JUNCTION BOX	CONTROL									
C114B	3/4	1	14	JUNCTION BOX			MOTOR	CONTROL									
C114C	3/4	1	14	JUNCTION BOX			LOCAL LOW-LOAD PANEL	CONTROL									
C114D	3/4	3	14	JUNCTION BOX			VIBRATION SWITCH	CONTROL									
C115	1-1/2	3	1/0	MCC-SG-1			GRIT BLOWER MOTOR 3	POWER									

**RECORD DRAWINGS**  
 This drawing reflects changes from the original contract drawing that were made during construction and has been prepared from information provided to the Engineer by the construction contractor. The Engineer does not warrant this drawing to be complete and accurate in all respects.  
 MALCOLM PIRNIE, INC.  
 Date 4/88 By 1962

Revisions

No. Date

NO SCALE

DESIGNED BY: FS  
 DRAWN BY: MEH  
 CHECKED BY: [Signature]  
 DATE: NOV 1983

WATERBURY FACILITIES IMPROVEMENTS

SAN ANTONIO

CONTRACT NO. 3

DOS RIOS FACILITY SCREEN, GRIT & PREARATION FACILITIES CONDUIT & CABLE SCHEDULE

Sheet F-25 of F-58

DR 83-6502

CONDUIT		CABLE		FROM	VIA	TO	PURPOSE	REMARKS	CONDUIT		CABLE		FROM	VIA	TO	PURPOSE	REMARKS
NO.	SIZE IN.	QTY.	SIZE						NO.	SIZE IN.	QTY.	SIZE					
C133A3	3/4	3	12	LOCAL PANEL #1A		OPERATOR B	POWER		C136A1	3/4	6	14	JUNCTION BOX		LOCAL CONTROL PANEL 4A	IND	
		6	14	LOCAL PANEL #1A		OPERATOR B	CONTROL	LIMIT SW	C136A2	3/4	3	12	LOCAL PANEL 4A		OPERATOR A	POWER	
C133B	3/4	4	12	JUNCTION BOX	JB & DISC	LOCAL CONTROL PANEL 1B	POWER & GND				6	14	LOCAL PANEL 4A		OPERATOR A	CONTROL	LIMIT SW
		6	14	JUNCTION BOX		JUNCTION BOX	IND		C136A3	3/4	3	12	LOCAL PANEL 4A		OPERATOR B	POWER	
C133B1	3/4	6	14	JUNCTION BOX		LOCAL CONTROL PANEL 1B	IND				6	14	LOCAL PANEL 4A		OPERATOR B	CONTROL	LIMIT SW
C133B2	3/4	3	12	LOCAL PANEL #1B		OPERATOR A	POWER		C136B	3/4	4	12	JUNCTION BOX	JB & DISC	LOCAL CONTROL PANEL 4B	POWER & GND	
		6	14	LOCAL PANEL #1B		OPERATOR A	CONTROL	LIMIT SW			6	14	JUNCTION BOX		JUNCTION BOX	IND	
C133B3	3/4	3	12	LOCAL PANEL #1B		OPERATOR B	POWER		C136B1	3/4	6	14	JUNCTION BOX		LOCAL CONTROL PANEL 4B	IND	
		6	14	LOCAL PANEL #1B		OPERATOR B	CONTROL	LIMIT SW	C136B2	3/4	3	12	LOCAL PANEL 4B		OPERATOR A	POWER	
C133C	3/4	4	12	JUNCTION BOX	JB & DISC	LOCAL CONTROL PANEL 1C	POWER & GND				6	14	LOCAL PANEL 4B		OPERATOR A	CONTROL	LIMIT SW
C133C1	3/4	6	14	JUNCTION BOX		JUNCTION BOX	IND		C136B3	3/4	3	12	LOCAL PANEL 4B		OPERATOR B	POWER	
C133C2	3/4	3	12	LOCAL PANEL #1C		LOCAL CONTROL PANEL 1C	IND				6	14	LOCAL PANEL 4B		OPERATOR B	CONTROL	LIMIT SW
		6	14	LOCAL PANEL #1C		OPERATOR A	POWER		C136C	3/4	4	12	JUNCTION BOX	JB & DISC	LOCAL CONTROL PANEL 4C	POWER & GND	
C133C3	3/4	3	12	LOCAL PANEL #1C		OPERATOR A	CONTROL	LIMIT SW			6	14	JUNCTION BOX		JUNCTION BOX	IND	
		6	14	LOCAL PANEL #1C		OPERATOR B	POWER		C136C1	3/4	6	14	JUNCTION BOX		LOCAL CONTROL PANEL 4C	IND	
C133D	3/4	6	14	LOCAL PANEL #1A		LOCAL PANEL 1B	CONTROL	LIMIT SW	C136C2	3/4	3	12	LOCAL PANEL 4C		OPERATOR A	POWER	
C133E	3/4	12	14	LOCAL PANEL #1B		LOCAL PANEL 1C	CONTROL				6	14	LOCAL PANEL 4C		OPERATOR A	CONTROL	LIMIT SW
C133F	1	18	14	LOCAL PANEL #1C		CONTROL STA ASSEMBLY #1	CONTROL		C136C3	3/4	3	12	LOCAL PANEL 4C		OPERATOR B	POWER	
C134	1	4	12	MCC-SG-1		JUNCTION BOX	POWER & GND				6	14	LOCAL PANEL 4C		OPERATOR B	CONTROL	LIMIT SW
		18	14	MCC-SG-1		JUNCTION BOX	INDICATION		C136D	3/4	6	14	LOCAL PANEL 4C		LOCAL PANEL 4B	CONTROL	
C134A	3/4	4	12	JUNCTION BOX	JB & DISC	LOCAL CONTROL PANEL 2A	POWER & GND		C136E	3/4	12	14	LOCAL PANEL 4B		LOCAL PANEL 4A	CONTROL STA ASSEMBLY #2	
		6	14	JUNCTION BOX		JUNCTION BOX	IND		C136F	1	18	14	LOCAL PANEL 4A		MCC-SG-2 (LP-HW)	FLOW TRANSMITTER COMP. SAMPLE	120V (4) SPARE
C134A1	3/4	6	14	JUNCTION BOX		LOCAL CONTROL PANEL 2A	IND		C137	3/4	8x5	12	MCC-SG-2 (LP-HW)		FLOW TRANSMITTER	SIGNAL	(1) SPARE
C134A2	3/4	3	12	LOCAL PANEL 2A		OPERATOR A	POWER		C138	3/4	2-2/C	18(SH)	MCC-SG-1		RECEPTACLE AT ODOR PAD	POWER & GND	120V
		6	14	LOCAL PANEL 2A		OPERATOR A	CONTROL	LIMIT SW	C139	3/4	3	8	MCC-SG-2 (LP-HW)		PP-SMS-HP	POWER & GND	AT SMS
C134A3	3/4	3	12	LOCAL PANEL 2A		OPERATOR B	POWER		C140	1	3	4	MCC-SG-2		PP-SMS-HP	POWER	
		6	14	LOCAL PANEL 2A		OPERATOR B	CONTROL	LIMIT SW	C141	2	3	8	MCC-SG-1		PP-SMS-HP	GND	
C134B	3/4	4	12	JUNCTION BOX	JB & DISC	LOCAL CONTROL PANEL 2B	POWER & GND		C142	3/4	3	10	MCC-SG-1		PP-HV-SWG	POWER	
		6	14	JUNCTION BOX		JUNCTION BOX	IND				1	10	MCC-SG-1		PP-HV-SWG	GND	
C134B1	3/4	6	14	JUNCTION BOX		LOCAL CONTROL PANEL 2B	IND		C143	1	-	-	MCC-SG-1		BLOWER PAD RECEPTACLE	120V PWR & GND	
C134B2	3/4	3	12	LOCAL PANEL 2B		OPERATOR A	POWER		C144	1	-	-	MCC-SG-1		132 KV SWGR	FUT I/O	
		6	14	LOCAL PANEL 2B		OPERATOR A	CONTROL	LIMIT SW	C145	2	-	-	MCC-SG-1		SUB #12 TRAN COMP	FUT I/O	
C134B3	3/4	3	12	LOCAL PANEL 2B		OPERATOR B	POWER		C146	2	-	-	SMS-DIGM		SMS-HP	FUT I/O	
		6	14	LOCAL PANEL 2B		OPERATOR B	CONTROL	LIMIT SW	C146A	2	-	-	SMS-DIGM		SMS-HP	FUT - PC	
C134C	3/4	4	12	JUNCTION BOX	JB & DISC	LOCAL CONTROL PANEL 2C	POWER & GND		C146B	2	-	-	SMS-HP		EHH #4	FUT CMS	
		6	14	JUNCTION BOX		JUNCTION BOX	IND		C146C	2	-	-	SMS-HP		EHH #4	FUT CMS	
C134C1	3/4	6	14	JUNCTION BOX		LOCAL CONTROL PANEL 2C	IND										
C134C2	3/4	3	12	LOCAL PANEL 2C		OPERATOR A	POWER										
		6	14	LOCAL PANEL 2C		OPERATOR A	CONTROL	LIMIT SW									
C134C3	3/4	3	12	LOCAL PANEL 2B		OPERATOR B	POWER										
		6	14	LOCAL PANEL 2B		OPERATOR B	CONTROL	LIMIT SW									
C134D	3/4	6	14	LOCAL PANEL 2C		LOCAL PANEL 2B	CONTROL										
C134E	3/4	12	14	LOCAL PANEL 2B		LOCAL PANEL 2A	CONTROL										
C134F	1	18	14	LOCAL PANEL 2A		CONTROL STA ASSEMBLY #1	CONTROL										
C135	1	4	12	MCC-SG-2		JUNCTION BOX	POWER & GND										
		18	14	MCC-SG-2		JUNCTION BOX	IND										
C135A	3/4	4	12	JUNCTION BOX	JB & DISC	LOCAL CONTROL PANEL 3A	POWER & GND										
		6	14	JUNCTION BOX		JUNCTION BOX	IND										
C135A1	3/4	6	14	JUNCTION BOX		LOCAL CONTROL PANEL 3A	IND										
C135A2	3/4	3	12	LOCAL PANEL 3A		OPERATOR A	POWER										
		6	14	LOCAL PANEL 3A		OPERATOR A	CONTROL	LIMIT SW									
C135A3	3/4	3	12	LOCAL PANEL 3A		OPERATOR B	POWER										
		6	14	LOCAL PANEL 3A		OPERATOR B	CONTROL	LIMIT SW									
C135B	3/4	4	12	JUNCTION BOX	JB & DISC	LOCAL CONTROL PANEL 3B	POWER & GND										
		6	14	JUNCTION BOX		JUNCTION BOX	IND										
C135B1	3/4	6	14	JUNCTION BOX		LOCAL CONTROL PANEL 3B	IND										
C135B2	3/4	3	12	LOCAL PANEL 3B		OPERATOR A	POWER										
		6	14	LOCAL PANEL 3B		OPERATOR A	CONTROL	LIMIT SW									
C135B3	3/4	3	12	LOCAL PANEL 3B		OPERATOR B	POWER										
		6	14	LOCAL PANEL 3B		OPERATOR B	CONTROL	LIMIT SW									
C135C	3/4	4	12	JUNCTION BOX	JB & DISC	LOCAL CONTROL PANEL 3C	POWER & GND										
		6	14	JUNCTION BOX		JUNCTION BOX	IND										
C135C1	3/4	6	14	JUNCTION BOX		LOCAL CONTROL PANEL 3C	IND										
C135C2	3/4	3	12	LOCAL PANEL 3C		OPERATOR A	POWER										
		6	14	LOCAL PANEL 3C		OPERATOR A	CONTROL	LIMIT SW									
C135C3	3/4	3	12	LOCAL PANEL 3C		OPERATOR B	POWER										
		6	14	LOCAL PANEL 3C		OPERATOR B	CONTROL	LIMIT SW									
C135D	3/4	6	14	LOCAL PANEL 3A		LOCAL PANEL 3B	CONTROL										
C135E	3/4	12	14	LOCAL PANEL 3B		LOCAL PANEL 3C	CONTROL										
C135F	1	18	14	LOCAL PANEL 3C		CONTROL STA ASSEMBLY #2	CONTROL										
C136	1	4	12	MCC-SG-2		JUNCTION BOX	POWER & GND										
		18	14	MCC-SG-2		JUNCTION BOX	IND										
C136A	3/4	4	12	JUNCTION BOX	JB & DISC	LOCAL CONTROL PANEL 4A	POWER & GND										
		6	14	JUNCTION BOX		JUNCTION BOX	IND										

C141-1  
C147A  
C148-1

CONDUIT: "4-12" (SLO, PS & SPACE REQ.)  
CABLE: "4-10" (SLO, PS & SPACE REQ.)  
PURPOSE: "POWER & GND CONTROL"  
REMARKS: "IN STOP CTR."

**RECORD DRAWINGS**

This drawing reflects changes from the original contract drawing that were made during construction and has been prepared from information provided to the Engineer by the construction contractor(s). The Engineer does not warrant this drawing to be complete and accurate in all respects.

MALCOLM PIRNIE, INC.

Date: 6/88 By: HGM

App. Drawing No. 410N-83.260-0

Revisions

Date

No.

Date

NO SCALE

DESIGNED BY: FS  
DRAWN BY: MEH  
CHECKED BY: J. G. ...  
SCALE:

STATE OF TEXAS  
REGISTERED ELECTRICAL ENGINEER  
MALCOLM PIRNIE, INC.

WESTBOROUGH  
MASSACHUSETTS  
IMPROVEMENTS

SAN ANTONIO

CONTRACT NO. 3  
DOS RIOS FACILITY  
SCREEN, GRIT &  
PREARATION FACILITIES  
CONDUIT & CABLE SCHEDULE

Sheet E-26 of E-58