



Evans Ground Storage Tank Rehabilitation Project - RFCSP
Solicitation Number: CO-00510
Job No.: 20-0130

ADDENDUM 1
April 25, 2022

To Bidder of Record:

This addendum, applicable to work referenced above, is an amendment to the bid proposal, plans and specifications and as such will be a part of and included in the Contract Documents. Acknowledge receipt of this addendum by entering the Addendum number and issue date on the space provided in submitted copies of the bid proposal.

| |
|-------------------------------|
| RESPONSES TO QUESTIONS |
|-------------------------------|

1. I have reviewed the generic drawings that you have posted on your site “SAWS Construction Specifications Review”, specifically:

ITEM NO. 845 Gate, Fencing and Property Marker Details

We have been working with SAWS and are the basis of design for your Cantilever Slide Gates. We are thrilled to work with you and thank you for your specification.

We have seen some changes over the years to the generic drawings posted and do have some updates and some concerns.

Updates:

- 1. Drawing is Labeled Heavy Duty Cantilever Slide Gate**
 - a. Detail is for a Structural Cantilever Slide Gate**
- 2. 3/16” Stainless Steel Cables.**
 - a. Current gate utilizes ¼” Galvanized Steel Cables. (This is an upgrade which offers more stability)**

Concerns:

- 3. Changes have been made to our Gate Design which will void the warranty.**
 - a. Add 2” Bracing Poles to the counterbalance.**
 - i. By adding the Bracing Poles, it takes away the ability to adjust the gate back to plumb. The inability to adjust back to plumb will eventually cause the gate to bind and could damage the gate itself and the operator (if operated).**

I have attached a revised drawing for our Structural Cantilever with the noted changes made.

I would like to discuss this with you at your convenience. We appreciate the specification of our Cantilever Slide Gates for all your projects and thank you for your time and consideration.

Response: Cantilever slide gates are not included in this project.

2. **We received this project today and we are not listed as an Approved Lightning Protection Manufacturer. I have attached an approval letter about our company. Our websites are listed in the letter where you may view our products and services. We would like to be listed as an Approved Lightning Protection Manufacturer on this project and future projects. If you have received this request in error, please forward**

Response: The General Contractor will be required to bid the project per the manufacturers listed in the Specifications. SAWS may evaluate all proposed materials and products not currently found in the project Specifications after the contract has been awarded. Manufacturers may request to be approved providers by completing the documentation needed to submit to the SAWS Product Submittal Committee. Please go to: https://apps.saws.org/business_center/specs/product_submittal/ and submit the required form in order to start the process to have your product evaluated to be included on future projects.

3. **Can a preproposal site visit be conducted?**

Response: No preproposal site visit will be conducted.

4. **Section 01560 1.03 says on sites where chemicals are present an armed security guard shall be present while work is performed? Are chemicals present onsite to where this will apply?**

Response: No chemicals will be present onsite; therefore, no security guard will be required.

5. **Sheet S-4 and detail 5/T-2 shows the center hatch to be covered with a plate but detail 2/T-1 states to replace with a 36x42 hatch. Please clarify.**

Response: The center hatch is to be removed and replaced with a cover plate. See item 1 under “Changes to the Plans”.

CHANGES TO THE SPECIFICATIONS

1. **Amend Page SIR-5, Supplementary Instructions to Respondents as follows:**
 - a. In Paragraph 2.a.ii, replace first bullet point “If Respondent has SAWS experience, at a minimum, one (1) SAWS project of similar size, scope, and complexity must be included in the list of three (3) projects provided, and” with “If Respondent has SAWS experience, at a minimum, one (1) SAWS project of similar size, scope, and complexity must be included in the list of three (3) projects provided.”
2. **Amend Page EV-14, Evaluation Criteria as follows:**
 - a. In Paragraph 2.a.ii, replace first bullet point “If Respondent has SAWS experience, at a minimum, one (1) SAWS project of similar size, scope, and complexity must be included in the list of three (3) projects provided, and” with “If Respondent has SAWS experience, at a minimum, one (1) SAWS project of similar size, scope, and complexity must be included in the list of three (3) projects provided.”

CHANGES TO THE PLANS

1. **Remove and replace plan sheet T-1 “Tank Exterior Improvements I” in its entirety.**

CLARIFICATIONS

1. None

END OF ADDENDUM 1

This Addendum is four (4) pages in its entirety, with one (1) attachment.

Attachments:

1. Plan Sheet T-1 "Tank Exterior Improvements I" (1 page)

Ryan Ramsey, P.E.
Freese and Nichols, Inc.



FREESE AND NICHOLS, INC.
TEXAS REGISTERED
ENGINEERING FIRM
F-2144



1 T-1 TANK AERIAL
NTS




2 T-1 TANK AERIAL
NTS




3 T-1 LEVEL TRANSMITTER
NTS



4 T-1 FLANGED OUTLETS
NTS

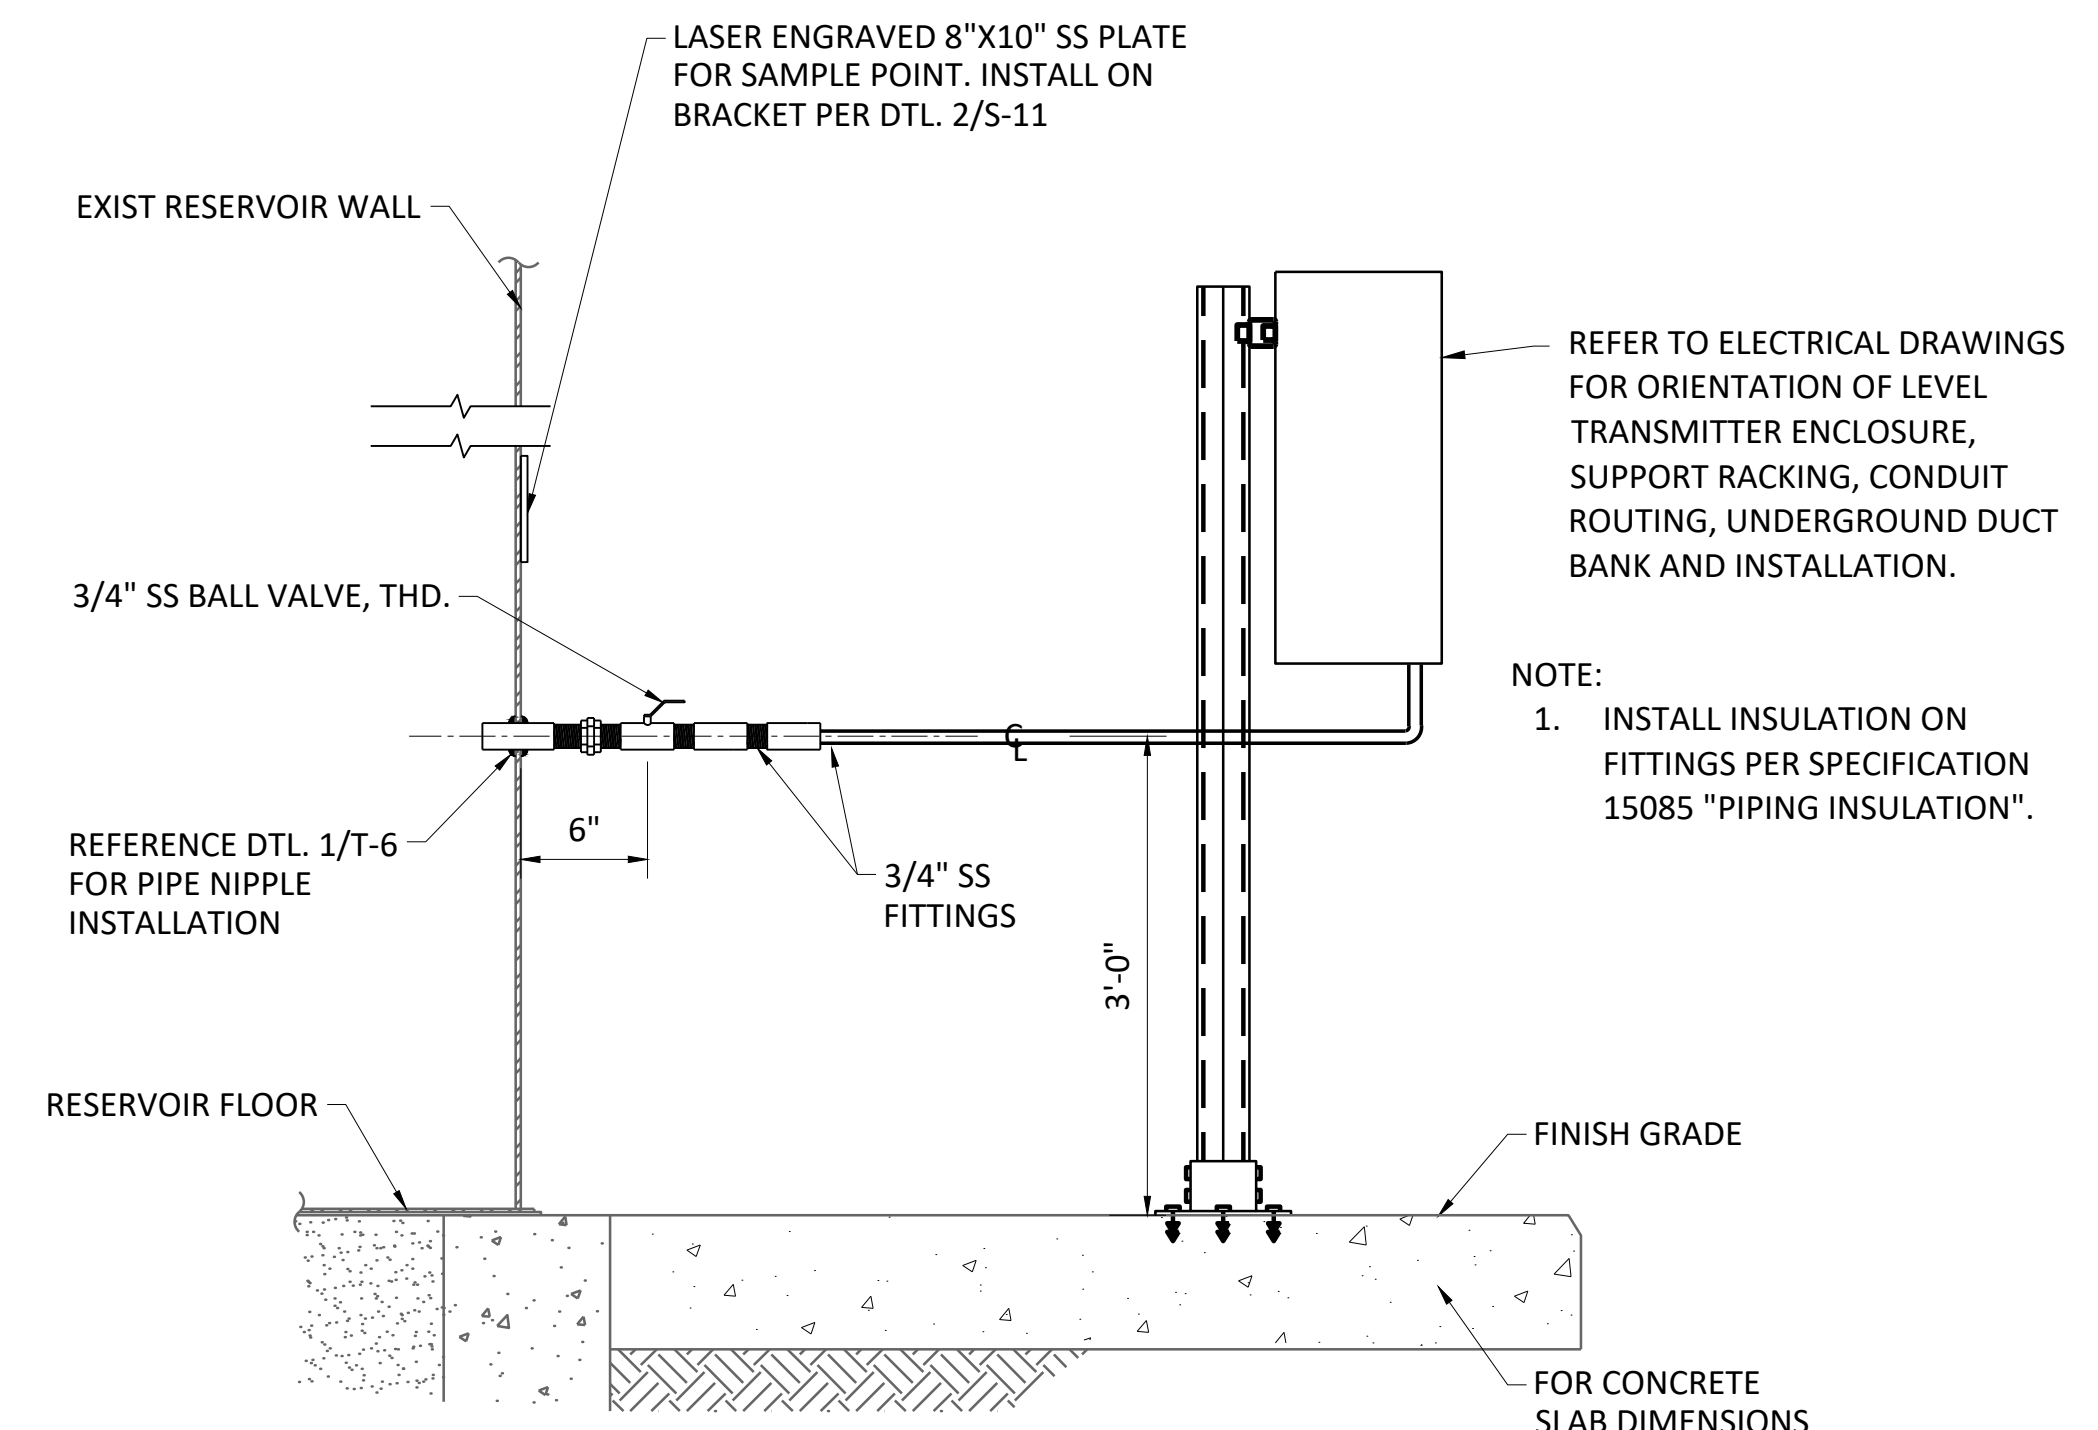

5 T-1 LEVEL TRANSMITTER DETAIL
NTS

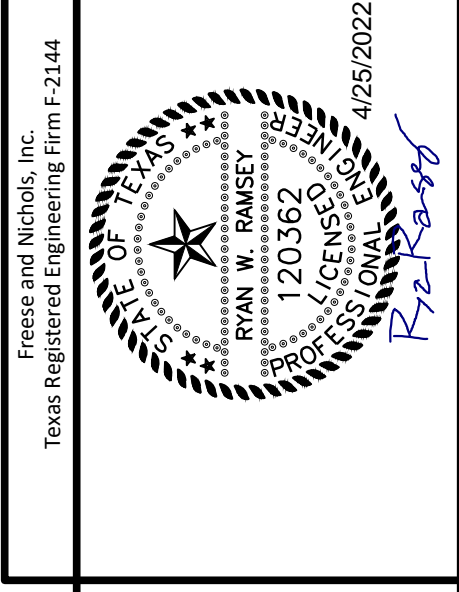

Freese and Nichols, Inc.
 Texas Registered Engineering Firm F-3144

FREES & NICHOLS
 9001 McAllister Freeway, Suite 1008
 San Antonio, Texas 78216
 Phone - (210) 298-3800
 Web - www.freese.com

SAN ANTONIO WATER SYSTEM
EVANS GROUND STORAGE TANK REHABILITATION
 TANK
TANK EXTERIOR IMPROVEMENTS I

| | | | | | | | | |
|----------------|-------|------------|----|----------|-------|---------|---------|-----|
| NO. | ISSUE | DATE | BY | DESIGNED | DRAWN | REVISOR | CHECKED | CAK |
| | | 4/25/2022 | | RWR | CIG | | | |
| ADDENDUM NO. 1 | | 04/25/2022 | RR | | | | | |
| VERIFY SCALE | | | | | | | | |
| 0 | | | | | | | | |

Bar is one inch on original drawing. If not one inch on this sheet, adjust scale.

FILE NAME: WTU-EVANS-DT-MISC13.dwg

ISSUE FOR BID

SHEET T-1
 SEQ.