



**Micron PS Well Pump No. 4**  
**Solicitation Number: CO-00347-FG**  
**Job No.: 19-6011**

**ADDENDUM #3**  
**July 30, 2020**

To Bidder of Record:

This addendum, applicable to work referenced above, is an amendment to the bid proposal, plans and specification and such will be a part of and included in the Contract Documents. Acknowledge receipt of this addendum by entering the Addendum number and issue date on the space provided in submitted copies of the bid proposal.

**CHANGES TO PLANS**


1. Sheet C-11.0 WELL NO. 4 – WELL DISCHARGE PIPING DETAILS
  - a. Remove and replace this sheet in its entirety with the attached Sheet C-11.0.

**END OF ADDENDUM #3**



This Addendum is 2 pages in its entirety to include attachments.

Attachments:

Revised Micron Pump Station Well Pump No. 4 Plan Sheet C-11.0 (1 page)

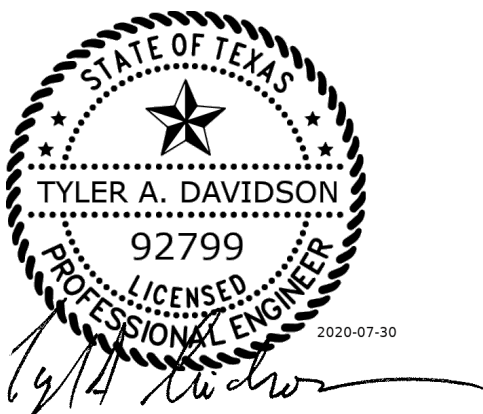

ACAD Rel: 23.0s (LMS Tech)  
 Filename: N:\WW\WW-DET-MISC.dwg  
 Last Saved: 7/29/2020 3:02 PM Saved By: 02651

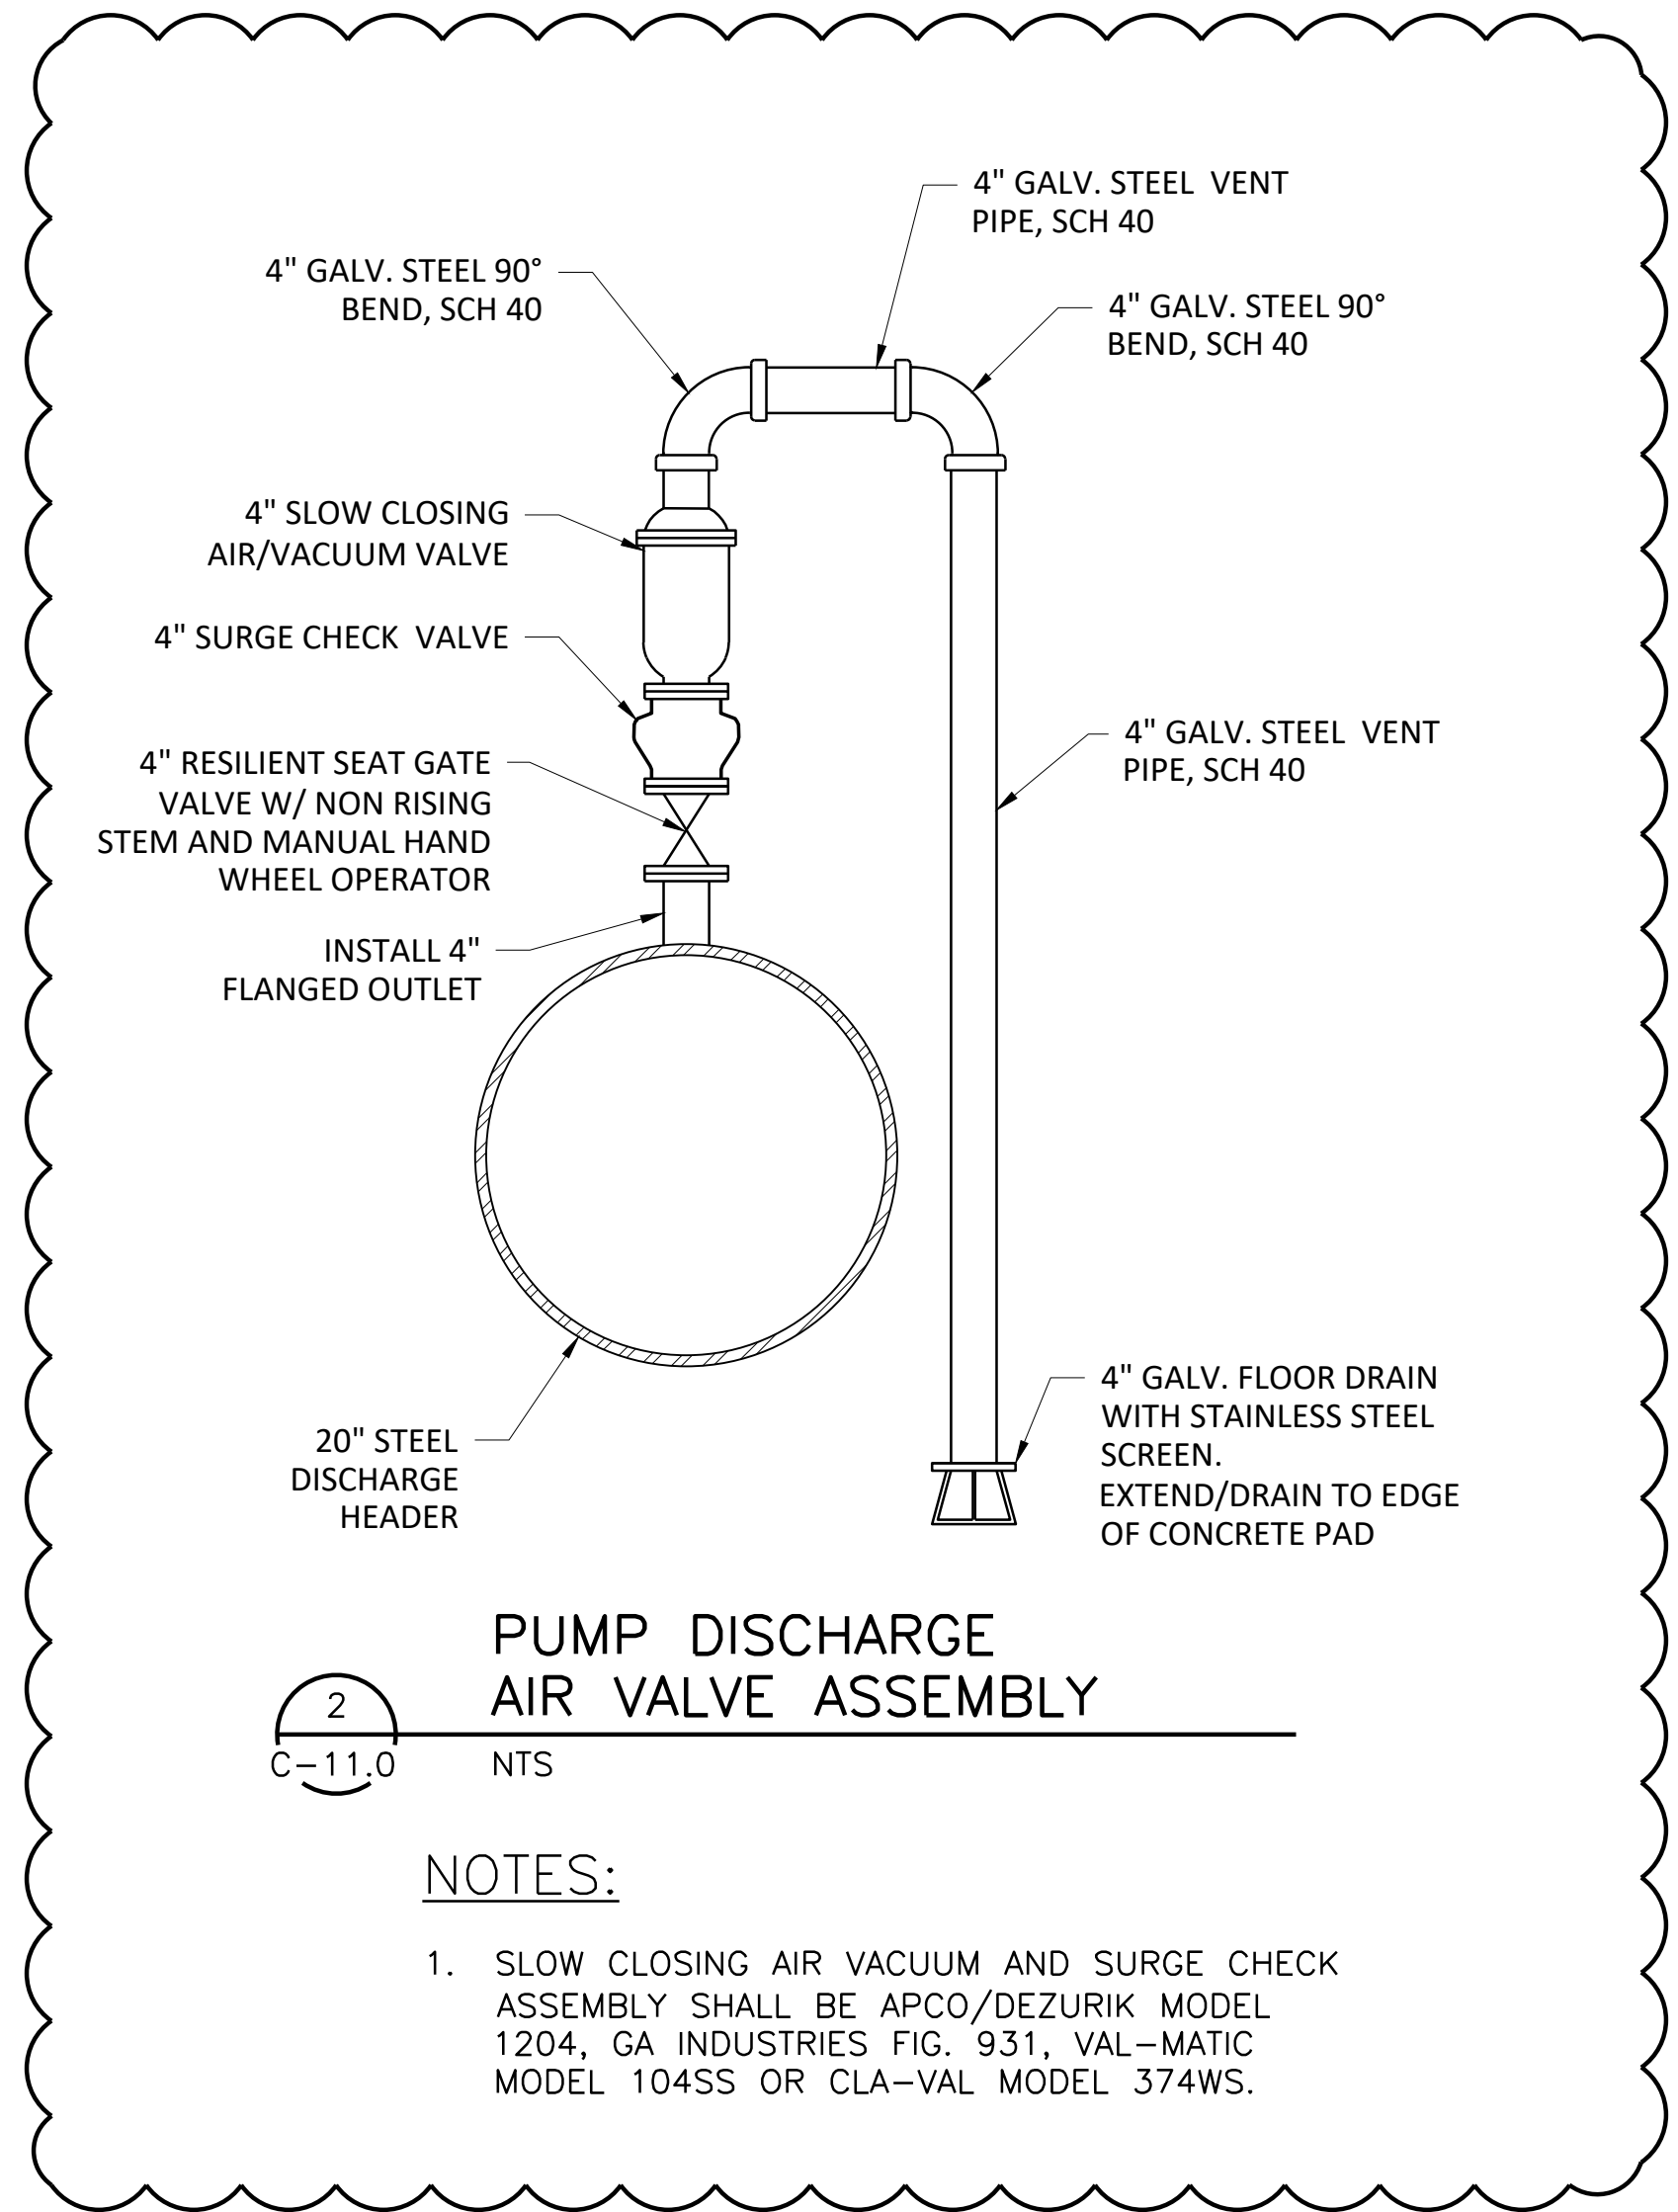
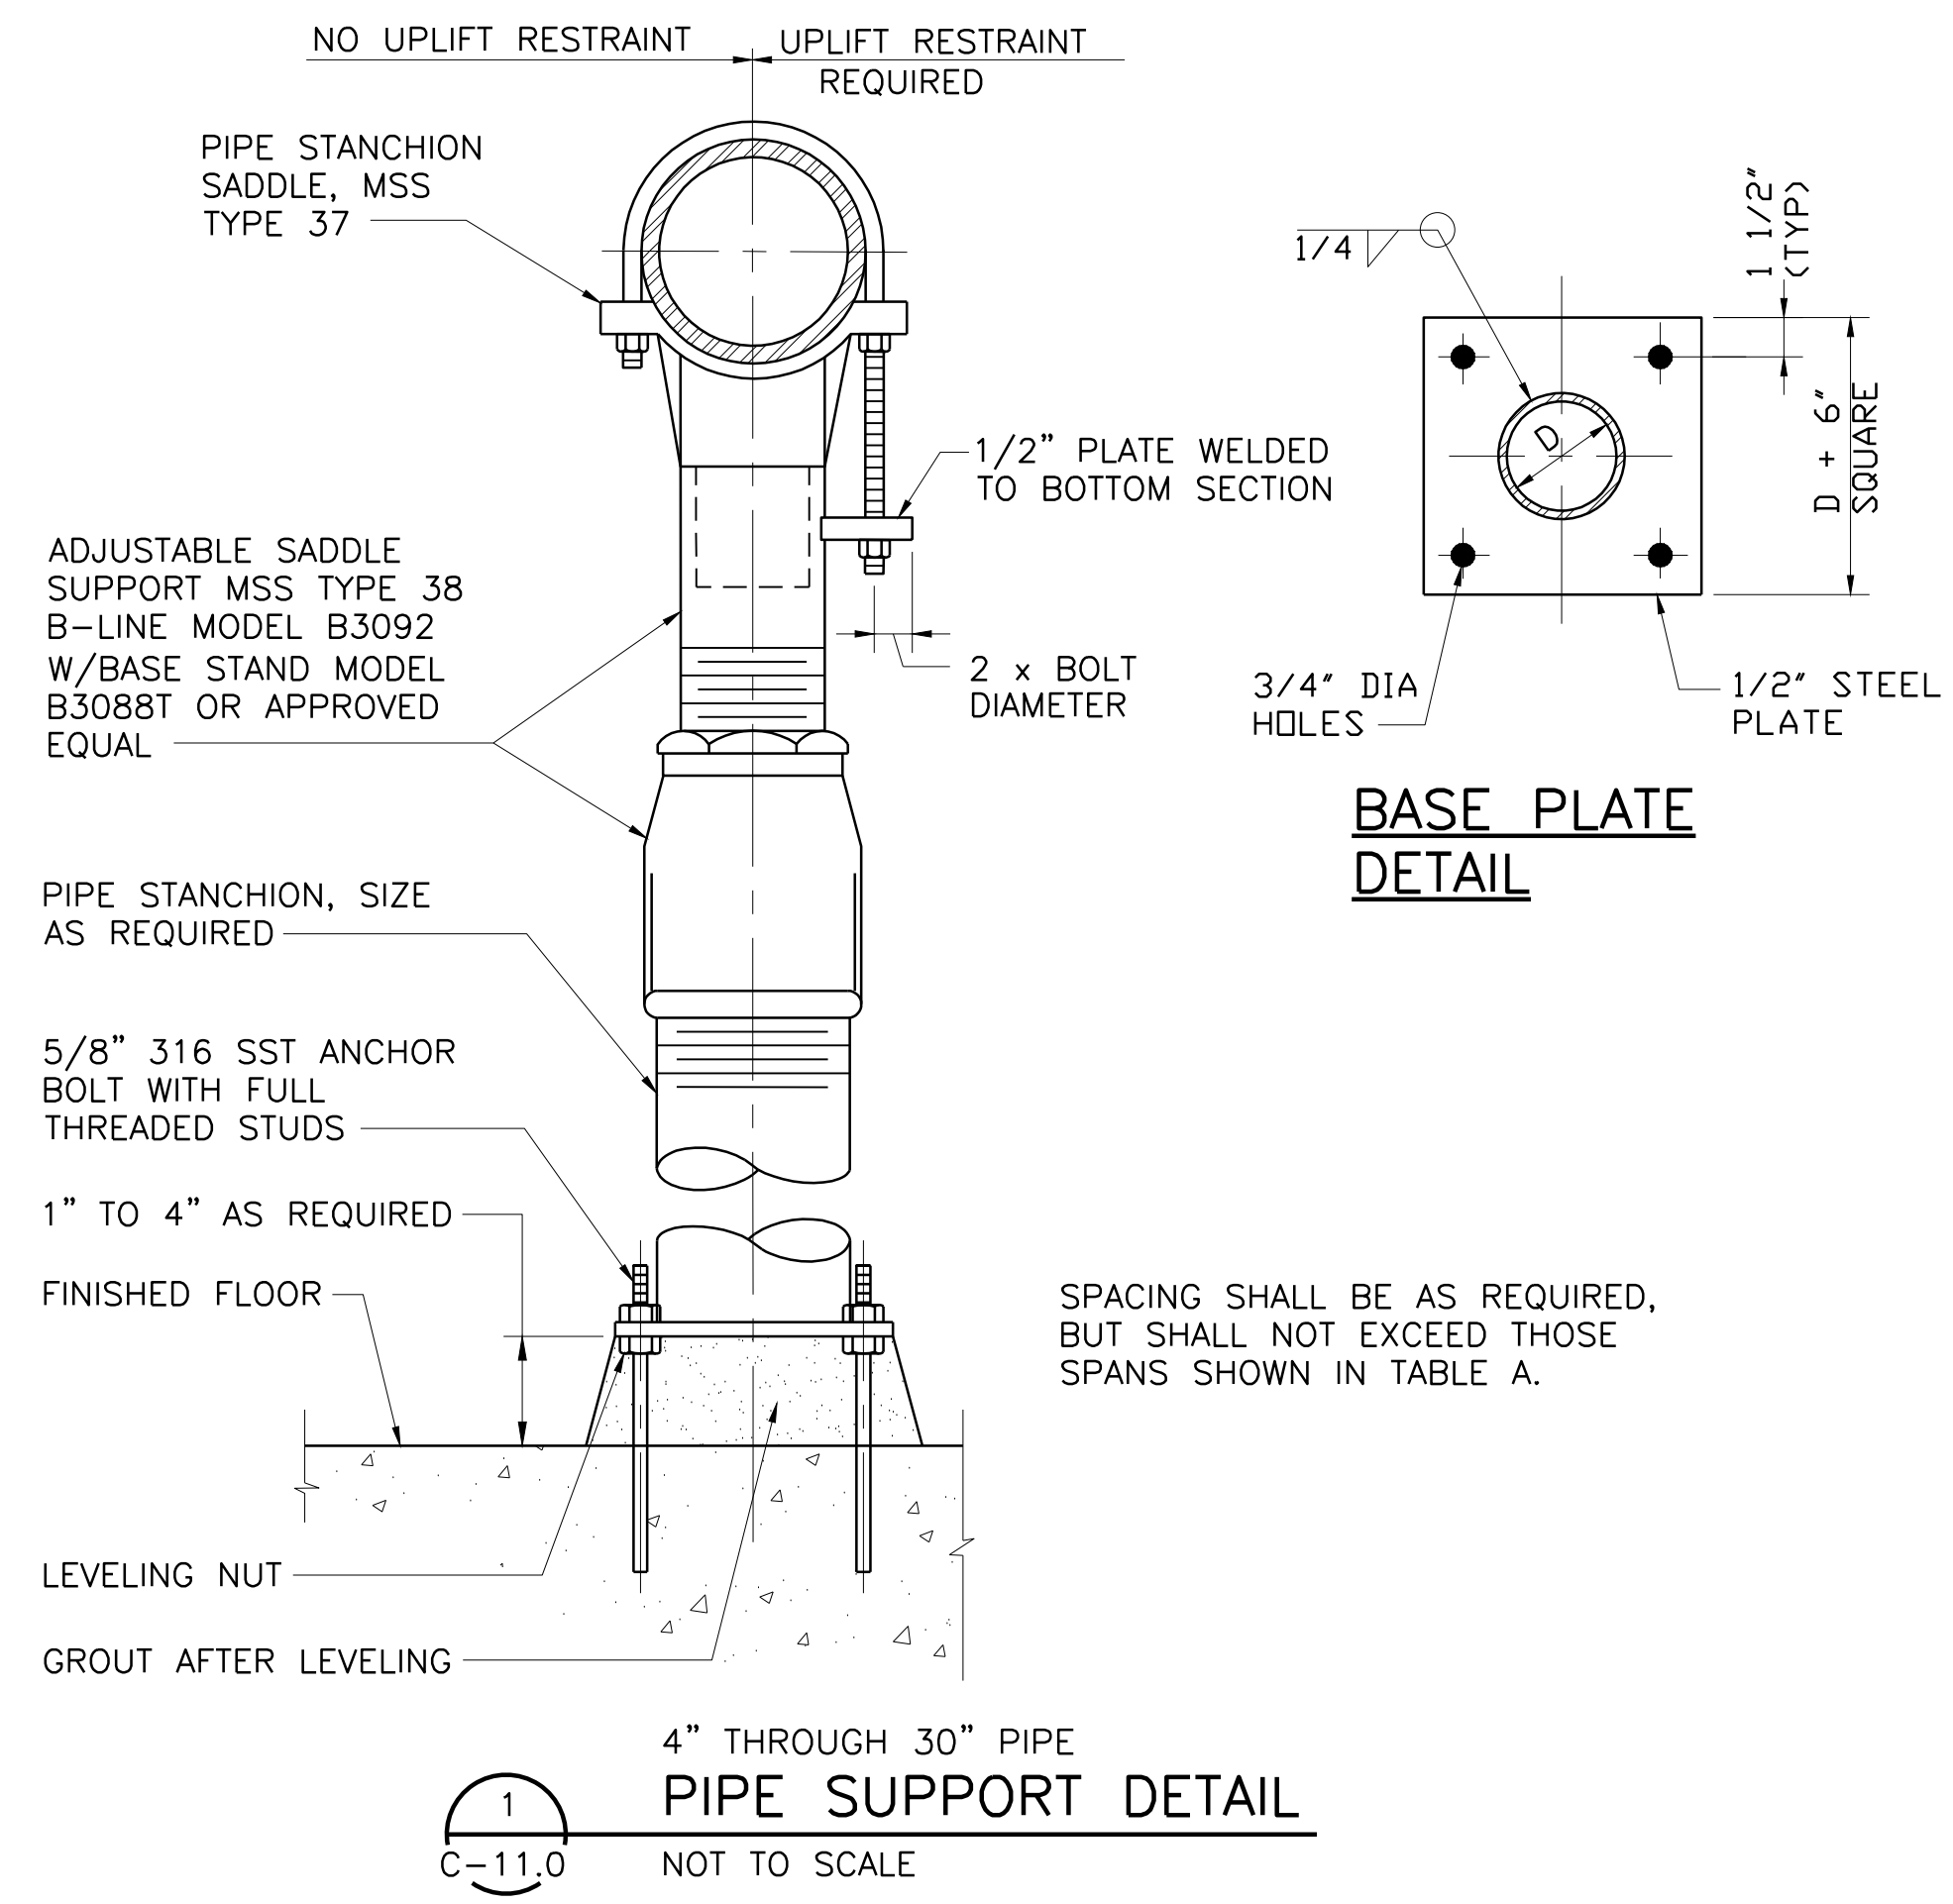


- NOTES:**
1. SLOW CLOSING AIR VACUUM AND SURGE CHECK ASSEMBLY SHALL BE APCO/DEZURIK MODEL 1204, GA INDUSTRIES FIG. 931, VAL-MATIC MODEL 104SS OR CLA-VAL MODEL 374WS.

07/29/2020	ADDDITION NO. 3	1	ECT	CGS
DATE	REVISIONS AND RECORD OF ISSUE	NO.	BY	CHK
				APP

10431 Mercedes Circle, Suite 300  
 Austin, Texas 78759  
 Phone - (512) 617-3100  
 Fax - (512) 617-3101  
 Web - www.freese.com

**FREES & NICHOLS**  
 Texas Registered Engineering Firm F-2144

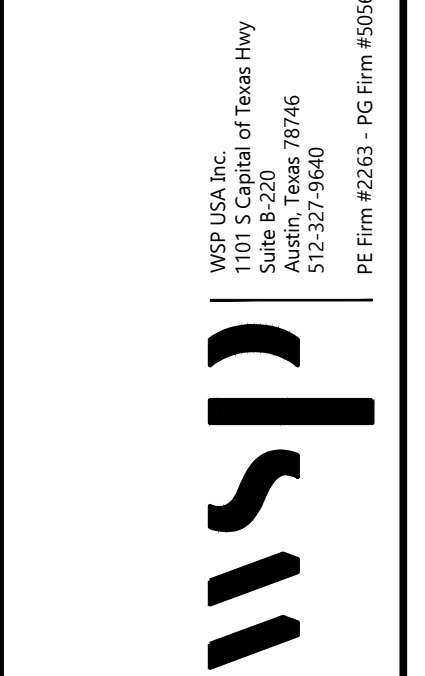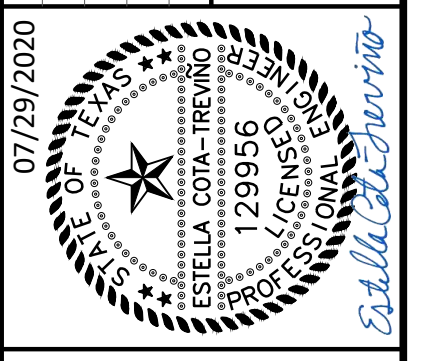

SAN ANTONIO WATER SYSTEM  
 EQUIPPING OF MICRON STATION  
 WELL 4  
 WELL DISCHARGE PIPING  
 DETAILS

DESIGNED: BG
DETAILED: DB
CHECKED: —
APPROVED: INGO
DATE: 7/29/2020
IF THIS BAR DOES NOT MEASURE 1" THEN DRAWING IS NOT TO FULL SCALE
SAWS JOB NO.
C-11.0 SHEET 12 OF 35