

King Street Pump Station Improvements (Volume I) & ASR Lime System Improvements (Volume II) - RFCSP Solicitation Number: CO-00670

Job No.: 20-6002 and 22-8603

# ADDENDUM 12 January 09, 2024

## To Respondent of Record:

This addendum, applicable to work referenced above, is an amendment to the price proposal, plans and specifications and as such will be a part of and included in the Contract Documents. Acknowledge receipt of this addendum by entering the Addendum number and issue date on the space provided in submitted copies of the Respondent Questionnaire.

#### **RESPONSES TO QUESTIONS**

- 1. Volume II-ASR Lime Improvements: Contract Drawing D-101 shows where the Demo Pictures were taken from, however, Picture A / D-103 doesn't appear to be the correct location. Please Advise.
  - <u>Response:</u> No changes made to contract documents. Picture A / D-103 is not shown on sheet D-101 view; however, Picture A / D-103 refers to the demolition at the lime slurry pipe at the existing injection vault. Picture A indicated on D-101 is referenced on C-102.
- 2. Volume II-ASR Lime Improvements: Contract Drawing D-101 shows where the Demo Pictures were taken from, however, Picture B / D-103 isn't shown on D-101. Please Advise.
  - <u>Response:</u> No changes made to contract documents. Picture B / D-103 is not shown on Drawing D-101 view; however, Picture B refers to the demolition at the lime slurry pipe at the existing injection vault.
- 3. Volume II-ASR Lime Improvements: Contract Drawing D-101 shows where the Demo Pictures were taken from, however, Picture E / D-103 is called out at different locations. Please Advise.
  - <u>Response:</u> Picture E / D-103 refers to permanganate pumps as called out on Drawing D-101. Duplicate reference for E / D-103 has been deleted from Drawing D-101. Refer to "Changes to Plans" Item No 1.
- 4. Volume II-ASR Lime Improvements: Contract Drawing D-101 shows where the Demo Pictures were taken from, however, Picture F / D-103 isn't shown on D-101. Please Advise.
  - *Response:* Reference for F / D-103 has been added to Drawing D-101. Refer to "Changes to Plans" Item No 1.
- 5. Volume II-ASR Lime Improvements: Contract Drawing D-101 shows where the Demo Pictures were taken from, however, Picture D / D-104 is shown, but not found on D-104. Please Advise.
  - <u>Response:</u> D / D-104 reference has been updated to J/D-104 on Drawing D-101. Refer to "Changes to Plans" Item No 1.
- 6. Volume II-ASR Lime Improvements: Contract Drawing D-101 shows where the Demo Pictures were taken from, however, Picture J / D-104 isn't shown on D-101. Please Advise.
  - <u>Response:</u> D / D-104 reference has been updated to J / D-104 on Drawing D-101. Refer to "Changes to Plans" Item No 1.
- 7. Volume II-ASR Lime Improvements: Contract Drawing D-101 shows where the Demo Pictures were taken from, however, Picture L / D-104 isn't shown on D-101. Please Advise.
  - Response: Reference for L / D-104 has been added to Drawing D-101. Refer to "Changes to Plans" Item No 1.

1 of 6

- 8. Volume II-ASR Lime Improvements: Contract Drawing D-101 shows where the Demo Pictures were taken from, however, Picture M / D-104 isn't shown on D-101. Please Advise.
  - Response: Reference for M / D-104 has been added to Drawing D-101. Refer to "Changes to Plans" Item No 1.
- 9. Volume I-King St PS Improvements: The specifications in Section 15076 Double Containment / Section 3.1.B.2, together with the "PIPE MATERIALS SCHEDULE" table in drawing D-001, require the use of threaded connections for the carrier pipe of PVC and CPVC double containment systems. This is not recommended due to potential leaks, pressure derating and added installation difficulties making it impractical for onsite preparation and installation. IPEX would recommend using solvent weld joints as they are permanent and reliable and easier to install.
  - <u>Response:</u> Solvent weld joints shall be used for carrier pipe of Hydrofluosilicic acid and Sodium Hypochlorite. Refer to "Changes to Plans" Item No 3. Refer to "Changes to Specifications" Item No 3, Item No 4.1 and Item No 4.2. Please note Section 15076 was changed in Addendum no 4.
- 10. Volume I-King St PS Improvements: The "PIPE MATERIALS SCHEDULE" table in drawing D-001 lists both fluoride and hypo systems as double contained. In the subsequent drawings the Fluoride systems has visible double containment, tags showing so, and tags showing the location of the low point leak detection sensors. In the Hypo system there is no visible double containment nor tags for the exposed/above ground portion, or defined locations for the leak detection. We want to confirm what are the above ground locations where the Hypo system needs double containment.
  - <u>Response:</u> Double containment and leak sensors for hypo system shown. Refer to "Changes to Plans" Item No 5, Item No 6, Item No 7, Item No 8, Item No 9, Item No 11, Item No 12, Item No 13 and Item No 14.
- 11. Volume I-King St PS Improvements: The specifications in Section 15076 Double Containment / Section 1.1.C.4 requires that "Double wall chemical containment floor drains and drain piping shall be installed from the chemical feed rooms to their respective bulk storage containment areas as shown in the Drawings". We could not identify the layout of the mentioned system in the drawings.
  - <u>Response:</u> Double wall chemical containment floor drains are not required for the fluoride room as they drain to the sewer system. Fluoride piping and tanks are double walled and are designed to contain the chemical leakage. The drain that collects sodium hypochlorite leaks from the sodium hypochlorite metering pump room to sump pit needs to be double walled. Refer to P-301 for the drain line. No changes made to contract documents.
- 12. Volume I-King St PS Improvements: IPEX offers a complete and competitive range of thermoplastic valves. Please evaluate including IPEX as an approved manufacturer for specification number 15102.

  \*\*Response:\*\* Manufacturers cannot be approved during the bidding/advertisement phase of the project. No changes made to contract documents.
- **13.** Volume I-King St PS Improvements: Are the valves resilient seated? Section 15103 AWWA Ball Valves <u>Response:</u> The ball valves are rubber seated with seat material made of EPDM. Refer to "Changes to Specifications" item no 5.
- **14.** Volume I-King St PS Improvements: What is the number of seats required? Section 15103 AWWA Ball Valves *Response:* Valves shall be single seated. Refer to "Changes to Specifications" item no 5.
- 15. Volume I-King St PS Improvements: The spec calls for 300 class Flanges. Is that correct? We need to know what CWP we should use to select valves.
  - <u>Response:</u> Flanges shall conform to ANSI/ASME B16.1, Class 125. Refer to "Changes to Specifications" item no 5. Ball valves shall be rated for a working pressure as indicated in table 1 of section 15055 in accordance with paragraph 2.01 D of Section 15103 AWWA Ball Valves.
- 16. Volume I-King St PS Improvements: On Sheet 504, Detail 3 there is a detail for a vandal deterrent, however I didn't see this called out anywhere on the plans. What was the intent of this detail? There are new ladders inside the building, the chemical tank access, and the existing water tank. Please advise.

SAN ANTONIO WATER SYSTEM 2 of 6

<u>Response:</u> Refer to Note 5 on D-102. Vandal deterrent is added to the ladder on the existing Ground Storage Tank. No changes made to contract documents.

17. Volume I-King St PS Improvements: Can Mayfield be closed during the drilling of the new well to provide additional access for the drilling contractor?

<u>Response:</u> The closure of W.Mayfield Blvd is not in the contract documents and has not been coordinated with City of San Antonio (COSA) for the project. If the contractor wishes to coordinate with COSA for the closure of W.Mayfield Blvd, they may do so at no additional cost to SAWS. Contractor is responsible for the development, implementation of traffic control plans, maintaining access for residents, submitting any necessary permit requests and securing approval from City of San Antonio for street closure at no additional cost to SAWS.

18. Volume I-King St PS Improvements: Can you provide a cut of the south wall inside the Hypo Generation Room? We need to see how the pipe is laid out.

Response: Cut sections provided. Refer to "Changes to Plans" item no 2 and item no 10.

19. Volume I-King St PS Improvements: Can you provide a cut of the north wall inside the Fluoride Building? We need to see how the pipe is laid out.

*Response:* Cut sections provided. Refer to "Changes to Plans" item no 2 and item no 10.

20. Volume I-King St PS Improvements: In regard to this project, the plans show an aluminum stair and platform in the demo section and in the structural. Do you know if this is something that needs to be quoted as new material?

<u>Response:</u> The Sheet D-303 (Volume I) referenced in the attachment is not a demo sheet and is a process mechanical sheet. Aluminum stairs/platforms/rails are required to access the hypo bulk storage tanks. Aluminum railing is needed around the hypo bulk storage tank containment walls. These items are to be provided and installed by the contractor. The design of the stairs/platforms/railing is to be provided by the stair manufacturer's licensed engineer (refer to drawing S-504).

21. Volume I-King St PS Improvements: On the above project, we greatly appreciate it if you could consider naming EDGENG as an approved Manufacturer in the specification OR approve us Equal Status on this Project per the specification sections of Section 13122- FRP Shelters in order for us to forward our proposal for the FRP scope of work, which has developed cost-effective and durable alternatives for Stainless Steel Products.

We are an FRP Composite Manufacturer Specializing in Fiber Reinforced Composite products for Structural and civil Engineering Applications. Over the past 2 decades, we have delivered to clients ranging from the US military, Chemical Plants, and City Governments across the United States & Canada with unparalleled service standards.

<u>Response:</u> EDGENG will not be added to the list of approved manufacturers in the specification. Manufacturers cannot be approved during the bidding/advertisement phase of the project. No changes made to contract documents.

22. Volume I-King St PS Improvements: Would it be possible for a SAWS representative to meet with Del Shockley (Alsay's Logistics & Equipment Manager) next week to be sure we know exactly where the well stake will be? This would allow us to be 100% confident about our ability to fit the drilling package into the proposed site and through the proposed access. Del inspected the site on Sep. 20th. He tried contacting someone from SAWS at the time but was unable to make contact. From what he understood where the well was supposed to go, he said we could get our equipment in there. If someone from SAWS could verify the well location on-site with him it would be helpful.

<u>Response:</u> A second non-mandatory site visit is scheduled for Jan 8, 2024. Please refer to Addendum 11 for details on the site visit. Please refer to "Changes to Plans" item no 4.

23. Location is a big concern working in a residential area with houses so close. We would be running 24/7 on this type of well construction. Even with acoustic walls to deter the noise, operations could exceed any City noise ordinances. There would be numerous contractors needing to work on this location based on the specifications, however, due to the size of the drilling operations they would be limited as far as access is

concerned. Weisinger's operations on this type of well would be significant and encompass a large majority of the site.

<u>Response:</u> Please refer to section 13111-Temporary Construction Noise Barrier for the temporary noise control requirements. As per paragraph 2.01 A of Section 13111, a single or double layer may be used as required to achieve desired noise reduction. Well driller should plan to alter operations at night if needed to meet the noise ordinance requirements. General sequence of operations specified is for the demolition to occur first followed by the well drilling and then the remaining construction. Thus, the site premises could be fully dedicated to well drilling except for the existing structures noted to remain in the contract documents.

24. Elevation of site is a concern. Right now the Edwards Aquifer is setting at approximately 640'. Elevation at the site is 648'. By the time this project gets kicked off, after winter, we could see a rise in the Edwards that would significantly impact the costs associated with the drilling. If it becomes artesian during the construction program, costs associated with control and continued construction would increase significantly. There would need to be assurances that if that happens, the contractor could request a change order for the additional costs.

**Response:** No changes made to contract documents.

Per paragraph 2.02 A of section 13920-Well No 6 Construction, "The contractor shall be fully prepared to control artesian groundwater flow during the drilling of the pilot borehole and during production casing installation."

Additional provisions for artesian conditions are addressed in the following specification paragraphs.

Section 01025, Paragraph 2.1

Section 13920, Paragraph. 1.01 A

Section 13920, Paragraph. 1.01 B 1

Section 13920, Paragraph. 1.03 J

In addition to the above, the site elevation is surveyed at 653' ASL.

25. Other wells on the location having an impact on the new construction. If, for some reason beyond the contractor's control, cement leaches out, through a fault, and into one of the other wells on this location during the pressure cementing of the new well's casing, the contractor could not be held responsible for damages to the existing wells.

<u>Response:</u> No changes made to contract documents. Paragraph 5.6.2 of General Conditions addresses unforeseen site conditions/conditions at the site different from those indicated in the contract documents. If such conditions are encountered on the site, contractor should comply to the provisions in the same.

### **CHANGES TO THE SPECIFICATIONS**

- BUILDING WAGE DECISION, Due to updates in the General Wage Decisions for Building Construction Type, remove
  the wage decision documents from the solicitation in its entirety and replace with the revised versions attached to
  this addendum (rev. 01/05/2024 for General Decision Number TX20240231). This version should be utilized by the
  awarded contractor for this project.
- 2. HEAVY AND HIGHWAY WAGE DECISION, Due to updates in the General Wage Decisions for Heavy and Highway Construction Type, remove the wage decision documents from the solicitation in its entirety and replace with the revised versions attached to this addendum (rev. 01/05/2024 for General Decision Number TX20240007). This version should be utilized by the awarded contractor for this project.
- 3. SECTION 15062: CPVC PIPE AND FITTINGS
  - DELETE in its entirety and REPLACE with the attached.
- 4. SECTION 15076: DOUBLE WALL CONTAINMENT PIPING
  - Paragraph 3.1.B.1; DELETE the sentence "Use threaded joints and threaded fittings for joining primary carrier pipe in exposed conditions" and REPLACE with the following "Use solvent weld for joining primary carrier pipe in exposed conditions."
  - Paragraph 3.1.B.2; DELETE the sentence "Use threaded barbed adaptors to transition between exposed piping and buried piping" and REPLACE with the following "Use solvent weld to transition between exposed piping and buried piping."

SAN ANTONIO WATER SYSTEM 4 of 6

- 5. SECTION 15103: AWWA BALL VALVES
  - Paragraph 2.01.F; ADD the following as item "4. Seat: Single seated made of EPDM rubber"
  - Paragraph 2.01.I; DELETE the sentence "Flanges shall conform to ANSI/ASME B16.1, Class 300." and REPLACE with the following "Flanges shall conform to ANSI/ASME B16.1, Class 125."

#### **CHANGES TO THE PLANS**

- 1. DRAWING D-101: LIME FEED SYSTEM DEMOLITION PLAN
  - DELETE in its entirety and REPLACE with the attached.
- 2. DRAWING G-001 DRAWING INDEX
  - DELETE in its entirety and REPLACE with the attached.
- 3. DRAWING D-001: PROCESS GENERAL NOTES LEGEND AND ABBREVIATIONS
  - DELETE in its entirety and REPLACE with the attached.
- 4. DRAWING C-117 YARD PIPING PLAN
  - DELETE in its entirety and REPLACE with the attached.
- 5. DRAWING D-301: OVERALL EQUIPMENT PLAN
  - DELETE in its entirety and REPLACE with the attached.
- 6. DRAWING D-302: OSHG BLDG AND BRINE TANK
  - DELETE in its entirety and REPLACE with the attached.
- 7. DRAWING D-303: FLUORIDE BLDG, TANK & HYPO BULK STORAGE TANKS
  - DELETE in its entirety and REPLACE with the attached.
- 8. DRAWING D-306: OSHG BLDG AND TANK I
  - DELETE in its entirety and REPLACE with the attached.
- 9. DRAWING D-307: OSHG BLDG AND TANK II
  - DELETE in its entirety and REPLACE with the attached.
- 10. DRAWING D-308: ADDITIONAL BUILDING SECTIONS
  - ADD the sheet to the plan set.
- 11. DRAWING E-108: SITE PLAN MODIFICATION ENLARGED VIEW-II
  - DELETE in its entirety and REPLACE with the attached.
- 12. DRAWING E-308: OSHG BULDING CONTROL PLAN -I
  - DELETE in its entirety and REPLACE with the attached.
- 13. DRAWING E-321: FLOURIDE TRANSFER PUMP CONTROL SCHEMATIC
  - DELETE in its entirety and REPLACE with the attached.
- 14. DRAWING I-13: FLOURIDE FEED PID
  - DELETE in its entirety and REPLACE with the attached.

## **CLARIFICATIONS**

1. The well location for the new well no. 6 shown on the drawings is not exact. A tolerance of 10 feet is allowable. Adjustments to other utilities on the site to accommodate the new well location need to be made by the Contractor at no additional cost to the Owner.

## **END OF ADDENDUM**

This Addendum, including these six (6) pages, is thirty-nine (39) pages with attachments in its entirety.

## Attachments:

- 1. WAGE DECISION BUILDING (7 Pages)
- 2. WAGE DECISION HIGHWAY (6 Pages)
- 3. SPECIFICATIONS SECTION 15062 CPVC PIPE AND FITTINGS (6 Pages)
- 4. DRAWING D-101: LIME FEED SYSTEM DEMOLITION PLAN (1 Page)
- 5. DRAWING G-001: DRAWING INDEX (1 Page)
- 6. DRAWING D-001: PROCESS GENERAL NOTES LEGEND AND ABBREVIATIONS (1 Page)
- 7. DRAWING C-117 YARD PIPING PLAN (1 Page)

SAN ANTONIO WATER SYSTEM 5 of 6

- 8. DRAWING D-301: OVERALL EQUIPMENT PLAN (1 Page)
- 9. DRAWING D-302: OSHG BLDG AND BRINE TANK (1 Page)
- 10. DRAWING D-303: FLUORIDE BLDG, TANK & HYPO BULK STORAGE TANKS (1 Page)
- 11. DRAWING D-306: OSHG BLDG AND TANK I (1 Page)
- 12. DRAWING D-307: OSHG BLDG AND TANK II (1 Page)
- 13. DRAWING D-308: ADDITIONAL BUILDING SECTIONS (1 Page)
- 14. DRAWING E-108: SITE PLAN MODIFICATION ENLARGED VIEW-II (1 Page)
- 15. DRAWING E-308: OSHG BULDING CONTROL PLAN I (1 Page)
- 16. DRAWING E-321: FLOURIDE TRANSFER PUMP CONTROL SCHEMATIC (1 Page)
- 17. DRAWING I-13: FLOURIDE FEED PID (1 Page)



01/09/2024

Mythri Krishnamoorthysujatha, P.E.
Tetra Tech

"General Decision Number: TX20240231 01/05/2024

Superseded General Decision Number: TX20230231

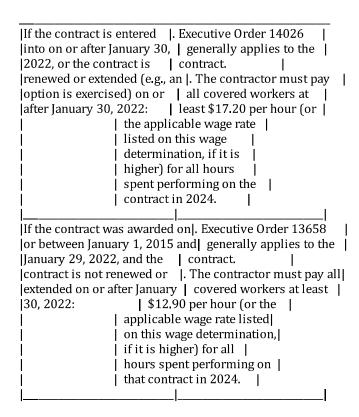
State: Texas

Construction Type: Building

County: Bexar County in Texas.

BUILDING CONSTRUCTION PROJECTS (does not include single family homes or apartments up to and including 4 stories).

Note: Contracts subject to the Davis-Bacon Act are generally required to pay at least the applicable minimum wage rate required under Executive Order 14026 or Executive Order 13658. Please note that these Executive Orders apply to covered contracts entered into by the federal government that are subject to the Davis-Bacon Act itself, but do not apply to contracts subject only to the Davis-Bacon Related Acts, including those set forth at 29 CFR 5.1(a)(1).



The applicable Executive Order minimum wage rate will be adjusted annually. If this contract is covered by one of the Executive Orders and a classification considered necessary for performance of work on the contract does not appear on this wage determination, the contractor must still submit a conformance request.

Additional information on contractor requirements and worker protections under the Executive Orders is available at http://www.dol.gov/whd/govcontracts.

ASBESTOS WORKER/HEAT & FROST INSULATOR (Duct, Pipe and Mechanical System Insulation)\$ 28.95 BOIL0074-003 07/01/2023
Rates Fringes
BOILERMAKER\$ 37.00 24.64
ELEC0060-003 06/05/2023
Rates Fringes
ELECTRICIAN (Communication Technician Only)\$33.00 18%+5.45
ELEC0060-004 06/05/2023
Rates Fringes
ELECTRICIAN (Excludes Low Voltage Wiring)\$ 33.00 18%+5.45
ELEV0081-001 01/01/2023
Rates Fringes
ELEVATOR MECHANIC\$ 46.83 37.335+a+b
FOOTNOTES:  a. 6% under 5 years based on regular hourly rate for all hours worked. 8% over 5 years based on regular hourly rate for all hours worked.
b. Holidays: New Year's Day; Memorial Day; Independence Day; Labor Day; Thanksgiving Day; Friday after Thanksgiving Day; Christmas Day; and Veterans Day.
ENGI0450-002 04/01/2014
Rates Fringes
POWER EQUIPMENT OPERATOR Cranes\$ 34.85 9.85
IRON0066-013 06/01/2023
Rates Fringes
IRONWORKER, STRUCTURAL\$ 26.00 7.53
IRON0084-011 06/01/2023
Rates Fringes
IRONWORKER, ORNAMENTAL\$ 27.51 8.13

PLUM0142-009 07/01/2023

Rates Fringes
HVAC MECHANIC (Electrical Temperature Control Installation & Unit Installation Only)\$ 35.95
PIPEFITTER (Including HVAC Pipe Installation)\$ 35.95 11.25
Including HVAC Pipe Installation PLUMBER\$ 35.95 11.25 Excludes HVAC Pipe Installation
SFTX0669-002 04/01/2023
Rates Fringes
SPRINKLER FITTER (Fire Sprinklers)\$ 34.60 23.30
SHEE0067-004 07/03/2023
Rates Fringes
Sheet metal worker Excludes HVAC Duct Installation\$ 30.24 15.89 HVAC Duct Installation Only.\$ 30.24 15.89
SUTX2014-006 07/21/2014
Rates Fringes
BRICKLAYER\$ 22.15 0.00
CARPENTER (Acoustical Ceiling Installation Only)\$ 17.83 0.00
CARPENTER (Form Work Only)\$ 13.63 ** 0.00
CARPENTER, Excludes Acoustical Ceiling Installation, Drywall Hanging, Form Work, and Metal Stud Installation\$ 16.86 ** 4.17
CAULKER\$ 15.00 ** 0.00
CEMENT MASON/CONCRETE FINISHER\$ 22.27 5.30
DRYWALL FINISHER/TAPER\$ 13.81 ** 0.00
DRYWALL HANGER AND METAL STUD INSTALLER\$ 15.18 ** 0.00
ELECTRICIAN (Low Voltage Wiring Only)\$ 20.39 3.04
IRONWORKER, REINFORCING\$ 12.27 ** 0.00
LABORER: Common or General\$ 10.75 ** 0.00
LABORER: Mason Tender - Brick\$ 11.88 ** 0.00

LABORER: Pipelayer \$ 11.00 ** 0.00
LABORER: Roof Tearoff\$ 11.28 ** 0.00
LABORER: Landscape and Irrigation\$ 8.00 ** 0.00
OPERATOR: Backhoe/Excavator/Trackhoe\$ 15.98 ** 0.00
OPERATOR: Bobcat/Skid Steer/Skid Loader\$ 14.00 ** 0.00
OPERATOR: Bulldozer \$ 14.00 ** 0.00
OPERATOR: Drill\$ 14.50 ** 0.00
OPERATOR: Forklift \$ 12.50 ** 0.00
OPERATOR: Grader/Blade\$ 23.00 5.07
OPERATOR: Loader \$ 12.79 ** 0.00
OPERATOR: Mechanic\$ 18.75 5.12
OPERATOR: Paver (Asphalt, Aggregate, and Concrete)\$ 16.03 ** 0.00
OPERATOR: Roller\$ 12.00 ** 0.00
PAINTER (Brush, Roller and Spray), Excludes Drywall Finishing/Taping\$ 13.07 ** 0.00
ROOFER \$ 12.00 ** 0.00
TILE FINISHER \$ 11.32 ** 0.00
TILE SETTER 14.94 ** 0.00
TRUCK DRIVER: Dump Truck\$ 12.39 ** 1.18
TRUCK DRIVER: Flatbed Truck\$ 19.65 8.57
TRUCK DRIVER: Semi-Trailer Truck\$ 12.50 ** 0.00
TRUCK DRIVER: Water Truck\$ 12.00 ** 4.11
WELDERS - Receive rate prescribed for craft performing

WELDERS - Receive rate prescribed for craft performing operation to which welding is incidental.

\_\_\_\_\_

<sup>\*\*</sup> Workers in this classification may be entitled to a higher minimum wage under Executive Order 14026 (\$17.20) or 13658 (\$12.90). Please see the Note at the top of the wage determination for more information. Please also note that the minimum wage requirements of Executive Order 14026 are not currently being enforced as to any contract or subcontract to which the states of Texas, Louisiana, or Mississippi, including their agencies, are a party.

Note: Executive Order (EO) 13706, Establishing Paid Sick Leave for Federal Contractors applies to all contracts subject to the Davis-Bacon Act for which the contract is awarded (and any solicitation was issued) on or after January 1, 2017. If this contract is covered by the EO, the contractor must provide employees with 1 hour of paid sick leave for every 30 hours they work, up to 56 hours of paid sick leave each year. Employees must be permitted to use paid sick leave for their own illness, injury or other health-related needs, including preventive care; to assist a family member (or person who is like family to the employee) who is ill, injured, or has other health-related needs, including preventive care; or for reasons resulting from, or to assist a family member (or person who is like family to the employee) who is a victim of, domestic violence, sexual assault, or stalking. Additional information on contractor requirements and worker protections under the EO is available at

https://www.dol.gov/agencies/whd/government-contracts.

Unlisted classifications needed for work not included within the scope of the classifications listed may be added after award only as provided in the labor standards contract clauses (29CFR 5.5 (a) (1) (iii)).

-----

The body of each wage determination lists the classification and wage rates that have been found to be prevailing for the cited type(s) of construction in the area covered by the wage determination. The classifications are listed in alphabetical order of ""identifiers"" that indicate whether the particular rate is a union rate (current union negotiated rate for local), a survey rate (weighted average rate) or a union average rate (weighted union average rate).

## Union Rate Identifiers

A four letter classification abbreviation identifier enclosed in dotted lines beginning with characters other than ""SU"" or ""UAVG"" denotes that the union classification and rate were prevailing for that classification in the survey. Example: PLUM0198-005 07/01/2014. PLUM is an abbreviation identifier of the union which prevailed in the survey for this classification, which in this example would be Plumbers. 0198 indicates the local union number or district council number where applicable, i.e., Plumbers Local 0198. The next number, 005 in the example, is an internal number used in processing the wage determination. 07/01/2014 is the effective date of the most current negotiated rate, which in this example is July 1, 2014.

Union prevailing wage rates are updated to reflect all rate changes in the collective bargaining agreement (CBA) governing this classification and rate.

# Survey Rate Identifiers

Classifications listed under the ""SU"" identifier indicate that no one rate prevailed for this classification in the survey and the published rate is derived by computing a weighted average rate based on all the rates reported in the survey for that classification. As this weighted average rate includes all rates reported in the survey, it may include both union and

non-union rates. Example: SULA2012-007 5/13/2014. SU indicates the rates are survey rates based on a weighted average calculation of rates and are not majority rates. LA indicates the State of Louisiana. 2012 is the year of survey on which these classifications and rates are based. The next number, 007 in the example, is an internal number used in producing the wage determination. 5/13/2014 indicates the survey completion date for the classifications and rates under that identifier.

Survey wage rates are not updated and remain in effect until a new survey is conducted.

Union Average Rate Identifiers

Classification(s) listed under the UAVG identifier indicate that no single majority rate prevailed for those classifications; however, 100% of the data reported for the classifications was union data. EXAMPLE: UAVG-OH-0010 08/29/2014. UAVG indicates that the rate is a weighted union average rate. OH indicates the state. The next number, 0010 in the example, is an internal number used in producing the wage determination. 08/29/2014 indicates the survey completion date for the classifications and rates under that identifier.

A UAVG rate will be updated once a year, usually in January of each year, to reflect a weighted average of the current negotiated/CBA rate of the union locals from which the rate is based.

\_\_\_\_\_

#### WAGE DETERMINATION APPEALS PROCESS

- 1.) Has there been an initial decision in the matter? This can be:
- \* an existing published wage determination
- \* a survey underlying a wage determination
- \* a Wage and Hour Division letter setting forth a position on a wage determination matter
- \* a conformance (additional classification and rate) ruling

On survey related matters, initial contact, including requests for summaries of surveys, should be with the Wage and Hour National Office because National Office has responsibility for the Davis-Bacon survey program. If the response from this initial contact is not satisfactory, then the process described in 2.) and 3.) should be followed.

With regard to any other matter not yet ripe for the formal process described here, initial contact should be with the Branch of Construction Wage Determinations. Write to:

Branch of Construction Wage Determinations Wage and Hour Division U.S. Department of Labor 200 Constitution Avenue, N.W. Washington, DC 20210

2.) If the answer to the question in 1.) is yes, then an interested party (those affected by the action) can request review and reconsideration from the Wage and Hour Administrator (See 29 CFR Part 1.8 and 29 CFR Part 7). Write to:

Wage and Hour Administrator U.S. Department of Labor 200 Constitution Avenue, N.W. Washington, DC 20210

The request should be accompanied by a full statement of the interested party's position and by any information (wage payment data, project description, area practice material, etc.) that the requestor considers relevant to the issue.

3.) If the decision of the Administrator is not favorable, an interested party may appeal directly to the Administrative Review Board (formerly the Wage Appeals Board). Write to:

Administrative Review Board U.S. Department of Labor 200 Constitution Avenue, N.W. Washington, DC 20210

4.) All decisions by the Administrative Review Board are final.

\_\_\_\_\_\_

END OF GENERAL DECISION"

"General Decision Number: TX20240007 01/05/2024

Superseded General Decision Number: TX20230007

State: Texas

Construction Types: Heavy and Highway

Counties: Atascosa, Bandera, Bastrop, Bell, Bexar, Brazos, Burleson, Caldwell, Comal, Coryell, Guadalupe, Hays, Kendall, Lampasas, McLennan, Medina, Robertson, Travis, Williamson and Wilson Counties in Texas.

HEAVY (excluding tunnels and dams, not to be used for work on Sewage or Water Treatment Plants or Lift / Pump Stations in Bell, Coryell, McClennon and Williamson Counties) and HIGHWAY Construction Projects

Note: Contracts subject to the Davis-Bacon Act are generally required to pay at least the applicable minimum wage rate required under Executive Order 14026 or Executive Order 13658. Please note that these Executive Orders apply to covered contracts entered into by the federal government that are subject to the Davis-Bacon Act itself, but do not apply to contracts subject only to the Davis-Bacon Related Acts, including those set forth at 29 CFR 5.1(a)(1).

```
| If the contract is entered | Executive Order 14026
[into on or after January 30, | generally applies to the |
2022, or the contract is | contract.
|renewed or extended (e.g., an |. The contractor must pay
option is exercised) on or | all covered workers at
lafter January 30, 2022:
                          | least $17.20 per hour (or |
                | the applicable wage rate |
                | listed on this wage
                 | determination, if it is |
                 | higher) for all hours
                | spent performing on the |
                | contract in 2024.
If the contract was awarded on Lexecutive Order 13658
or between January 1, 2015 and generally applies to the
[January 29, 2022, and the | contract.
|contract is not renewed or |. The contractor must pay all|
extended on or after January | covered workers at least |
                     | $12.90 per hour (or the |
130, 2022:
                | applicable wage rate listed|
                on this wage determination,
                | if it is higher) for all |
                | hours spent performing on |
                that contract in 2024.
```

The applicable Executive Order minimum wage rate will be adjusted annually. If this contract is covered by one of the Executive Orders and a classification considered necessary for performance of work on the contract does not appear on this wage determination, the contractor must still submit a conformance request.

Additional information on contractor requirements and worker protections under the Executive Orders is available at

# Modification Number Publication Date 01/05/2024 SUTX2011-006 08/03/2011 Rates Fringes CEMENT MASON/CONCRETE FINISHER (Paving and Structures).....\$ 12.56 \*\* ELECTRICIAN.....\$ 26.35 FORM BUILDER/FORM SETTER Paving & Curb.....\$ 12.94 \*\* Structures.....\$ 12.87 \*\* LABORER Asphalt Raker.....\$ 12.12 \*\* Flagger..... 9.45 \*\* Laborer, Common......\$ 10.50 \*\* Laborer, Utility.....\$ 12.27 \*\* Pipelayer.....\$ 12.79 \*\* Work Zone Barricade Servicer.....\$ 11.85 \*\* PAINTER (Structures).....\$ 18.34 POWER EQUIPMENT OPERATOR: Agricultural Tractor......\$ 12.69 \*\* Asphalt Distributor.....\$ 15.55 \*\* Asphalt Paving Machine.....\$ 14.36 \*\* Boom Truck.....\$ 18.36 Broom or Sweeper.....\$ 11,04 \*\* Concrete Pavement Finishing Machine.....\$ 15.48 \*\* Crane, Hydraulic 80 tons or less.....\$ 18.36 Crane, Lattice Boom 80 tons or less.....\$ 15.87 \*\* Crane, Lattice Boom over 80 tons.....\$ 19.38 Crawler Tractor.....\$ 15.67 \*\* Directional Drilling Locator.....\$ 11.67 \*\* Directional Drilling Operator.....\$ 17.24 Excavator 50,000 lbs or Less.....\$ 12.88 \*\* Excavator over 50,000 lbs...\$ 17.71 Foundation Drill, Truck Mounted.....\$ 16.93 \*\* Front End Loader, 3 CY or Less.....\$ 13.04 \*\* Front End Loader, Over 3 CY.\$ 13.21 \*\* Loader/Backhoe.....\$ 14.12 \*\* Mechanic.....\$ 17.10 \*\* Milling Machine.....\$ 14.18 \*\*

Motor Grader, Fine Grade....\$ 18.51 Motor Grader, Rough........\$ 14.63 \*\* Pavement Marking Machine...\$ 19.17 Reclaimer/Pulverizer......\$ 12.88 \*\* Roller, Asphalt...........\$ 12.78 \*\*
Roller, Other.........\$ 10.50 \*\*
Scraper..........\$ 12.27 \*\*
Spreader Box.........\$ 14.04 \*\*
Trenching Machine, Heavy....\$ 18.48

Servicer.....\$ 14.51 \*\*

Steel Worker

Reinforcing......\$ 14.00 \*\* Structural......\$ 19.29

TRAFFIC SIGNALIZATION:

Traffic Signal Installation
Traffic Signal/Light Pole
Worker......\$ 16.00 \*\*

## TRUCK DRIVER

WELDER......\$ 15.97 \*\*

WELDERS - Receive rate prescribed for craft performing operation to which welding is incidental.

\_\_\_\_\_

\*\* Workers in this classification may be entitled to a higher minimum wage under Executive Order 14026 (\$17.20) or 13658 (\$12.90). Please see the Note at the top of the wage determination for more information. Please also note that the minimum wage requirements of Executive Order 14026 are not currently being enforced as to any contract or subcontract to which the states of Texas, Louisiana, or Mississippi, including their agencies, are a party.

Note: Executive Order (EO) 13706, Establishing Paid Sick Leave for Federal Contractors applies to all contracts subject to the Davis-Bacon Act for which the contract is awarded (and any solicitation was issued) on or after January 1, 2017. If this contract is covered by the EO, the contractor must provide employees with 1 hour of paid sick leave for every 30 hours they work, up to 56 hours of paid sick leave each year. Employees must be permitted to use paid sick leave for their own illness, injury or other health-related needs, including preventive care; to assist a family member (or person who is like family to the employee) who is ill, injured, or has other health-related needs, including preventive care; or for reasons resulting from, or to assist a family member (or person who is like family to the employee) who is a victim of, domestic violence, sexual assault, or stalking. Additional information on contractor requirements and worker protections under the EO is available at

https://www.dol.gov/agencies/whd/government-contracts.

Unlisted classifications needed for work not included within the scope of the classifications listed may be added after award only as provided in the labor standards contract clauses -----

The body of each wage determination lists the classification and wage rates that have been found to be prevailing for the cited type(s) of construction in the area covered by the wage determination. The classifications are listed in alphabetical order of ""identifiers"" that indicate whether the particular rate is a union rate (current union negotiated rate for local), a survey rate (weighted average rate) or a union average rate (weighted union average rate).

#### Union Rate Identifiers

A four letter classification abbreviation identifier enclosed in dotted lines beginning with characters other than ""SU"" or ""UAVG"" denotes that the union classification and rate were prevailing for that classification in the survey. Example: PLUM0198-005 07/01/2014. PLUM is an abbreviation identifier of the union which prevailed in the survey for this classification, which in this example would be Plumbers. 0198 indicates the local union number or district council number where applicable, i.e., Plumbers Local 0198. The next number, 005 in the example, is an internal number used in processing the wage determination. 07/01/2014 is the effective date of the most current negotiated rate, which in this example is July 1, 2014.

Union prevailing wage rates are updated to reflect all rate changes in the collective bargaining agreement (CBA) governing this classification and rate.

#### Survey Rate Identifiers

Classifications listed under the ""SU"" identifier indicate that no one rate prevailed for this classification in the survey and the published rate is derived by computing a weighted average rate based on all the rates reported in the survey for that classification. As this weighted average rate includes all rates reported in the survey, it may include both union and non-union rates. Example: SULA2012-007 5/13/2014. SU indicates the rates are survey rates based on a weighted average calculation of rates and are not majority rates. LA indicates the State of Louisiana. 2012 is the year of survey on which these classifications and rates are based. The next number, 007 in the example, is an internal number used in producing the wage determination. 5/13/2014 indicates the survey completion date for the classifications and rates under that identifier.

Survey wage rates are not updated and remain in effect until a new survey is conducted.

#### Union Average Rate Identifiers

Classification(s) listed under the UAVG identifier indicate that no single majority rate prevailed for those classifications; however, 100% of the data reported for the classifications was union data. EXAMPLE: UAVG-OH-0010 08/29/2014. UAVG indicates that the rate is a weighted union average rate. OH indicates the state. The next number, 0010 in the example, is an internal number used in producing the wage determination. 08/29/2014 indicates the survey completion date

for the classifications and rates under that identifier.

A UAVG rate will be updated once a year, usually in January of each year, to reflect a weighted average of the current negotiated/CBA rate of the union locals from which the rate is based.

-----

#### WAGE DETERMINATION APPEALS PROCESS

- 1.) Has there been an initial decision in the matter? This can be:
- \* an existing published wage determination
- \* a survey underlying a wage determination
- \* a Wage and Hour Division letter setting forth a position on a wage determination matter
- \* a conformance (additional classification and rate) ruling

On survey related matters, initial contact, including requests for summaries of surveys, should be with the Wage and Hour National Office because National Office has responsibility for the Davis-Bacon survey program. If the response from this initial contact is not satisfactory, then the process described in 2.) and 3.) should be followed.

With regard to any other matter not yet ripe for the formal process described here, initial contact should be with the Branch of Construction Wage Determinations. Write to:

Branch of Construction Wage Determinations Wage and Hour Division U.S. Department of Labor 200 Constitution Avenue, N.W. Washington, DC 20210

2.) If the answer to the question in 1.) is yes, then an interested party (those affected by the action) can request review and reconsideration from the Wage and Hour Administrator (See 29 CFR Part 1.8 and 29 CFR Part 7). Write to:

Wage and Hour Administrator U.S. Department of Labor 200 Constitution Avenue, N.W. Washington, DC 20210

The request should be accompanied by a full statement of the interested party's position and by any information (wage payment data, project description, area practice material, etc.) that the requestor considers relevant to the issue.

3.) If the decision of the Administrator is not favorable, an interested party may appeal directly to the Administrative Review Board (formerly the Wage Appeals Board). Write to:

Administrative Review Board U.S. Department of Labor 200 Constitution Avenue, N.W. Washington, DC 20210

4.) All decisions by the Administrative Review Board are final.

\_\_\_\_\_

END OF GENERAL DECISION"

#### **SECTION 15062**

# CHLORINATED POLYVINYL CHLORIDE (CPVC) PIPE AND FITTINGS

## **PART 1- GENERAL**

## 1.01 DESCRIPTION

## A. Scope of Work:

- 1. Furnish all labor, materials, equipment and incidentals required, and install and test in the locations and of the size as shown on the Drawings and specified herein Schedule 80 Chlorinated Polyvinyl Chloride (CPVC) piping, fittings and appurtenances.
- 2. All plastic pipe and fittings shall conform to this specification section whether provided as a part of an equipment "package" or purchased separately by the Contractor.

#### B. Related Work Described Elsewhere:

- 1. Section 09900 Painting and Coating
- 2. Section 15140 Pipe Supports for Process Piping
- 3. Section 15014 Pressure Testing of Pipe
- 4. Section 15015 Identification for Process Piping and Valves
- 5. Section 15141 Couplings, Connectors and Adapters

# C. General Design (Not Applicable)

## 1.02 QUALITY ASSURANCE

A. CPVC pipe, fittings and appurtenances shall meet the following standards:

1.	Pipe	ASTM D1784/ASTM F441, Type IV, Grade I, CPVC 4120, Schedule 80, Cell Classification 23447-A, bearing NSF seal.
2.	Fittings	ASTM D2464 or D2467, Cell Classification 23447-A, bearing NSF seal.
3.	Flanges	Diameter and drilling shall conform to ANSI B16.5,

4. Flange Bolts and Nuts Flange bolts and nuts shall conform to ASTM F593

Class 150.

and F594 respectively.

_	Flat Washers	Shall be of the same material as the bolts.
.).		

6. Flange Gaskets Full face, 1/8 inch thick, chemical-resistant elastometric material suitable for the specified

service.

7. Solvent Cement ASTM D2564.

8. Primer ASTM F656.

9. Expansion Joints Edlon "Thermo-molded TFE", Resistoflex "Style

R6905".

#### 1.03 SUBMITTALS

## A. Materials and Shop Drawings:

- 1. Shop drawings shall be submitted to the Owner for approval in accordance with the General Requirements and Section 01330. All products within this specification shall be combined into a single submittal which shall include at least the following:
  - a. Dimensioning and the technical specification for all piping, fittings, and appurtenances to be furnished.
  - b. Letter of Certification from the National Sanitation Foundation International (NSF) stating compliance with Standard 14 and Standard 61.
  - c. Letter from the Manufacturer verifying chemical compatibility of all products to be used in chemical feed systems.

## B. Additional Information:

- 1. Submit to the Owner, for approval, samples of all materials specified herein, along with the manufacturer's descriptive literature, illustrations, specifications, installation instructions and related information.
- C. Operating Instructions (Not Applicable)

# 1.04 PRODUCT DELIVERY, STORAGE AND HANDLING

A. Pipe and fittings shall be handled and stored in a manner which will ensure installation in sound, undamaged condition. Handling methods and equipment used shall prevent damage to pipe. Bare cables, chains, or metal bars shall not be used. Pipe shall be stored off the ground on wide padded skids.

# 1.05 WARRANTY

A. Provide equipment warranty for a period of two years, in accordance with Section 01600, Material and Equipment.

#### **PART 2 - PRODUCTS**

#### 2.01 GENERAL

A. All materials that come into contact with the water being treated or the finished water shall be on either the EPA or NSF lists of products approved for use in contact with potable water. Manufacturers shall submit an affidavit with the shop drawings indicating approval by the EPA or NSF for the materials used in products that come into contact with the water, in accordance with Rule 290.44(a) of the Texas Administrative Code.

# 2.02 MATERIALS AND EQUIPMENT

- A. Piping for buried service:
  - 1. Pipe and fittings:
    - a. Pipe and fittings shall be gasketed style utilizing twin gasket coupling or single gasket bell and spigot unless otherwise shown on the Drawings or specified in other Sections in this Division.
    - b. All chemical piping using Schedule 80 CPVC shall be solvent welded..
    - c. Pipe lengths: Laying length of 20 feet or as shown on the Drawings.
  - 2. Joints:
    - a. Provide rubber gaskets in sufficient quantity to allow for loss.
    - b. Provide couplings of the same quality as the pipe that will maintain tight joints when subjected to the same hydrostatic tests designated for the pipe.
  - 3. Adapters: When applicable, provide adapters for connecting chlorinated polyvinyl chloride pipe to pipes constructed from other material.
- B. Piping for exposed service:
  - 1. Pipe and fittings:
    - a. Solvent weld type unless otherwise shown on the Drawings or specified in other Sections in the Division.
    - b. Chemical piping, fittings and components: Schedule 80 CPVC, normal impact unless otherwise shown on the Drawings or specified in other Sections in this Division.

## 2. Joints:

- a. Solvent weld using solvent supplied or approved by pipe manufacturer.
- b. Threaded and screwed joints: Permitted only on Schedule 80 and heavier pipe. For all non chemical pipes.
- c. Couplings and fittings: Minimum schedule and pressure rating as the pipe.
- 3. Provide suitable adapters for connections to equipment and other piping systems.

#### C. Solvent Cement:

- 1. CPVC solvent cement shall be in compliance with ASTM D 2564.
- 2. Solvent cement shall be specified by compatibility based on pipe service and size.
- 3. For CPVC pipe in chemical service, provide IPS Corp Type 724 cement or another cement certified by the manufacturer for the proposed chemical service. Manufacturer to provide certification with submittal.

# D. Flanges:

- 1. The Contractor shall provide flanges on CPVC piping to connect to flanged valves, fittings, or equipment and as shown in the Drawings. Flanges shall match the connecting flanges on the adjacent fitting, valve or piece of equipment and must meet the test pressure of the piping system as specified in Section 15014: Pressure Testing of Piping.
- 2. Except for higher pressure flange connections that may be required as noted above, flanges shall meet ANSI B16.5 and be rated for an internal pressure of 150 psi at 73-degrees F.
- 3. Flange hardware (bolts, nuts, and washers) for CPVC flanges shall be Type 316 stainless steel in accordance with ASTM F593 and F594, respectively, and shall be furnished with a bright electropolished finish. Flange hardware for CPVC flanges on Hydrofluosilisic Acid and Sulfuric Acid chemical piping and at injection nozzles on process piping shall be Hastelloy C-276. Bolt length shall be provided such that bolts will project 1/8 to 3/8 inch beyond the outer face of the nut.
- 4. For chemical feed piping systems, the gasket material shall be selected by the gasket manufacturer based on the chemical concentrations as specified in Divisions 11 and 13.

# 2.03 ACCESSORIES (Not Applicable)

## 2.04 SPARE PARTS

A. All special tools, solvents, lubricants, and cements required for normal installation shall be furnished with the pipe.

## 2.05 QUALITY CONTROL

A. Contractor shall follow Manufacturer's and Supplier's recommended product quality control specifics as required for this project.

#### **PART 3 - EXECUTION**

# 3.01 PREPARATION (Not Applicable)

#### 3.02 INSTALLATION

- A. Install CPVC pipe where shown on the Drawings and in strict accordance with the manufacturer's technical data and printed instructions.
- B. Joints for Schedule 80 CPVC pipe and fittings shall be solvent welded. All joints shall be made watertight. All pipe cutting, threading and jointing procedures for solvent welded and threaded CPVC pipe joints shall be in strict accordance with the pipe and fitting manufacturer's printed installation instructions. Thread lubricant for threaded joints shall be Teflon tape only. In making solvent welded connections, clean dirt and moisture from pipe and fittings, bevel pipe ends slightly with emery cloth, if necessary and apply solvent cement of proper grade.
- C. Installation of valves and fittings shall be strictly in accordance with the manufacturer's instructions. Particular care shall be taken not to over-stress threaded connections at sleeves. In making solvent weld connections the solvent shall not be spilled on valves or allowed to run from joints.
- D. All piping shall have sufficient number of unions to allow convenient removal and shall be as approved by the Owner.
- E. Where plastic passes through wall sleeves, joints shall be sealed with a mechanical seal equal to Link-seal.
- F. Concrete inserts for hangers and supports shall be furnished and installed in the concrete as it is placed. The inserts shall be set in accordance with the requirements of the piping layout and the Contractor shall verify their locations from approved piping layout Drawings and the structural Drawings. Pipe Supports for Process Piping are specified in Section 15140.

# G. Jointing:

1. Clean each pipe length, coupling and fitting of all debris and dirt before installation.

- 2. Do not use pipe length if there are any cuts, abrasions, or defects on the surface of the pipe.
- 3. Provide and use coupling pullers for joining the pipe when required.
- 4. Shove home each length of pipe against the pipe previously laid and hold securely in position.
- 5. Do not pull or cramp joints.

## H. Fabrication:

# 1. Cutting:

- a. Use a hand saw or pipe cutter with blades (not rollers).
- b. Examine all cut ends for possible cracks caused by cutting.

# 2. Connecting:

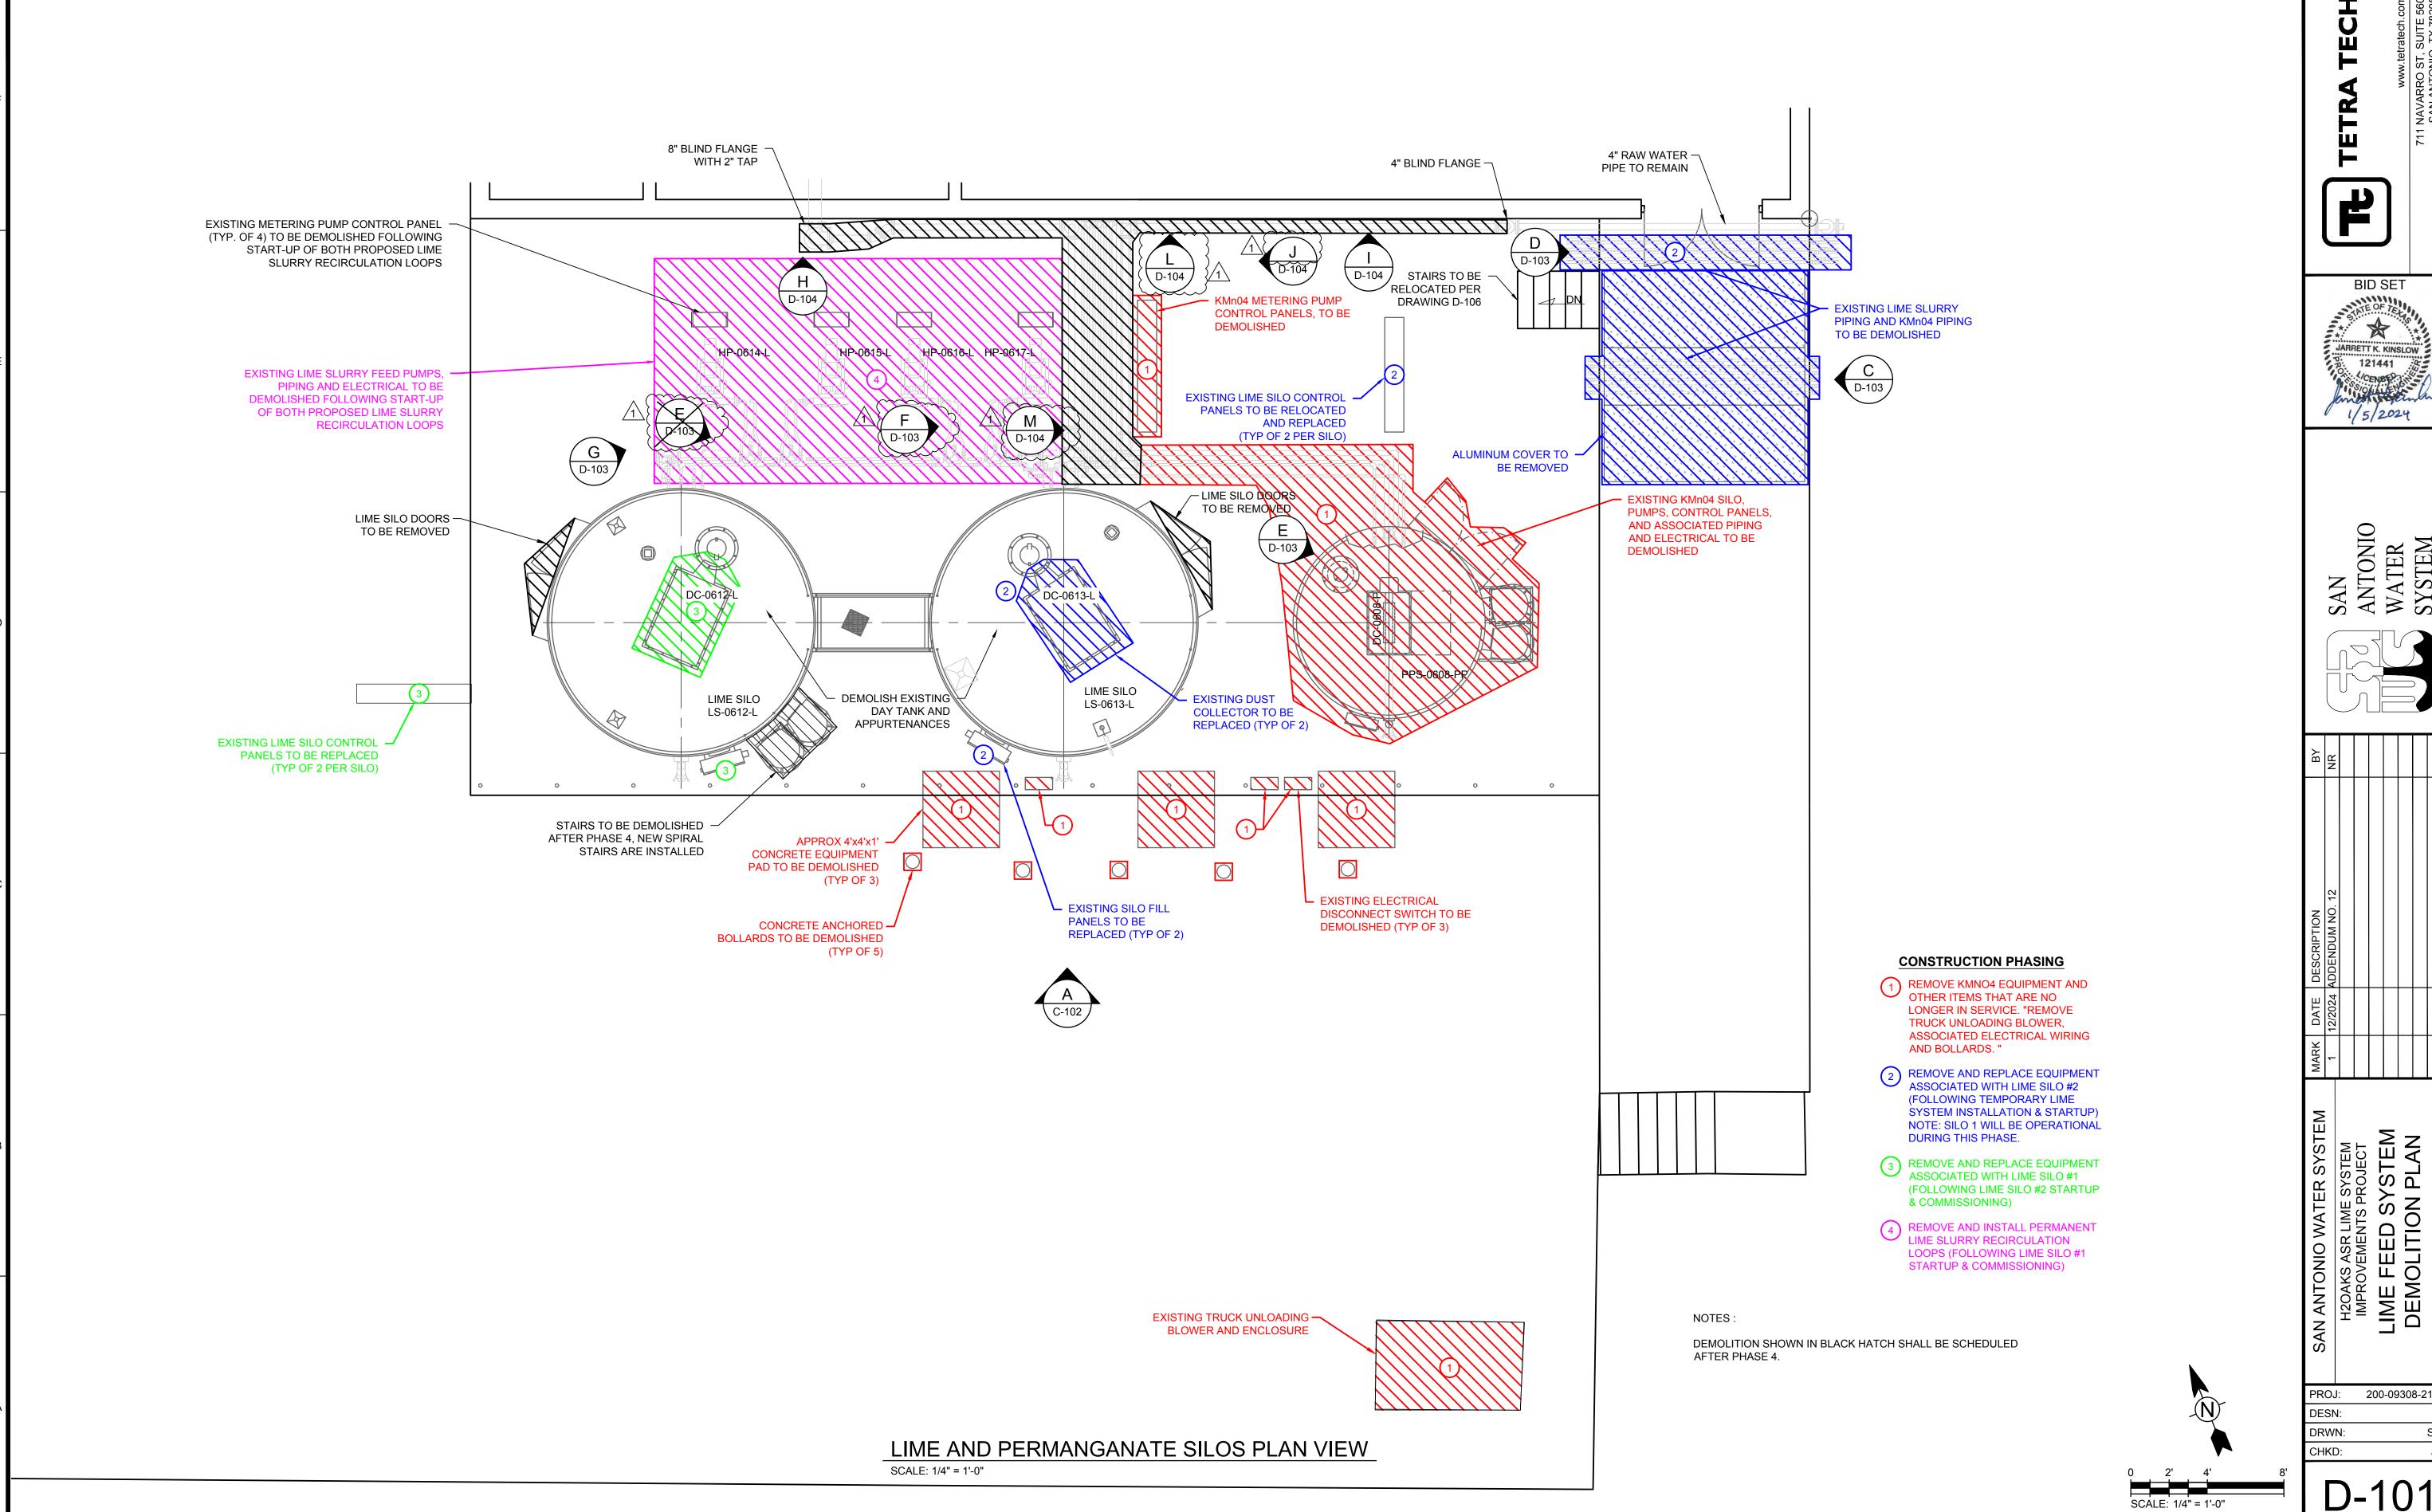
- a. Solvent weld connections are recommended by the manufacturer.
- b. Connect pipe and fittings only when temperature is above the minimum recommended by the manufacturer.
- c. Threaded adapters shall be connected only with plastic male into metal female.

## 3.03 INSPECTION AND TESTING

A. All CPVC pipe shall be pressure tested in accordance with Section 15014: Pressure Testing of Piping.


# 3.04 START-UP AND INSTRUCTION (Not Applicable)

## END OF SECTION



Bar Measures 1 inch, otherwise drawing not to scale

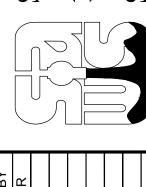BID SET JARRETT K. KINSLOW



PROJ: 200-09308-2100°

DRAWING INDEX						
SHEET NO	DRAWING NO	DRAWING TITLE				
	1	GENERAL				
1	G-000	COVER				
2	G-001	DRAWING INDEX				
3	G-002	GENERAL NOTES				
4	G-003	LEGEND AND ABBREVIATIONS				
5	G-004	WELL FIELD PROCESS FLOW DIAGRAM				
6	G-005	HIGH SERVICE PUMP STATION PROCESS FLOW DIAGRAM				
7	G-006	FLUORIDE SYSTEM PROCESS FLOW DIAGRAM				
8	G-007	OSHG SYSTEM PROCESS FLOW DIAGRAM				
9	G-008	SODIUM HYPOCHLORITE FEED SYSTEM PROCESS FLOW DIAGRAM				
		CIVIL/YARD PIPING				
10	C-001	CIVIL GENERAL NOTES AND LEGEND				
11	C-100	EXISTING SITE				
12	C-101	OVERBUILD PLAN				
13	C-102	ABOVEGROUND DEMOLITION				
14	C-103	UNDERGROUND DEMOLITION				
15	C-104	DEMOLITION PHOTOS I				
16	C-105	DEMOLITION PHOTOS II				
17	C-106	DEMOLITION PHOTOS III				
18	C-107	DEMOLITION PHOTOS IV				
19	C-108	NEW SITE LAYOUT PLAN				
20	C-109	EROSION CONTROL PLAN				
21	C-110	EROSION CONTROL DETAILS				
22	C-111	HORIZONTAL CONTROL PLAN				
23	C-112	GRADING PLAN				
24	C-113	UTILITY PLAN				
25	C-114	WATER PLAN AND PROFILE				
26	C-115	OVERFLOW DRAIN PLAN AND PROFILE				
27	C-116	JOINT LAYOUT PLAN				
28 29	C-117 C-118	PIPE A PLAN AND PROFILE				
30	+					
31	C-119 C-120	PIPE B PLAN AND PROFILE PIPES C & D PLAN AND PROFILE				
32	C-120 C-121	PIPES E & F PLAN AND PROFILE				
33	C-121 C-122	PIPES G & H PLAN AND PROFILE				
34	C-122	PIPE I PLAN AND PROFILE				
35	C-501	STANDARD CIVIL DETAILS I				
36	C-502	CONCRETE DRIVEWAY STANDARDS				
37	C-503	WHEELCHAIR RAMP STANDARDS				
38	C-504	COSA STANDARD 5' X 5' X 5' JUNCTION BOX				
39	C-505	SOUND BARRIER WALL DETAILS				
40	C-506	YARD PIPING DETAILS I				
41	C-507	YARD PIPING DETAILS II				
42	C-508	SITE SECTIONS I				
43	C-509	SITE SECTIONS II				
44	C-510	SITE SECTIONS III				
		LANDSCAPING				
45	L-101	TREE PRESERVATION PLAN				
46	L-102	TREE PRESERVATION SCHEDULE				
47	L-103	LANDSCAPE PLAN				
48	L-104	TREE PRESERVATION DETAILS				
		PROCESS				
49	D-001	PROCESS GENERAL NOTES, LEGEND AND ABBREVIATIONS				
50	D-002	VALVE SCHEDULE				
51	D-101	STATIC MIXER AND TANK OUTLET PLAN AND SECTION				
52	D-102	EXISTING 0.5 MG GST MODIFICATIONS				
53	D-201	WELL NO. 3 DISCHARGE PIPING PLAN & SECTIONS				
54	D-202	WELL NO. 4 DISCHARGE PIPING PLAN & SECTIONS				
55	D-203	WELL NO. 5 DISCHARGE PIPING PLAN & SECTIONS				
56	D-204	WELL NO. 6 DISCHARGE PIPING PLAN & SECTIONS				
57	D-301	OVERALL EQUIPMENT PLAN				
58	D-302	OSHG BLDG & BRINE TANK				
59	D-303	FLOURIDE BLDG, TANK & HYPO BULK STORAGE TANKS				
60	D-304	FLOURIDE BLDG & TANK SECTIONS				
61	D-305	HYPO BULK STORAGE TANKS SECTION				
62	D-306	OSHG BLDG & TANK I				
$\sim$ 63 $\sim$	D-307	OSHG BLDG & TANK II				
~ .	D-308	ADDITIONAL SECTIONS  HSP STATION SUCTION PIPING AND DISCHARGE PIPING				
64	<del> </del>	THE REPORT OF THE PROPERTY OF				
65	6-401					
65 66	D-401 D-402	HSP STATION SUCTION PIPING AND DISCHARGE PIPING SECTIONS				
65 66 67	D-401 D-402 D-501	HSP STATION SUCTION PIPING AND DISCHARGE PIPING SECTIONS PROCESS STANDARDS DETAILS I				
65 66 67 68	D-401 D-402 D-501 D-502	HSP STATION SUCTION PIPING AND DISCHARGE PIPING SECTIONS PROCESS STANDARDS DETAILS I PROCESS STANDARDS DETAILS II				
65 66 67 68 69	D-401 D-402 D-501 D-502 D-503	HSP STATION SUCTION PIPING AND DISCHARGE PIPING SECTIONS PROCESS STANDARDS DETAILS I PROCESS STANDARDS DETAILS II PROCESS STANDARDS DETAILS III				
65 66 67 68 69 70	D-401 D-402 D-501 D-502 D-503 D-504	HSP STATION SUCTION PIPING AND DISCHARGE PIPING SECTIONS PROCESS STANDARDS DETAILS II PROCESS STANDARDS DETAILS III PROCESS STANDARDS DETAILS III PROCESS STANDARDS DETAILS IV				
65 66 67 68 69 70 71	D-401 D-402 D-501 D-502 D-503 D-504 D-505	HSP STATION SUCTION PIPING AND DISCHARGE PIPING SECTIONS PROCESS STANDARDS DETAILS I PROCESS STANDARDS DETAILS III PROCESS STANDARDS DETAILS III PROCESS STANDARDS DETAILS IV PROCESS STANDARDS DETAILS V				
65 66 67 68 69 70 71 72	D-401 D-402 D-501 D-502 D-503 D-504 D-505 D-506	HSP STATION SUCTION PIPING AND DISCHARGE PIPING SECTIONS  PROCESS STANDARDS DETAILS II  PROCESS STANDARDS DETAILS III  PROCESS STANDARDS DETAILS IV  PROCESS STANDARDS DETAILS V  PROCESS STANDARDS DETAILS VI				
65 66 67 68 69 70 STATION SUCTION PIPING AND DISCHARGE PIPING SECTIONS  PROCESS STANDARDS DETAILS II  PROCESS STANDARDS DETAILS III  PROCESS STANDARDS DETAILS IV  PROCESS STANDARDS DETAILS V  PROCESS STANDARDS DETAILS VI  PROCESS STANDARDS DETAILS VII  WELL NO. 6 DETAIL  WELL CASING DETAIL				
65 66 67 68 69 70 71 72 73 74 75	D-401 D-402 D-501 D-502 D-503 D-504 D-505 D-506 D-507 D-508 D-509	HSP STATION SUCTION PIPING AND DISCHARGE PIPING SECTIONS PROCESS STANDARDS DETAILS II PROCESS STANDARDS DETAILS III PROCESS STANDARDS DETAILS IV PROCESS STANDARDS DETAILS V PROCESS STANDARDS DETAILS V PROCESS STANDARDS DETAILS VI PROCESS STANDARDS DETAILS VI WELL NO. 6 DETAIL WELL CASING DETAIL  ARCHITECTURAL				
65 66 67 68 69 70 71 72 73 74 75	D-401 D-402 D-501 D-502 D-503 D-504 D-505 D-506 D-507 D-508 D-509 A-301	HSP STATION SUCTION PIPING AND DISCHARGE PIPING SECTIONS PROCESS STANDARDS DETAILS II PROCESS STANDARDS DETAILS III PROCESS STANDARDS DETAILS IV PROCESS STANDARDS DETAILS IV PROCESS STANDARDS DETAILS V PROCESS STANDARDS DETAILS VI PROCESS STANDARDS DETAILS VII WELL NO. 6 DETAIL WELL CASING DETAIL OSHG CODE ANALYSIS & LIFE SAFETY PLAN				
65 66 67 68 69 70 71 72 73 74 75	D-401 D-402 D-501 D-502 D-503 D-504 D-505 D-506 D-507 D-508 D-509  A-301 A-302	HSP STATION SUCTION PIPING AND DISCHARGE PIPING SECTIONS PROCESS STANDARDS DETAILS II PROCESS STANDARDS DETAILS III PROCESS STANDARDS DETAILS IV PROCESS STANDARDS DETAILS IV PROCESS STANDARDS DETAILS V PROCESS STANDARDS DETAILS VI PROCESS STANDARDS DETAILS VI WELL NO. 6 DETAIL WELL CASING DETAIL  WELL CASING DETAIL OSHG CODE ANALYSIS & LIFE SAFETY PLAN OSHG BUILDING FLOOR PLAN				
65 66 67 68 69 70 71 72 73 74 75	D-401 D-402 D-501 D-502 D-503 D-504 D-505 D-506 D-507 D-508 D-509  A-301 A-302 A-303	HSP STATION SUCTION PIPING AND DISCHARGE PIPING SECTIONS  PROCESS STANDARDS DETAILS II  PROCESS STANDARDS DETAILS III  PROCESS STANDARDS DETAILS IV  PROCESS STANDARDS DETAILS V  PROCESS STANDARDS DETAILS V  PROCESS STANDARDS DETAILS VI  PROCESS STANDARDS DETAILS VII  WELL NO. 6 DETAIL  WELL CASING DETAIL  OSHG CODE ANALYSIS & LIFE SAFETY PLAN  OSHG BUILDING FLOOR PLAN  OSHG BUILDING REFLECTED CEILING PLAN				
65 66 67 68 69 70 71 72 73 74 75 76 77 78 79	D-401 D-402 D-501 D-502 D-503 D-504 D-505 D-506 D-507 D-508 D-509  A-301 A-302 A-303 A-304	HSP STATION SUCTION PIPING AND DISCHARGE PIPING SECTIONS PROCESS STANDARDS DETAILS II PROCESS STANDARDS DETAILS III PROCESS STANDARDS DETAILS IV PROCESS STANDARDS DETAILS V PROCESS STANDARDS DETAILS VI PROCESS STANDARDS DETAILS VI PROCESS STANDARDS DETAILS VII WELL NO. 6 DETAIL WELL CASING DETAIL WELL CASING DETAIL OSHG CODE ANALYSIS & LIFE SAFETY PLAN OSHG BUILDING FLOOR PLAN OSHG BUILDING ROOF PLAN				
65 66 67 68 69 70 71 72 73 74 75	D-401 D-402 D-501 D-502 D-503 D-504 D-505 D-506 D-507 D-508 D-509  A-301 A-302 A-303	HSP STATION SUCTION PIPING AND DISCHARGE PIPING SECTIONS  PROCESS STANDARDS DETAILS II  PROCESS STANDARDS DETAILS III  PROCESS STANDARDS DETAILS IV  PROCESS STANDARDS DETAILS V  PROCESS STANDARDS DETAILS V  PROCESS STANDARDS DETAILS VI  PROCESS STANDARDS DETAILS VII  WELL NO. 6 DETAIL  WELL CASING DETAIL  OSHG CODE ANALYSIS & LIFE SAFETY PLAN  OSHG BUILDING FLOOR PLAN  OSHG BUILDING REFLECTED CEILING PLAN				

02		
83	A-308	OSHG BUILDING SECTIONS
84	A-401	HSPS CODE ANALYSIS & LIFE SAFETY PLAN
85	A-402	HSPS BUILDING FLOOR PLAN
86	A-403	HSPS BUILDING REFLECTED CEILING PLAN
87	A-404	HSPS BUILDING ROOF PLAN
88	A-405	HSPS EXTERIOR ELEVATIONS
89	A-406	HSPS EXTERIOR ELEVATIONS
90	A-407	HSPS BUILDING SECTIONS
91	A-501	WALL SECTONS & DETAILS
92	A-502	SCHEDULES & DETAILS
93	A-503	3D AERIAL PERSPECTIVE
		STRUCTURAL
94	S-001	STRUCTURAL GENERAL NOTES
95	S-002	STRUCTURAL GENERAL NOTES
96	S-201	WELL'S SLAB - STRUCTURAL DETAILS
97	S-202	NEW STATIC MIXER AND CONCRETE FOUNDATION PLAN
98	S-301	NEW CHEMICAL BUILDING SLAB AND WALL PLAN
99	S-302	NEW CHEMICAL BUILDING FOUNDATION FRAMING PLAN
100	S-303	NEW CHEMICAL BUILDING - ROOF PLAN
101	S-304	NEW CHEMICAL BUILDING - FOUNDATION SECTION I
102	S-305	NEW CHEMICAL BUILDING - FOUNDATION SECTION II
103	S-306	NEW CHEMICAL BUILDING - FOUNDATION SECTION III
104	S-401	NEW HSPS/ELECTRICAL BUILDING - SLAB AND WALL PLAN
105	S-402	NEW HSPS/ELECTRICAL BUILDING - FOUNDATION PLAN
106	S-403	NEW HSPS/ELECTRICAL BUILDING - ROOF PLAN
107	S-404	NEW HSPS/ELECTRICAL BUILDING - FOUNDATION SECTIONS
108	S-405	NEW HSPS/ELECTRICAL BUILDING - FOUNDATION SECTIONS AND DETAILS
109	S-406	OVERHEAD BRIDGE CRANE PLAN AND SECTION
110	S-501	STRUCTURAL CONCRETE TYPICAL DETAILS
111	S-502	STRUCTURAL MASONRY TYPICAL DETAILS
112	S-503	STRUCTURAL HOLLOW CORE PLANK DETAILS
113	S-504	STAIR AND RAIL
		MECHANICAL
114	M-001	MECHANICAL SYMBOLS AND ABBREVIATIONS
115	M-301	CHEMICAL BUILDING PLAN
116	M-401	HSPS BUILDING PLAN
117	M-501	MECHANICAL SCHEDULES
118	M-502	MECHANICAL DETAILS
		PLUMBING
119	P-001	PLUMBING SYMBOLS AND ABBREVIATIONS
120	P-301	PLUMBING UNDERFLOOR PLAN
121	P-302	PLUMBING FLOOR PLAN
122	P-401	HSPS BUILDING UNDERFLOOR PLAN
123	P-501	PLUMBING SCHEMATIC AND SCHEDULES
124	P-502	PLUMBING STANDARD DETAILS
124	1 302	ELECTRICAL
405	F 004	
125 126	E-001 E-002	LEGENDS AND SYMBOLS - I  LEGENDS AND SYMBOLS - II
127	E-002	GENERAL NOTES
128	E-101	ELECTRICAL SITE PLAN -DEMOLITION
129	E-101	EXISTING ELECTRICAL EQUIPMENT ONE-LINE DIAGRAM DEMOLITION
130	E-103	DEMOLITION PHOTOGRAPHS - I
131	L 105	DEMOLITION PHOTOGRAPHS - II
	F-104	DEMOCRATION OF THE PROPERTY OF
132	E-104 F-105	DEMOLITION PHOTOGRAPHS - III
132 133	E-105	DEMOLITION PHOTOGRAPHS - III SITE PLAN MODIFICATION
133	E-105 E-106	SITE PLAN MODIFICATION
133 134	E-105 E-106 E-107	SITE PLAN MODIFICATION  SITE PLAN MODIFICATION ENLARGED VIEW - I
133 134 135	E-105 E-106 E-107 E-108	SITE PLAN MODIFICATION  SITE PLAN MODIFICATION ENLARGED VIEW - I  SITE PLAN MODIFICATION ENLARGED VIEW - II
133 134	E-105 E-106 E-107	SITE PLAN MODIFICATION  SITE PLAN MODIFICATION ENLARGED VIEW - I
133 134 135 136	E-105 E-106 E-107 E-108 E-109	SITE PLAN MODIFICATION  SITE PLAN MODIFICATION ENLARGED VIEW - I  SITE PLAN MODIFICATION ENLARGED VIEW - II  DUCTBANK SECTIONS - I
133 134 135 136 137	E-105 E-106 E-107 E-108 E-109 E-110	SITE PLAN MODIFICATION  SITE PLAN MODIFICATION ENLARGED VIEW - I  SITE PLAN MODIFICATION ENLARGED VIEW - II  DUCTBANK SECTIONS - I  DUCTBANK SECTIONS - II
133 134 135 136 137 138	E-105 E-106 E-107 E-108 E-109 E-110 E-111	SITE PLAN MODIFICATION  SITE PLAN MODIFICATION ENLARGED VIEW - I  SITE PLAN MODIFICATION ENLARGED VIEW - II  DUCTBANK SECTIONS - I  DUCTBANK SECTIONS - III  DUCTBANK SECTIONS - III
133 134 135 136 137 138 139	E-105 E-106 E-107 E-108 E-109 E-110 E-111 E-112	133 134 135 136 137 138 139 140 141	E-105 E-106 E-107 E-108 E-109 E-110 E-111 E-112 E-113 E-114 E-115	SITE PLAN MODIFICATION  SITE PLAN MODIFICATION ENLARGED VIEW - I  SITE PLAN MODIFICATION ENLARGED VIEW - II  DUCTBANK SECTIONS - I  DUCTBANK SECTIONS - III  DUCTBANK SECTIONS - III  MCC-HS ONE-LINE DIAGRAM  MCC ELEVATION  PANELBOARD SCHEDULE  HSPS ELECTRICAL ROOM - POWER PLAN
133 134 135 136 137 138 139 140 141 142 143	E-105 E-106 E-107 E-108 E-109 E-110 E-111 E-112 E-113 E-114 E-115 E-116	SITE PLAN MODIFICATION  SITE PLAN MODIFICATION ENLARGED VIEW - I  SITE PLAN MODIFICATION ENLARGED VIEW - II  DUCTBANK SECTIONS - I  DUCTBANK SECTIONS - III  DUCTBANK SECTIONS - III  MCC-HS ONE-LINE DIAGRAM  MCC ELEVATION  PANELBOARD SCHEDULE  HSPS ELECTRICAL ROOM - POWER PLAN  HSPS ELECTRICAL ROOM - LIGTHING PLAN
133 134 135 136 137 138 139 140 141 142 143 144	E-105 E-106 E-107 E-108 E-109 E-110 E-111 E-112 E-113 E-114 E-115 E-116 E-117	SITE PLAN MODIFICATION  SITE PLAN MODIFICATION ENLARGED VIEW - I  SITE PLAN MODIFICATION ENLARGED VIEW - II  DUCTBANK SECTIONS - I  DUCTBANK SECTIONS - III  DUCTBANK SECTIONS - III  MCC-HS ONE-LINE DIAGRAM  MCC ELEVATION  PANELBOARD SCHEDULE  HSPS ELECTRICAL ROOM - POWER PLAN  HSPS MECHANICAL ROOM - POWER AND CONTROL PLAN
133 134 135 136 137 138 139 140 141 142 143 144 145	E-105 E-106 E-107 E-108 E-109 E-110 E-111 E-112 E-113 E-114 E-115 E-116 E-117 E-118	SITE PLAN MODIFICATION  SITE PLAN MODIFICATION ENLARGED VIEW - I  SITE PLAN MODIFICATION ENLARGED VIEW - II  DUCTBANK SECTIONS - I  DUCTBANK SECTIONS - III  DUCTBANK SECTIONS - III  MCC-HS ONE-LINE DIAGRAM  MCC ELEVATION  PANELBOARD SCHEDULE  HSPS ELECTRICAL ROOM - POWER PLAN  HSPS MECHANICAL ROOM - POWER AND CONTROL PLAN  HSPS MECHANICAL ROOM - LIGHTING PLAN
133 134 135 136 137 138 139 140 141 142 143 144 145 146	E-105 E-106 E-107 E-108 E-109 E-110 E-111 E-112 E-113 E-114 E-115 E-116 E-117 E-118 E-119	SITE PLAN MODIFICATION  SITE PLAN MODIFICATION ENLARGED VIEW - I  SITE PLAN MODIFICATION ENLARGED VIEW - II  DUCTBANK SECTIONS - I  DUCTBANK SECTIONS - III  DUCTBANK SECTIONS - III  MCC-HS ONE-LINE DIAGRAM  MCC ELEVATION  PANELBOARD SCHEDULE  HSPS ELECTRICAL ROOM - POWER PLAN  HSPS MECHANICAL ROOM - LIGTHING PLAN  HSPS MECHANICAL ROOM - LIGHTING PLAN  HSPS MECHANICAL ROOM - LIGHTING PLAN  HSPS MECHANICAL ROOM - LIGHTING PLAN  HIGH SERVICE PUMP STATION - GROUNDING PLAN
133 134 135 136 137 138 139 140 141 142 143 144 145 146 147	E-105 E-106 E-107 E-108 E-109 E-110 E-111 E-112 E-113 E-114 E-115 E-116 E-117 E-118 E-119 E-120	SITE PLAN MODIFICATION  SITE PLAN MODIFICATION ENLARGED VIEW - II  SITE PLAN MODIFICATION ENLARGED VIEW - II  DUCTBANK SECTIONS - II  DUCTBANK SECTIONS - III  DUCTBANK SECTIONS - III  MCC-HS ONE-LINE DIAGRAM  MCC ELEVATION  PANELBOARD SCHEDULE  HSPS ELECTRICAL ROOM - POWER PLAN  HSPS ELECTRICAL ROOM - LIGTHING PLAN  HSPS MECHANICAL ROOM - LIGTHING PLAN  HSPS MECHANICAL ROOM - LIGHTING PLAN  HIGH SERVICE PUMP STATION - GROUNDING PLAN  HIGH SERVICE PUMP AREA RISER DIAGRAM
133 134 135 136 137 138 139 140 141 142 143 144 145 146 147 148	E-105 E-106 E-107 E-108 E-109 E-110 E-111 E-112 E-113 E-114 E-115 E-116 E-117 E-118 E-119 E-120 E-121	SITE PLAN MODIFICATION  SITE PLAN MODIFICATION ENLARGED VIEW - I  SITE PLAN MODIFICATION ENLARGED VIEW - II  DUCTBANK SECTIONS - I  DUCTBANK SECTIONS - II  DUCTBANK SECTIONS - III  MCC-HS ONE-LINE DIAGRAM  MCC ELEVATION  PANELBOARD SCHEDULE  HSPS ELECTRICAL ROOM - POWER PLAN  HSPS ELECTRICAL ROOM - LIGTHING PLAN  HSPS MECHANICAL ROOM - POWER AND CONTROL PLAN  HSPS MECHANICAL ROOM - LIGHTING PLAN  HIGH SERVICE PUMP STATION - GROUNDING PLAN  HIGH SERVICE PUMP AREA RISER DIAGRAM  OVERALL SECURITY RISER DIAGRAM
133 134 135 136 137 138 139 140 141 142 143 144 145 146 147 148	E-105 E-106 E-107 E-108 E-109 E-110 E-111 E-112 E-113 E-114 E-115 E-116 E-117 E-118 E-119 E-120 E-121 E-201	SITE PLAN MODIFICATION  SITE PLAN MODIFICATION ENLARGED VIEW - I  SITE PLAN MODIFICATION ENLARGED VIEW - II  DUCTBANK SECTIONS - I  DUCTBANK SECTIONS - III  DUCTBANK SECTIONS - III  MCC-HS ONE-LINE DIAGRAM  MCC ELEVATION  PANELBOARD SCHEDULE  HSPS ELECTRICAL ROOM - POWER PLAN  HSPS ELECTRICAL ROOM - LIGHTING PLAN  HSPS MECHANICAL ROOM - POWER AND CONTROL PLAN  HSPS MECHANICAL ROOM - LIGHTING PLAN  HIGH SERVICE PUMP STATION - GROUNDING PLAN  HIGH SERVICE PUMP AREA RISER DIAGRAM  OVERALL SECURITY RISER DIAGRAM  WELL PUMP NO.3 POWER PLAN
133 134 135 136 137 138 139 140 141 142 143 144 145 146 147 148 149 150 151	E-105 E-106 E-107 E-108 E-109 E-110 E-111 E-112 E-113 E-114 E-115 E-116 E-117 E-118 E-119 E-120 E-121 E-201 E-202 E-203 E-203 E-204	SITE PLAN MODIFICATION  SITE PLAN MODIFICATION ENLARGED VIEW - I  SITE PLAN MODIFICATION ENLARGED VIEW - II  DUCTBANK SECTIONS - I  DUCTBANK SECTIONS - III  MCC-HS ONE-LINE DIAGRAM  MCC ELEVATION  PANELBOARD SCHEDULE  HSPS ELECTRICAL ROOM - POWER PLAN  HSPS ELECTRICAL ROOM - LIGTHING PLAN  HSPS MECHANICAL ROOM - POWER AND CONTROL PLAN  HSPS MECHANICAL ROOM - LIGHTING PLAN  HIGH SERVICE PUMP STATION - GROUNDING PLAN  HIGH SERVICE PUMP AREA RISER DIAGRAM  OVERALL SECURITY RISER DIAGRAM  WELL PUMP NO.3 POWER PLAN  WELL PUMP NO.4 POWER PLAN
133 134 135 136 137 138 139 140 141 142 143 144 145 146 147 148 149 150 151 152 153	E-105 E-106 E-107 E-108 E-109 E-110 E-111 E-112 E-113 E-114 E-115 E-116 E-117 E-118 E-119 E-120 E-121 E-201 E-202 E-203 E-204 E-205	SITE PLAN MODIFICATION  SITE PLAN MODIFICATION ENLARGED VIEW - I  SITE PLAN MODIFICATION ENLARGED VIEW - II  DUCTBANK SECTIONS - II  DUCTBANK SECTIONS - III  MCC-HS ONE-LINE DIAGRAM  MCC ELEVATION  PANELBOARD SCHEDULE  HSPS ELECTRICAL ROOM - POWER PLAN  HSPS ELECTRICAL ROOM - LIGTHING PLAN  HSPS MECHANICAL ROOM - LIGHTING PLAN  HSPS MECHANICAL ROOM - LIGHTING PLAN  HIGH SERVICE PUMP STATION - GROUNDING PLAN  HIGH SERVICE PUMP AREA RISER DIAGRAM  OVERALL SECURITY RISER DIAGRAM  WELL PUMP NO.3 POWER PLAN  WELL PUMP NO.4 POWER PLAN  WELL PUMP NO.5 POWER PLAN
133 134 135 E-105 E-106 E-107 E-108 E-109 E-110 E-111 E-112 E-113 E-114 E-115 E-116 E-117 E-118 E-119 E-120 E-121 E-201 E-202 E-203 E-203 E-204	SITE PLAN MODIFICATION  SITE PLAN MODIFICATION ENLARGED VIEW - I  SITE PLAN MODIFICATION ENLARGED VIEW - II  DUCTBANK SECTIONS - I  DUCTBANK SECTIONS - III  DUCTBANK SECTIONS - III  MCC-HS ONE-LINE DIAGRAM  MCC ELEVATION  PANELBOARD SCHEDULE  HSPS ELECTRICAL ROOM - POWER PLAN  HSPS ELECTRICAL ROOM - LIGTHING PLAN  HSPS MECHANICAL ROOM - POWER AND CONTROL PLAN  HSPS MECHANICAL ROOM - LIGHTING PLAN  HIGH SERVICE PUMP STATION - GROUNDING PLAN  HIGH SERVICE PUMP AREA RISER DIAGRAM  OVERALL SECURITY RISER DIAGRAM  WELL PUMP NO.3 POWER PLAN  WELL PUMP NO.5 POWER PLAN  WELL PUMP NO.5 POWER PLAN  WELL PUMP NO.5 POWER PLAN  WELL PUMP NO.6 POWER PLAN
133 134 135 136 137 138 139 140 141 142 143 144 145 146 147 148 149 150 151 152 153	E-105 E-106 E-107 E-108 E-109 E-110 E-111 E-112 E-113 E-114 E-115 E-116 E-117 E-118 E-119 E-120 E-121 E-201 E-202 E-203 E-204 E-205	SITE PLAN MODIFICATION  SITE PLAN MODIFICATION ENLARGED VIEW - I  SITE PLAN MODIFICATION ENLARGED VIEW - II  DUCTBANK SECTIONS - II  DUCTBANK SECTIONS - III  DUCTBANK SECTIONS - III  MCC-HS ONE-LINE DIAGRAM  MCC ELEVATION  PANELBOARD SCHEDULE  HSPS ELECTRICAL ROOM - POWER PLAN  HSPS ELECTRICAL ROOM - POWER PLAN  HSPS MECHANICAL ROOM - POWER AND CONTROL PLAN  HSPS MECHANICAL ROOM - POWER AND CONTROL PLAN  HIGH SERVICE PUMP STATION - GROUNDING PLAN  HIGH SERVICE PUMP AREA RISER DIAGRAM  OVERALL SECURITY RISER DIAGRAM  WELL PUMP NO.3 POWER PLAN  WELL PUMP NO.5 POWER PLAN  WELL PUMP NO.5 POWER PLAN  WELL PUMP NO.6 POWER PLAN
133 134 135 E-105 E-106 E-107 E-108 E-109 E-110 E-111 E-112 E-113 E-114 E-115 E-116 E-117 E-118 E-119 E-120 E-121 E-201 E-202 E-203 E-204 E-205 E-205 E-206	SITE PLAN MODIFICATION  SITE PLAN MODIFICATION ENLARGED VIEW - I  SITE PLAN MODIFICATION ENLARGED VIEW - II  DUCTBANK SECTIONS - I  DUCTBANK SECTIONS - II  DUCTBANK SECTIONS - III  MCC-HS ONE-LINE DIAGRAM  MCC ELEVATION  PANELBOARD SCHEDULE  HSPS ELECTRICAL ROOM - POWER PLAN  HSPS ELECTRICAL ROOM - POWER PLAN  HSPS MECHANICAL ROOM - POWER AND CONTROL PLAN  HSPS MECHANICAL ROOM - LIGHTING PLAN  HIGH SERVICE PUMP STATION - GROUNDING PLAN  HIGH SERVICE PUMP AREA RISER DIAGRAM  OVERALL SECURITY RISER DIAGRAM  WELL PUMP NO.3 POWER PLAN  WELL PUMP NO.4 POWER PLAN  WELL PUMP NO.5 POWER PLAN  WELL PUMP NO.6 POWER PLAN  WELL PUMP NO.6 POWER PLAN  WELL PUMP AREA RISER DIAGRAM  WELL PUMP NO.6 POWER PLAN  WELL PUMP AREA RISER DIAGRAM
133 134 135 E-105 E-106 E-107 E-108 E-109 E-110 E-111 E-112 E-113 E-114 E-115 E-116 E-117 E-118 E-119 E-120 E-121 E-201 E-202 E-203 E-204 E-205 E-205 E-206 E-207 E-301 E-302	SITE PLAN MODIFICATION  SITE PLAN MODIFICATION ENLARGED VIEW - I  SITE PLAN MODIFICATION ENLARGED VIEW - II  DUCTBANK SECTIONS - I  DUCTBANK SECTIONS - III  DUCTBANK SECTIONS - III  MCC-HS ONE-LINE DIAGRAM  MCC ELEVATION  PANELBOARD SCHEDULE  HSPS ELECTRICAL ROOM - POWER PLAN  HSPS ELECTRICAL ROOM - LIGTHING PLAN  HSPS MECHANICAL ROOM - LIGHTHING PLAN  HSPS MECHANICAL ROOM - LIGHTHING PLAN  HIGH SERVICE PUMP STATION - GROUNDING PLAN  HIGH SERVICE PUMP AREA RISER DIAGRAM  OVERALL SECURITY RISER DIAGRAM  WELL PUMP NO.3 POWER PLAN  WELL PUMP NO.5 POWER PLAN  WELL PUMP NO.5 POWER PLAN  WELL PUMP NO.6 POWER PLAN  WELL PUMP NO.6 POWER PLAN  WELL PUMP AREA RISER DIAGRAM  WELL PUMP DETAILS  INTERFACE DIAGRAM - I  MCC-OSHG ONE-LINE DIAGRAM  MCC ELEVATION
133 134 135 E-105 E-106 E-107 E-108 E-109 E-110 E-111 E-112 E-113 E-114 E-115 E-116 E-117 E-118 E-119 E-120 E-121 E-201 E-202 E-203 E-204 E-205 E-206 E-207 E-301 E-302 E-303	SITE PLAN MODIFICATION  SITE PLAN MODIFICATION ENLARGED VIEW - I  SITE PLAN MODIFICATION ENLARGED VIEW - II  DUCTBANK SECTIONS - I  DUCTBANK SECTIONS - II  DUCTBANK SECTIONS - III  MCC-HS ONE-LINE DIAGRAM  MCC ELEVATION  PANELBOARD SCHEDULE  HSPS ELECTRICAL ROOM - POWER PLAN  HSPS ELECTRICAL ROOM - LIGTHING PLAN  HSPS MECHANICAL ROOM - LIGHTING PLAN  HIGH SERVICE PUMP STATION - GROUNDING PLAN  HIGH SERVICE PUMP AREA RISER DIAGRAM  OVERALL SECURITY RISER DIAGRAM  WELL PUMP NO.3 POWER PLAN  WELL PUMP NO.5 POWER PLAN  WELL PUMP NO.5 POWER PLAN  WELL PUMP NO.6 POWER PLAN  WELL PUMP AREA RISER DIAGRAM  WELL PUMP NO.6 POWER PLAN  WELL PUMP AREA RISER DIAGRAM  WELL PUMP AREA RISER DIAGRAM  WELL PUMP AREA RISER DIAGRAM  WELL PUMP DO.6 POWER PLAN  WELL PUMP AREA RISER DIAGRAM  WELL PUMP DO.6 POWER PLAN  WELL PUMP AREA RISER DIAGRAM  WELL PUMP DO.6 POWER PLAN  WELL PUMP DO.6 POWER PLAN  WELL PUMP AREA RISER DIAGRAM  WELL PUMP DO.6 POWER PLAN  WELL PUMP DO.6 PLAN  WELL PUMP DO.6 PLAN  WELL PUMP DO.6 PLAN
133 134 135 E-105 E-106 E-107 E-108 E-109 E-110 E-111 E-112 E-113 E-114 E-115 E-116 E-117 E-118 E-119 E-120 E-121 E-201 E-202 E-203 E-204 E-205 E-206 E-207 E-301 E-302 E-303 E-304	SITE PLAN MODIFICATION SITE PLAN MODIFICATION ENLARGED VIEW - I SITE PLAN MODIFICATION ENLARGED VIEW - II DUCTBANK SECTIONS - I DUCTBANK SECTIONS - III DUCTBANK SECTIONS - III MCC-HS ONE-LINE DIAGRAM MCC ELEVATION PANELBOARD SCHEDULE HSPS ELECTRICAL ROOM - POWER PLAN HSPS ELECTRICAL ROOM - POWER PLAN HSPS MECHANICAL ROOM - POWER AND CONTROL PLAN HSPS MECHANICAL ROOM - LIGHTING PLAN HIGH SERVICE PUMP STATION - GROUNDING PLAN HIGH SERVICE PUMP AREA RISER DIAGRAM OVERALL SECURITY RISER DIAGRAM WELL PUMP NO.3 POWER PLAN WELL PUMP NO.4 POWER PLAN WELL PUMP NO.5 POWER PLAN WELL PUMP NO.6 POWER PLAN WELL PUMP NO.6 POWER PLAN WELL PUMP PAREA RISER DIAGRAM WELL PUMP DETAILS INTERFACE DIAGRAM WELL PUMP DETAILS INTERFACE DIAGRAM - I MCC-OSHG ONE-LINE DIAGRAM MCC ELEVATION 480V PANEL PC ONE-LINE DIAGRAM PANELBOARD SCHEDULES
133 134 135 E-105 E-106 E-107 E-108 E-109 E-110 E-111 E-112 E-113 E-114 E-115 E-116 E-117 E-118 E-119 E-120 E-121 E-201 E-202 E-203 E-204 E-205 E-206 E-207 E-301 E-302 E-303	SITE PLAN MODIFICATION  SITE PLAN MODIFICATION ENLARGED VIEW - I  SITE PLAN MODIFICATION ENLARGED VIEW - II  DUCTBANK SECTIONS - I  DUCTBANK SECTIONS - II  DUCTBANK SECTIONS - III  MCC-HS ONE-LINE DIAGRAM  MCC ELEVATION  PANELBOARD SCHEDULE  HSPS ELECTRICAL ROOM - POWER PLAN  HSPS ELECTRICAL ROOM - LIGTHING PLAN  HSPS MECHANICAL ROOM - LIGHTING PLAN  HIGH SERVICE PUMP STATION - GROUNDING PLAN  HIGH SERVICE PUMP AREA RISER DIAGRAM  OVERALL SECURITY RISER DIAGRAM  WELL PUMP NO.3 POWER PLAN  WELL PUMP NO.5 POWER PLAN  WELL PUMP NO.5 POWER PLAN  WELL PUMP NO.6 POWER PLAN  WELL PUMP AREA RISER DIAGRAM  WELL PUMP NO.6 POWER PLAN  WELL PUMP AREA RISER DIAGRAM  WELL PUMP AREA RISER DIAGRAM  WELL PUMP AREA RISER DIAGRAM  WELL PUMP DO.6 POWER PLAN  WELL PUMP AREA RISER DIAGRAM  WELL PUMP DO.6 POWER PLAN  WELL PUMP AREA RISER DIAGRAM  WELL PUMP DO.6 POWER PLAN  WELL PUMP DO.6 POWER PLAN  WELL PUMP AREA RISER DIAGRAM  WELL PUMP DO.6 POWER PLAN  WELL PUMP DO.6 PLAN  WELL PUMP DO.6 PLAN  WELL PUMP DO.6 PLAN
133 134 135 E-105 E-106 E-107 E-108 E-109 E-110 E-111 E-112 E-113 E-114 E-115 E-116 E-117 E-118 E-119 E-120 E-121 E-201 E-202 E-203 E-204 E-205 E-206 E-207 E-301 E-302 E-303 E-304	SITE PLAN MODIFICATION SITE PLAN MODIFICATION ENLARGED VIEW - I SITE PLAN MODIFICATION ENLARGED VIEW - II DUCTBANK SECTIONS - I DUCTBANK SECTIONS - III DUCTBANK SECTIONS - III MCC-HS ONE-LINE DIAGRAM MCC ELEVATION PANELBOARD SCHEDULE HSPS ELECTRICAL ROOM - POWER PLAN HSPS ELECTRICAL ROOM - POWER PLAN HSPS MECHANICAL ROOM - POWER AND CONTROL PLAN HSPS MECHANICAL ROOM - LIGHTING PLAN HIGH SERVICE PUMP STATION - GROUNDING PLAN HIGH SERVICE PUMP AREA RISER DIAGRAM OVERALL SECURITY RISER DIAGRAM WELL PUMP NO.3 POWER PLAN WELL PUMP NO.4 POWER PLAN WELL PUMP NO.5 POWER PLAN WELL PUMP NO.6 POWER PLAN WELL PUMP NO.6 POWER PLAN WELL PUMP PAREA RISER DIAGRAM WELL PUMP DETAILS INTERFACE DIAGRAM WELL PUMP DETAILS INTERFACE DIAGRAM - I MCC-OSHG ONE-LINE DIAGRAM MCC ELEVATION 480V PANEL PC ONE-LINE DIAGRAM PANELBOARD SCHEDULES
133 134 135 E-105 E-106 E-107 E-108 E-109 E-110 E-111 E-112 E-113 E-114 E-115 E-116 E-117 E-118 E-119 E-120 E-121 E-201 E-202 E-203 E-204 E-205 E-206 E-207 E-301 E-302 E-303 E-304 E-305	SITE PLAN MODIFICATION  SITE PLAN MODIFICATION ENLARGED VIEW - I  SITE PLAN MODIFICATION ENLARGED VIEW - II  DUCTBANK SECTIONS - I  DUCTBANK SECTIONS - III  DUCTBANK SECTIONS - III  MCC-HS ONE-LINE DIAGRAM  MCC ELEVATION  PANELBOARD SCHEDULE  HSPS ELECTRICAL ROOM - POWER PLAN  HSPS ELECTRICAL ROOM - POWER PLAN  HSPS MECHANICAL ROOM - POWER AND CONTROL PLAN  HSPS MECHANICAL ROOM - LIGHTING PLAN  HIGH SERVICE PUMP STATION - GROUNDING PLAN  HIGH SERVICE PUMP AREA RISER DIAGRAM  WELL PUMP NO.3 POWER PLAN  WELL PUMP NO.4 POWER PLAN  WELL PUMP NO.5 POWER PLAN  WELL PUMP NO.6 POWER PLAN  WELL PUMP NO.6 POWER PLAN  WELL PUMP DETAILS  INTERFACE DIAGRAM  WELL PUMP DETAILS  INTERFACE DIAGRAM  MCC ELEVATION  480V PANEL PC ONE-LINE DIAGRAM  PANELBOARD SCHEDULES  OSHG BUILDING OVERALL PLAN
133 134 135 163	E-105 E-106 E-107 E-108 E-109 E-110 E-111 E-112 E-113 E-114 E-115 E-116 E-117 E-118 E-119 E-120 E-121 E-201 E-202 E-203 E-204 E-205 E-206 E-207 E-301 E-302 E-303 E-304 E-305 E-306 E-307 E-308	SITE PLAN MODIFICATION SITE PLAN MODIFICATION ENLARGED VIEW - I SITE PLAN MODIFICATION ENLARGED VIEW - II DUCTBANK SECTIONS - I DUCTBANK SECTIONS - II DUCTBANK SECTIONS - III MCC-HS ONE-LINE DIAGRAM MCC ELEVATION PANELBOARD SCHEDULE HSPS ELECTRICAL ROOM - POWER PLAN HSPS ELECTRICAL ROOM - POWER AND CONTROL PLAN HSPS MECHANICAL ROOM - LIGHTING PLAN HIGH SERVICE PUMP STATION - GROUNDING PLAN HIGH SERVICE PUMP AREA RISER DIAGRAM OVERALL SECURITY RISER DIAGRAM WELL PUMP NO.3 POWER PLAN WELL PUMP NO.4 POWER PLAN WELL PUMP NO.5 POWER PLAN WELL PUMP NO.5 POWER PLAN WELL PUMP NO.6 POWER PLAN WELL PUMP AREA RISER DIAGRAM MCC ELEVATION  480V PANEL PC ONE-LINE DIAGRAM PANELBOARD SCHEDULES OSHG BUILDING OVERALL PLAN OSHG BUILDING OVER PLAN - I OSHG BUILDING POWER PLAN - I
133 134 135 E-105 E-106 E-107 E-108 E-109 E-110 E-111 E-112 E-113 E-114 E-115 E-116 E-117 E-118 E-119 E-120 E-121 E-201 E-202 E-203 E-204 E-205 E-206 E-207 E-301 E-302 E-303 E-304 E-305 E-306 E-307	SITE PLAN MODIFICATION  SITE PLAN MODIFICATION ENLARGED VIEW - I  SITE PLAN MODIFICATION ENLARGED VIEW - II  DUCTBANK SECTIONS - I  DUCTBANK SECTIONS - III  DUCTBANK SECTIONS - III  MCC-HS ONE-LINE DIAGRAM  MCC ELEVATION  PANELBOARD SCHEDULE  HSPS ELECTRICAL ROOM - POWER PLAN  HSPS ELECTRICAL ROOM - POWER PLAN  HSPS MECHANICAL ROOM - POWER AND CONTROL PLAN  HIGH SERVICE PUMP STATION - GROUNDING PLAN  HIGH SERVICE PUMP AREA RISER DIAGRAM  OVERALL SECURITY RISER DIAGRAM  WELL PUMP NO.3 POWER PLAN  WELL PUMP NO.5 POWER PLAN  WELL PUMP NO.5 POWER PLAN  WELL PUMP AREA RISER DIAGRAM  WELL PUMP NO.6 POWER PLAN  WELL PUMP AREA RISER DIAGRAM  WELL PUMP AREA RISER DIAGRAM  WELL PUMP PATALIS  INTERFACE DIAGRAM - I  MCC-OSHG ONE-LINE DIAGRAM  MCC ELEVATION  480V PANEL PC ONE-LINE DIAGRAM  PANELBOARD SCHEDULES  OSHG BUILDING OVERALL PLAN  OSHG BUILDING OVER PLAN - I
133 134 135 165	E-105 E-106 E-107 E-108 E-109 E-110 E-111 E-112 E-113 E-114 E-115 E-116 E-117 E-118 E-119 E-120 E-121 E-201 E-202 E-203 E-204 E-205 E-206 E-207 E-301 E-305 E-306 E-307 E-308 E-307 E-308 E-309 E-310	SITE PLAN MODIFICATION  SITE PLAN MODIFICATION ENLARGED VIEW - I  SITE PLAN MODIFICATION ENLARGED VIEW - II  DUCTBANK SECTIONS - II  DUCTBANK SECTIONS - III  MCC-HS ONE-LINE DIAGRAM  MCC ELEVATION  PANELBOARD SCHEDULE  HSPS ELECTRICAL ROOM - POWER PLAN  HSPS ELECTRICAL ROOM - LIGHTING PLAN  HSPS MECHANICAL ROOM - LIGHTING PLAN  HSPS MECHANICAL ROOM - LIGHTING PLAN  HIGH SERVICE PUMP STATION - GROUNDING PLAN  HIGH SERVICE PUMP STATION - GROUNDING PLAN  WELL PUMP NO.3 POWER PLAN  WELL PUMP NO.5 POWER PLAN  WELL PUMP NO.5 POWER PLAN  WELL PUMP NO.6 POWER PLAN  WELL PUMP DETAILS  INTERFACE DIAGRAM - I  MCC-OSHG ONE-LINE DIAGRAM  MCC ELEVATION  480V PANEL PC ONE-LINE DIAGRAM  PANELBOARD SCHEDULES  OSHG BUILDING OVERALL PLAN  OSHG BUILDING POWER PLAN - II  OSHG BUILDING POWER PLAN - II  OSHG BUILDING CONTROL PLAN - II
133 134 135 164	E-105 E-106 E-107 E-108 E-109 E-110 E-111 E-112 E-113 E-114 E-115 E-116 E-117 E-118 E-119 E-120 E-121 E-201 E-202 E-203 E-204 E-205 E-206 E-207 E-301 E-302 E-303 E-304 E-305 E-306 E-307 E-308 E-307 E-308 E-309	SITE PLAN MODIFICATION  SITE PLAN MODIFICATION ENLARGED VIEW - I  SITE PLAN MODIFICATION ENLARGED VIEW - II  DUCTBANK SECTIONS - II  DUCTBANK SECTIONS - III  MCC-HS ONE-LINE DIAGRAM  MCC ELEVATION  PANELBOARD SCHEDULE  HSPS ELECTRICAL ROOM - POWER PLAN  HSPS ELECTRICAL ROOM - LIGHTING PLAN  HSPS MECHANICAL ROOM - LIGHTING PLAN  HIGH SERVICE PUMP STATION - GROUNDING PLAN  HIGH SERVICE PUMP AREA RISER DIAGRAM  OVERALL SECURITY RISER DIAGRAM  WELL PUMP NO.3 POWER PLAN  WELL PUMP NO.5 POWER PLAN  WELL PUMP NO.5 POWER PLAN  WELL PUMP NO.6 POWER PLAN  WELL PUMP AREA RISER DIAGRAM  WELL PUMP AREA RISER DIAGRAM  WELL PUMP AREA RISER DIAGRAM  WELL PUMP NO.6 POWER PLAN  WELL PUMP AREA RISER DIAGRAM  WELL PUMP DETAILS  INTERFACE DIAGRAM - I  MCC-OSHG ONE-LINE DIAGRAM  MCC ELEVATION  480V PANEL PC ONE-LINE DIAGRAM  PANELBOARD SCHEDULES  OSHG BUILDING OVERR PLAN - I  OSHG BUILDING POWER PLAN - II
133 134 135 165	E-105 E-106 E-107 E-108 E-109 E-110 E-111 E-112 E-113 E-114 E-115 E-116 E-117 E-118 E-119 E-120 E-121 E-201 E-202 E-203 E-204 E-205 E-206 E-207 E-301 E-305 E-306 E-307 E-308 E-307 E-308 E-309 E-310	SITE PLAN MODIFICATION  SITE PLAN MODIFICATION ENLARGED VIEW - I  SITE PLAN MODIFICATION ENLARGED VIEW - II  DUCTBANK SECTIONS - II  DUCTBANK SECTIONS - III  MCC-HS ONE-LINE DIAGRAM  MCC ELEVATION  PANELBOARD SCHEDULE  HSPS ELECTRICAL ROOM - POWER PLAN  HSPS ELECTRICAL ROOM - LIGHTING PLAN  HSPS MECHANICAL ROOM - LIGHTING PLAN  HSPS MECHANICAL ROOM - LIGHTING PLAN  HIGH SERVICE PUMP STATION - GROUNDING PLAN  HIGH SERVICE PUMP STATION - GROUNDING PLAN  WELL PUMP NO.3 POWER PLAN  WELL PUMP NO.5 POWER PLAN  WELL PUMP NO.5 POWER PLAN  WELL PUMP NO.6 POWER PLAN  WELL PUMP DETAILS  INTERFACE DIAGRAM - I  MCC-OSHG ONE-LINE DIAGRAM  MCC ELEVATION  480V PANEL PC ONE-LINE DIAGRAM  PANELBOARD SCHEDULES  OSHG BUILDING OVERALL PLAN  OSHG BUILDING POWER PLAN - II  OSHG BUILDING POWER PLAN - II  OSHG BUILDING CONTROL PLAN - II
133 134 135 166	E-105 E-106 E-107 E-108 E-109 E-110 E-111 E-112 E-113 E-114 E-115 E-116 E-117 E-118 E-119 E-120 E-121 E-201 E-202 E-203 E-204 E-205 E-206 E-207 E-301 E-302 E-303 E-304 E-305 E-306 E-307 E-308 E-309 E-310 E-310	SITE PLAN MODIFICATION  SITE PLAN MODIFICATION ENLARGED VIEW - I  SITE PLAN MODIFICATION ENLARGED VIEW - II  DUCTBANK SECTIONS - II  DUCTBANK SECTIONS - III  MCC-HS ONE-LINE DIAGRAM  MCC ELEVATION  PANELBOARD SCHEDULE  HSPS ELECTRICAL ROOM - POWER PLAN  HSPS ELECTRICAL ROOM - POWER PLAN  HSPS MECHANICAL ROOM - POWER AND CONTROL PLAN  HSPS MECHANICAL ROOM - POWER AND CONTROL PLAN  HIGH SERVICE PUMP STATION - GROUNDING PLAN  HIGH SERVICE PUMP AREA RISER DIAGRAM  OVERALL SECURITY RISER DIAGRAM  WELL PUMP NO.3 POWER PLAN  WELL PUMP NO.3 POWER PLAN  WELL PUMP NO.4 POWER PLAN  WELL PUMP NO.5 POWER PLAN  WELL PUMP NO.5 POWER PLAN  WELL PUMP NO.6 POWER PLAN  WELL PUMP AREA RISER DIAGRAM  OSHO ONE-LINE DIAGRAM  MCC ELEVATION  480V PANEL PC ONE-LINE DIAGRAM  PANELBOARD SCHEDULES  OSHG BUILDING OVERALL PLAN  OSHG BUILDING OVERALL PLAN  OSHG BUILDING CONTROL PLAN - II
133 134 135 166	E-105 E-106 E-107 E-108 E-109 E-110 E-111 E-112 E-113 E-114 E-115 E-116 E-117 E-118 E-119 E-120 E-121 E-201 E-202 E-203 E-204 E-205 E-206 E-207 E-301 E-302 E-303 E-304 E-305 E-306 E-307 E-308 E-307 E-308 E-309 E-310 E-311 E-312	SITE PLAN MODIFICATION  SITE PLAN MODIFICATION ENLARGED VIEW - I  SITE PLAN MODIFICATION ENLARGED VIEW - II  DUCTBANK SECTIONS - II  DUCTBANK SECTIONS - III  MCC-HS ONE-LINE DIAGRAM  MCC ELEVATION  PANELBOARD SCHEDULE  HSPS ELECTRICAL ROOM - POWER PLAN  HSPS ELECTRICAL ROOM - POWER PLAN  HSPS MECHANICAL ROOM - POWER AND CONTROL PLAN  HIGH SERVICE PUMP STATION - GROUNDING PLAN  HIGH SERVICE PUMP AREA RISER DIAGRAM  OVERALL SECURITY RISER DIAGRAM  WELL PUMP NO.3 POWER PLAN  WELL PUMP NO.3 POWER PLAN  WELL PUMP NO.5 POWER PLAN  WELL PUMP NO.6 POWER PLAN  WELL PUMP DETAILS  INTERFACE DIAGRAM - I  MCC-OSHG ONE-LINE DIAGRAM  MCC ELEVATION  480V PANEL PC ONE-LINE DIAGRAM  PANELBOARD SCHEDULES  OSHG BUILDING OVERALL PLAN  OSHG ELECTRICAL ROOM - POWER AND CONTROL PLAN  OSHG BUILDING OVERALL PLAN  OSHG BUILDING CONTROL PLAN - I  OSHG BUILDING CONTROL PLAN - II
133 134 135 168	E-105 E-106 E-107 E-108 E-109 E-110 E-111 E-112 E-113 E-114 E-115 E-116 E-117 E-118 E-119 E-120 E-121 E-201 E-202 E-203 E-204 E-205 E-206 E-207 E-301 E-302 E-303 E-304 E-305 E-306 E-307 E-308 E-309 E-310 E-311 E-312 E-313	SITE PLAN MODIFICATION SITE PLAN MODIFICATION ENLARGED VIEW - I SITE PLAN MODIFICATION ENLARGED VIEW - II DUCTBANK SECTIONS - I DUCTBANK SECTIONS - II DUCTBANK SECTIONS - III MCC-HS ONE-LINE DIAGRAM MCC ELEVATION PANELBOARD SCHEDULE HSPS ELECTRICAL ROOM - POWER PLAN HSPS ELECTRICAL ROOM - LIGHTING PLAN HSPS MECHANICAL ROOM - LIGHTING PLAN HIGH SERVICE PUMP STATION - GROUNDING PLAN HIGH SERVICE PUMP AREA RISER DIAGRAM WELL PUMP NO.3 POWER PLAN WELL PUMP NO.3 POWER PLAN WELL PUMP NO.5 POWER PLAN WELL PUMP NO.6 POWER PLAN WELL PUMP NO.6 POWER PLAN WELL PUMP NO.5 POWER PLAN WELL PUMP NO.6 POWER PLAN WELL PUMP NO.6 POWER PLAN WELL PUMP DETAILS INTERFACE DIAGRAM WELL PUMP DETAILS INTERFACE DIAGRAM MCC CLEVATION ABOV PANEL PC ONE-LINE DIAGRAM MCC ELEVATION ABOV PANEL PC ONE-LINE DIAGRAM PANELBOARD SCHEDULES OSHG BUILDING OVERALL PLAN OSHG BUILDING OVERALL PLAN OSHG BUILDING CONTROL PLAN - I OSHG BUILDING CONTROL PLAN - I OSHG BUILDING CONTROL PLAN - II OSHG BUILDING GROUNDING PLAN


171	E-316	INTERFACE DIAGRAM
172	E-317	VPLC-OSHG1 RISER DIAGRAM
173	E-318	VPLC-OSHG2 RISER DIAGRAM
174	E-319	GATE CONTROLLER DETAIL
175	E-320	FLUORIDE FILL STATION CONTROL SCHEMATIC
176	E-321	FLUORIDE TRANSFER PUMP CONTROL SCHEMATIC
177	E-401	EXISTING 0.5 MG GST MODIFICATION
178	E-402	GROUND STORAGE TANK ELECTRICAL DETATILS
179	E-501	SCHEMATICS - I HIGH SERVICE PUMPS
180	E-502	SCHEMATICS - II DISCHARGE VALVES
181	E-503	SCHEMATICS - III VALVE AND PUMP CONNECTION
182	E-504	SCHEMATICS - IV WELL PUMP
183	E-505	SCHEMATICS - V FLOW CONTROL VALVE SCHEMATICS & RISER DIA
184	E-506	SCHEMATICS - VI HEAT-TRACE SCHEMATICS
185	E-507	SCHEMATICS - VII MISCELLANEOUS SCHEMATICS
186	E-508	SCHEMATICS - VIII SCP
187	E-509	SCHEMATICS - IX GROUND STORAGE TANK
188	E-510	SCHEMATICS - X
189	E-511	SCHEMATICS - XI
190	E-512	SCHEMATICS - XII
191	E-601	STANDARD DETAILS - I
192	E-602	STANDARD DETAILS - II
193	E-603	STANDARD DETAILS - III
194	E-604	STANDARD DETAILS - IV
195	E-605	SECURITY SYSTEM DETAILS
		INSTRUMENTATION
196	I-1	LEGEND & SYMBOLS
197	I-2	LEGEND & SYMBOLS
198	I-3	CONTROL SYSTEM NETWORK DIAGRAM - I
199	1-4	CONTROL SYSTEM NETWORK DIAGRAM - II
200	I-5	SECURITY SYSTEM NETWORK DIAGRAM
201	I-6	WELL PUMPS P&ID
202	I-7	GROUND STORAGE TANK P&ID
203	I-8	HIGH SERVICE PUMP STATION P&ID
204	I-9	OSHG SOFTENER & BRINE SYSTEM P&ID
205	I-10	OSHG GENERATOR SKIDS P&ID
206	I-11	SODIUM HYPOCHLORITE STORAGE & FEED SYSTEM P&ID
207	I-12	FLUORIDE SYSTEM P&ID
208	I-13	FLUORIDE FEED P&ID
209	I-14	MISCELLANEOUS P&ID
210	I-15	INSTRUMENTATION INSTALLATION DETAILS - I
211	I-16	INSTRUMENTATION INSTALLATION DETAILS - II
212	I-17	CHLORINE AND FLUORIDE ANALYZER PANEL DETAIL
213	I-18	SUPERVISORY CONTROL PANEL ELEVATION AND DETAILS
	I-19	PLC-TC3CHEM CONTROL PANEL ELEVATION AND DETAILS  PLC-TC3CHEM CONTROL PANEL ELEVATION AND DETAILS
214	1 1 1	ILEC LOCCHEIM COMMON MARE ELEVATION AND DETAILS

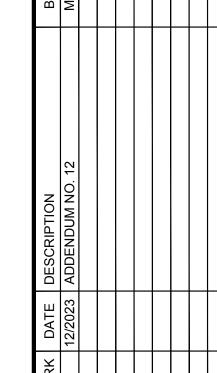TETRA TECH
Texas Registration No. F-3924










SAN ANTONIO WATER SYSTEMS
KING STREET PUMP STATION
IMPROVEMENTS
DRAWING INDEX

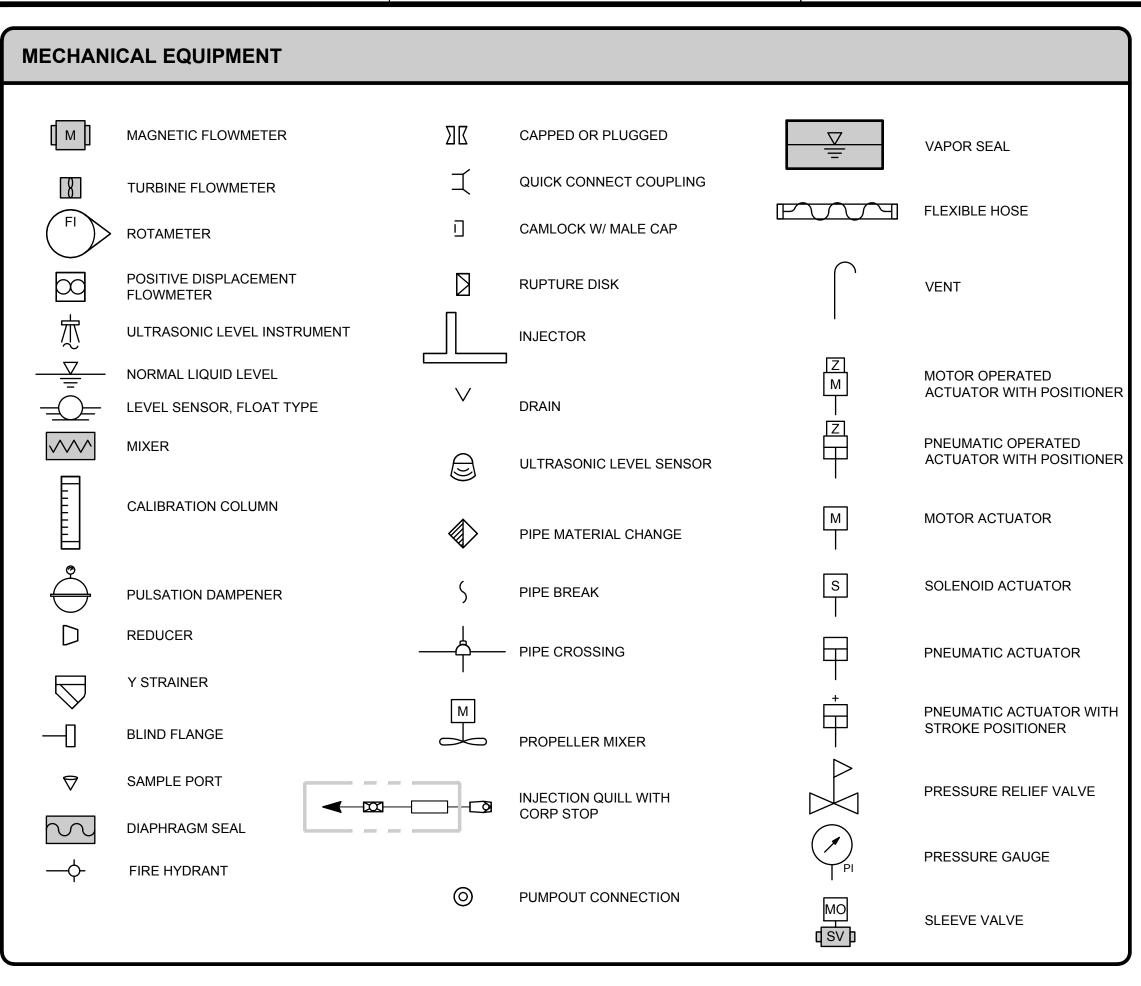PROJ: 200-09308-20002 DESN: MK DRWN: CHKD:



PIPING LEGE	PIPING LEGEND															
	FLANGED				MECHANICAL JOINT			GROOVE JOINT				SOLVENT WELD				
FITTING/ APPURTENANCE			LE-LINE	SINGLE-LINE DOUBLE-LINE			SINGLE-LINE		DOUBLE-LINE							
	EXISTING	PROPOSED	EXISTING	PROPOSED	EXISTING	PROPOSED	EXISTING	PROPOSED	EXISTING	PROPOSED	EXISTING	PROPOSED	EXISTING	PROPOSED	EXISTING	PROPOSED
BEND		<b>+</b>			+	4				+			+	+		
TEE	+	##			1)—(-	中				++			+++	++		
WYE	-				1	1×4		<b>4</b>		X			<del></del>	<del></del>		
REDUCER						- >-				<b>-</b>			->-	<b>→</b>		
CAP/ BLIND FLANGE			2	<b>E</b>	N/A	N/A	N/A	N/A		<b>—</b>	8	<b>—</b>			2	<del></del>
PLUG	N/A	N/A	N/A	N/A		—(			N/A	N/A	N/A	N/A	N/A	N/A	N/A	N/A
BUTTERFLY VALVE						<b>⊣</b> )+(⊢			——————————————————————————————————————	<b>—0+0</b> —				— <b>15</b> —		
BALL VALVE				<b>-</b>	N/A	N/A	N/A	N/A						— <del>—</del> ——		<del></del>
CHECK VALVE					N/A	N/A	N/A	N/A						T T		
GATE VALVE						<b>→×</b> ⊢										<del></del>
PLUG VALVE					$- \infty $	- xx -								<b>−</b> \$ <b>−</b>		-5-6
AUTOMATIC CONTROL VALVE					N/A	N/A	N/A	N/A		<b>→</b> \$ <b>-</b>						
PINCH VALVE					N/A	N/A	N/A	N/A	N/A	N/A	N/A	N/A		-283-		<del></del>
		-	•		ABOVE GI	RADE PIPING						BELO	W GRADE PIPII	NG		

- 1. SURFACE PREPARATIONS PER SPECIFICATIONS 09900-PAINTING AND
- 2. ALL CHEMICALS FEED PIPING CONSISTING OF SCH 80 PVC TO BE MINIMUM 3/4" DIA UNLESS OTHERWISE SHOWN SHOWN ON THE
- 3. ALL EXPOSED PROCESS PIPING IS TO BE PAINTED PER THE PAINTING SPECIFICATIONS, EXCEPT STAINLESS STEEL.
- GRAVITY SEWER IS TO BE AIR TESTED.
- WORKING PRESSURE RATING OF FITTING TO MEET OR EXCEED THE RATING OF PIPE.
- 6. ALL CARBON STEEL PIPING SHALL BE RATED FOR 150 PSI WORKING PRESSURE, MINIMUM 1/4" WALL THICKNESS PER SAWS STANDARDS, REGARDLESS OF WORKING AND TEST PRESSURES INDICATED IN THE SCHEDULE ABOVE.
- REFER TO SPECIFICATION SECTION 15076 DOUBLE WALL CONTAINMENT PIPING FOR DOUBLE WALL CONTAINMENT PIPING, FITTINGS AND APPURTENANCES.

			PIPE MATERIALS SCHEDULE					
ABBREVIATION	DESCRIPTION	BURIED	EXPOSED	EXPOSED COLOUR	MAX WORKING PRESSURE	TEST PRESSURE/TESTING SPEC	SPECIFICATIONS	
BR	BRINE	NA	PVC SCH 80, SOLVENT WELD	BROWN W/ WHITE LETTERS	50	100	15063	
DR,D,SS	DRAIN/SEWER	<6": PVC SCH 40; >= 6" PVC SEWER PIPE, SDR 26 W/ PVC FITTINGS			GRAVITY	15 FT WATER COLUMN/15014	15063	
DRAIN	10" TANK DRAIN	N/A	CARBON STEEL, WELDED AND FLANGED	MATCH GST	15	30/15014	15055, 15056	
HFA	HYDROFLUOSILICIC ACID (FLOURIDE)	PFA TUBING IN SCH 80 CPVC CONTAINMENT PIPE	CPVC SCH 80, SOLVENT WELD IN SCH 80 CPVC CONTAINMENT PIPE, SOLVENT WELD	WHITE W/YELLOW BANDS	60	100/15014	15062, 15076	
PW	POTABLE WATER	DUCTILE IRON, RESTRAINED RTJ AND RESTRAINED MJ>=4" <4" PVC SCH 40, SOLVENT WELD	<=4" PVC SCHEDULE 80; >4" CARBON STEEL	BLUE (11SF "SAFETY BLUE")	150	225/15085	15055, 15056,15058	
RW	RAW WATER	DUCTILE IRON	CARBON STEEL	TAN W/ WHITE LETTERS	150	225/15085	15055, 15056, 15058	
SH	SODIUM HYPOCHLORITE (HYPO)	PVC CARRIER TUBING IN SCH 80 PVC CONTAINMENT PIPE	PVC SCH 80, SOLVENT WELD IN SCH 80 PVC CONTAINMENT PIPE WHERE INDICATED, SOLVENT WELD	YELLOW	60	100	15063, 15076	
SMPL	SAMPLE	PVC SCH 80, SOLVENT WELD	PVC SCH 80, SOLVENT WELD OR 316 SST AS NOTED ON DRAWING	MATCH SERVICE	100	150/15014	15063, 15067	
UW	UTILITY WATER	< 4" PVC SCH 80, SOLVENT WELD & COPPER	<=3" PVC SCH 80, SOLVENT WELD	LIGHT BLUE	75	150/15104	15063	
SW	SOFTENED WATER	NA	PVC SCH 80, SOLVENT WELD	ALUMINUM W/ BLACK LETTERS	50	100	15063	
VNT/AIR	VENT/AIR	NA	INDOOR: PVC, SCH 40; OUTDOOR: PVC, SCH 80	( VENT: MD. GRAY (33GR) AIR: INDOOR- CLEAR, OUTDOOR- PLASTIC )	NA	NA	15063	
SF	SALT FILL	NA	316 STAINLESS STEEL	1 NA	12" WATER COLUMN	NA	15067	

PROJ: 200-09308-20002

TECH ation No. F-3924


**BID SET** 

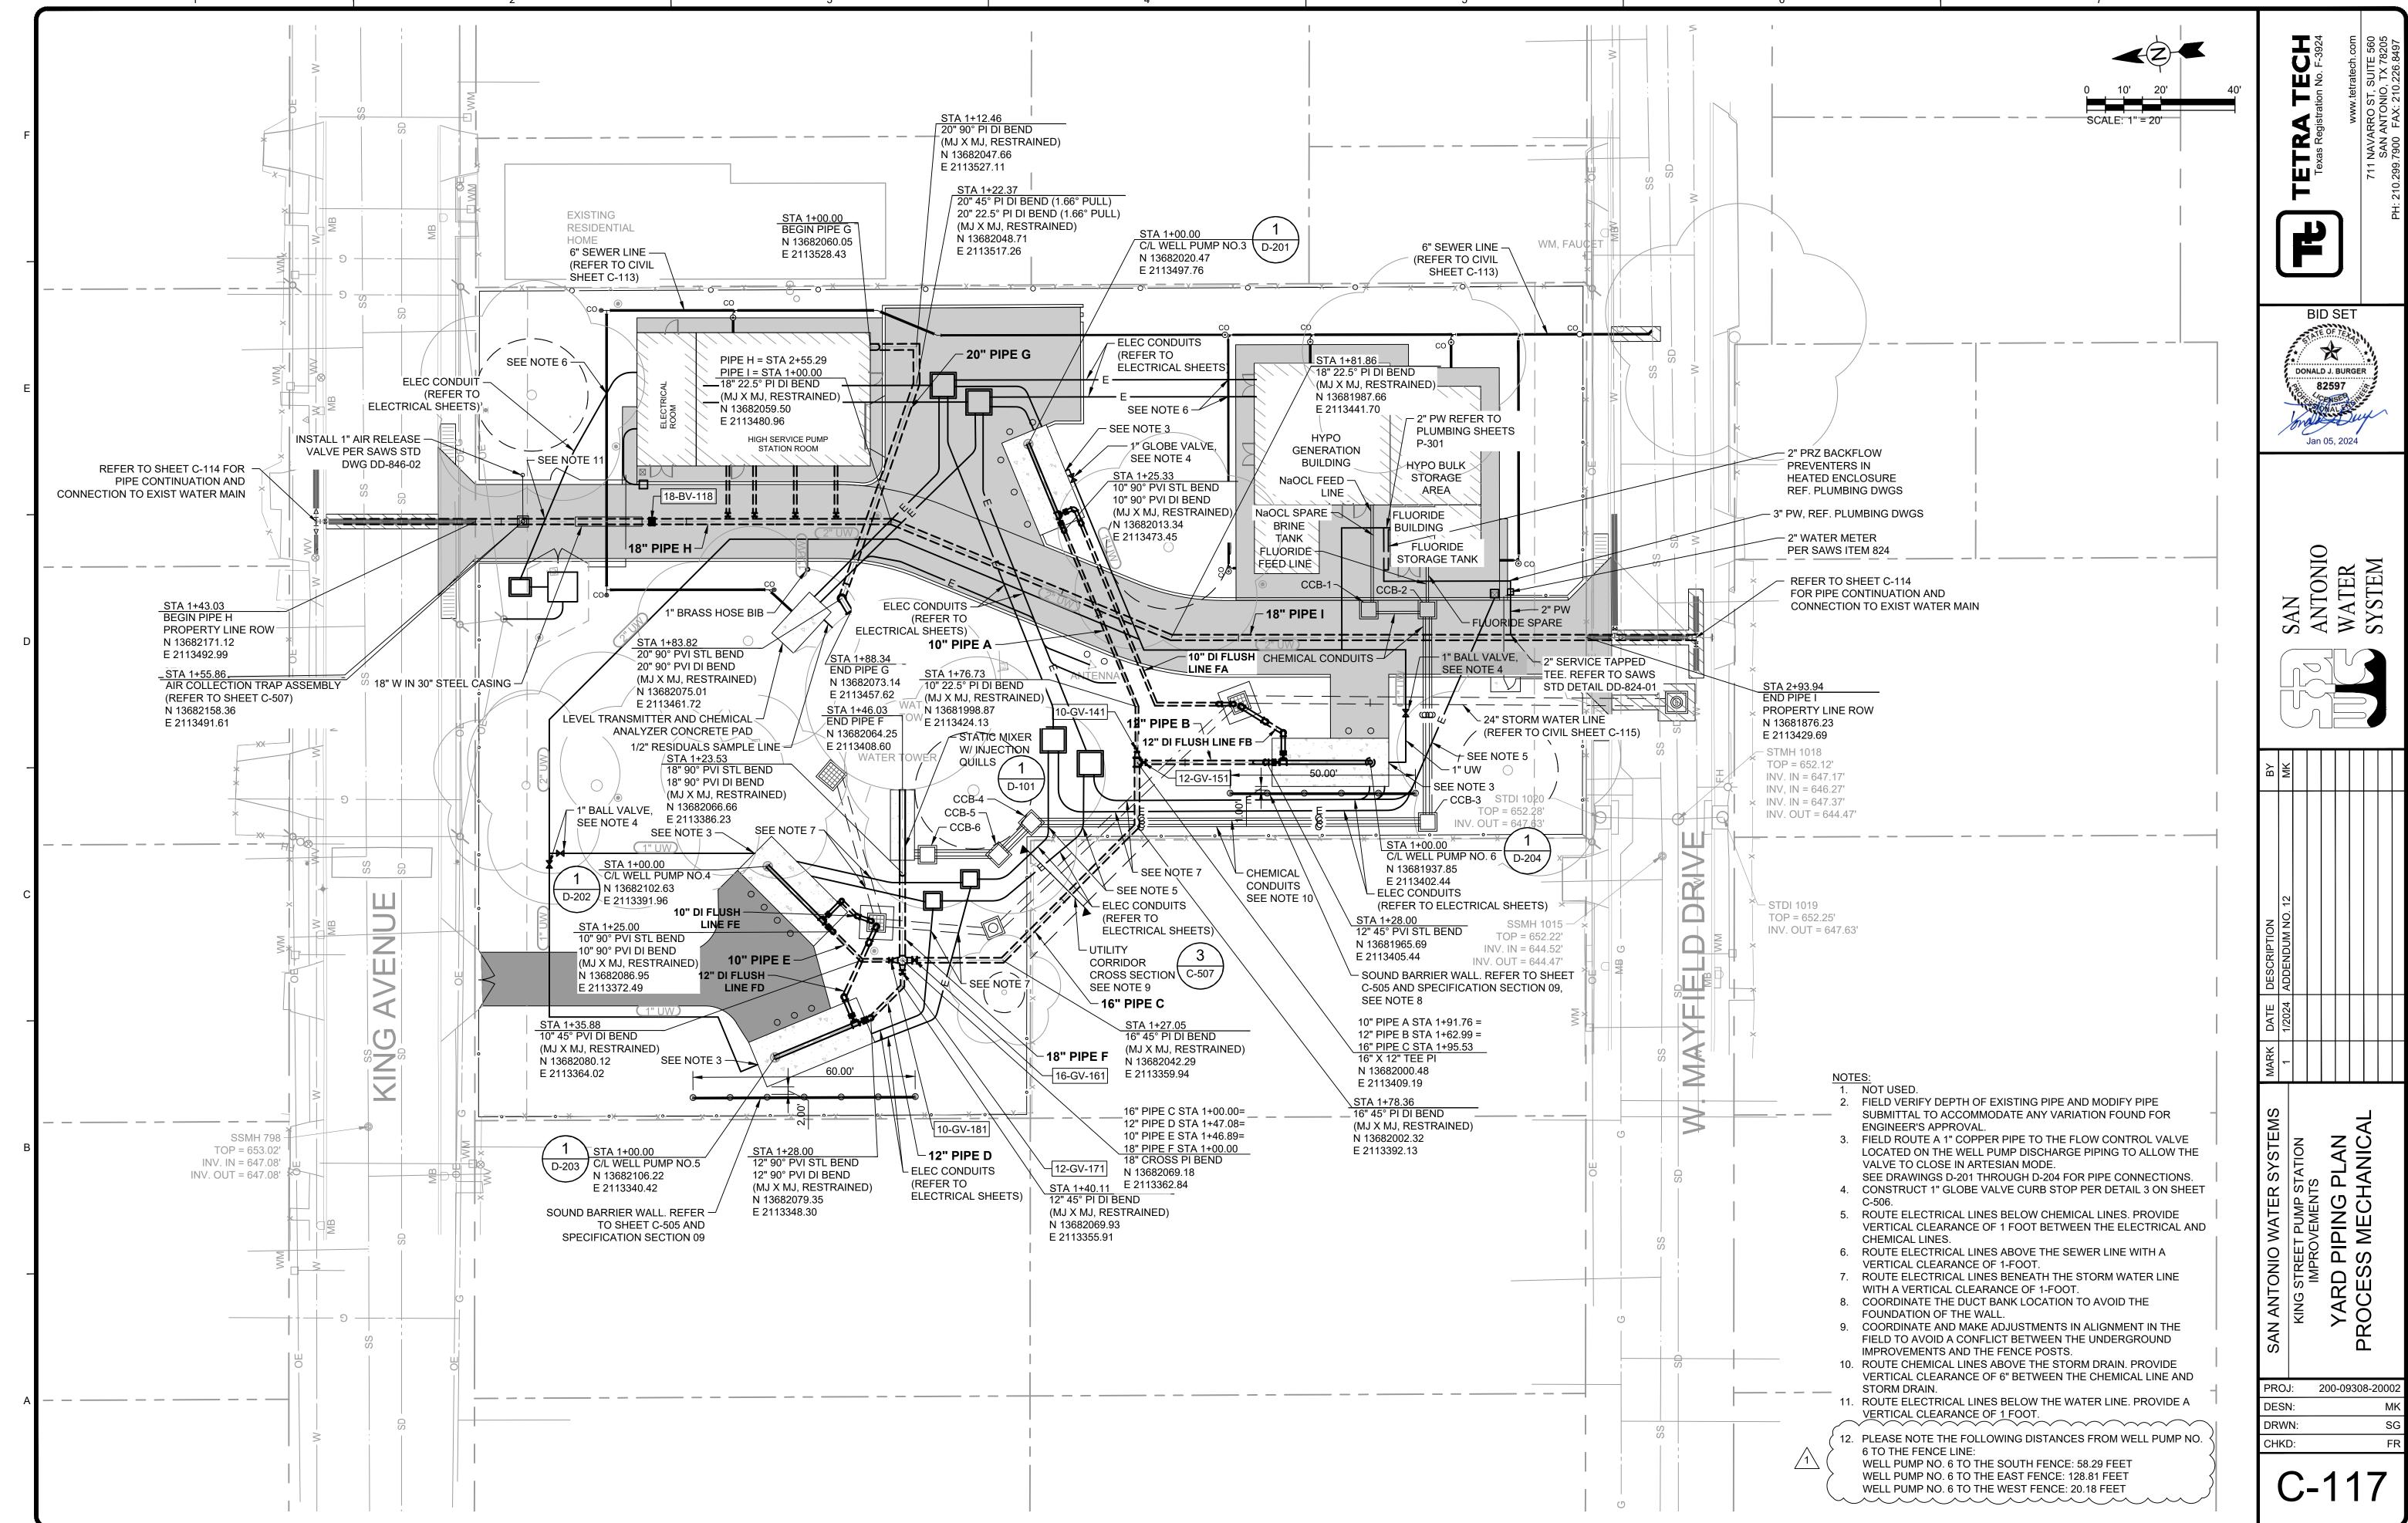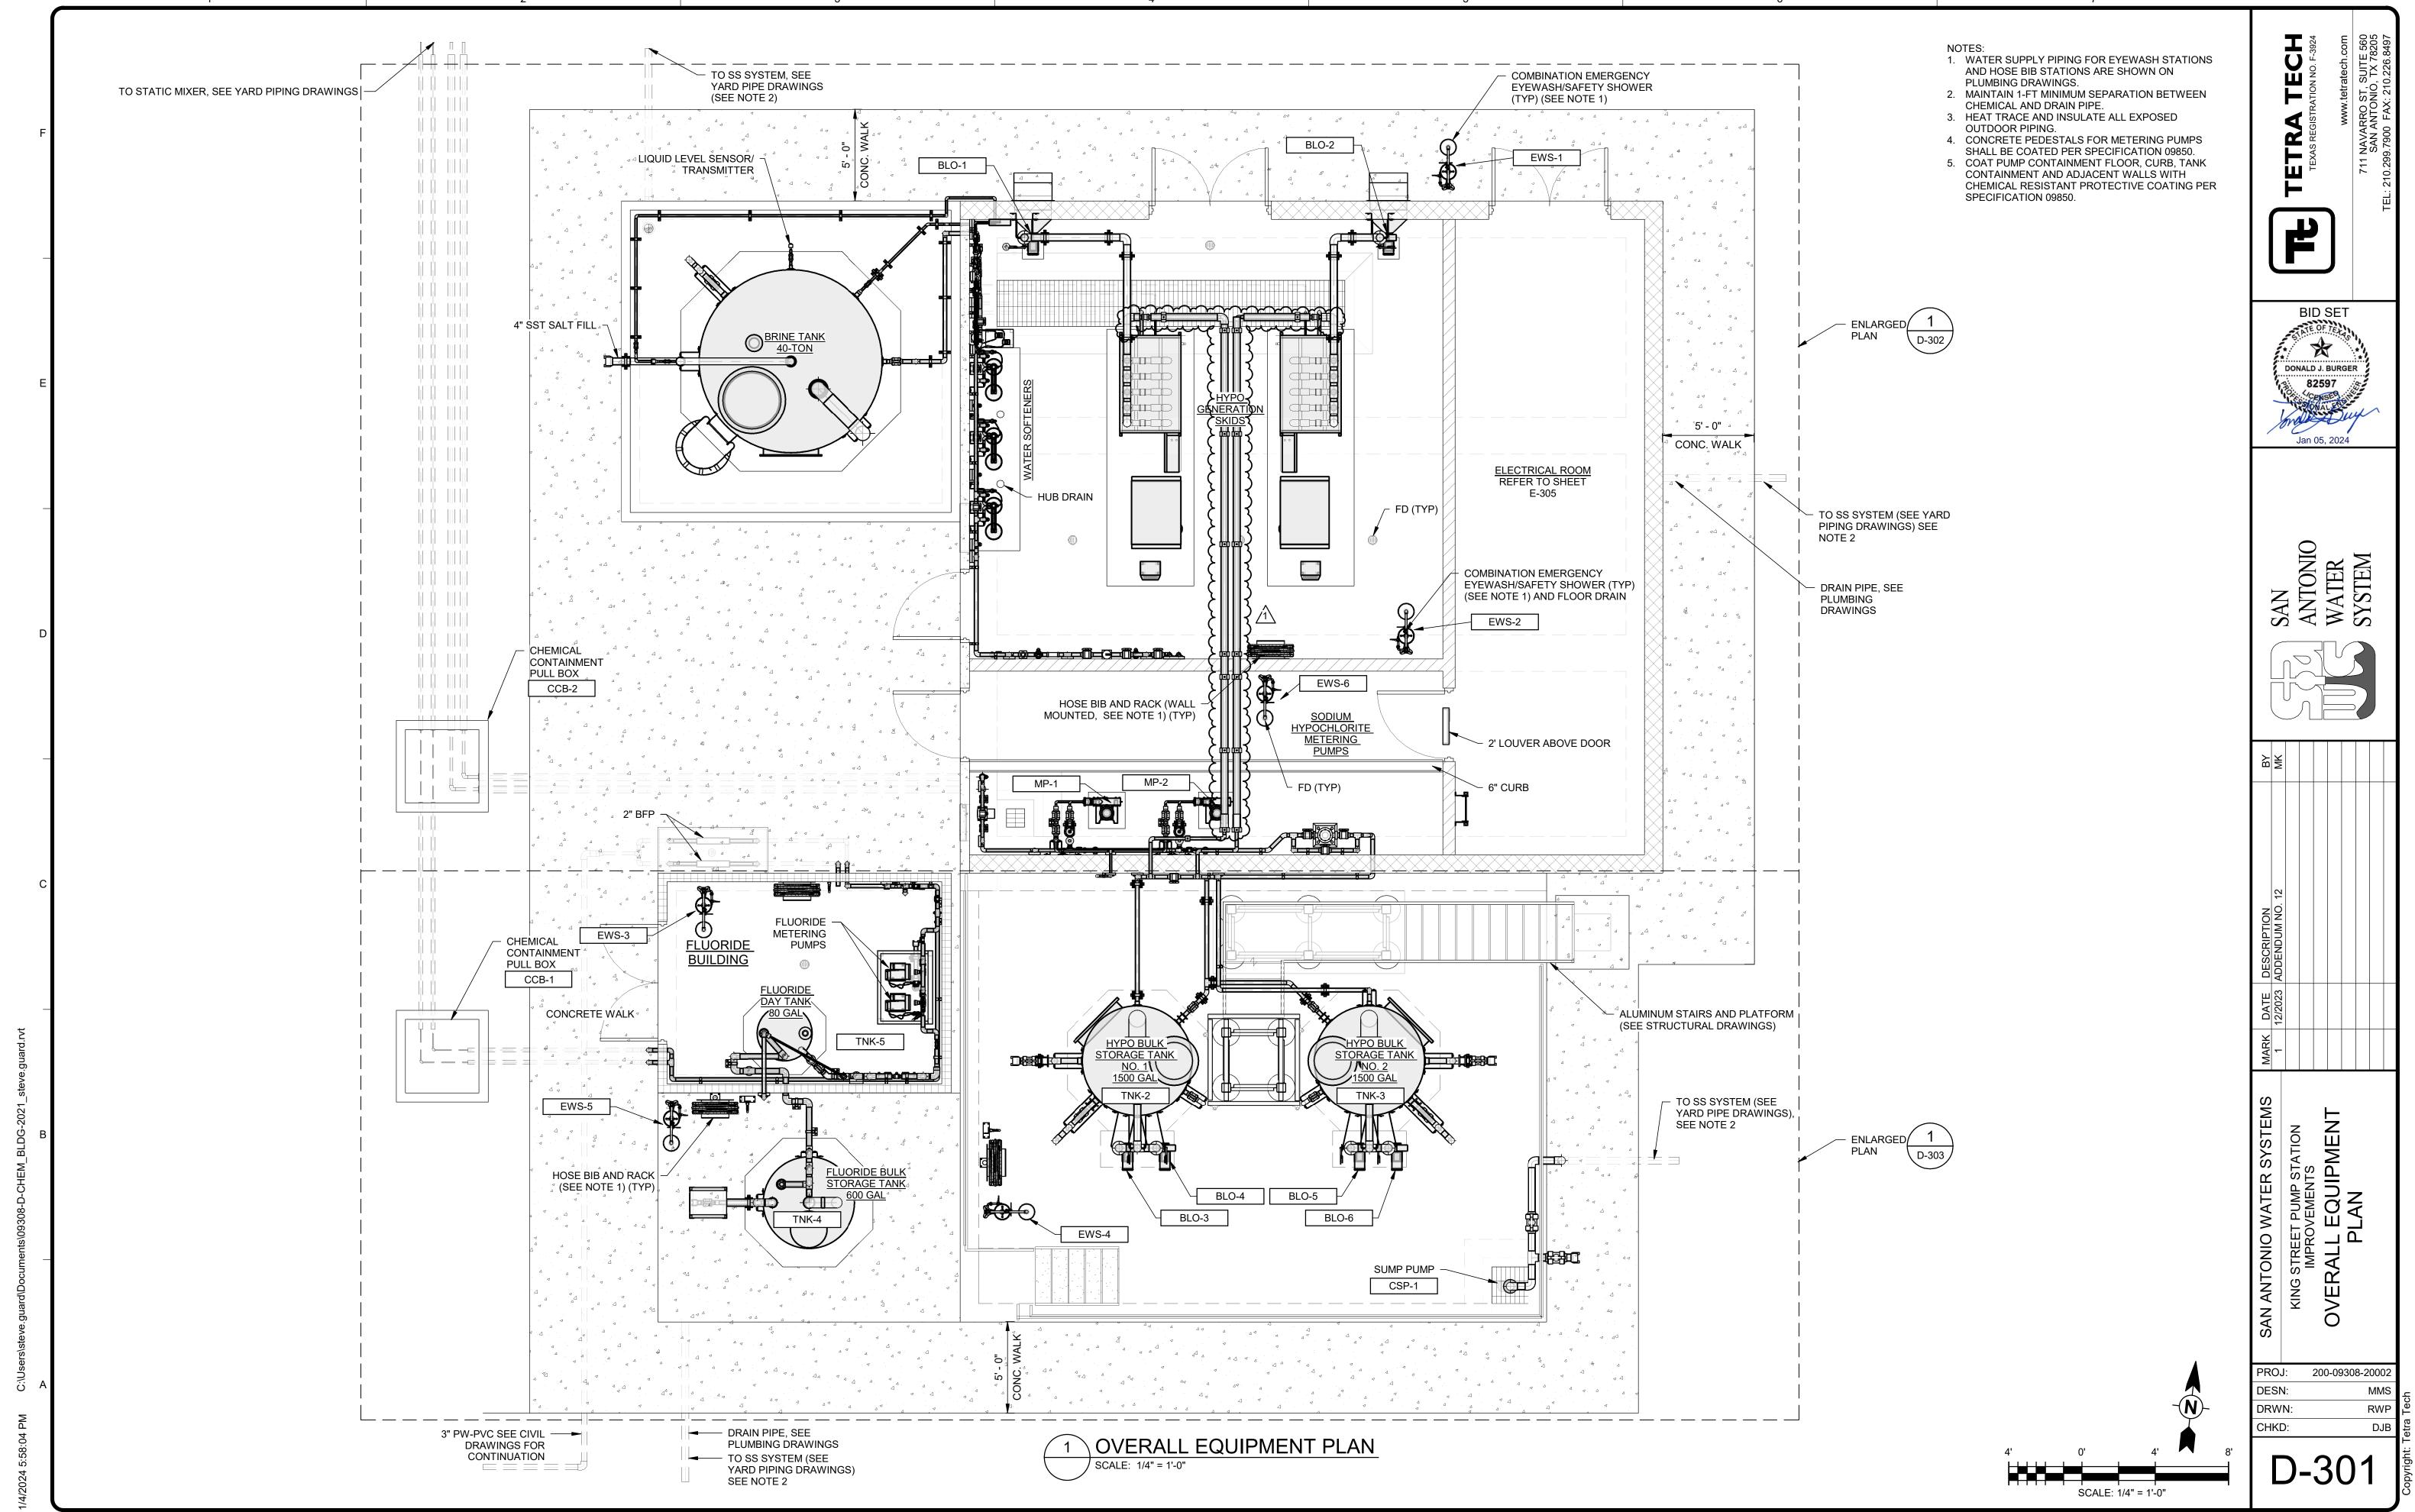
\*

DONALD J. BURGER 82597


SAN ANTONIO WATER SYSTEM

DESN: DRWN: CHKD:






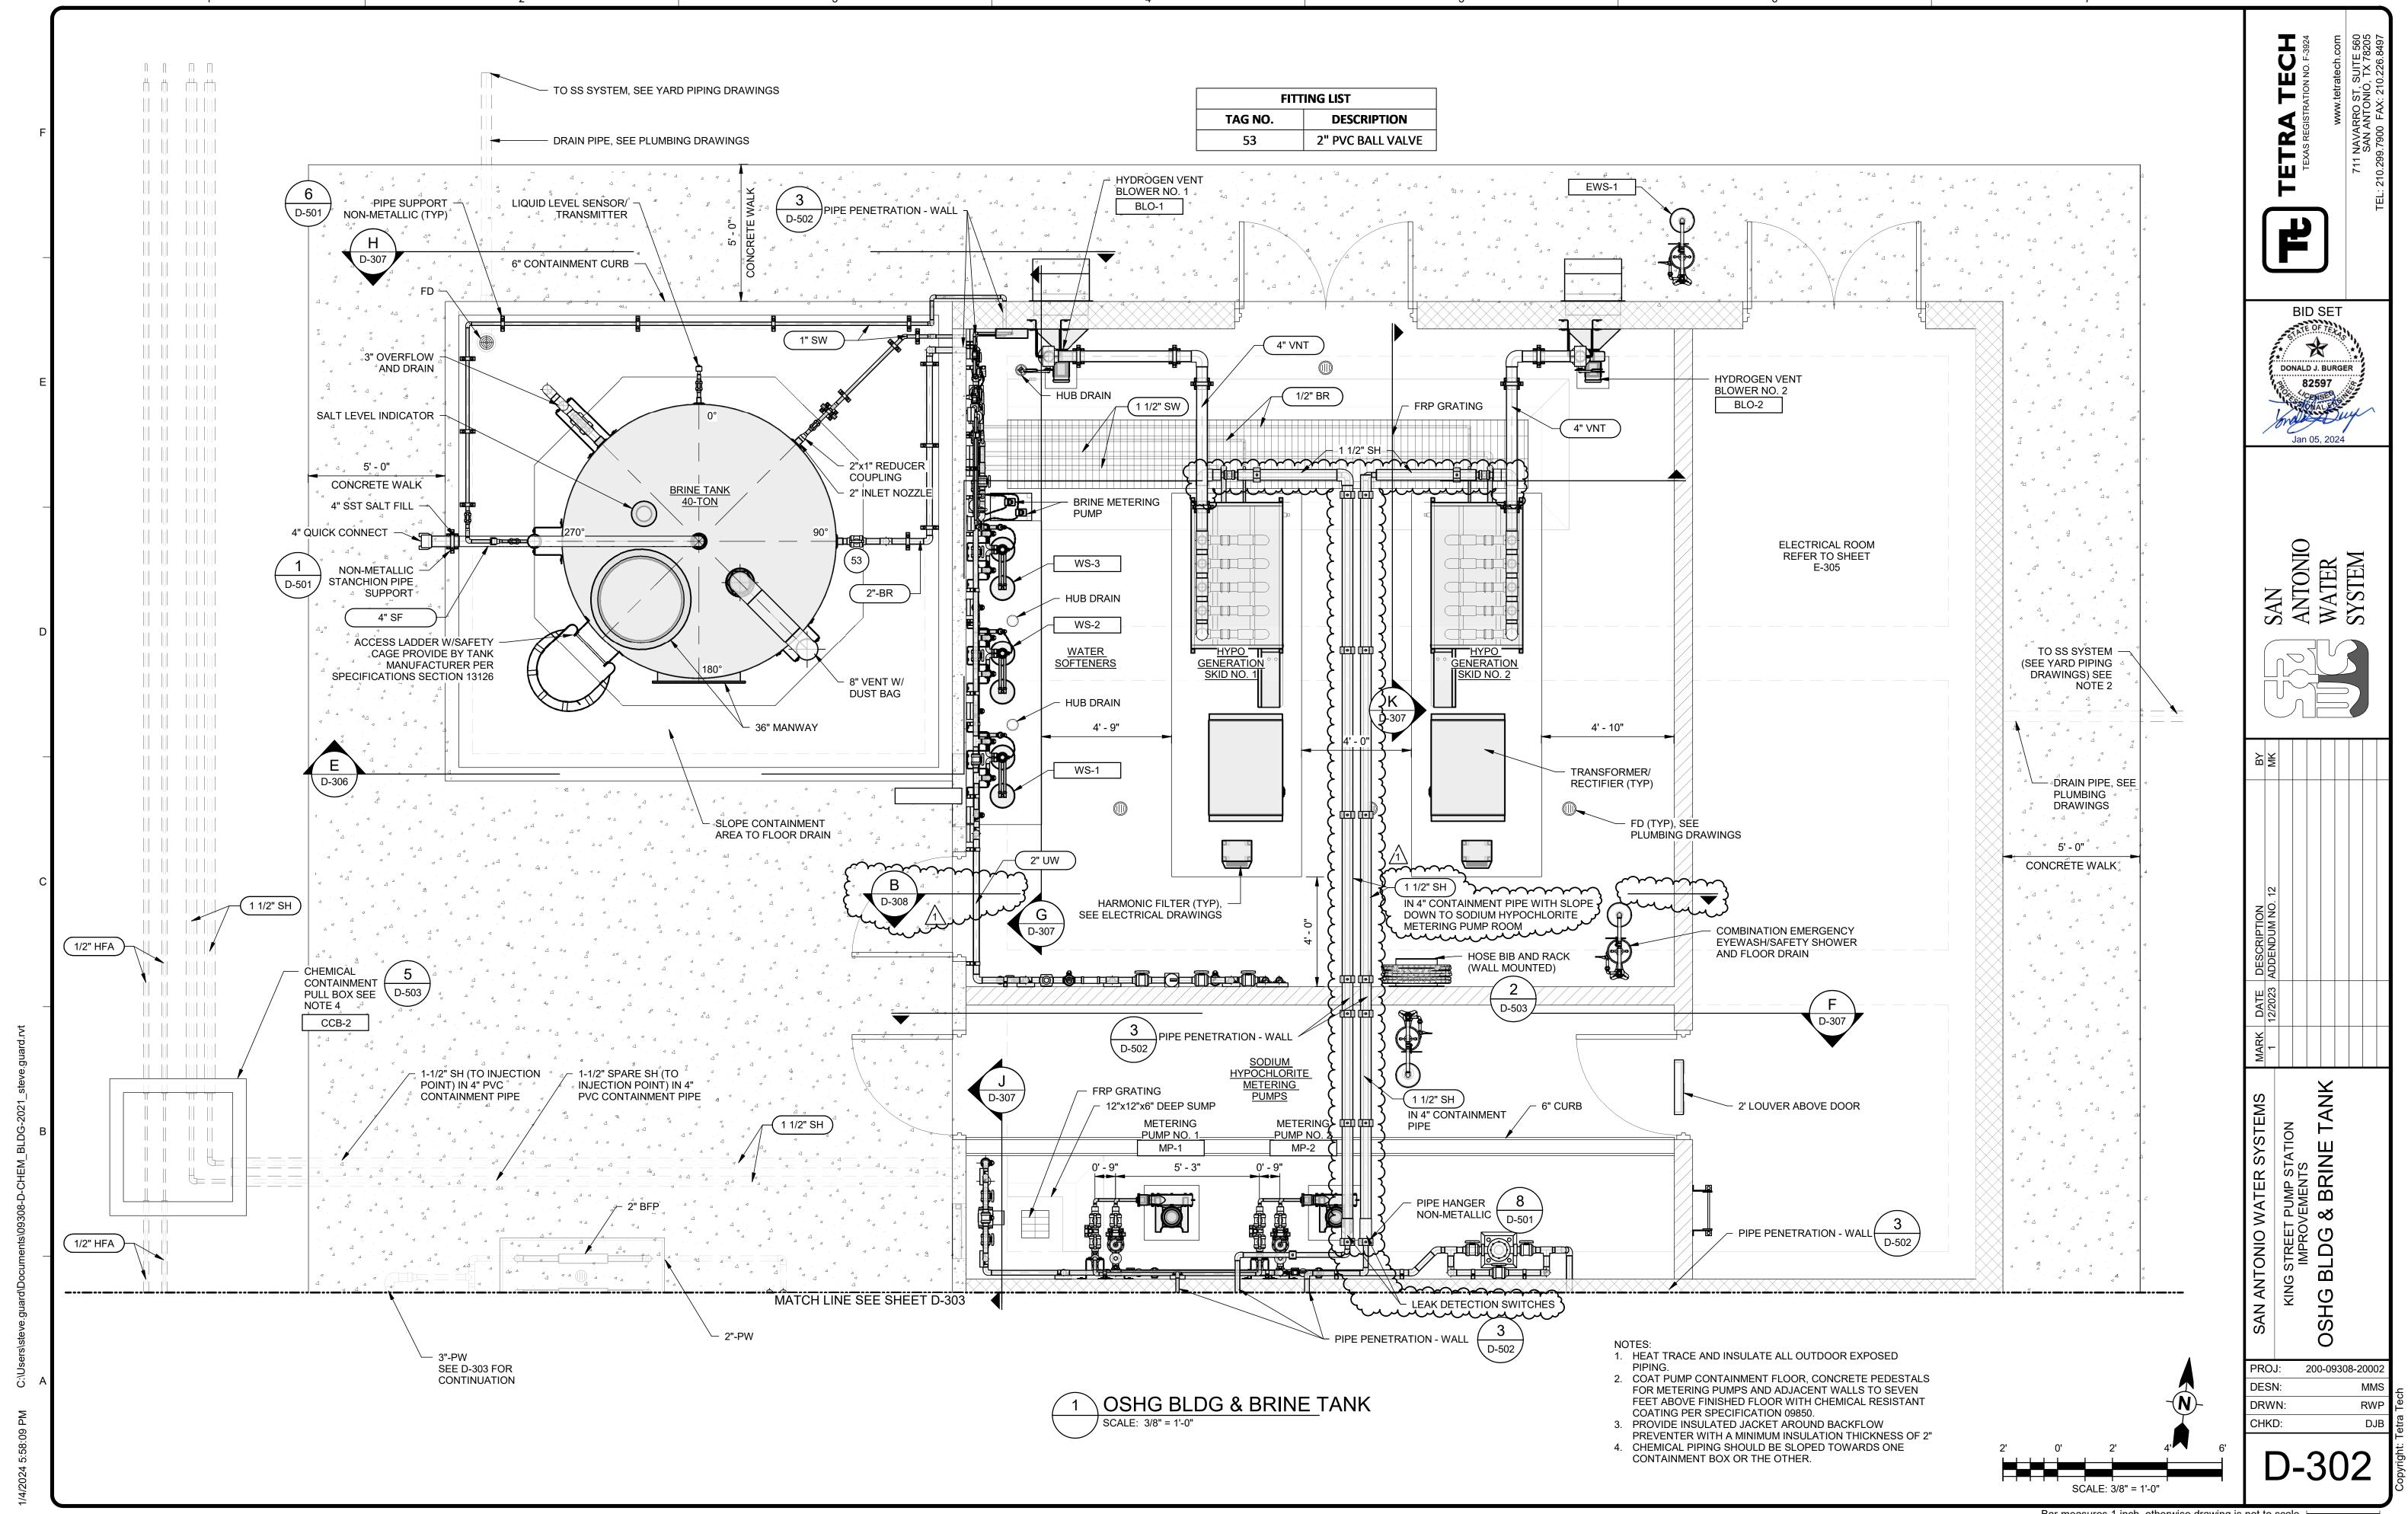
Bar measures 1 inch, otherwise drawing is not to scale



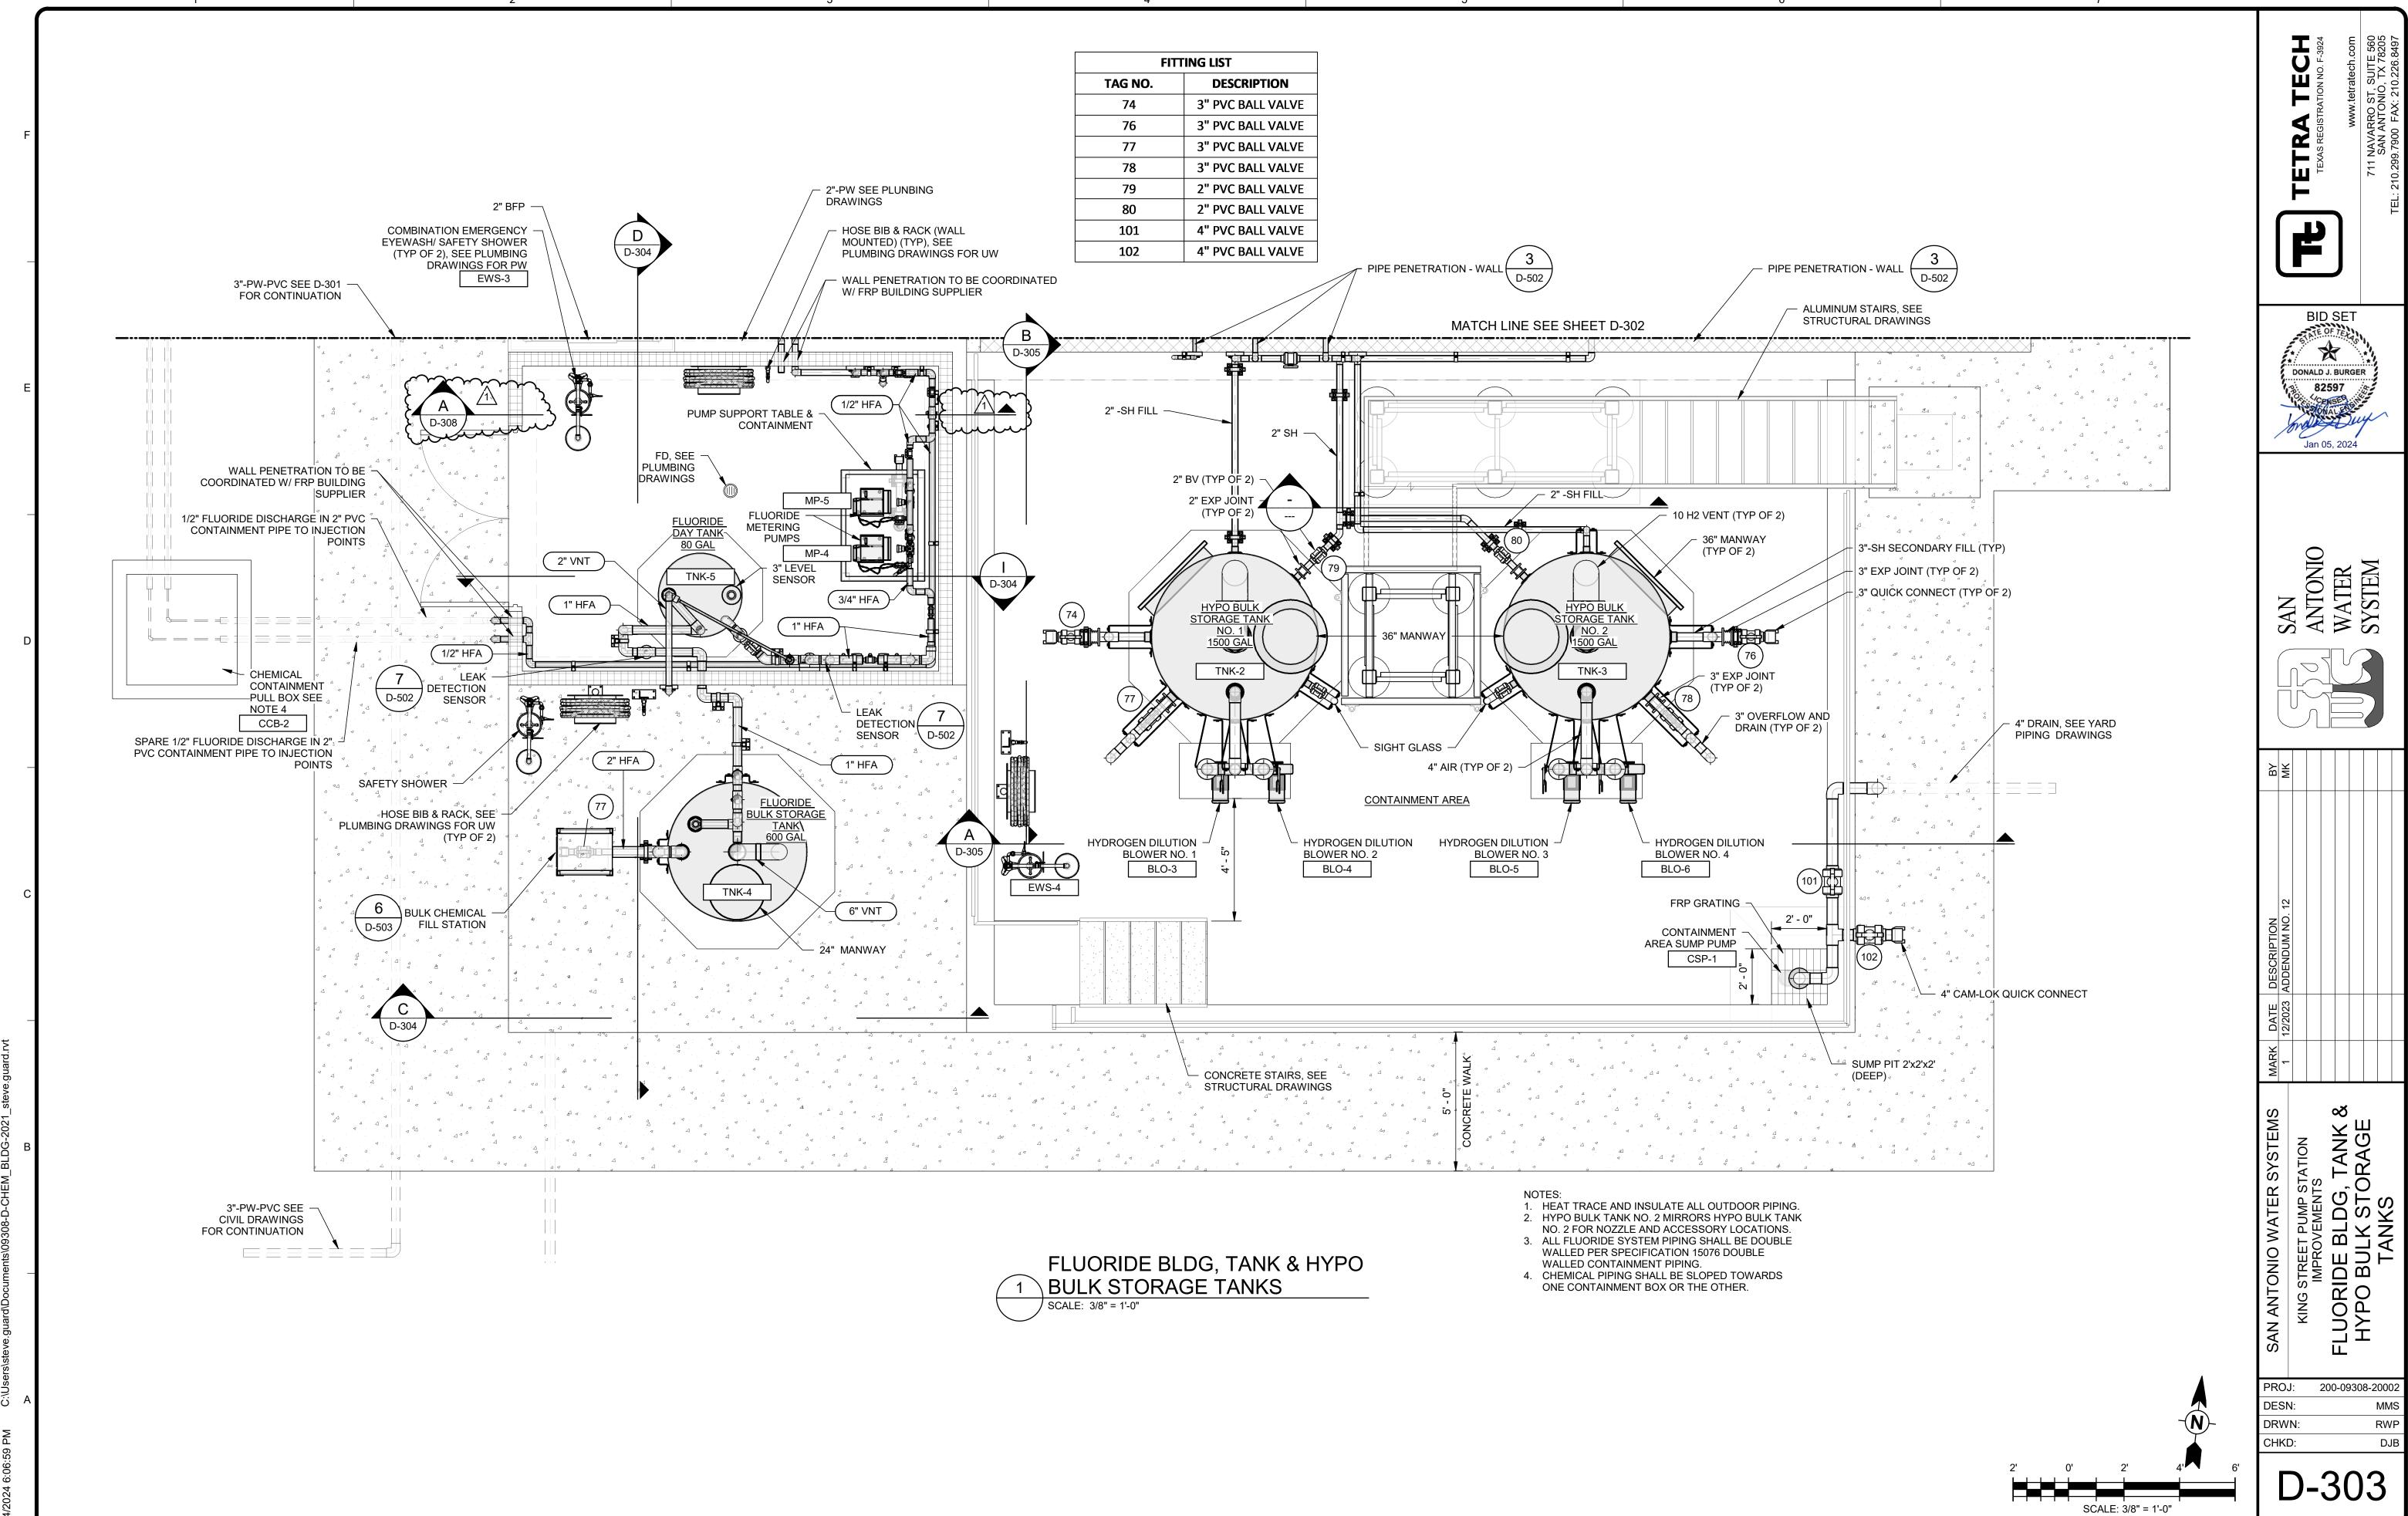
Bar measures 1 inch, otherwise drawing is not to scale if



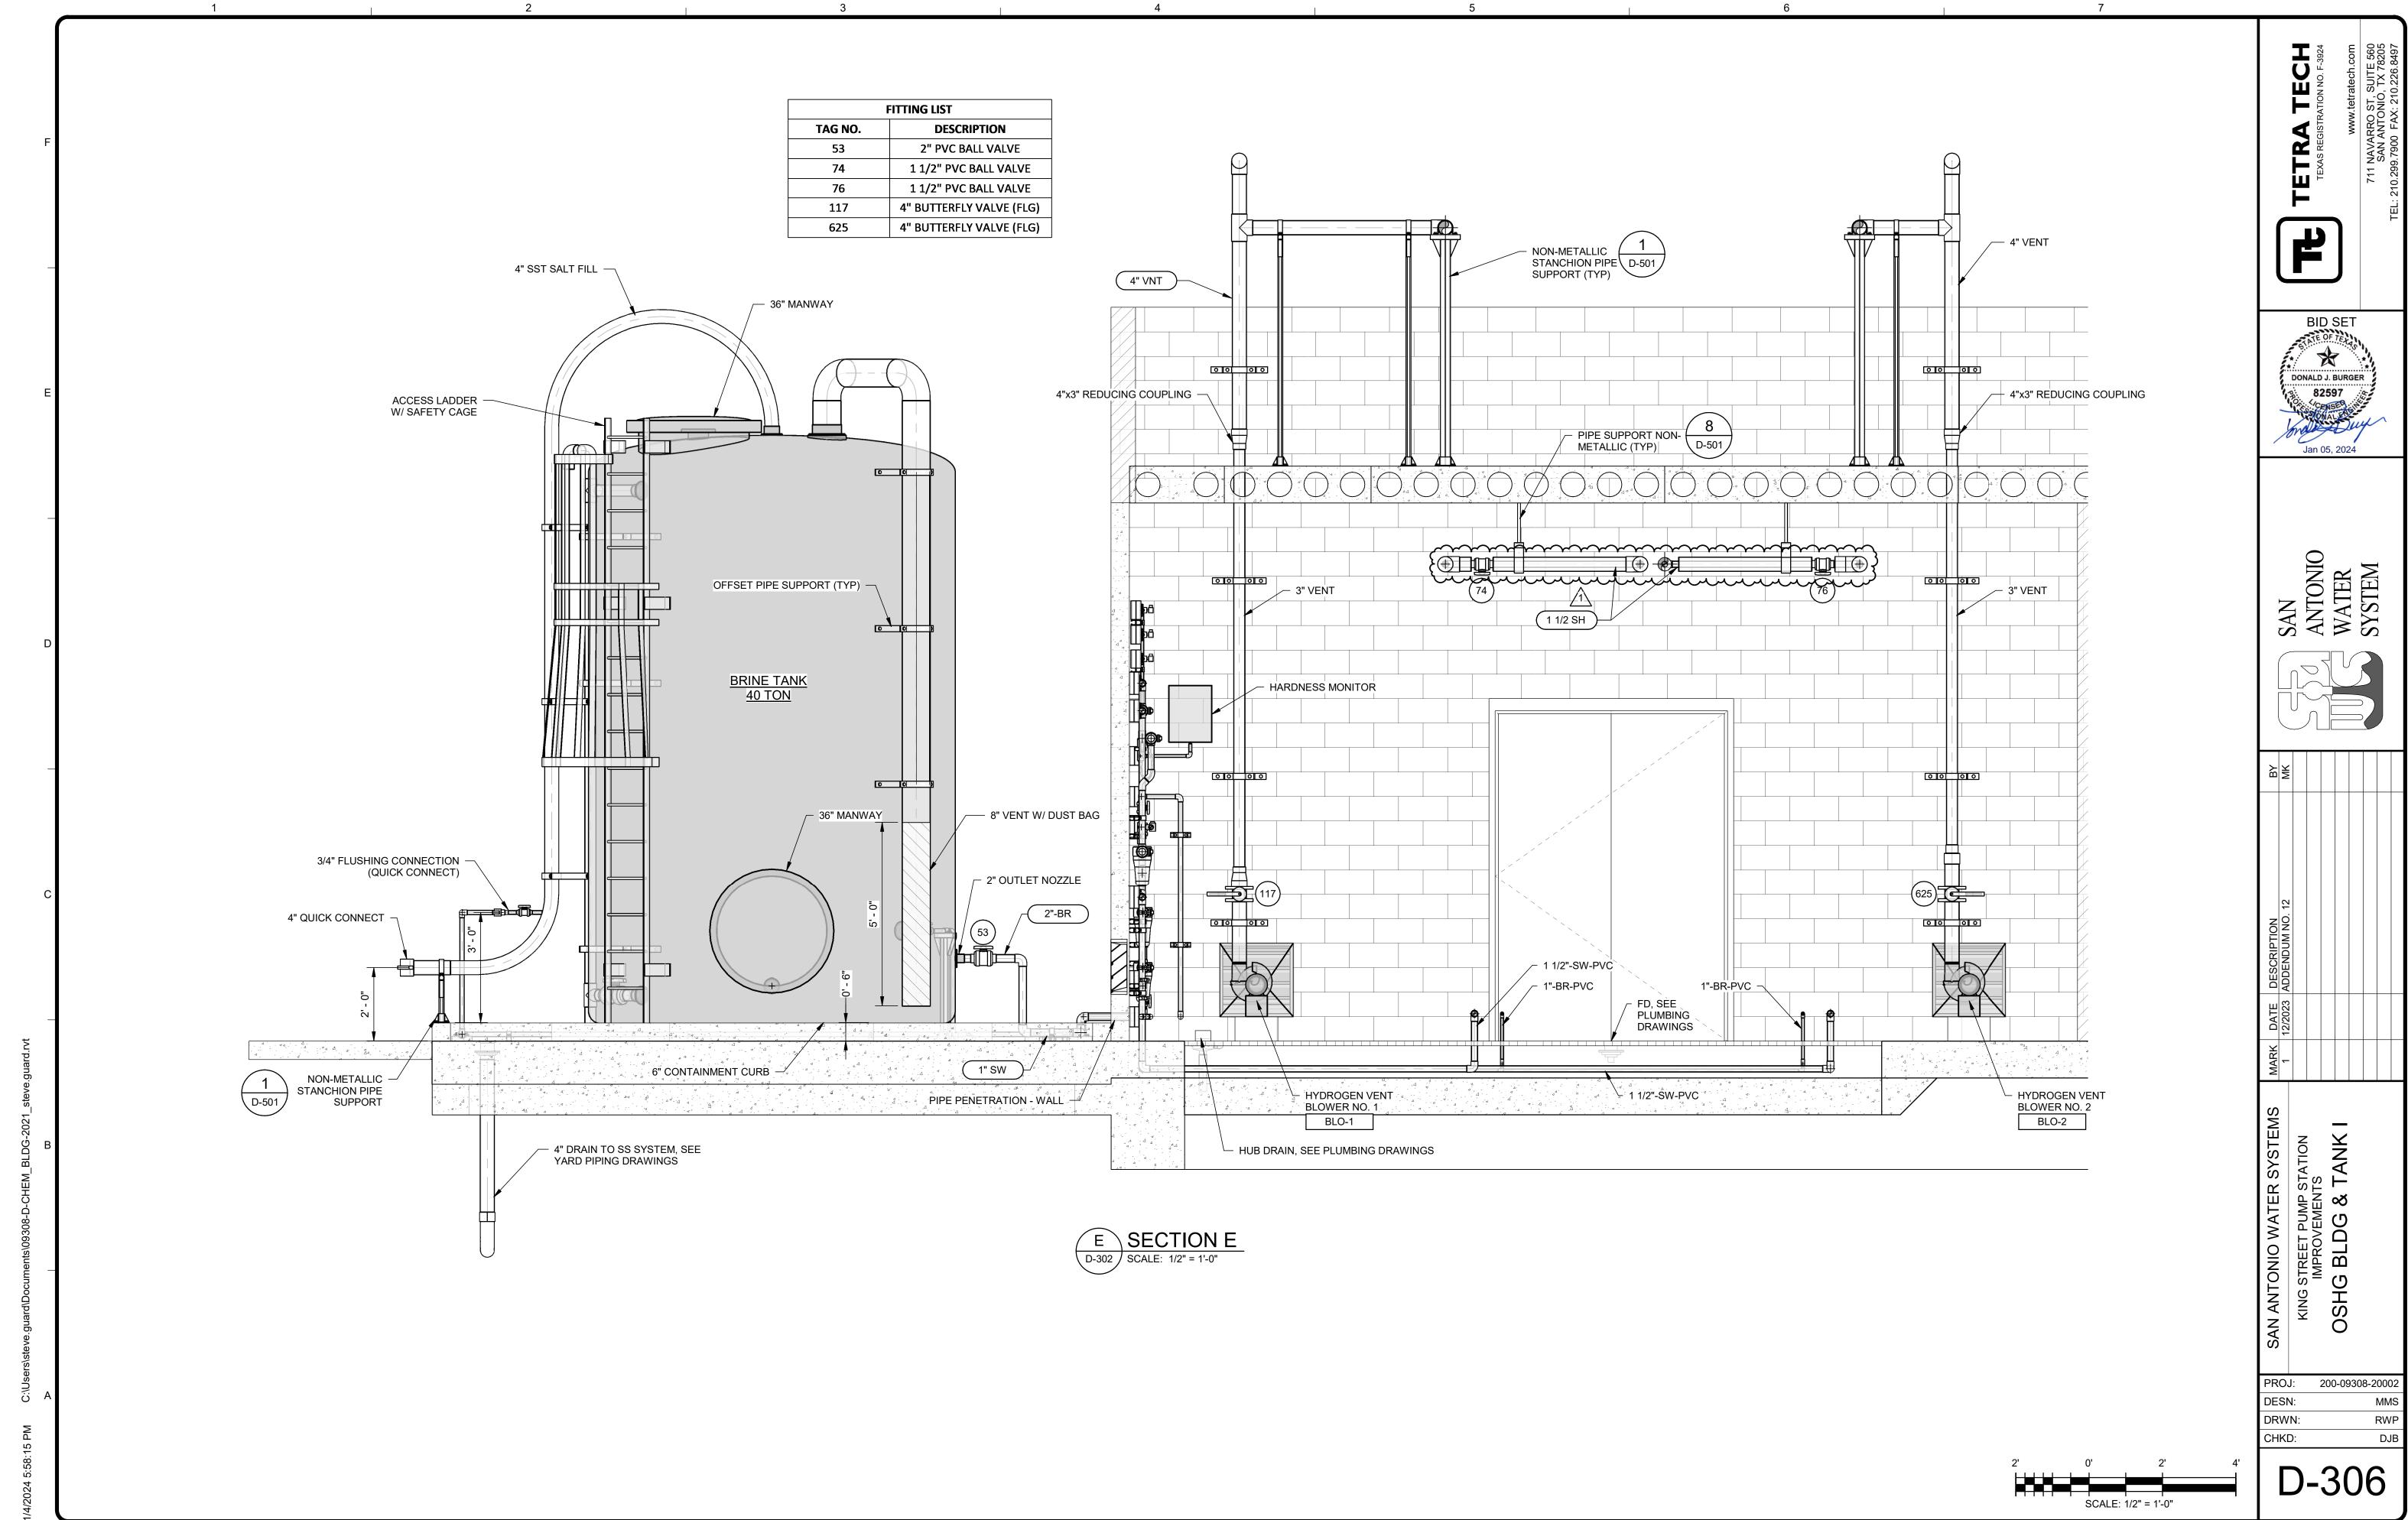Bar measures 1 inch, otherwise drawing is not to scale




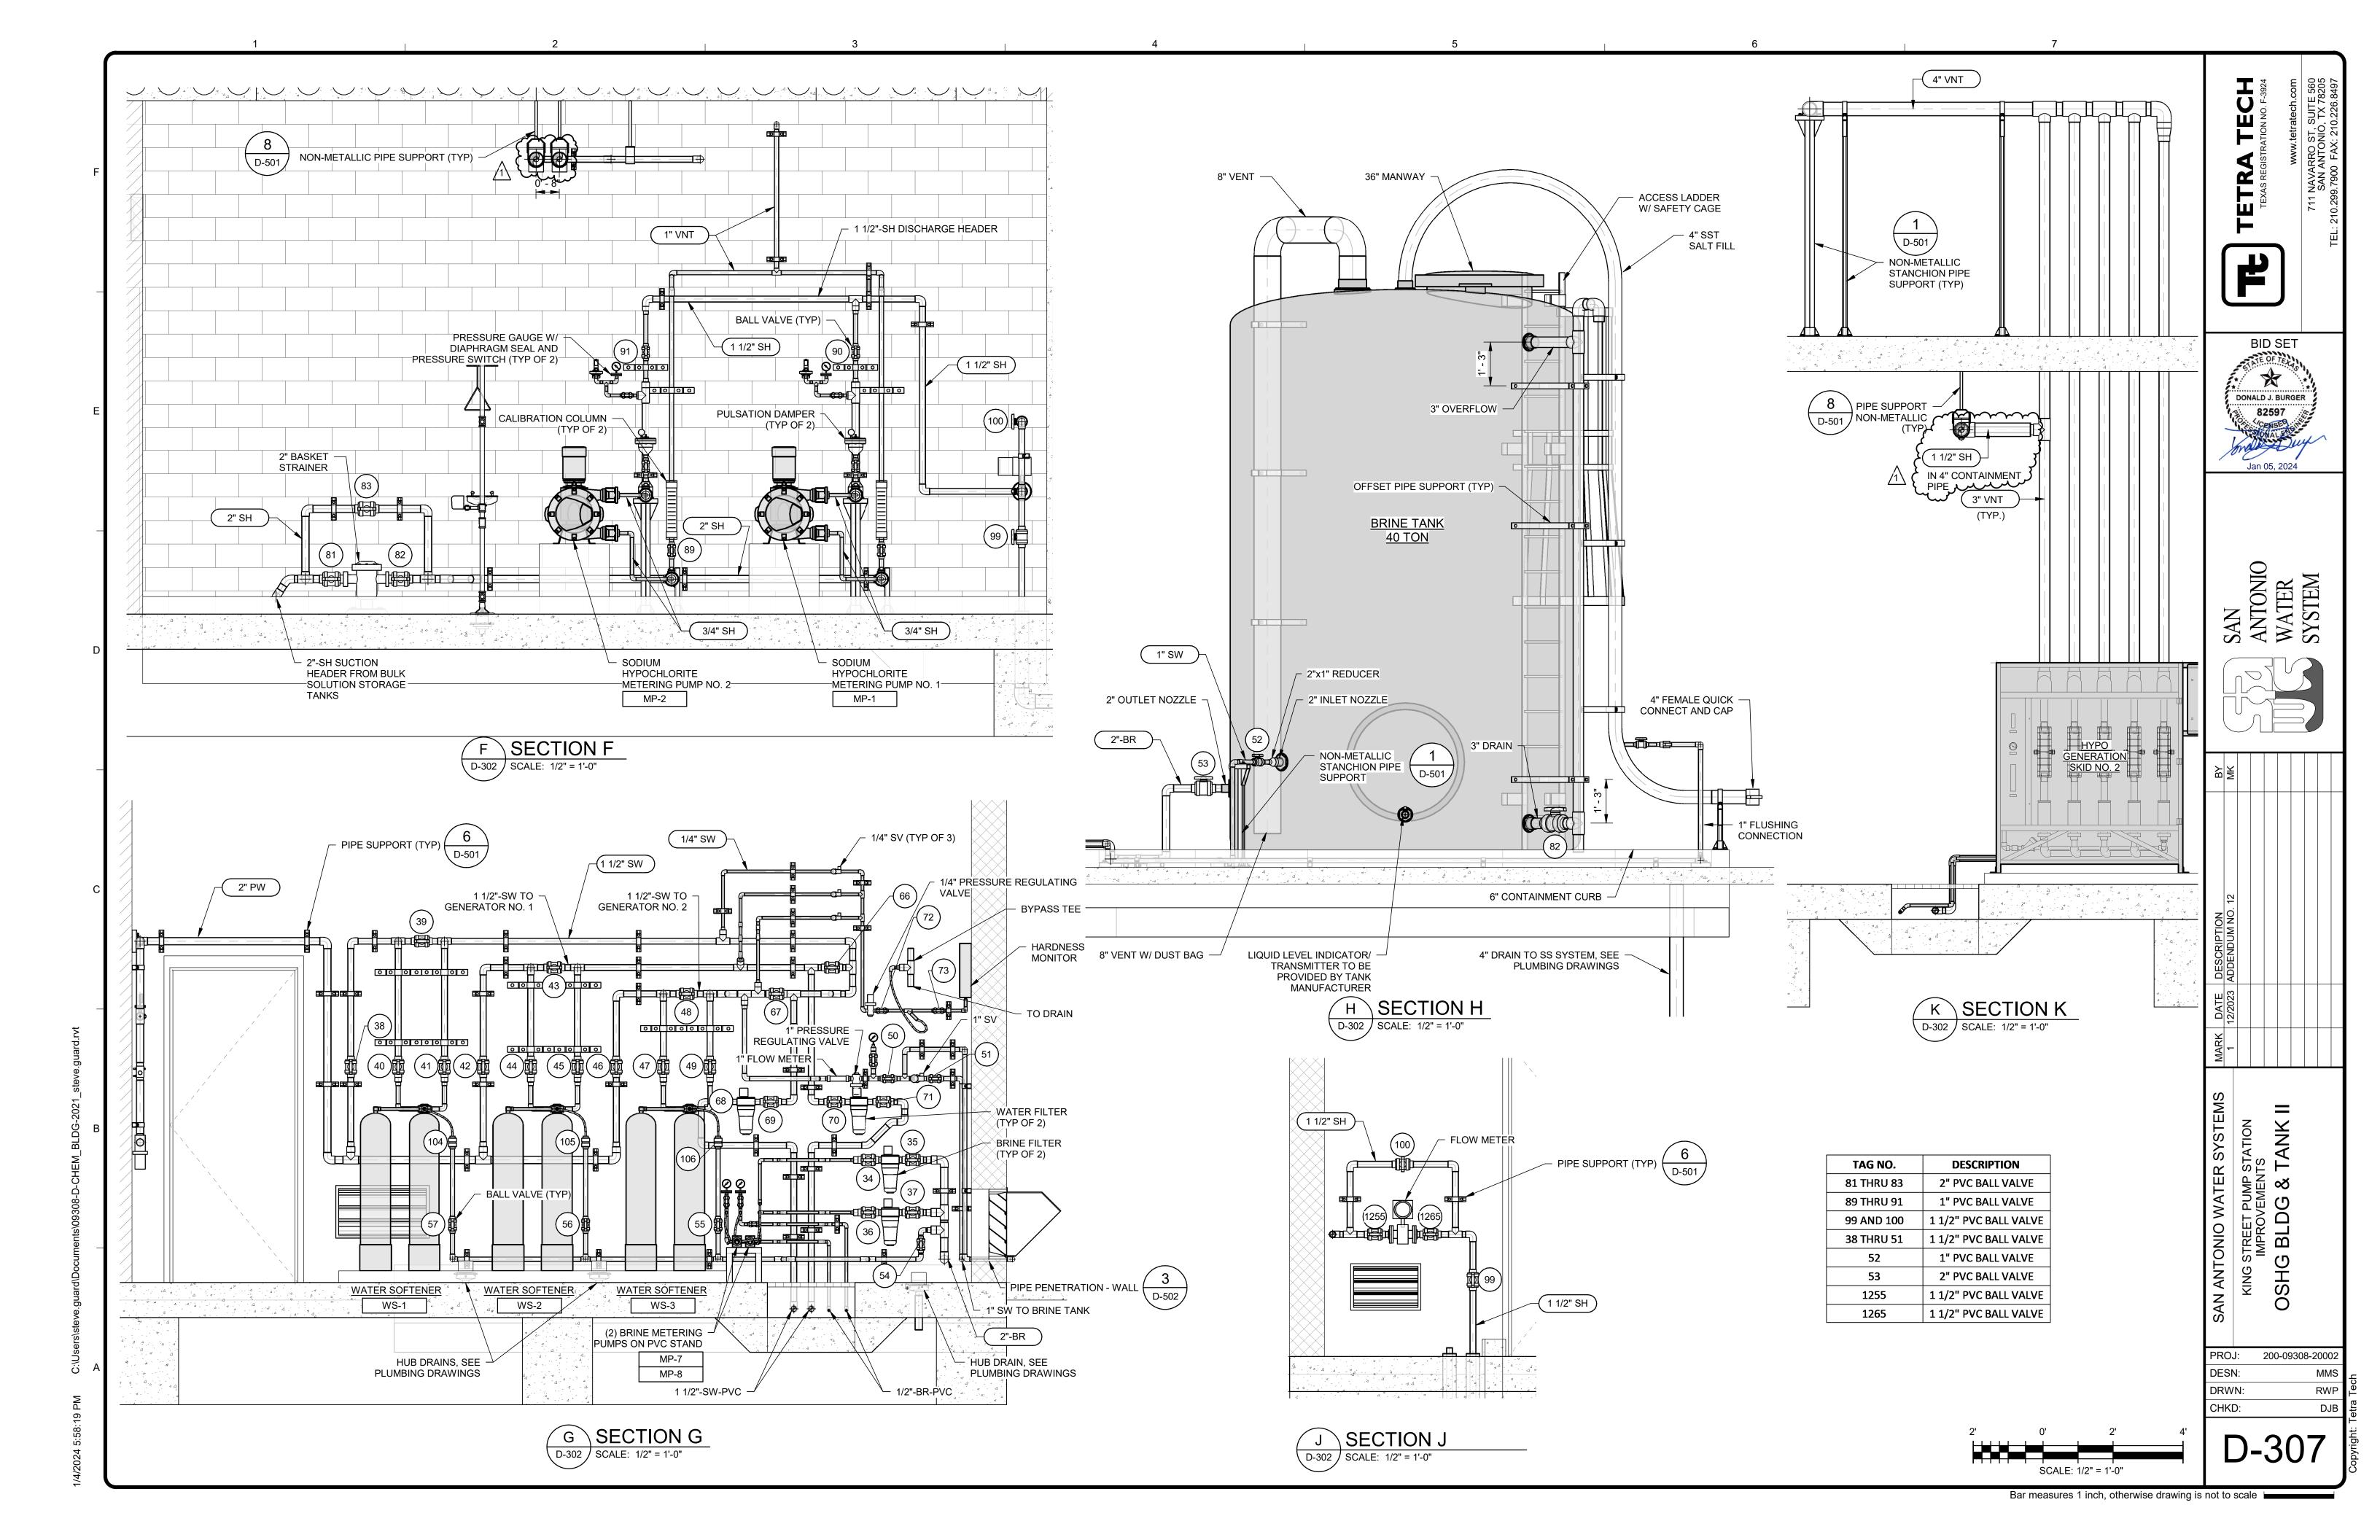Bar measures 1 inch, otherwise drawing is not to scale



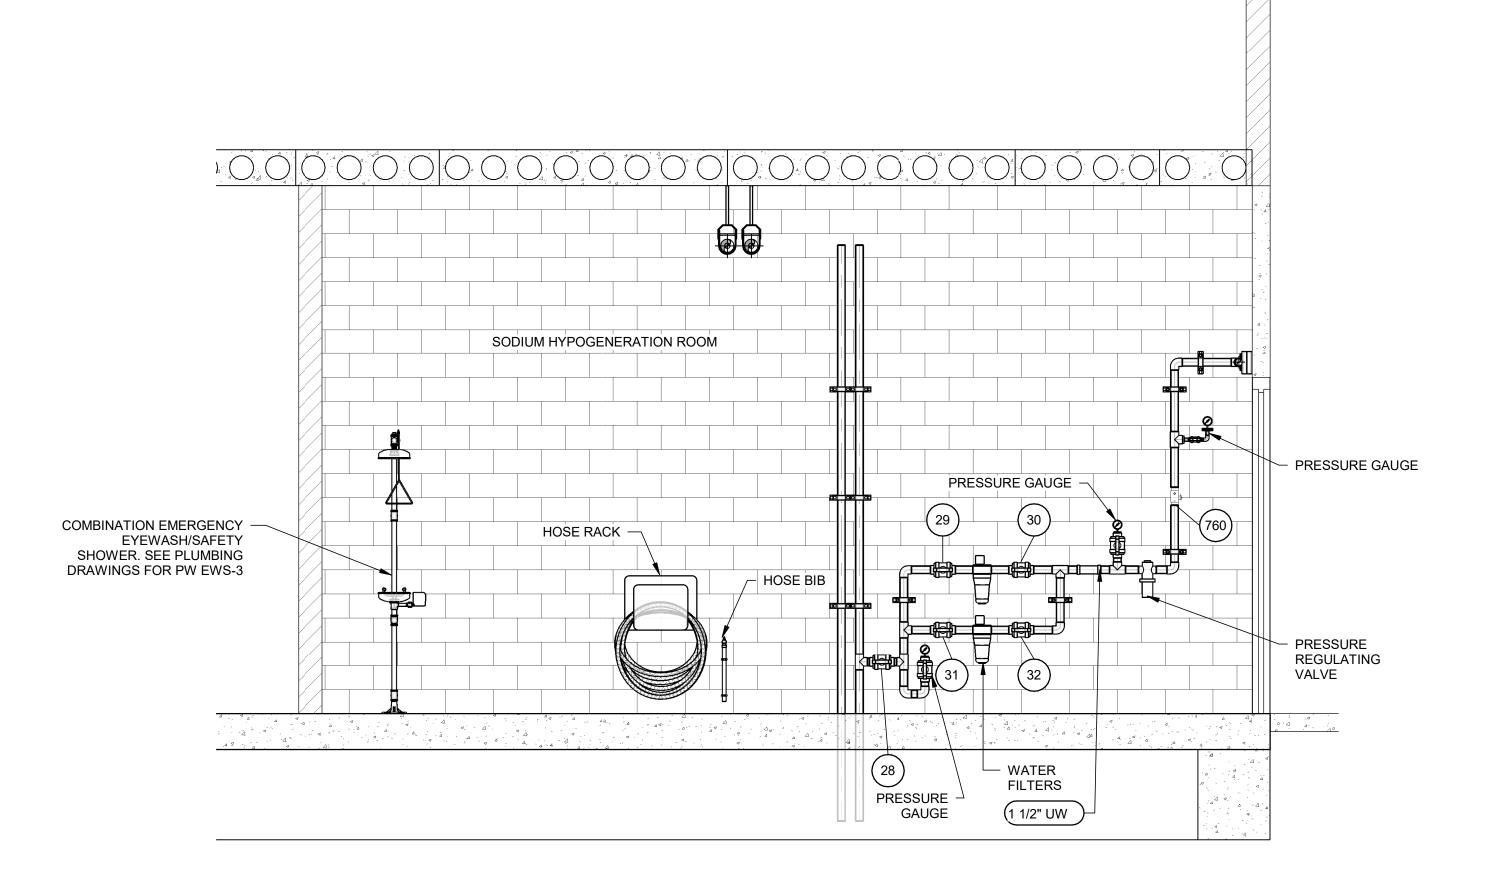
FLUORIDE BUILDING 1 2" HFA IN 2" CONTAINMENT PIPE COMBINATION EMERGENCY -EYEWASH/SAFETY SHOWER. (TYP OF 2), SEE PLUMBING DRAWINGS FOR PW EWS-3





FITTING LIST							
TAG NO.	DESCRIPTION						
07	1/2" CPVC CHECK VALVE						
22	1/2" CPVC BALL VALVE						
28-32	1 1/2" PVC BALL VALVE						
108-111	1/2" CPVC BALL VALVE						
760	1 1/2" MOTORIZED BALL VALVE						



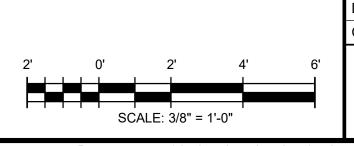

Bar measures 1 inch, otherwise drawing is not to scale

PROJ: 200-09308-20002 Designer Checker

KING STREET PU IMPROVEN ADDITIONAL


**BID SET** 

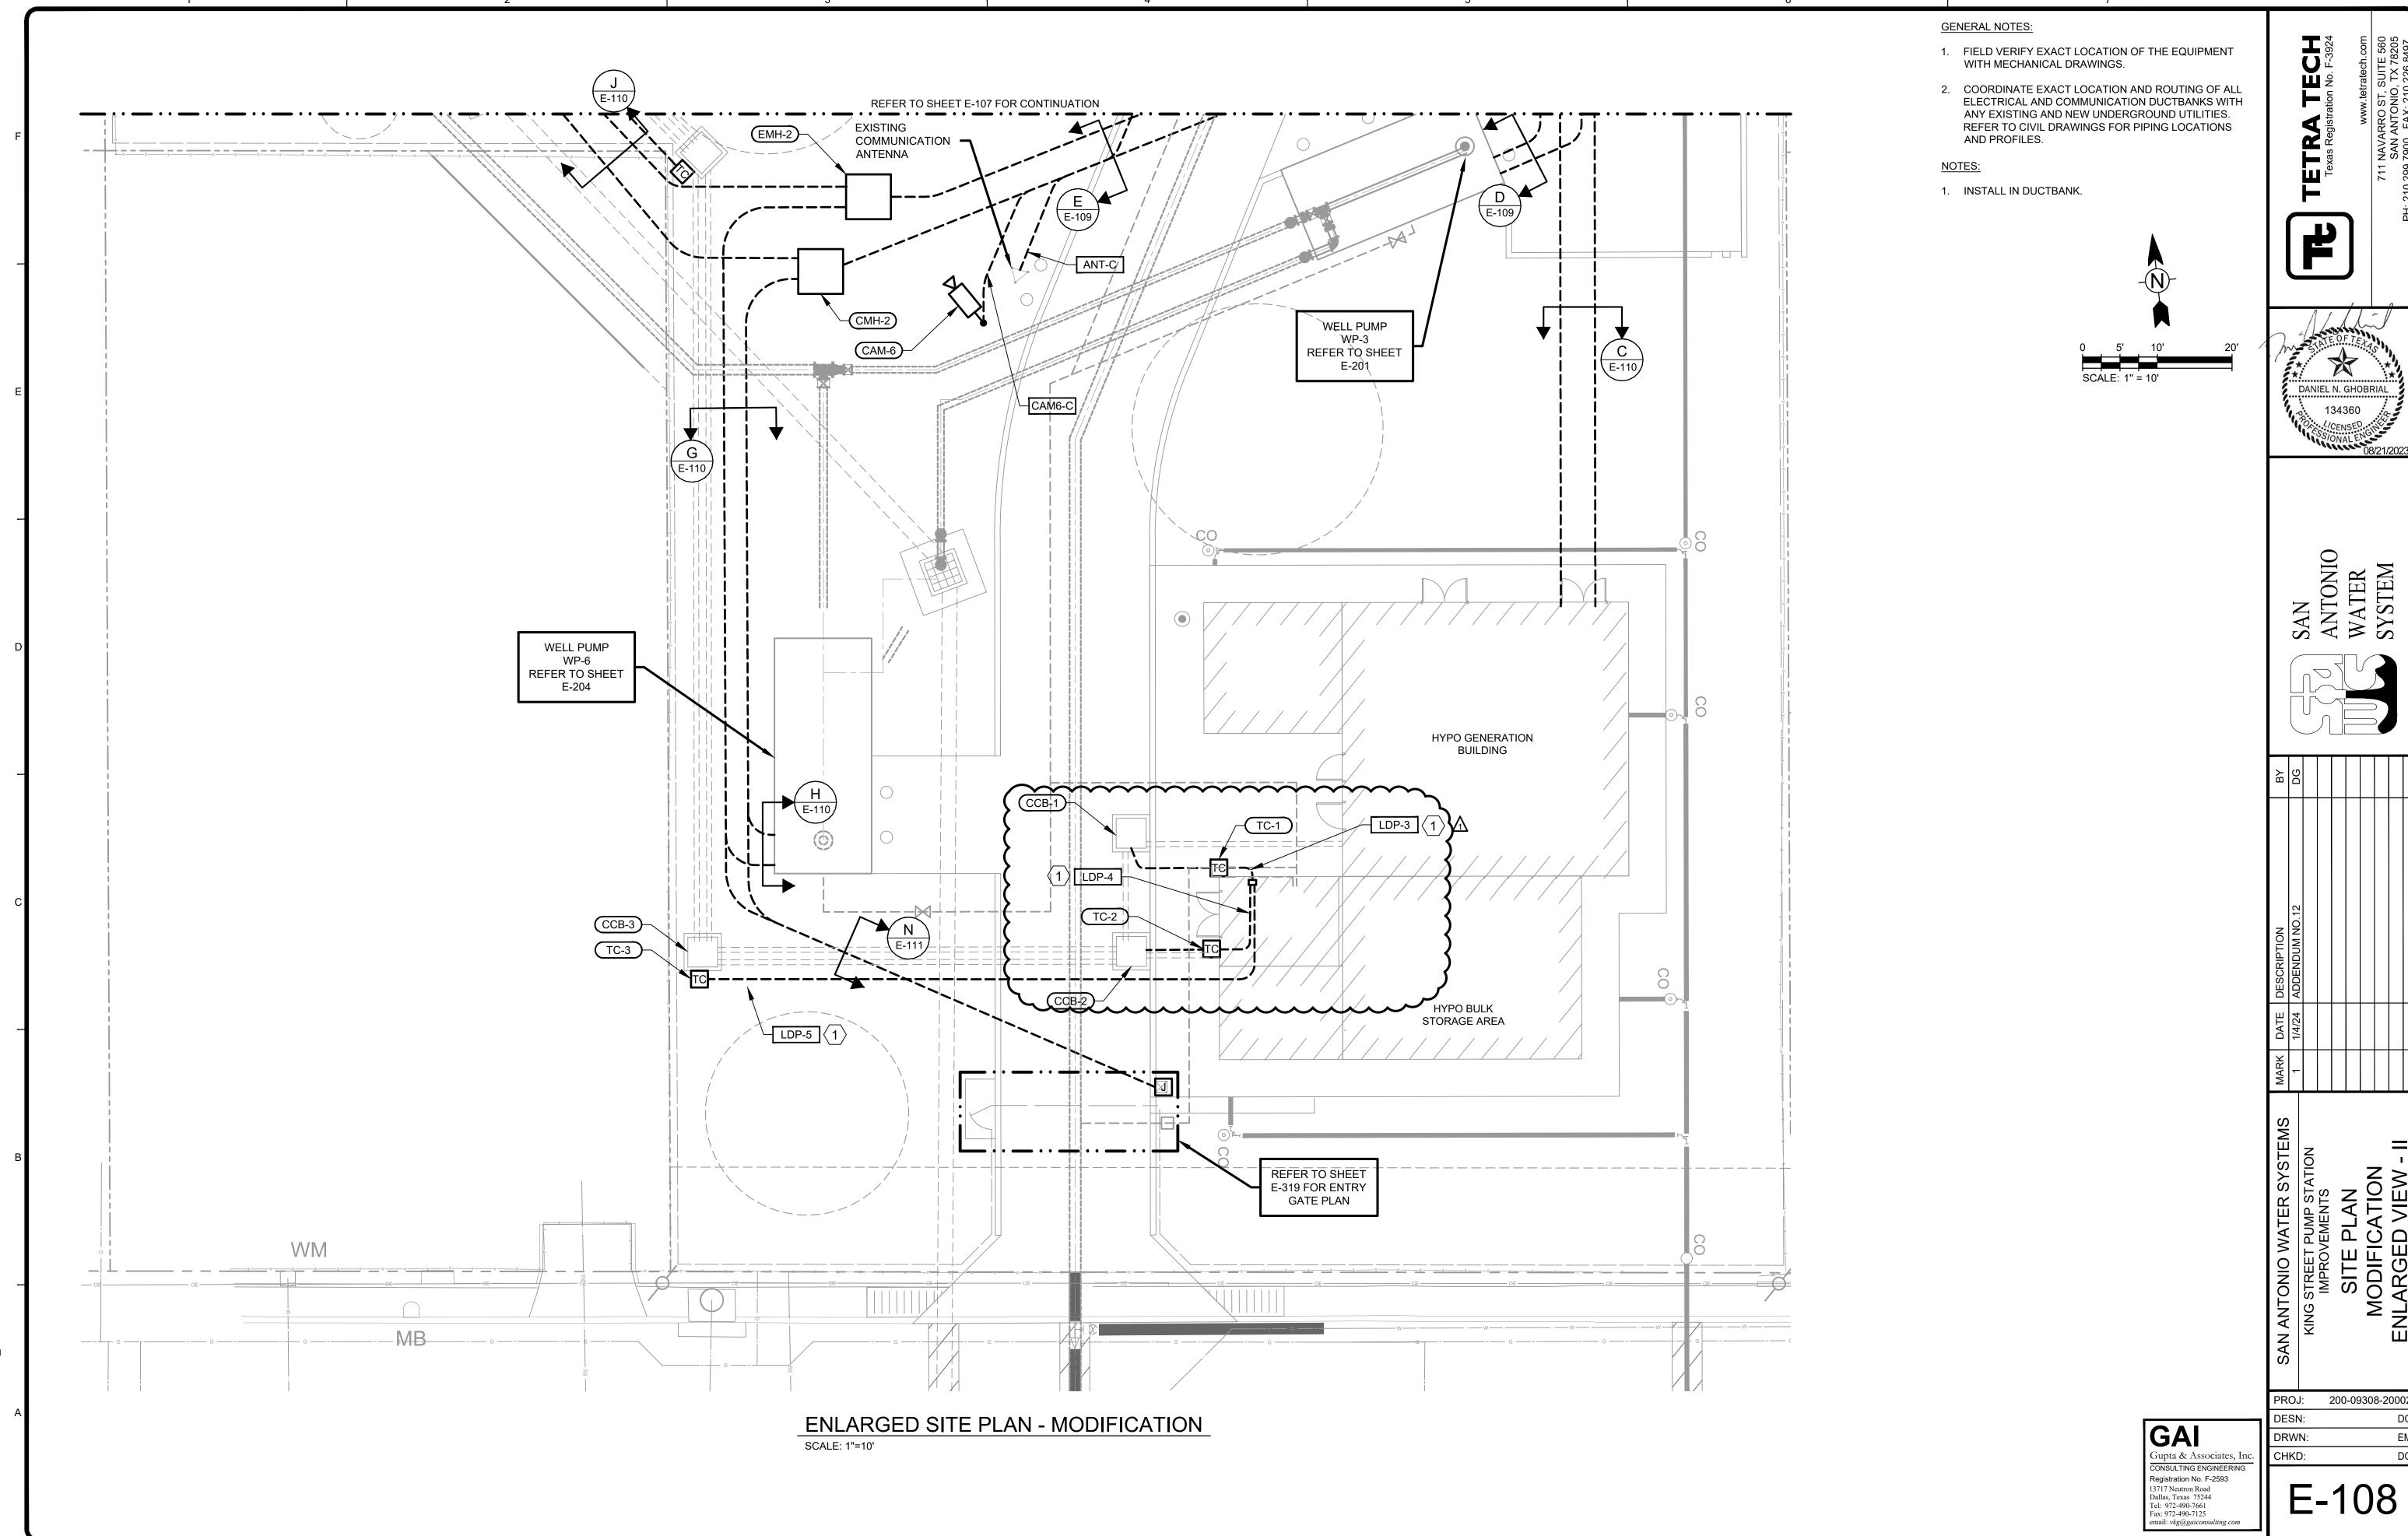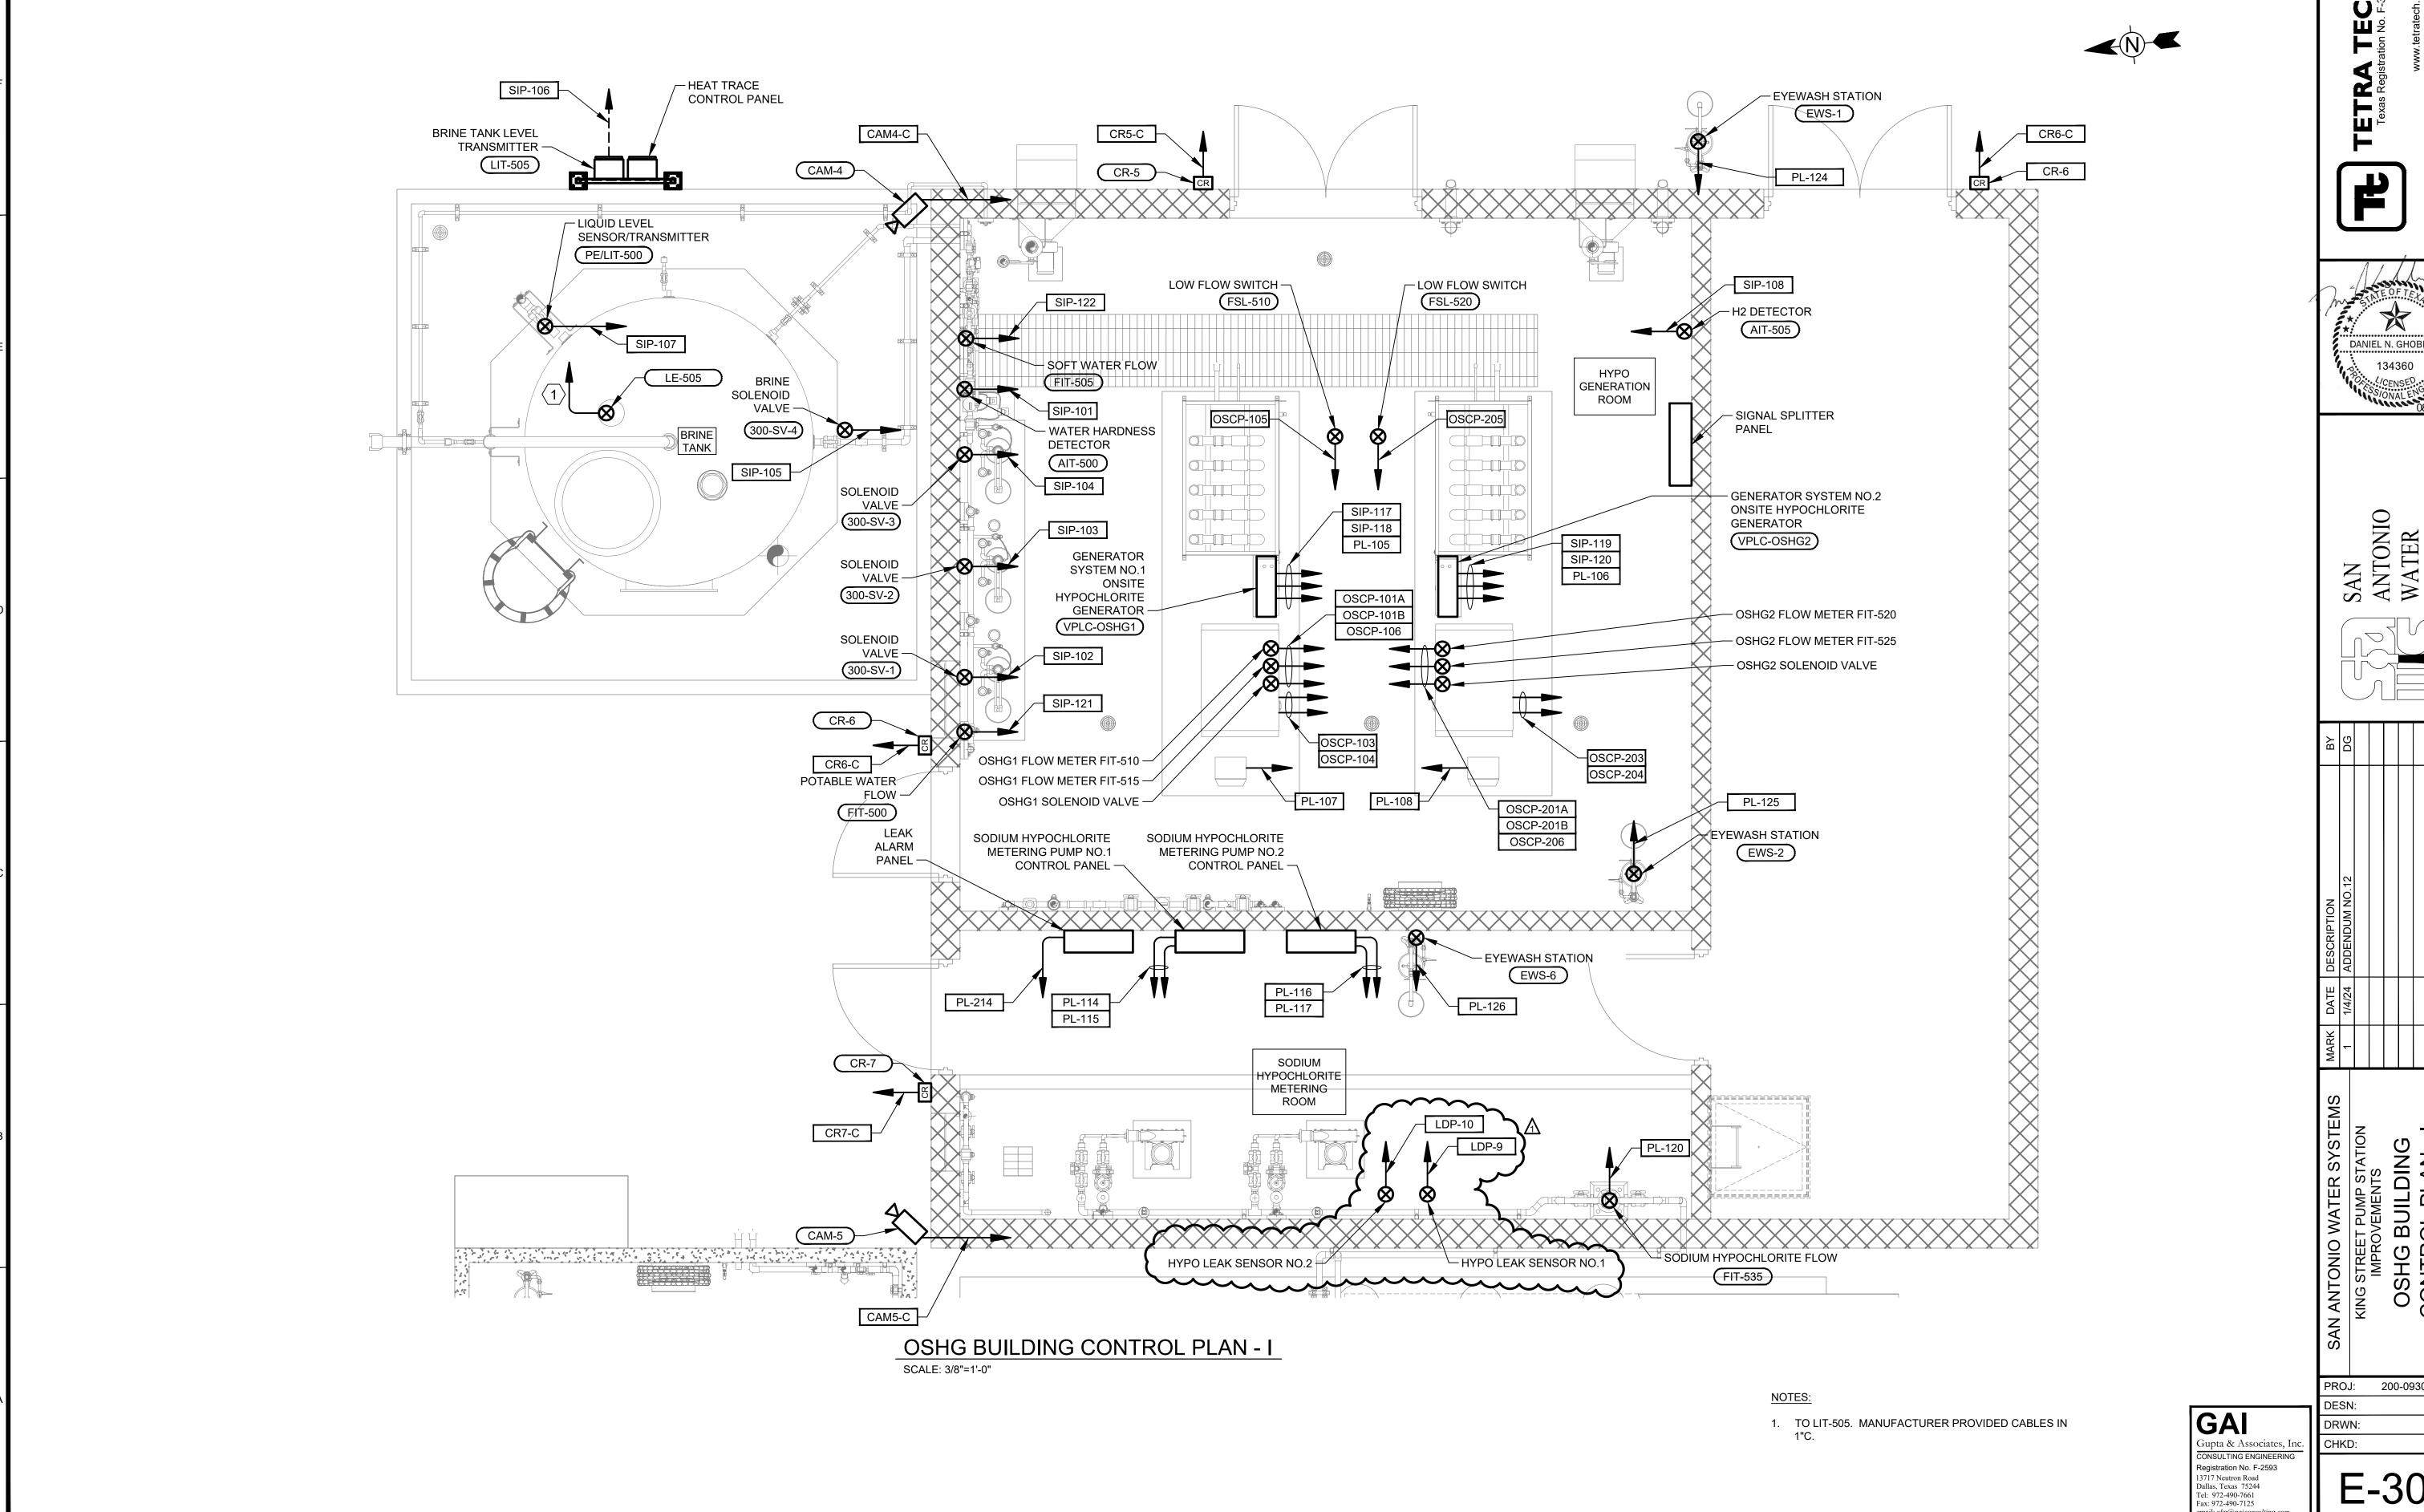
\*

DONALD J. BURGER 82597

찓롲


SAN ANTONIO WATER SYSTEMS







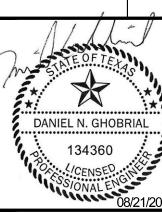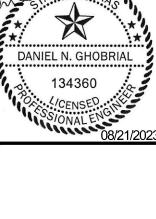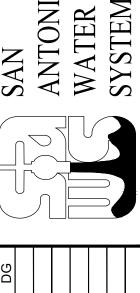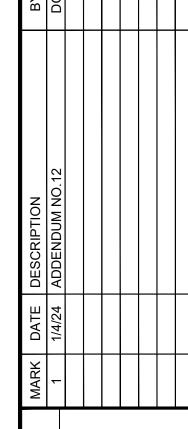
Bar Measures 1 inch, otherwise drawing not to scale












200-09308-20002

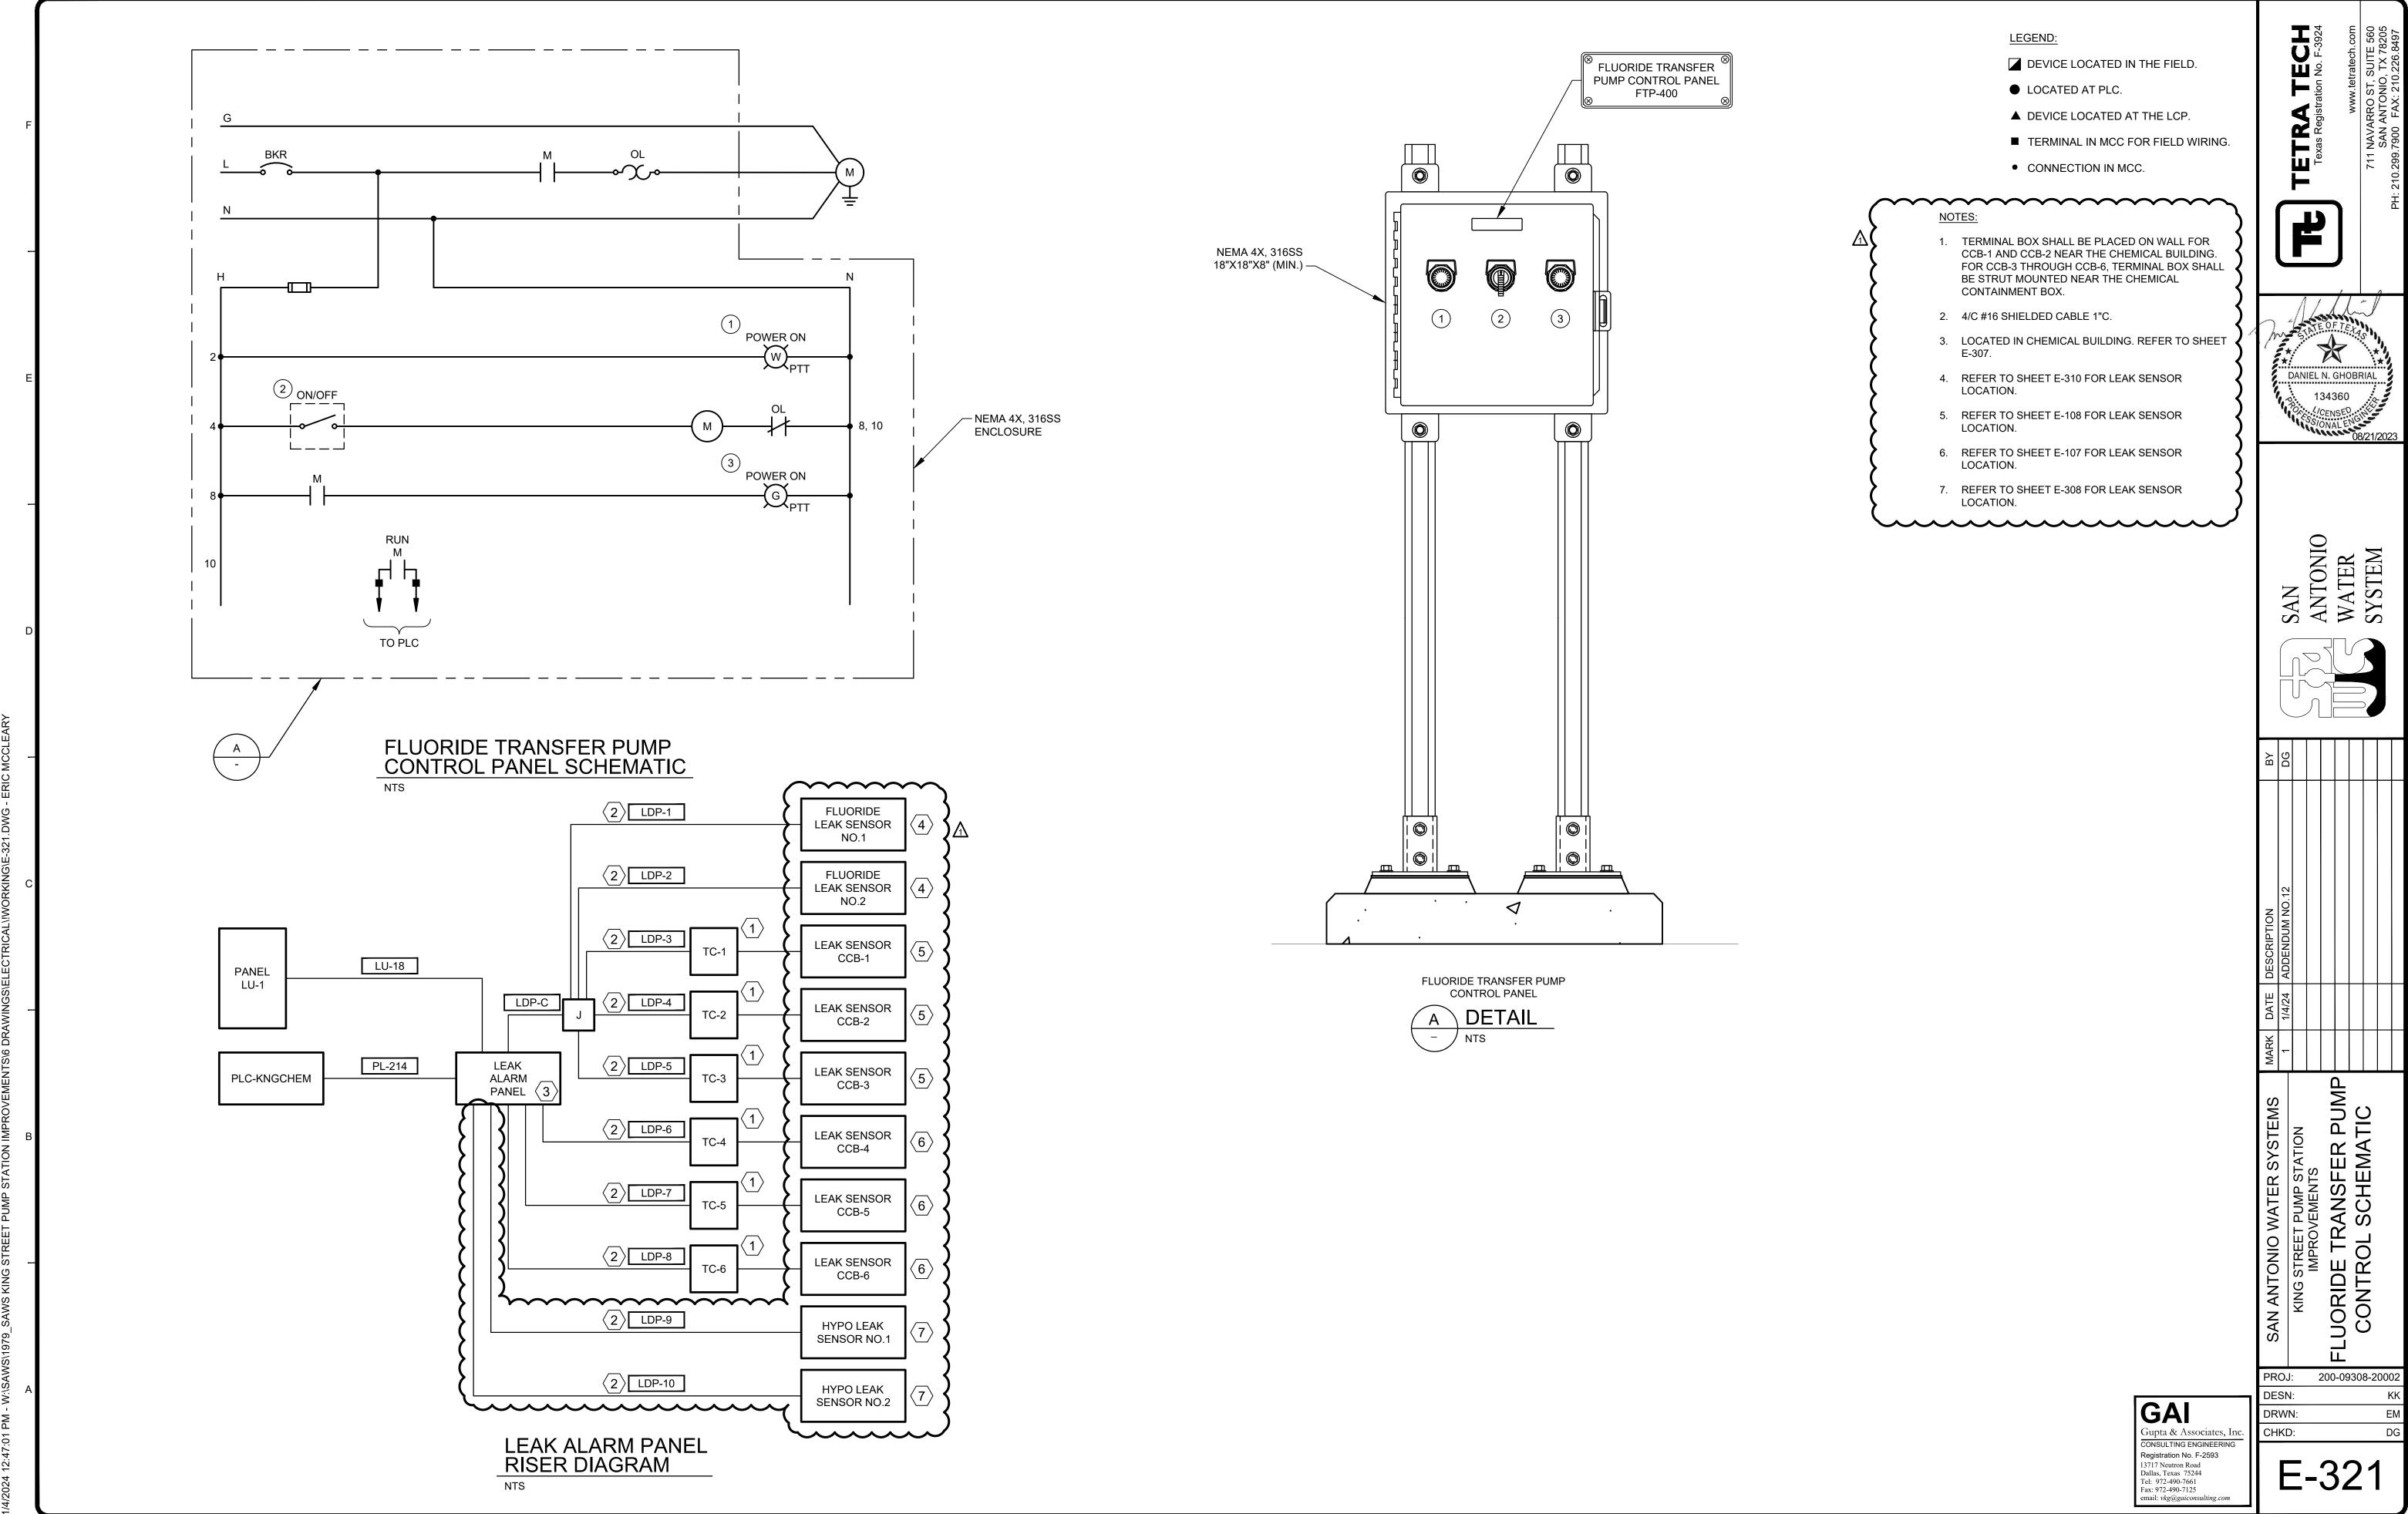E-308



Bar Measures 1 inch, otherwise drawing not to scale

