


SAN ANTONIO
WATER SYSTEM

JOB NO: XX-XXXX

JOB NAME
WATER PLANS

GENERAL NOTES:

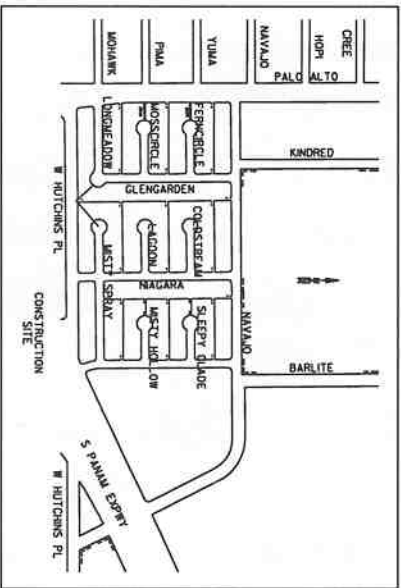

LOCATION MAP
NOT TO SCALE

AS-BUILT QUANTITIES

			
6" D.I.F.H.	6" D.I.M.A.-T/S	6" D.I.	12" D.I.
3	4	4	5.5
5.5	5.5	6.7	8.5
1.5	6.7	8.5	9
2	2	11.5	4.5
8.5	8.5	4.5	31.5
1.5	8.5	20	
1.5	1.5	15.5	
9	9		62
4.5	4.5		
1.5	20		
1.5	15		
1.5	31.5		
2	92		
55.5	272		

MATERIALS NOTE

AS-BUILT / PLAN OF RECORD

PIPE:	SAWS JOB NO.:
VALVES:	COMPLETION DATE:
FITTINGS:	CONTRACTOR:
FIRE HYDRANTS:	INSPECTOR: