

ADDENDUM NO. 6

Date: **1 November 2011**

San Antonio Water System

Project Name: **Olmos Basin Central Watershed Sewer Relief Line (C-3), Reaches 1 to 4**

Project No.: **08-2512**

Solicitation No.: **B-11-051-CM**

This addendum, applicable to work referenced above, is an amendment to the bidding documents and as such will be a part of and included in the Contract Documents. Acknowledge receipt of this addendum by entering the addendum number and issue date in the space provided in submitted copies of the proposal.

A. Bidding and Contract Requirement Revisions:

Item 1: Instructions to Bidders

- a) On Page IB-4, Item # 9, DELETE the following sentence: "In all cases, the written unit price in the bid shall govern." The remaining section of Item # 9 in the Instructions to Bidders shall remain.

Item 2: Specification Section 02504, Fiberglass Reinforced Polymer Mortar Pipe, Addendum No. 4

- a) DELETE Article 1.05 A. and REPLACE with the following:
"A. Pre-approved manufacturers for fiberglass reinforced polymer mortar pipe are listed below.

1. HOBAS, USA, Inc.
1413 Richey Road
Houston, TX 77073
2. FLOWTITE Pipe (Refer to Note 1 below)
18585 Samuels Road
Zachary, LA 70791
3. Future Pipe Industries Inc (Refer to Note 1 below)
11811 Proctor Road
Houston, TX 77038

Note 1: The approval of the Flowtite Pipe and Future Pipe products applies to pipe used in direct bury installation or installed within host pipe, casing or tunnel (i.e., slip line, bore with casing) installations. This approval does not apply to jacking where there is no host pipe or casing.

In all cases, Contractor shall adhere to pipe manufacturer's limitations for installation.

B. Drawing Revisions:

Item 1: Sheet ENV-3

- a) REMOVE and REPLACE Sheet ENV-3 with the revised Sheet ENV-3 attached to this addendum.

This Addendum, including these 2 pages, is 3 pages in its entirety.


Attachment(s)

Sheet ENV-3 (1 page)

Each bidder is requested to acknowledge receipt of this Addendum No. 6 by his/her signature affixed hereto and to file same with and attached to his/her bid.

Maridel Reyes Jimenez 11-1-11

Approved by ENGINEER
WESTON SOLUTIONS, INC.
TEXAS REGISTERED ENGINEERING FIRM F-3123

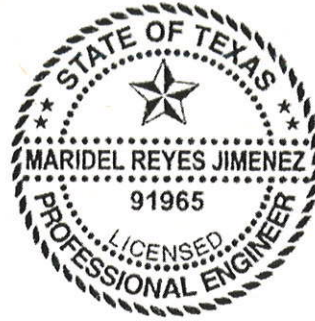

The undersigned acknowledges receipt of this Addendum No. 6 and the bid submitted herewith is in accordance with the information and stipulations set forth.

Date

Signature of Bidder

END OF ADDENDUM

TREE INVENTORY SUMMARY TABLE

REACH NUMBER	SHEET NUMBER	DBH (in)	TREE TYPE	66" DIA. FRPM		DESIGNATION	NOTES
				STATION	OFFSET		
C102	9	12	PECAN	5-67	27 W	SIGNIFICANT	TREE TO BE PROTECTED/PRESERVED
C102	12	12	HICKBERRY	5-66	26 W	SIGNIFICANT	TREE TO BE PROTECTED/PRESERVED
C102	14	10	HICKBERRY	5-60	25 W	SIGNIFICANT	TREE TO BE PROTECTED/PRESERVED
C102	10	10	CHINA BERRY	5-97	17 W	SIGNIFICANT	TREE TO BE PROTECTED/PRESERVED
C102	6	10	CHINA BERRY	6-01	19 W	NON-NATIVE	NON-NATIVE INVASIVE TREE; NOT PROTECTED
C102	6	10	CHINA BERRY	6-01	19 W	NON-NATIVE	NON-NATIVE INVASIVE TREE; NOT PROTECTED
C102	11	10	CHINA BERRY	6-05	19 W	NON-NATIVE	NON-NATIVE INVASIVE TREE; NOT PROTECTED
C102	17	12	HICKBERRY	6-08	26 W	SIGNIFICANT	TREE TO BE PROTECTED/PRESERVED
C102	6	10	CHINA BERRY	6-10	18 W	NON-NATIVE	NON-NATIVE INVASIVE TREE; NOT PROTECTED
C102	7	10	CHINA BERRY	6-17	18 W	NON-NATIVE	NON-NATIVE INVASIVE TREE; NOT PROTECTED
C102	7	10	CHINA BERRY	6-23	12 W	NON-NATIVE	NON-NATIVE INVASIVE TREE; NOT PROTECTED
C102	12	12	HICKBERRY	6-68	25 W	SIGNIFICANT	TREE TO BE PROTECTED/PRESERVED
C102	12	12	HICKBERRY	6-96	25 W	SIGNIFICANT	TREE TO BE PROTECTED/PRESERVED
C102	22	10	HICKBERRY	7-00	26 W	NON-NATIVE	NON-NATIVE INVASIVE TREE; NOT PROTECTED
C102	19	10	PECAN	7-30	8 W	SIGNIFICANT	TREE TO BE PROTECTED/PRESERVED
C103	8	8	OK	9-13	15 W	SIGNIFICANT	TREE TO BE PROTECTED/PRESERVED
C103	7	8	OK	9-50	17 W	SIGNIFICANT	TREE TO BE PROTECTED/PRESERVED
C103	4	8	OK	9-76	26 W	SMALL SPECIES	TREE TO BE PROTECTED/PRESERVED
C103	12	8	OK	9-93	2 W	SIGNIFICANT	TREE TO BE PROTECTED/PRESERVED
C103	12	8	OK	9-99	4 W	SIGNIFICANT	TREE TO BE PROTECTED/PRESERVED
C103	12	8	OK	10-02	1 W	SIGNIFICANT	TREE TO BE PROTECTED/PRESERVED
C103	10	8	OK	10-05	1 W	SIGNIFICANT	TREE TO BE PROTECTED/PRESERVED
C104	34	8	PECAN	15-54	9 W	HERITAGE	TREE LOCATED IN FLOODPLAIN; TO BE PROTECTED/PRESERVED
C104	7	8	MESQUITE	15-78	15 E	SMALL SPECIES	TREE LOCATED IN FLOODPLAIN; TO BE PROTECTED/PRESERVED
C104	8	8	PECAN	15-82	15 E	SIGNIFICANT	TREE LOCATED IN FLOODPLAIN; TO BE PROTECTED/PRESERVED
C104	24	8	MESQUITE	15-83	17 E	SIGNIFICANT	TREE LOCATED IN FLOODPLAIN; TO BE PROTECTED/PRESERVED
C105	24	8	MESQUITE	16-75	32 E	HERITAGE	TREE LOCATED IN FLOODPLAIN; TO BE PROTECTED/PRESERVED
C105	24	8	MESQUITE	18-20	10 W	HERITAGE	TREE LOCATED IN FLOODPLAIN; TO BE PROTECTED/PRESERVED
C105	8	8	OK	10-33	34 E	SIGNIFICANT	TREE LOCATED IN FLOODPLAIN; TO BE PROTECTED/PRESERVED
C105	8	8	OK	19-03	33 E	SIGNIFICANT	TREE LOCATED IN FLOODPLAIN; TO BE PROTECTED/PRESERVED
C105	20	8	POST OAK	21-09	19 E	HERITAGE	TREE LOCATED IN FLOODPLAIN; TO BE PROTECTED/PRESERVED
C106	10	8	CRAPE MYRTLE	22-25	11 E	SIGNIFICANT	TREE LOCATED IN FLOODPLAIN; TO BE PROTECTED/PRESERVED
C106	20	8	PECAN	22-44	21 W	SIGNIFICANT	TREE LOCATED IN FLOODPLAIN; TO BE PROTECTED/PRESERVED
C106	26	8	PECAN	22-64	19 W	HERITAGE	TREE LOCATED IN FLOODPLAIN; TO BE PROTECTED/PRESERVED
C106	26	8	PECAN	23-49	10 W	HERITAGE	TREE LOCATED IN FLOODPLAIN; TO BE PROTECTED/PRESERVED
C107	18	8	MESQUITE	24-79	26 W	SIGNIFICANT	TREE LOCATED IN FLOODPLAIN; TO BE PROTECTED/PRESERVED
C107	30	8	PECAN	26-62	38 E	HERITAGE	TREE LOCATED IN FLOODPLAIN; TO BE PROTECTED/PRESERVED
C107	15	8	PALM	27-50	51 W	SIGNIFICANT	TREE LOCATED IN FLOODPLAIN; TO BE PROTECTED/PRESERVED
C107	30	8	OK	27-50	15 W	HERITAGE	TREE LOCATED IN FLOODPLAIN; TO BE PROTECTED/PRESERVED
C107	15	8	PALM	27-50	15 E	SIGNIFICANT	TREE LOCATED IN FLOODPLAIN; TO BE PROTECTED/PRESERVED

TREE INVENTORY SUMMARY TABLE

REACH NUMBER	SHEET NUMBER	DBH (in)	TREE TYPE	66" DIA. FRPM		DESIGNATION	NOTES
				STATION	OFFSET		
C201	10	12	PALM	27-75	48 W	SIGNIFICANT	TREE LOCATED IN FLOODPLAIN; TO BE PROTECTED/PRESERVED
C201	12	12	MESQUITE	29-55	21 W	SIGNIFICANT	TREE LOCATED IN FLOODPLAIN; TO BE PROTECTED/PRESERVED
C201	24	12	COTTONWOOD	30-50	29 W	HERITAGE	TREE LOCATED IN FLOODPLAIN; TO BE PROTECTED/PRESERVED
C202	6	12	COTTONWOOD	32-46	11 W	SIGNIFICANT	TREE LOCATED IN FLOODPLAIN; TO BE PROTECTED/PRESERVED
C202	18	12	COTTONWOOD	32-70	44 W	SIGNIFICANT	TREE LOCATED IN FLOODPLAIN; TO BE PROTECTED/PRESERVED
C202	6	12	COTTONWOOD	32-75	76 W	SIGNIFICANT	TREE LOCATED IN FLOODPLAIN; TO BE PROTECTED/PRESERVED
C202	7	12	PECAN	33-50	75 W	SIGNIFICANT	TREE LOCATED IN FLOODPLAIN; TO BE PROTECTED/PRESERVED
C202	11	12	OK	33-94	34 W	SIGNIFICANT	TREE LOCATED IN FLOODPLAIN; TO BE PROTECTED/PRESERVED
C203	11	12	OK	34-25	10 W	SIGNIFICANT	TREE LOCATED IN FLOODPLAIN; TO BE PROTECTED/PRESERVED
C203	18D	12	CEAR ELM	34-70	18 E	TBD	TREE LOCATED IN FLOODPLAIN; TO BE PROTECTED/PRESERVED
C203	4	12	PERSIMMON	35-70	65 W	SMALL SPECIES	TREE LOCATED IN FLOODPLAIN; TO BE PROTECTED/PRESERVED
C203	5	12	PERSIMMON	35-76	48 W	SIGNIFICANT	TREE LOCATED IN FLOODPLAIN; TO BE PROTECTED/PRESERVED
C203	24	12	CEAR ELM	35-91	34 E	HERITAGE	TREE LOCATED IN FLOODPLAIN; TO BE PROTECTED/PRESERVED
C203	17	12	CEAR ELM	36-10	29 E	SIGNIFICANT	TREE LOCATED IN FLOODPLAIN; TO BE PROTECTED/PRESERVED
C203	18	12	ASH	36-16	20 W	SIGNIFICANT	TREE LOCATED IN FLOODPLAIN; TO BE PROTECTED/PRESERVED
C203	19	12	CEAR ELM	36-31	34 E	SIGNIFICANT	TREE LOCATED IN FLOODPLAIN; TO BE PROTECTED/PRESERVED
C203	17	12	CEAR ELM	36-47	35 E	SIGNIFICANT	TREE LOCATED IN FLOODPLAIN; TO BE PROTECTED/PRESERVED
C204	9	12	OK	36-56	42 W	SIGNIFICANT	TREE LOCATED IN FLOODPLAIN; TO BE PROTECTED/PRESERVED
C204	7	12	HICKORY	36-72	19 E	SIGNIFICANT	TREE LOCATED IN FLOODPLAIN; TO BE PROTECTED/PRESERVED
C204	17	12	CEAR ELM	37-04	37 E	SIGNIFICANT	TREE LOCATED IN FLOODPLAIN; TO BE PROTECTED/PRESERVED
C204	24	12	MESQUITE	38-35	26 W	HERITAGE	TREE LOCATED IN FLOODPLAIN; TO BE PROTECTED/PRESERVED
C204	26	12	CEAR ELM	39-90	42 E	HERITAGE	TREE LOCATED IN FLOODPLAIN; TO BE PROTECTED/PRESERVED
C204	16	12	CEAR ELM	40-26	50 E	SIGNIFICANT	TREE LOCATED IN FLOODPLAIN; TO BE PROTECTED/PRESERVED
C205	18	12	CEAR ELM	40-70	37 E	SIGNIFICANT	TREE LOCATED IN FLOODPLAIN; TO BE PROTECTED/PRESERVED
C205	14	12	CEAR ELM	41-12	24 E	SIGNIFICANT	TREE LOCATED IN FLOODPLAIN; TO BE PROTECTED/PRESERVED
C205	12	12	CEAR ELM	41-24	53 E	SIGNIFICANT	TREE LOCATED IN FLOODPLAIN; TO BE PROTECTED/PRESERVED
C205	18	12	CEAR ELM	41-29	27 E	SIGNIFICANT	TREE LOCATED IN FLOODPLAIN; TO BE PROTECTED/PRESERVED
C205	24	12	CEAR ELM	41-36	34 E	HERITAGE	TREE LOCATED IN FLOODPLAIN; TO BE PROTECTED/PRESERVED
C205	18D	12	COTTONWOOD	42-00	67 W	TBD	TREE LOCATED IN FLOODPLAIN; TO BE PROTECTED/PRESERVED

TREE INVENTORY SUMMARY TABLE

REACH NUMBER	SHEET NUMBER	DBH (in)	TREE TYPE	66" DIA. FRPM		DESIGNATION	NOTES
				STATION	OFFSET		
C301	22	12	CEAR ELM	43-44	29 E	SIGNIFICANT	TREE LOCATED IN FLOODPLAIN; TO BE PROTECTED/PRESERVED
C301	19	12	CEAR ELM	43-57	16 E	SIGNIFICANT	TREE LOCATED IN FLOODPLAIN; TO BE PROTECTED/PRESERVED
C301	8	12	CEAR ELM	43-65	25 W	SIGNIFICANT	TREE LOCATED IN FLOODPLAIN; TO BE PROTECTED/PRESERVED
C301	15	12	CEAR ELM	43-93	22 W	SIGNIFICANT	TREE LOCATED IN FLOODPLAIN; TO BE PROTECTED/PRESERVED
C301	10	12	CEAR ELM	44-04	21 W	SIGNIFICANT	TREE LOCATED IN FLOODPLAIN; TO BE PROTECTED/PRESERVED
C301	9	12	CEAR ELM	44-10	5 W	SIGNIFICANT	TREE LOCATED IN FLOODPLAIN; TO BE PROTECTED/PRESERVED
C301	13	12	CEAR ELM	44-11	9 W	SIGNIFICANT	TREE LOCATED IN FLOODPLAIN; TO BE PROTECTED/PRESERVED
C301	17	12	CEAR ELM	44-23	14 E	SIGNIFICANT	TREE LOCATED IN FLOODPLAIN; TO BE PROTECTED/PRESERVED
C301	17	12	CEAR ELM	44-44	29 E	SIGNIFICANT	TREE LOCATED IN FLOODPLAIN; TO BE PROTECTED/PRESERVED
C301	10	12	CEAR ELM	44-56	9 W	SIGNIFICANT	TREE LOCATED IN FLOODPLAIN; TO BE PROTECTED/PRESERVED
C301	16	12	CEAR ELM	44-66	15 E	SIGNIFICANT	TREE LOCATED IN FLOODPLAIN; TO BE PROTECTED/PRESERVED
C301	16	12	CEAR ELM	44-77	10 W	SIGNIFICANT	TREE LOCATED IN FLOODPLAIN; TO BE PROTECTED/PRESERVED
C301	9	12	CEAR ELM	44-79	10 W	SIGNIFICANT	TREE LOCATED IN FLOODPLAIN; TO BE PROTECTED/PRESERVED
C301	16	12	CEAR ELM	44-79	4 W	SIGNIFICANT	TREE LOCATED IN FLOODPLAIN; TO BE PROTECTED/PRESERVED
C301	16	12	CEAR ELM	45-27	8 W	SIGNIFICANT	TREE LOCATED IN FLOODPLAIN; TO BE PROTECTED/PRESERVED
C301	18	12	CEAR ELM	45-53	4 W	SIGNIFICANT	TREE LOCATED IN FLOODPLAIN; TO BE PROTECTED/PRESERVED
C301	22	12	CEAR ELM	45-66	9 W	SIGNIFICANT	TREE LOCATED IN FLOODPLAIN; TO BE PROTECTED/PRESERVED
C301	15	12	CEAR ELM	45-94	22 W	SIGNIFICANT	TREE LOCATED IN FLOODPLAIN; TO BE PROTECTED/PRESERVED
C301	12	12	CEAR ELM	46-06	18 W	SIGNIFICANT	TREE LOCATED IN FLOODPLAIN; TO BE PROTECTED/PRESERVED
C301	15	12	CEAR ELM	46-52	29 E	SIGNIFICANT	TREE LOCATED IN FLOODPLAIN; TO BE PROTECTED/PRESERVED
C301	13	12	CEAR ELM	46-54	9 W	SIGNIFICANT	TREE LOCATED IN FLOODPLAIN; TO BE PROTECTED/PRESERVED
C301	10	12	CEAR ELM	46-56	18 W	SIGNIFICANT	TREE LOCATED IN FLOODPLAIN; TO BE PROTECTED/PRESERVED
C301	4	12	CEAR ELM	46-62	11 W	SMALL SPECIES	TREE LOCATED IN FLOODPLAIN; TO BE PROTECTED/PRESERVED
C301	17	12	CEAR ELM	46-66	17 W	SIGNIFICANT	TREE LOCATED IN FLOODPLAIN; TO BE PROTECTED/PRESERVED
C301	15	12	CEAR ELM	46-68	30 E	SIGNIFICANT	TREE LOCATED IN FLOODPLAIN; TO BE PROTECTED/PRESERVED
C301	14	12	CEAR ELM	46-89	9 W	SIGNIFICANT	TREE LOCATED IN FLOODPLAIN; TO BE PROTECTED/PRESERVED
C301	15	12	CEAR ELM	47-00	17 E	SIGNIFICANT	TREE LOCATED IN FLOODPLAIN; TO BE PROTECTED/PRESERVED
C302	14	12	CEAR ELM	47-02	16 W	SIGNIFICANT	TREE LOCATED IN FLOODPLAIN; TO BE PROTECTED/PRESERVED
C302	24	12	CEAR ELM	47-65	29 E	HERITAGE	TREE LOCATED IN FLOODPLAIN; TO BE PROTECTED/PRESERVED
C302	11	12	OK	48-52	15 W	SIGNIFICANT	TREE LOCATED IN FLOODPLAIN; TO BE PROTECTED/PRESERVED
C302	16	12	OK	48-56	7 W	SIGNIFICANT	TREE LOCATED IN FLOODPLAIN; TO BE PROTECTED/PRESERVED
C302	9	12	OK	49-92	17 W	SIGNIFICANT	TREE LOCATED IN FLOODPLAIN; TO BE PROTECTED/PRESERVED
C302	12	12	OK	49-17	24 W	SIGNIFICANT	TREE LOCATED IN FLOODPLAIN; TO BE PROTECTED/PRESERVED
C302	18	12	PECAN	49-47	19 E	SIGNIFICANT	TREE LOCATED IN FLOODPLAIN; TO BE PROTECTED/PRESERVED
C302	12	12	OK	49-71	7 W	SIGNIFICANT	TREE LOCATED IN FLOODPLAIN; TO BE PROTECTED/PRESERVED
C302	12	12	OK	49-27	21 W	SIGNIFICANT	TREE LOCATED IN FLOODPLAIN; TO BE PROTECTED/PRESERVED
C302	11	12	OK	51-22	22 W	SIGNIFICANT	TREE LOCATED IN FLOODPLAIN; TO BE PROTECTED/PRESERVED
C302	12	12	OK	51-45	21 W	SIGNIFICANT	TREE LOCATED IN FLOODPLAIN; TO BE PROTECTED/PRESERVED
C303	24	12	CEAR ELM	51-61	17 E	HERITAGE	TREE LOCATED IN FLOODPLAIN; TO BE PROTECTED/PRESERVED
C303	10	12	OK	52-74	25 W	SIGNIFICANT	TREE LOCATED IN FLOODPLAIN; TO BE PROTECTED/PRESERVED
C303	15	12	CEAR ELM	52-81	16 E	SIGNIFICANT	TREE LOCATED IN FLOODPLAIN; TO BE PROTECTED/PRESERVED
C303	22	12	CEAR ELM	53-00	17 W	SIGNIFICANT	TREE LOCATED IN FLOODPLAIN; TO BE PROTECTED/PRESERVED
C303	20	12	CEAR ELM	53-08	27 W	SIGNIFICANT	TREE LOCATED IN FLOODPLAIN; TO BE PROTECTED/PRESERVED
C303	10	12	OK	53-29	25 W	SIGNIFICANT	TREE LOCATED IN FLOODPLAIN; TO BE PROTECTED/PRESERVED
C303	20	12	CEAR ELM	53-29	29 E	SIGNIFICANT	TREE LOCATED IN FLOODPLAIN; TO BE PROTECTED/PRESERVED
C303	16	12	CEAR ELM	54-02	10 E	SIGNIFICANT	TREE LOCATED IN FLOODPLAIN; TO BE PROTECTED/PRESERVED
C303	16	12	CEAR ELM	54-07	28 E	SIGNIFICANT	TREE LOCATED IN FLOODPLAIN; TO BE PROTECTED/PRESERVED
C303	16	12	CEAR ELM	54-14	16 W	HERITAGE	TREE LOCATED IN FLOODPLAIN; TO BE PROTECTED/PRESERVED
C303	11	12	CEAR ELM	54-16	12 E	SIGNIFICANT	TREE LOCATED IN FLOODPLAIN; TO BE PROTECTED/PRESERVED
C303	16	12	CEAR ELM	54-29	19 E	SIGNIFICANT	TREE LOCATED IN FLOODPLAIN; TO BE PROTECTED/PRESERVED
C303	14	12	CEAR ELM	54-30	24 E	SIGNIFICANT	TREE LOCATED IN FLOODPLAIN; TO BE PROTECTED/PRESERVED
C304	17	12	CEAR ELM	54-53	40 E	SIGNIFICANT	TREE LOCATED IN FLOODPLAIN; TO BE PROTECTED/PRESERVED
C304	24	12	CEAR ELM	54-68	7 W	HERITAGE	TREE LOCATED IN FLOODPLAIN; TO BE PROTECTED/PRESERVED
C304	24	12	CEAR ELM	55-13	52 E	SIGNIFICANT	TREE TO BE PROTECTED/PRESERVED
C304	8	12	CEAR ELM	55-65	1 W	SIGNIFICANT	TREE TO BE PROTECTED/PRESERVED
C304	7	12	CEAR ELM	55-78	5 W	SIGNIFICANT	TREE TO BE PROTECTED/PRESERVED
C304	25	12	CEAR ELM	55-78	0	HERITAGE	TREE TO BE PROTECTED/PRESERVED
C304	14	12	CEAR ELM	56-05	0	SIGNIFICANT	TREE TO BE PROTECTED/PRESERVED
C304	20	12	CEAR ELM	56-16	61 E	SIGNIFICANT	TREE TO BE PROTECTED/PRESERVED
C304	12	12	CEAR ELM	56-16	4 W	SIGNIFICANT	TREE TO BE PROTECTED/PRESERVED
C304	12	12	CEAR ELM	56-20	1 W	SIGNIFICANT	TREE TO BE PROTECTED/PRESERVED
C304	14	12	CEAR ELM	56-73	4 E	SIGNIFICANT	TREE TO BE PROTECTED/PRESERVED
C304	17	12	OK	57-32	5 W	SIGNIFICANT	TREE TO BE PROTECTED/PRESERVED
C304	17	12	OK	57-73	7 W	SIGNIFICANT	TREE TO BE PROTECTED/PRESERVED
C304	18	12	OK	58-02	20 E	SIGNIFICANT	TREE TO BE PROTECTED/PRESERVED
C304	16	12	CEAR ELM	58-18	7 W	SIGNIFICANT	TREE TO BE PROTECTED/PRESERVED
C304	16	12	CEAR ELM	58-34	19 E	SIGNIFICANT	TREE TO BE PROTECTED/PRESERVED
C304	16	12	CEAR ELM	58-41	10 W	SIGNIFICANT	TREE TO BE PROTECTED/PRESERVED
C305	10	12	CEAR ELM	58-62	8 W	SIGNIFICANT	TREE TO BE PROTECTED/PRESERVED
C305	10	12	CEAR ELM	58-82	7 W	SIGNIFICANT	TREE TO BE PROTECTED/PRESERVED
C305	10	12	CEAR ELM	58-96	19 E	SIGNIFICANT	TREE TO BE PROTECTED/PRESERVED
C305	10	12	CEAR ELM	59-07	29 E	SIGNIFICANT	TREE TO BE PROTECTED/PRESERVED
C305	11	12	CEAR ELM	59-08	15 W	SIGNIFICANT	TREE TO BE PROTECTED/PRESERVED
C305	12	12	CEAR ELM	59-09	15 E	SIGNIFICANT	TREE TO BE PROTECTED/PRESERVED
C305	9	12	CEAR ELM	59-14	22 E	SIGNIFICANT	TREE TO BE PROTECTED/PRESERVED
C305	10	12	CEAR ELM	59-30	10 W	SIGNIFICANT	TREE TO BE PROTECTED/PRESERVED
C305	9	12	CEAR ELM	59-38	15 W	SIGNIFICANT	TREE TO BE PROTECTED/PRESERVED
C305	8	12	CEAR ELM	59-47	13 W	SIGNIFICANT	TREE TO BE PROTECTED/PRESERVED
C305	12	12	CEAR ELM	59-59	17 E	SIGNIFICANT	TREE TO BE PROTECTED/PRESERVED
C305	9	12	CEAR ELM	59-72	15 W	SIGNIFICANT	TREE TO BE PROTECTED/PRESERVED
C305	7	12	CEAR ELM	59-92	10 W	SIGNIFICANT	TREE TO BE PROTECTED/PRESERVED
C305	14	12					