



Steven M. Clouse Water Recycling Center Perimeter Fence
Solicitation Number: B-19-017-AT
Job No.: 19-0132

ADDENDUM 3
September 10, 2019

To Bidder of Record:

This addendum, applicable to work referenced above, is an amendment to the bid proposal, plans and specifications and as such will be a part of and included in the Contract Documents. Acknowledge receipt of this addendum by entering the Addendum number and issue date on the space provided in submitted copies of the bid proposal.

CHANGES TO THE SPECIFICATIONS

1. Delete page 143 of the solicitation and replace with the attached revised aerial view of the Steven M. Clouse Water Recycling Center included in this Addendum.

CLARIFICATIONS

1. The Changes to the Specifications listed above have been made to provide a more accurate aerial view of the Steven M. Clouse Water Recycling Center.


END OF ADDENDUM

This Addendum, including this one (1) page, is two (2) pages with attachments in its entirety.

Attachments: Aerial View Update of Steven M. Clouse Water Recycling Center



Jeffrey J. Haby
9-10-2019

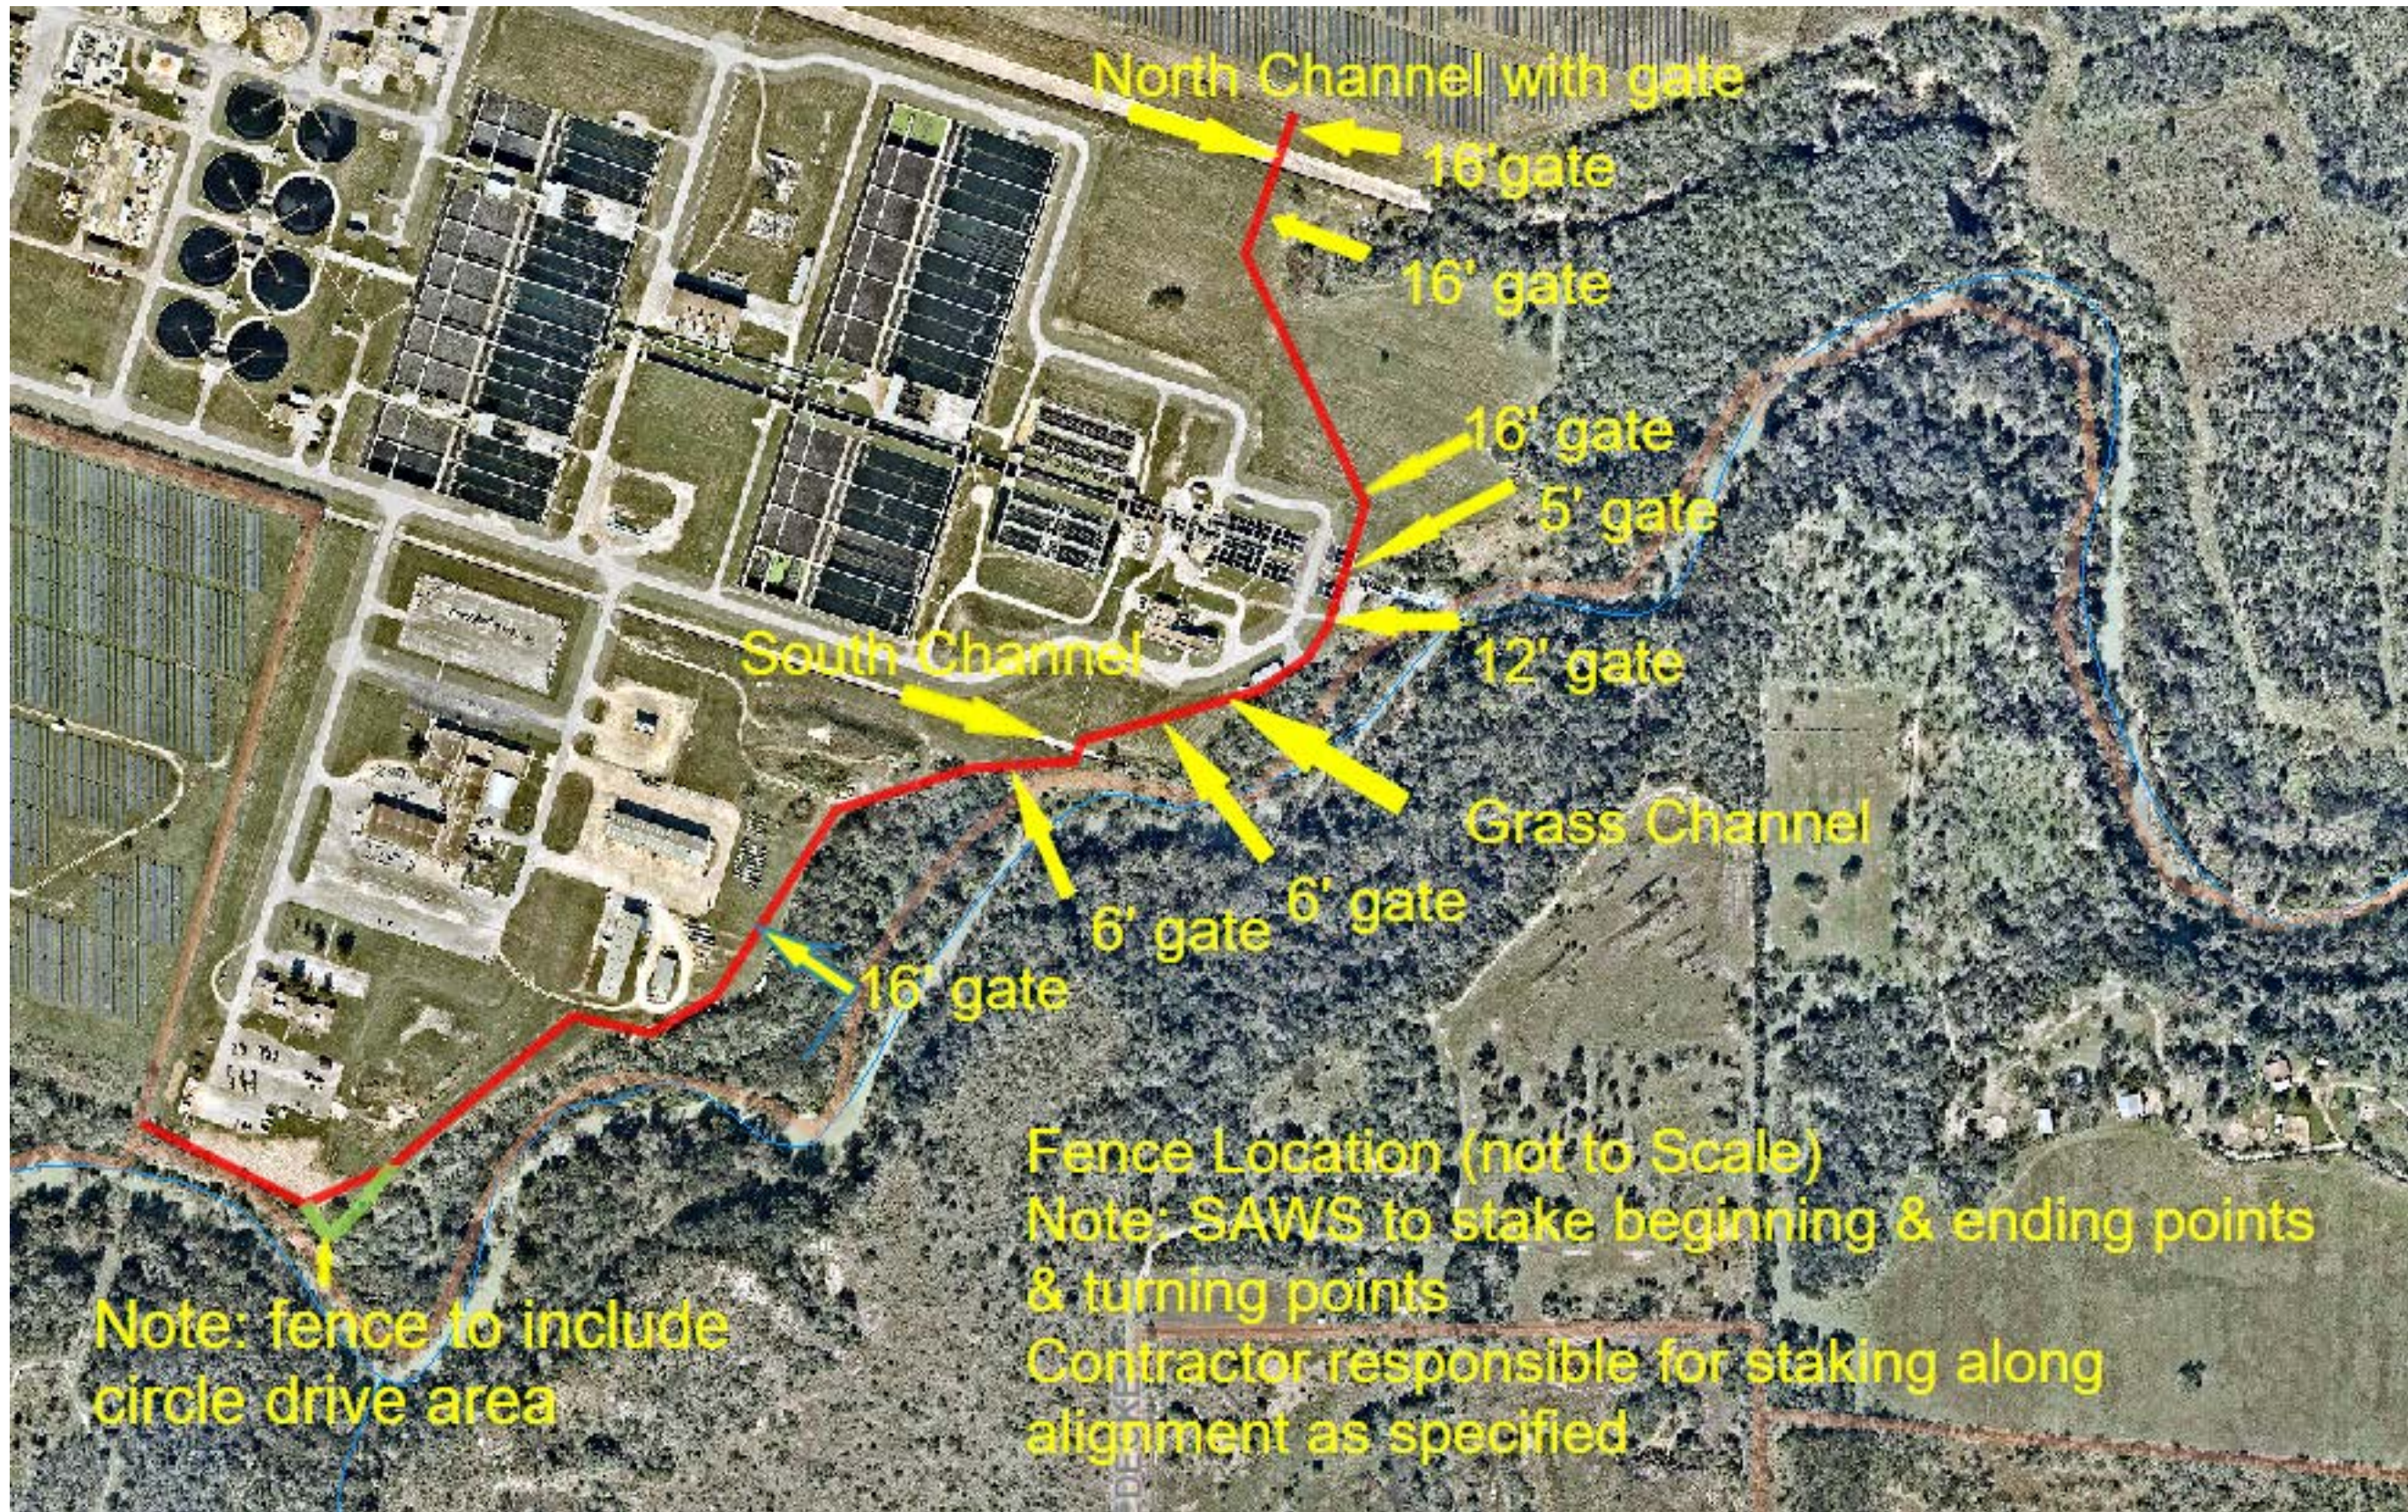

North Channel with gate

16' gate

16' gate

16' gate

5' gate

South Channel

12' gate

Grass Channel

6' gate

6' gate

16' gate

Fence Location (not to Scale)

Note: SAWS to stake beginning & ending points & turning points

Contractor responsible for staking along alignment as specified

Note: fence to include circle drive area