


SEE NOTES ON SHEET TP1 OR TP4 FOR PRUNING AND TREE PROTECTION DETAILS

1. REVISED TREE PLAN TO INCLUDE TREE PRESERVATION AND CLEARING LIMITS AS PER ADDEMDUM NO. 1

JOB NO.
10-7003

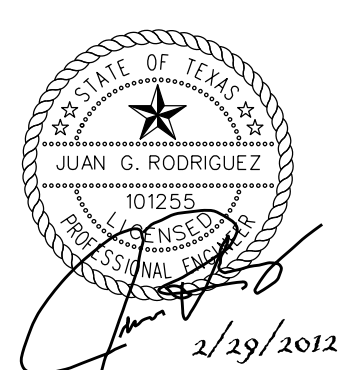

No.	Description	Drn.	Approved	Date
1	PER ADDEMDUM NO. 1	TMJ	JGR	4/20/2012

LEGEND

	PROP. 24\"/>
	PROP. TREE PROTECT LIMITS
	R.O.W.
	SURVEYED TREES
	BORE PIT
	TREE PROTECTION FENCE
	TREES TO BE TRIMMED
	TREES TO REMAIN

Date: 05/02/2011
 Drawn by: TMJ
 Designed by: TMJ
 Checked by: JR
 Scale: AS NOTED ABOVE
 Approved by: JGR



SAWS JOB NO. 10-7003
 CROSS MOUNTAIN TRAIL
 24\"/>

DRAWING NO.
TP2
25 OF 35

EXHIBIT "A"