



Steven M. Clouse WRC Electrical System Improvements Phase 2B RFCSP

Solicitation Number: CO-00547

Job No.: 21-6510

ADDENDUM 4

August 30, 2022

To Respondent of Record:

This addendum, applicable to work referenced above, is an amendment to the proposal request, plans and specifications and as such will be a part of and included in the Contract Documents. Acknowledge receipt of this addendum by entering the Addendum number and issue date on the space provided in submitted copies of the Proposal.

RESPONSES TO QUESTIONS

1. Please confirm Independent Testing Firm Report referenced in Section 16121 1.03 B 2 is pertaining to Field Test of the MV Cables referenced in Section 16121 3.03 E. As currently there is no requirement regarding the field test to be performed by Independent Testing Firm in Section 16121 3.03.

Response: Refer to Changes to the Specifications, Item 1.

2. AVCOMM Technologies, Inc. are manufacturers of Industrial grade IT Products. We would like to request to be listed as an approved equal vendor.

Response: No additional manufacturers will be named during bidding. Products submitted by Contractor for the project must fully comply with the contract documents. Materials for potential use on future projects may be submitted for consideration using the product submittal application process under Construction & Materials Specs in SAWS website at the following link.

https://apps.saws.org/business_center/specs/product_submittal/

3. May bidder's submit their bid bond on a surety provided form?

Response: Bidders may submit their bid bond on a surety provided form.

CHANGES TO THE SPECIFICATIONS

1. Section 16121 MEDIUM VOLTAGE CABLES
 - a. Page 16121-2, Paragraph 1.03.B.2: Remove this sentence in its entirety. Replace with, "Submit field test reports as specified."

CHANGES TO THE PLANS

1. Remove the following sheets in their entirety and replace with the attached sheets:
 - a. 00E14
 - b. 00E27
 - c. 00E32

- d. 00E35
- e. 20E28
- f. 20E56
- g. 20E57
- h. 20E58
- i. 20E59
- j. 20E60
- k. 20E61
- l. 20E62





END OF ADDENDUM

This Addendum, including these two (2) pages, is fourteen (14) pages with attachments in its entirety.


Attachments:

Drawings: 12 pages, 11x17 (HALF-SIZE)

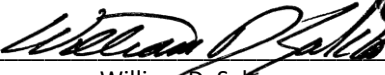
William D. Sako
Gupta & Associates, Inc.
TBPE # F-2593


8/30/2021


8/18/2022 5:42 PM Z:\1951_SAWS_Dos Rios WRC Electrical System Improvements - Phase II\5 Drawings\Dos Rios Phase II\Electrical\Working\Phase B\1951_00E14.dwg Emmanuel Rangel

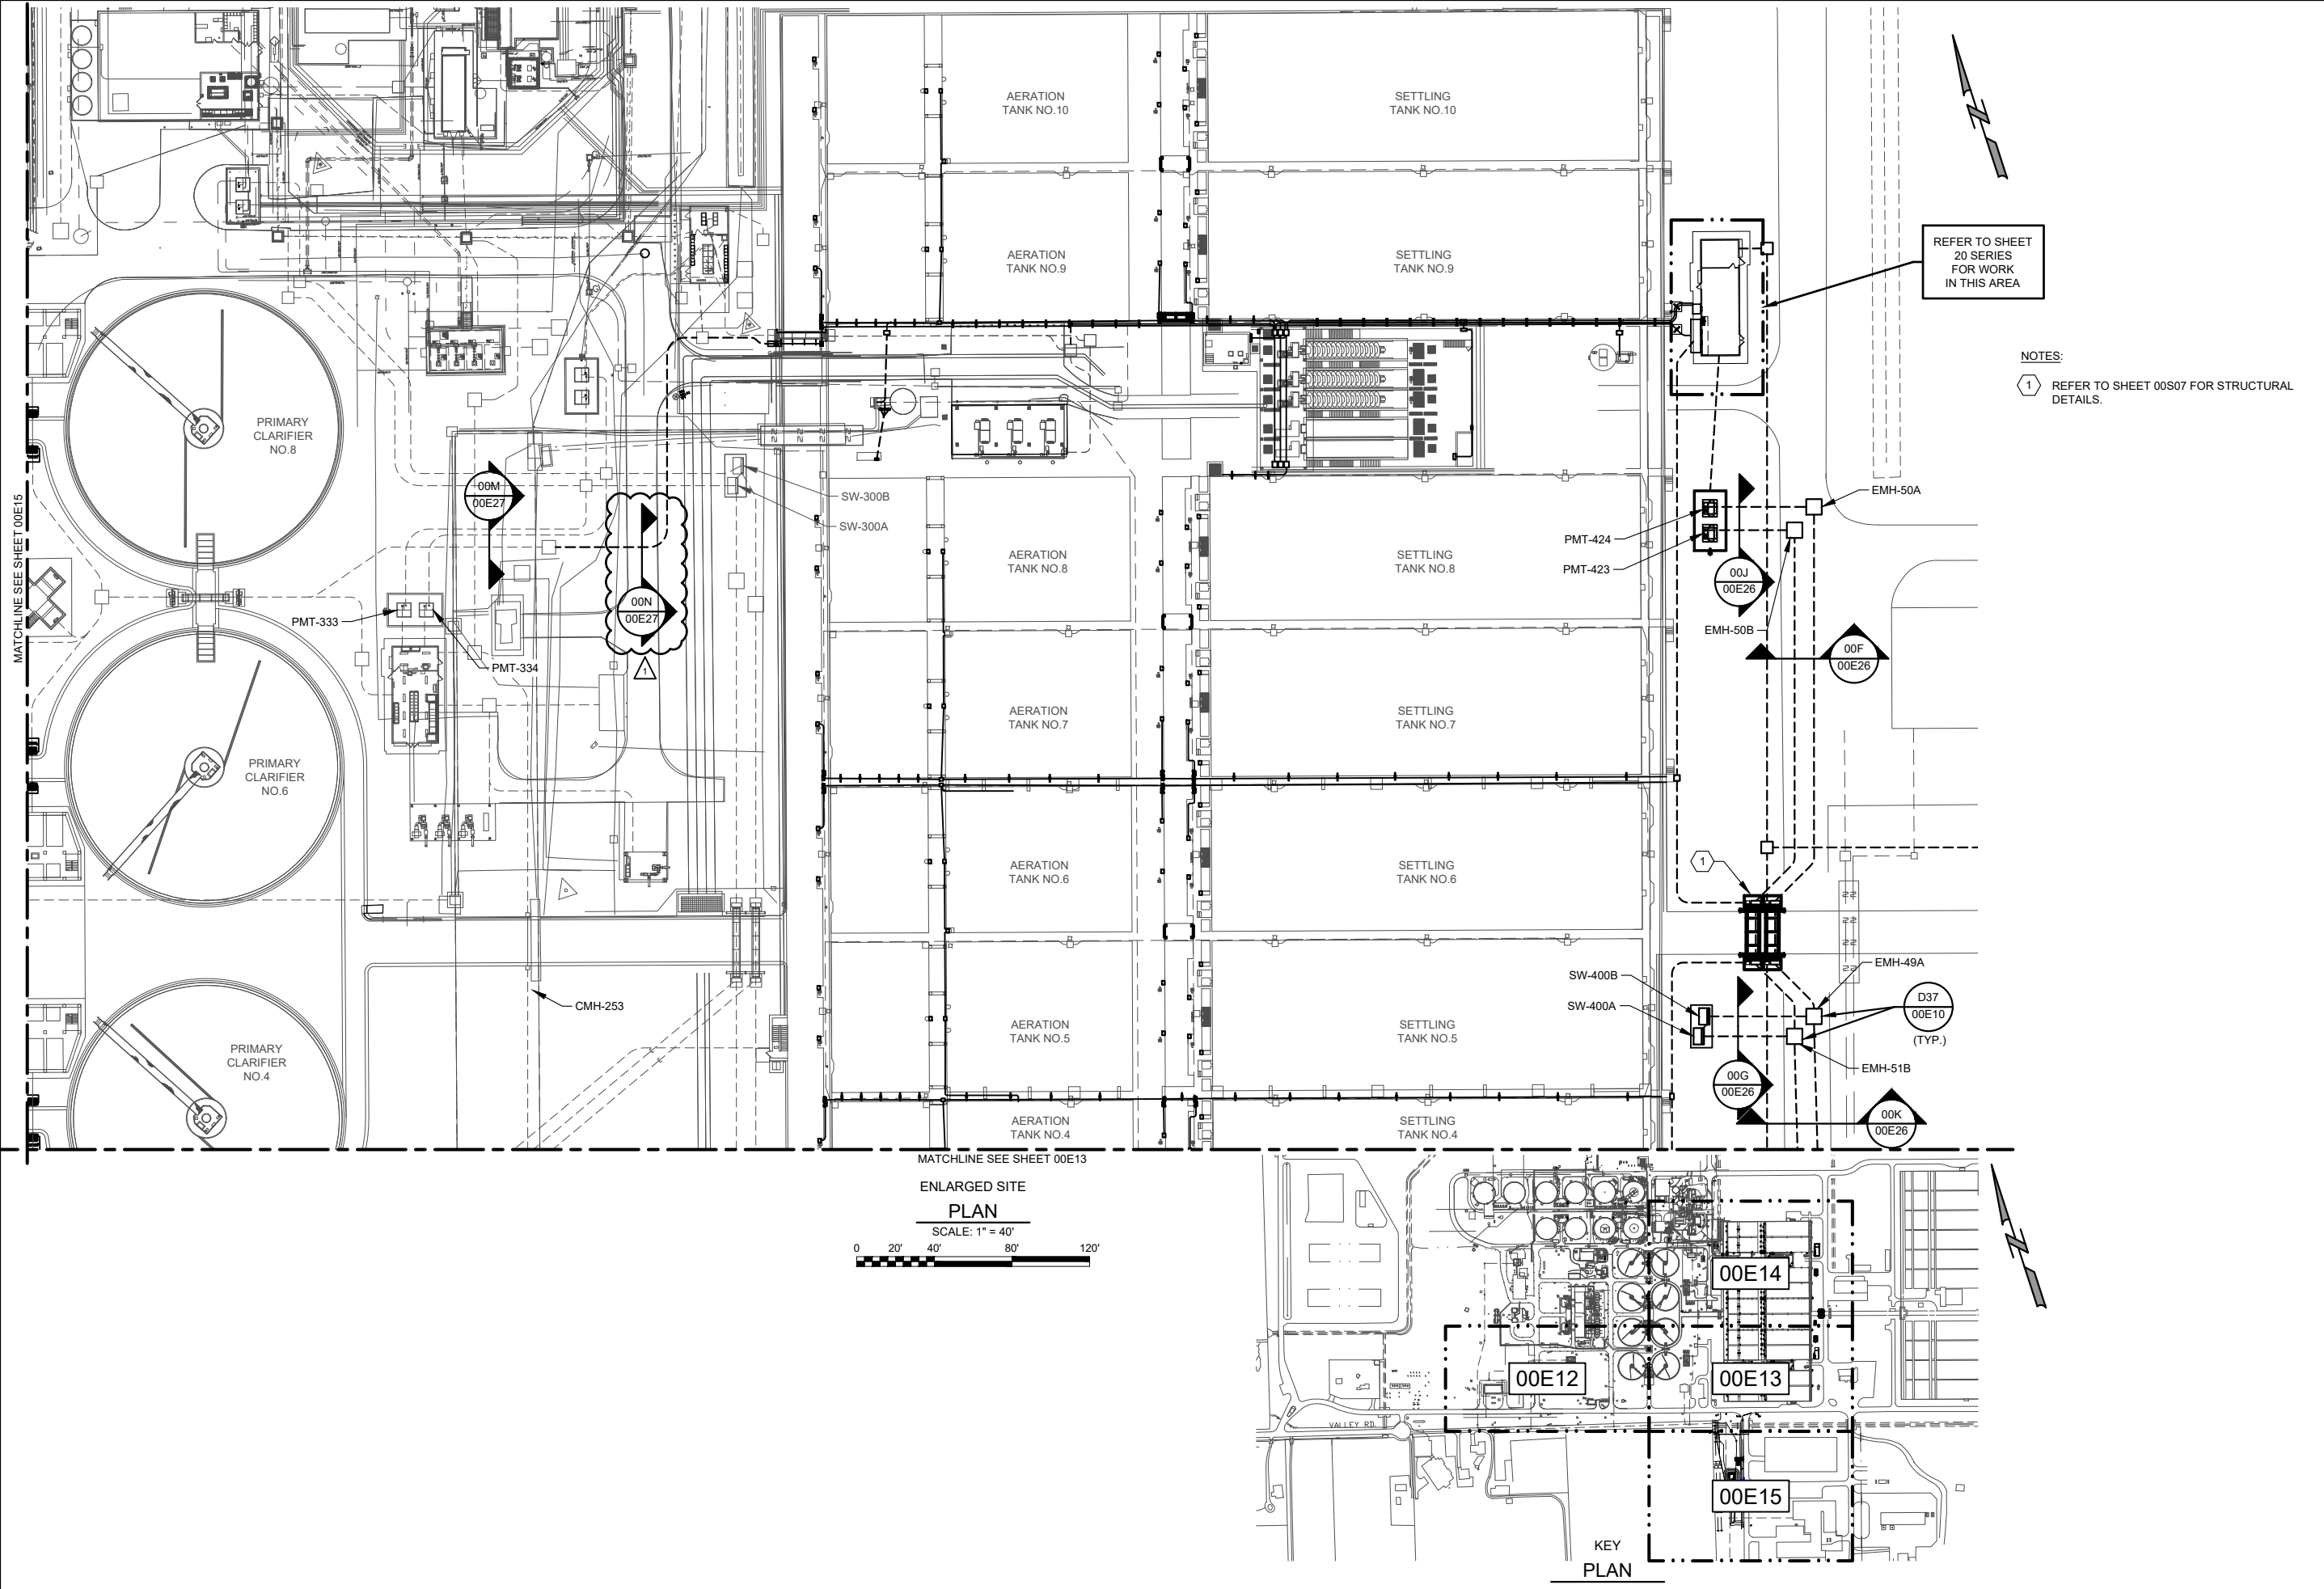

REFER TO SHEET
20 SERIES
FOR WORK
IN THIS AREA

NOTES:
1 REFER TO SHEET 00S07 FOR STRUCTURAL
DETAILS.

GAI
Gupta & Associates, Inc.
CONSULTING ENGINEERING
Registration No. F-2593
1377 N. Metro Road
Dallas, Texas 75244
Tel: 972-485-1725
email: gai@gaiairng.com

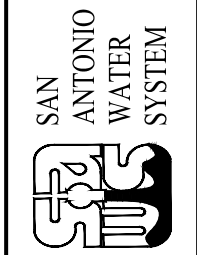

REV. NO.	DATE	DRWN	ER	ADDDIVIDM NO.4	REMARKS
1	08/30/22				

ONE INCH AT FULL SIZE IF NOT
ONE INCH SCALE ACCORDINGLY


SAN ANTONIO WATER SYSTEM
STEVEN M. CLOUSE WRC
ELECTRICAL SYSTEM IMPROVEMENTS PHASE 2B
ELECTRICAL

15KV DISTRIBUTION SITE PLAN - III

DESIGNED BY: W.SAKO
DRAWN BY: E.RANGEL
SHEET CHKD BY: V.K. GUPTA
APPROVED BY: W.SAKO
DATE: JULY 2022
SAWS JOB NO.: 21-6510
FILE NAME: 1951_00E14


SHEET NO.
00E14
36 OF 227

8/18/2022 5:42 PM Z:\1951_SAWS_Dos Rios WRC Electrical System Improvements - Phase II\5 Drawings\Dos Rios Phase II\Electrical\Working\Phase B\1951_00E27.dwg Emmanuel Rangel

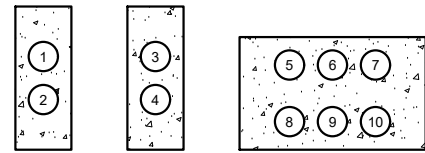



DUCTBANK
SECTION 00M
00E14

TABLE FOR SECTION 00M			
CONDUIT NO.	CONDUIT TAG	CONDUIT SIZE	DESCRIPTION
1	SW300-2P	4" C	TO PMT-330
2	SPARE	4" C	-
3	SW300B-2P	4" C	TO PMT-333
4	SPARE	4" C	-
2	B1-EM1-C1, B1-EM1-C2	2" C	EMERGENCY GENERATOR TO ATS-B1-A
6	SPARE	2" C	-
7	SPARE	2" C	J-BOXES TO LMH-10
2	B1-EM1-P	4" C	EMERGENCY GENERATOR TO ATS-B1-A VIA FTB-B1-A
2	B1-EM1-P	4" C	EMERGENCY GENERATOR TO ATS-B1-A VIA FTB-B1-A
2	B1-EM1-P	4" C	EMERGENCY GENERATOR TO ATS-B1-A VIA FTB-B1-A

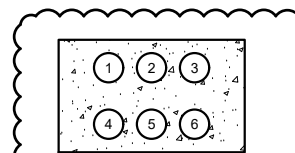

DUCTBANK
SECTION 00N
00E14

TABLE FOR SECTION 00N			
CONDUIT NO.	CONDUIT TAG	CONDUIT SIZE	DESCRIPTION
1	B1-EM1-C1, B1-EM1-C2	2" C	EMERGENCY GENERATOR TO ATS-B1-A
2	SPARE	2" C	-
3	SPARE	2" C	J-BOXES TO LMH-10
4	B1-EM1-P	4" C	EMERGENCY GENERATOR TO ATS-B1-A VIA FTB-B1-A
5	B1-EM1-P	4" C	EMERGENCY GENERATOR TO ATS-B1-A VIA FTB-B1-A
6	B1-EM1-P	4" C	EMERGENCY GENERATOR TO ATS-B1-A VIA FTB-B1-A

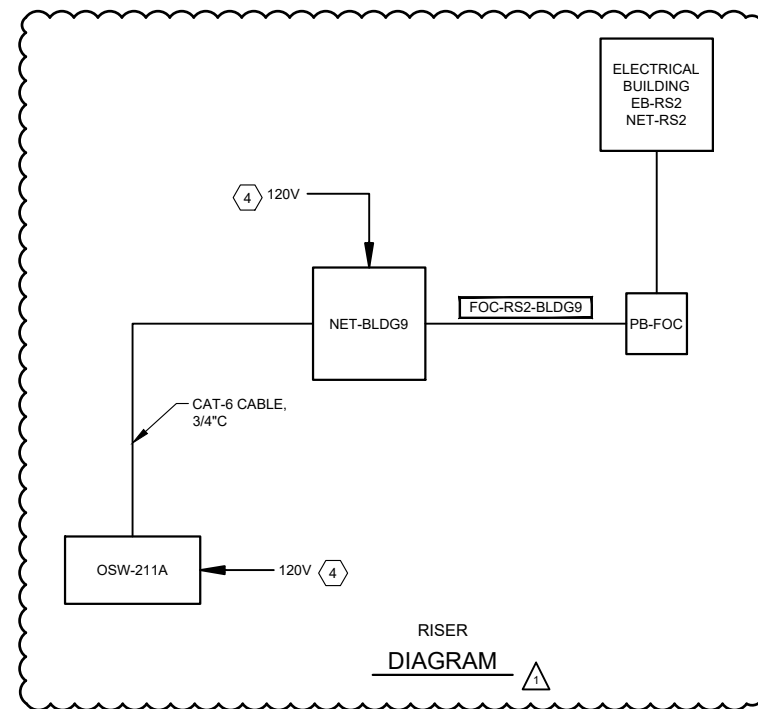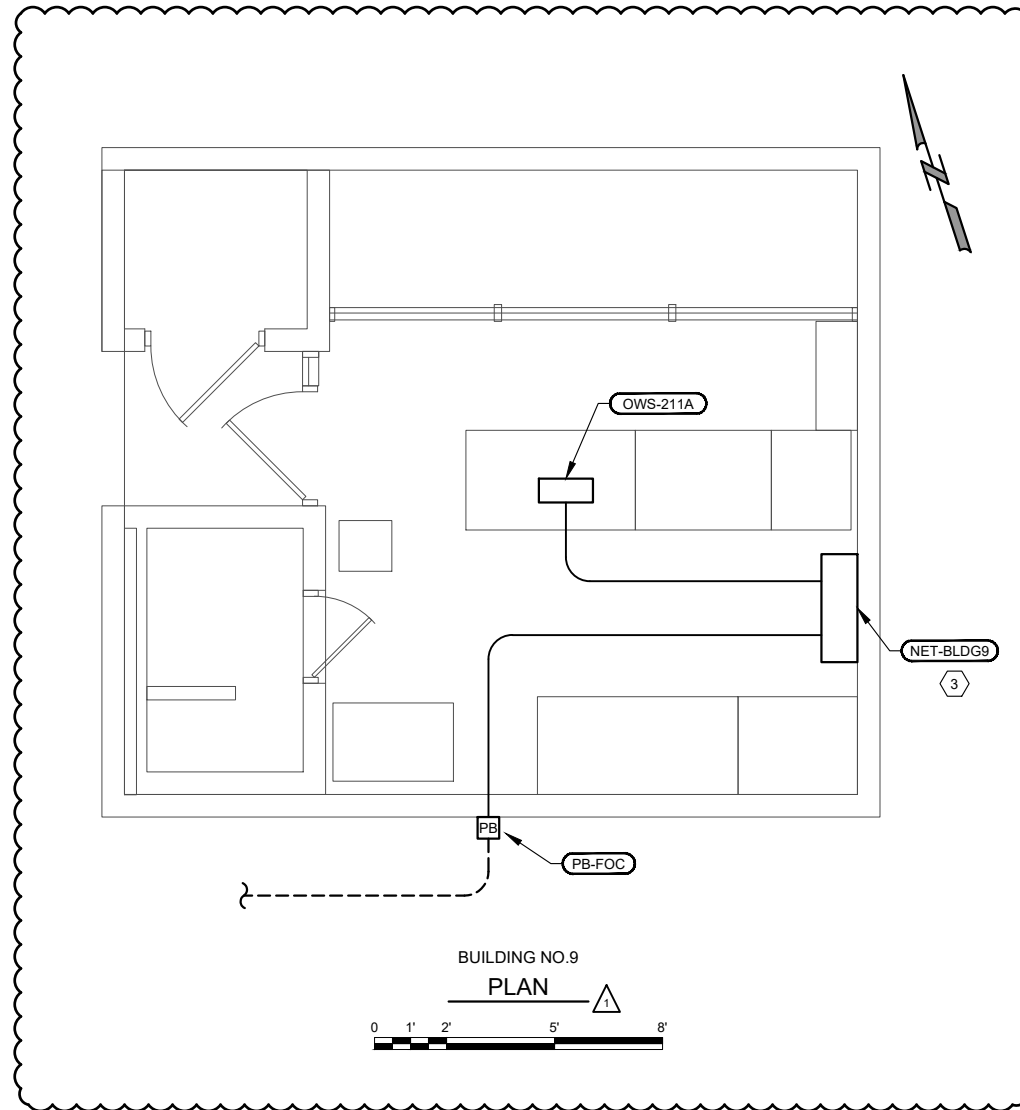

NOTES:

- 1 EXISTING DUCTBANK WITH EXISTING WIRES EXCEPT AS NOTED.
- 2 NEW WIRE IN EXISTING DUCTBANK.
- 3 LOCATION OF THE NETWORK ENCLOSURE SHALL BE ADJUSTED IN THE FIELD BASED ON SPACE AVAILABILITY.
- 4 PROVIDE 1202V POWER FROM EXISTING UPS SOURCE. PROVIDE 3#12, 3/4" C FIELD ROUTE WIRE AND CONDUIT.

GAI
Gupta & Associates, Inc.
CONSULTING ENGINEERING
Registration No. F-2593
13771 N. Metro Road
Dallas, Texas 75244
Tel: 972-485-1725
Fax: 972-485-1725
email: gai@gaiafirm.com



SAN ANTONIO WATER SYSTEM

REV. NO.	DATE	DRWN	ER	ADDENDUM NO.4	REMARKS
1	08/30/22				


ONE INCH AT FULL SIZE IF NOT ONE INCH SCALE ACCORDINGLY

SAN ANTONIO WATER SYSTEM
STEVEN M. CLOUSE WRC
ELECTRICAL SYSTEM IMPROVEMENTS PHASE 2B
ELECTRICAL
DUCTBANK SECTIONS - III

DESIGNED BY:	W.SAKO
DRAWN BY:	E.RANGEL
SHEET CHKD BY:	G.LUKE
APPROVED BY:	W.SAKO
DATE:	JULY 2022
SAWS JOB NO.:	21-6510
FILE NAME:	1951_00E27

SHEET NO.
00E27
49 OF 227

8/18/2022 5:42 PM Z:\1951_SAWS_Dos Rios WRC Electrical System Improvements - Phase II\5 Drawings\Dos Rios Phase II\Electrical\Working\Phase B\1951_00E32.dwg Emmanuel Rangel

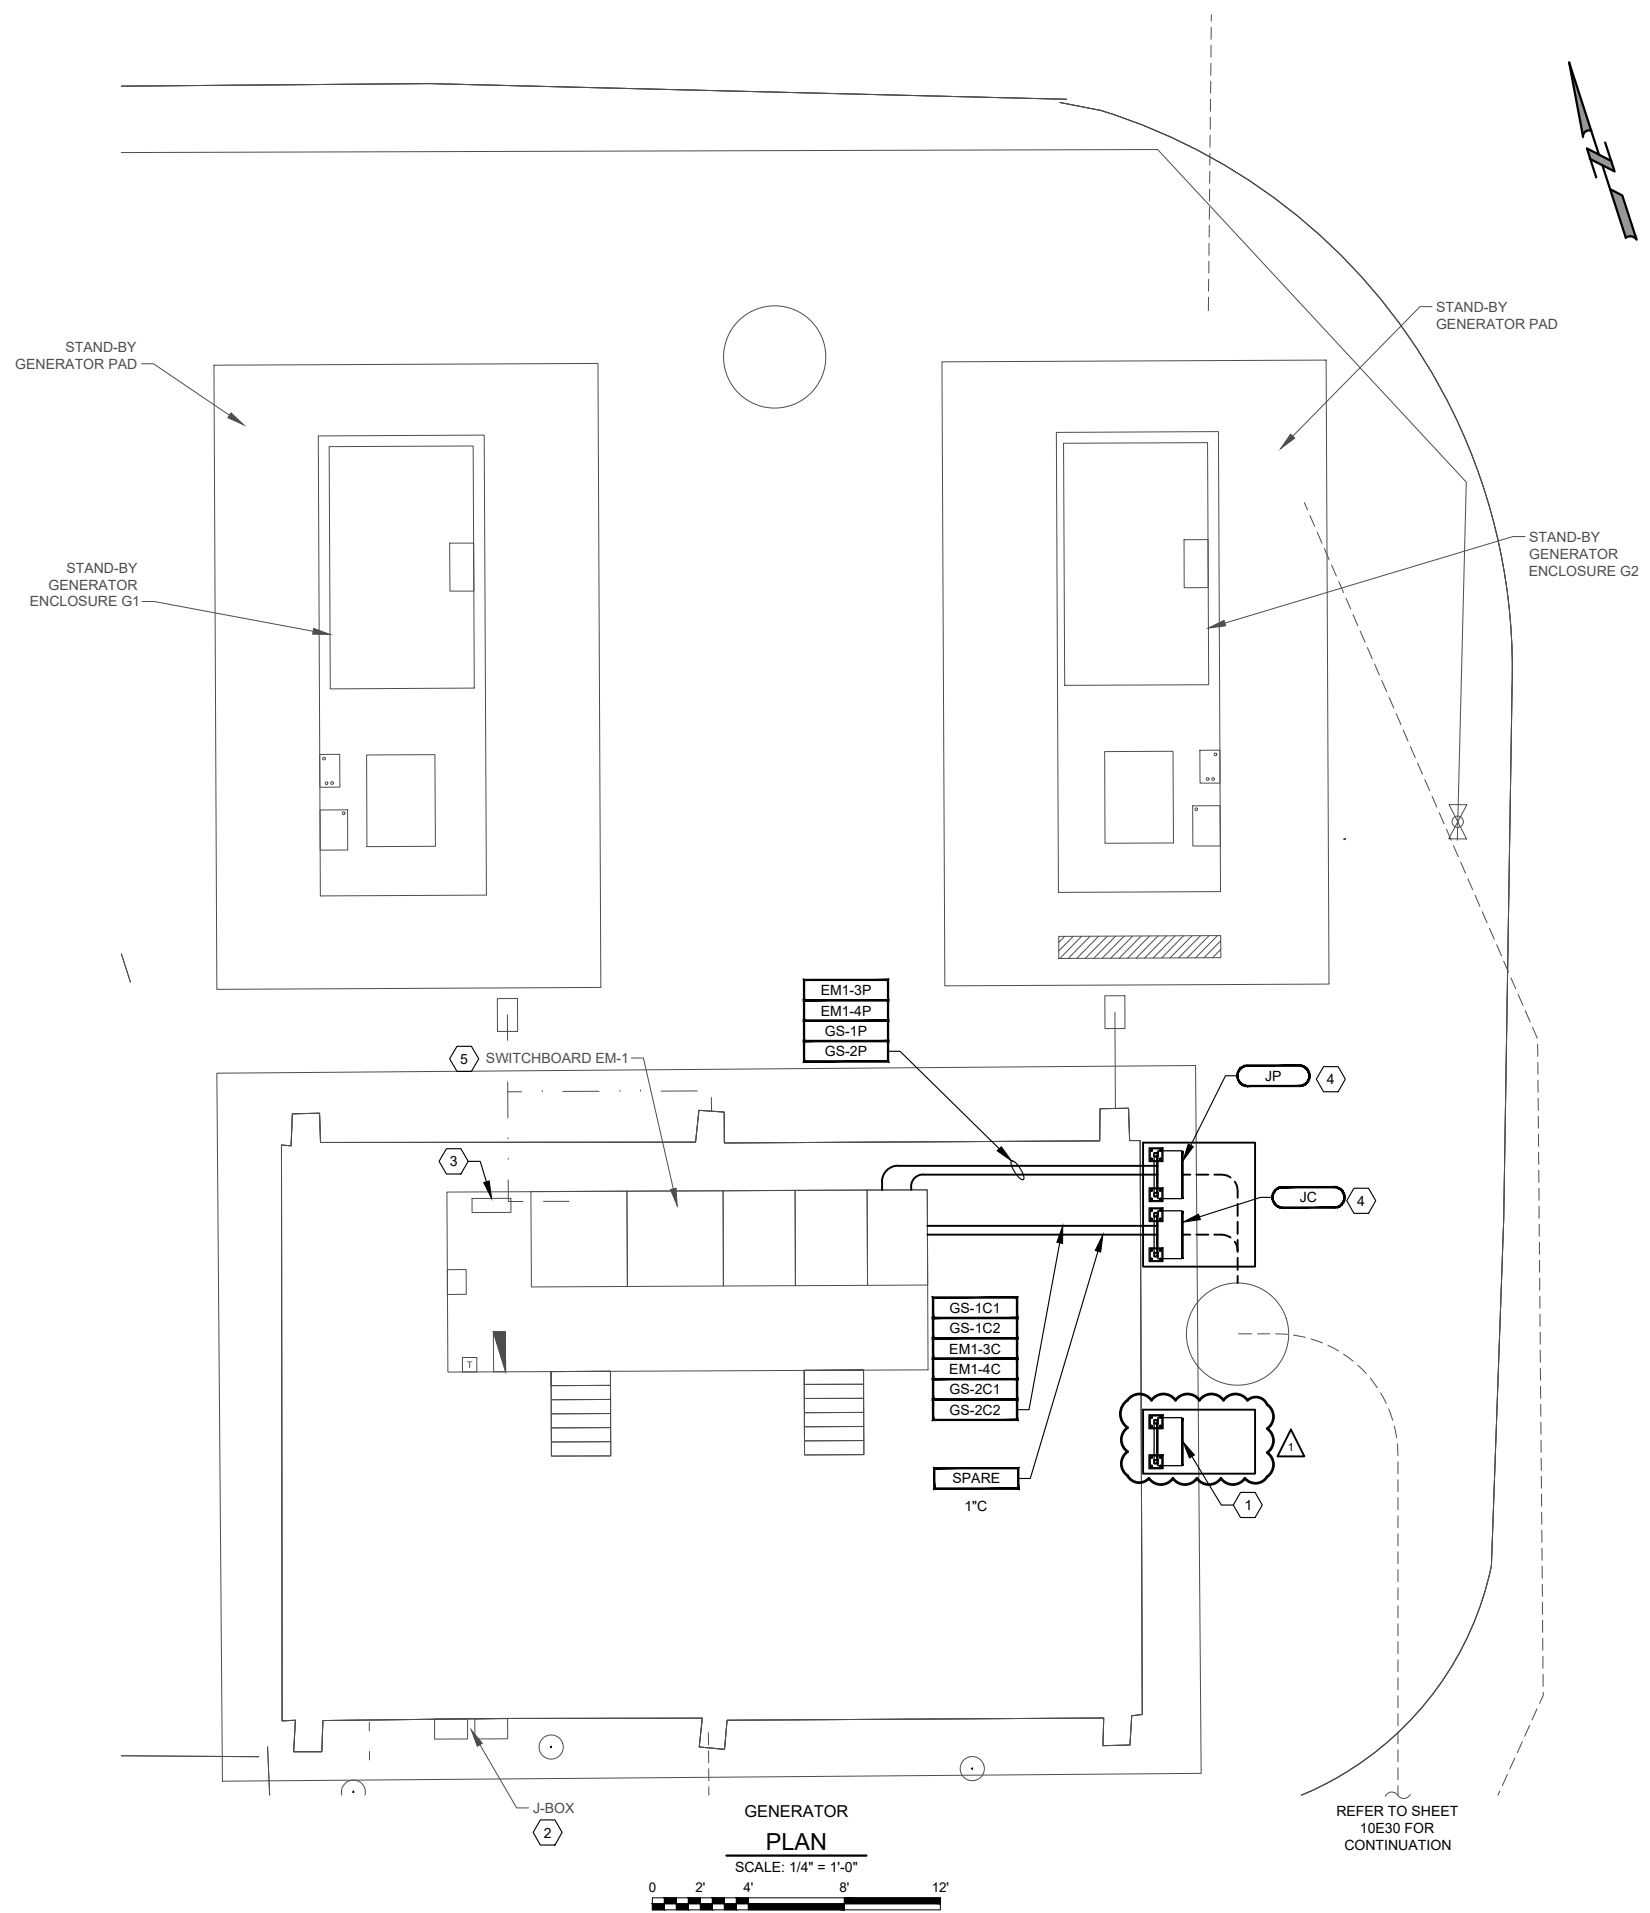

GENERAL NOTES:

1. FIELD VERIFY THE EXACT LAYOUT.
2. FIELD ROUTE CONDUITS.
3. THE CONTRACTOR SHALL OBTAIN SERVICES OF MANUFACTURING TO MAKE ANY MODIFICATION TO THE 480V SWITCHGEAR AND CONTROLS.
4. THE GENERATOR SYSTEM SHALL BE TESTED ONCE THE INSTALLATION IS COMPLETED.
5. PROVIDE NECESSARY HARDWARE AND TERMINALS IN THE SWITCHBOARD TO TERMINATE NEW CABLES.

NOTES:

- 1 POWER J-BOX FOR AERATION BASIN.
- 2 EXISTING J-BOXES.
- 3 EXISTING GENERATOR CONTROL PANEL.
- 4 PROVIDE NEMA 4X, 316 SS POWER AND CONTROL BOXES TO ACCOMMODATE THE CONDUIT AND WIRES FOR DUCTBANK 10AM (REFER TO SHEET 10E30 AND 10E33). SIZE THE BOXES PER THE REQUIREMENTS OF THE NEC. PLACE THEM ON STANDS FOR CONDUIT ENTRY FROM BELOW AND ABOVE AS REQUIRED.
- 5 REFER TO SHEET 00E24 FOR ONE-LINE DIAGRAM.

GAI
Gupta & Associates, Inc.
CONSULTING ENGINEERING
Registration No. F-2593
13771 N. Metro Road
Dallas, Texas 75244
Tel: 972-485-1725
Email: gai@gaiconsulting.com



SAN ANTONIO WATER SYSTEM

REV. NO.	DATE	DRWN	ER	ADDENDUM NO.4	REMARKS
A	08/30/22				

ONE INCH AT FULL SIZE IF NOT ONE INCH SCALE ACCORDINGLY


SAN ANTONIO WATER SYSTEM
STEVEN M. CLOUSE WRC
ELECTRICAL SYSTEM IMPROVEMENTS PHASE 2B
ELECTRICAL

SWITCHBOARD NO.1 PLAN

DESIGNED BY: W.SAKO
DRAWN BY: E.RANGEL
SHEET CHKD BY: V.K. GUPTA
APPROVED BY: W.SAKO
DATE: JULY 2022
SAWS JOB NO.: 21-6510
FILE NAME: 1951_00E32

SHEET NO.
00E32
53 OF 227


8/18/2022 5:42 PM Z:\1951_SAWS_Dos Rios WRC Electrical System Improvements - Phase II\5 Drawings\Dos Rios Phase II\Electrical\Working\Phase B\1951_00E35.dwg Emmanuel Rangel

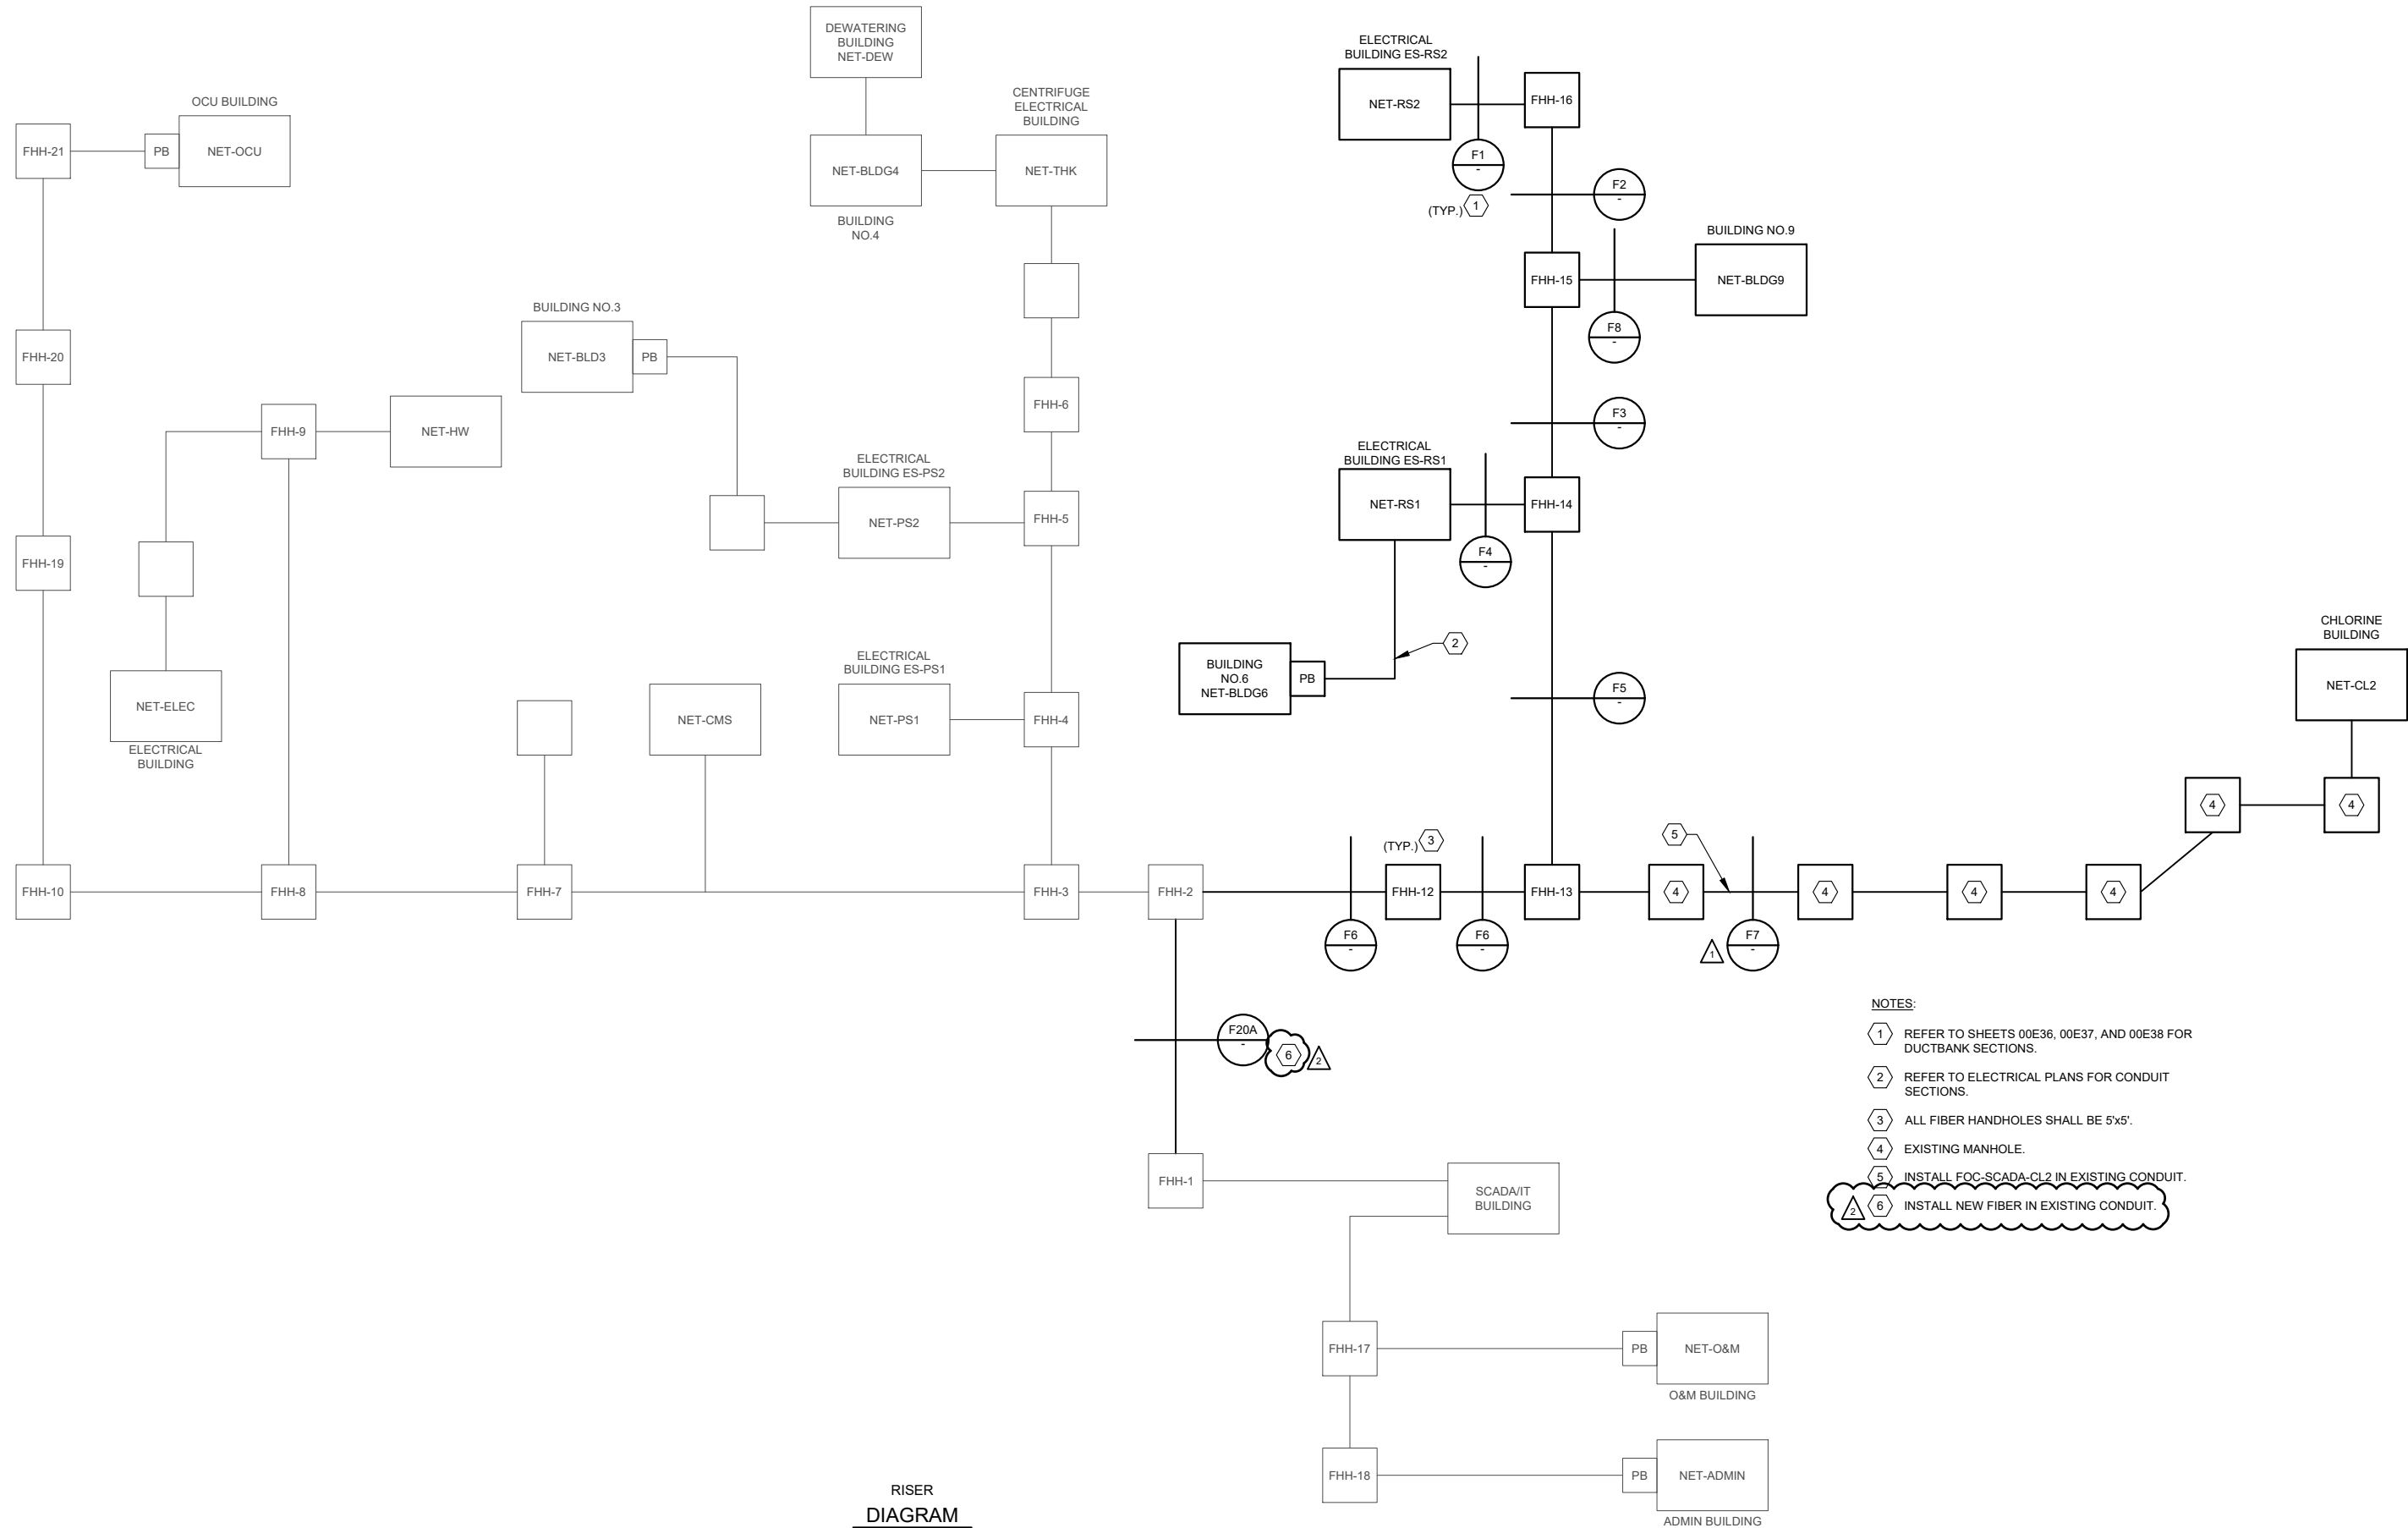

**RISER
DIAGRAM**

- NOTES:**
- 1 REFER TO SHEETS 00E36, 00E37, AND 00E38 FOR DUCTBANK SECTIONS.
 - 2 REFER TO ELECTRICAL PLANS FOR CONDUIT SECTIONS.
 - 3 ALL FIBER HANDHOLES SHALL BE 5'x5'.
 - 4 EXISTING MANHOLE.
 - 5 INSTALL FOC-SCADA-CL2 IN EXISTING CONDUIT.
 - 6 INSTALL NEW FIBER IN EXISTING CONDUIT.

GAI
Gupta & Associates, Inc.
CONSULTING ENGINEERING
Registration No. F-2593
Dallas, Texas 75244
13771 N. Metro Road
Fax: (972) 485-1725
email: gai@gaiairng.com

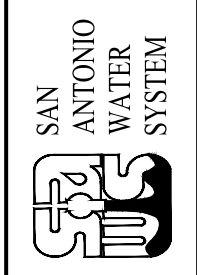

08/30/22	ER	ADDENDUM NO.4	REMARKS
08/08/22	ER	ADDENDUM NO.2	
	DRWN		
	DATE		
	REV. NO.		

ONE INCH AT FULL SIZE IF NOT
ONE INCH SCALE ACCORDINGLY


SAN ANTONIO WATER SYSTEM
STEVEN M. CLOUSE WRC
ELECTRICAL SYSTEM IMPROVEMENTS PHASE 2B
ELECTRICAL

**FIBER OPTIC
OVERALL RISER DIAGRAM**

DESIGNED BY: V.K. GUPTA
DRAWN BY: E. RANGEL
SHEET CHKD BY: V.K. GUPTA
APPROVED BY: W. SAKO
DATE: JULY 2022
SAWS JOB NO.: 21-6510
FILE NAME: 1951_00E35

SHEET NO.
00E35
55 OF 227

8/23/2022 12:07 PM Z:\1951_SAWS Dos Rios WRC Electrical System Improvements - Phase II\5 Drawings\Dos Rios Phase II\Electrical\Working\Phase B\1951_20E28.dwg, Jenny Meam

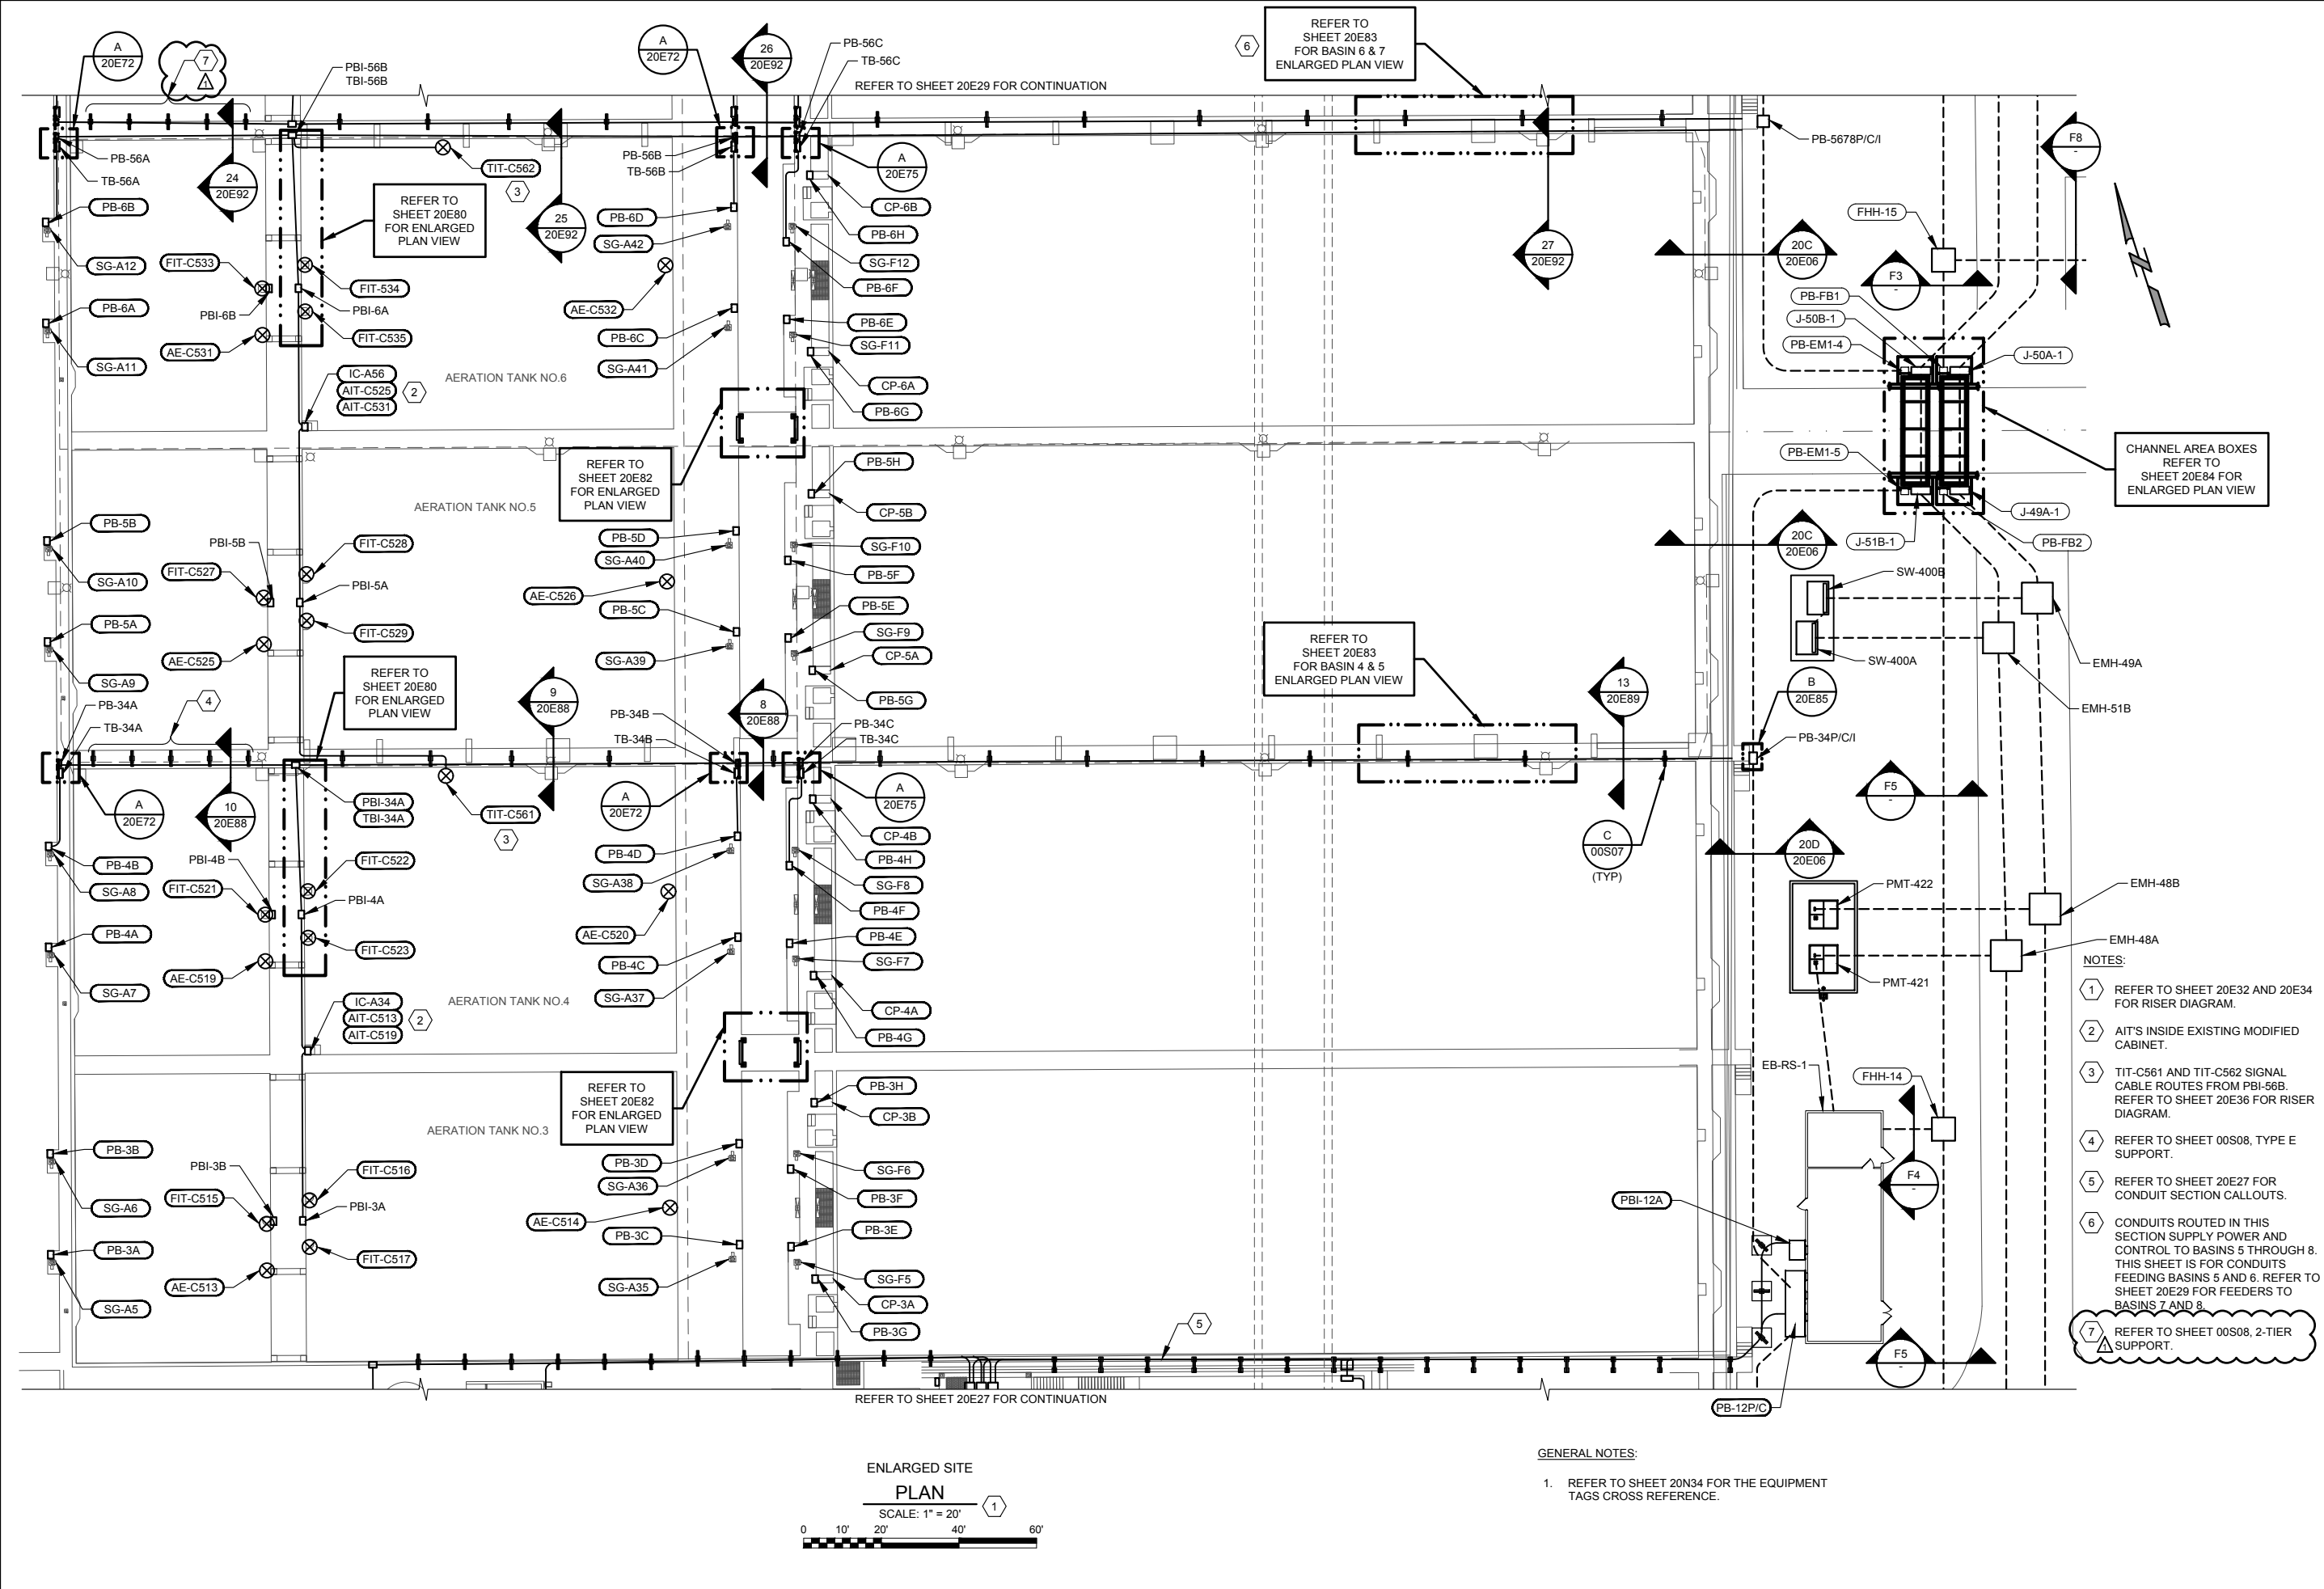

ENLARGED SITE
PLAN
SCALE: 1" = 20'
0 10' 20' 40' 60'

- GENERAL NOTES:**
- REFER TO SHEET 20N34 FOR THE EQUIPMENT TAGS CROSS REFERENCE.

- NOTES:**
- REFER TO SHEET 20E32 AND 20E34 FOR RISER DIAGRAM.
 - AIT'S INSIDE EXISTING MODIFIED CABINET.
 - TIT-C561 AND TIT-C562 SIGNAL CABLE ROUTES FROM PBI-56B. REFER TO SHEET 20E36 FOR RISER DIAGRAM.
 - REFER TO SHEET 00S08, TYPE E SUPPORT.
 - REFER TO SHEET 20E27 FOR CONDUIT SECTION CALLOUTS.
 - CONDUITS ROUTED IN THIS SECTION SUPPLY POWER AND CONTROL TO BASINS 5 THROUGH 8. THIS SHEET IS FOR CONDUITS FEEDING BASINS 5 AND 6. REFER TO SHEET 20E29 FOR FEEDERS TO BASINS 7 AND 8.
 - REFER TO SHEET 00S08, 2-TIER SUPPORT.

GAI
Gupta & Associates, Inc.
CONSULTING ENGINEERING
REGISTRATION NO. F-2593
Dallas, Texas 75244
13771 N. Metro Road
Fax: 972-485-1725
email: gai@gaiaut.com

SAN ANTONIO WATER SYSTEM

REV. NO.	DATE	DRWN	ER	ADDENDUM NO.4	REMARKS
A	08/30/22				

SAN ANTONIO WATER SYSTEM
STEVEN M. CLOUSE WRC
ELECTRICAL SYSTEM IMPROVEMENTS PHASE 2B

**FIRST STAGE AERATION TANKS
NO. 3 THROUGH NO. 6
ENLARGED SITE PLAN**

DESIGNED BY:	E. CLEMENT
DRAWN BY:	E. RANGEL
SHEET CHKD BY:	V.K. GUPTA
APPROVED BY:	W. SAKO
DATE:	JULY 2022
SAWS JOB NO.:	21-6510
FILE NAME:	1951_20E28

SHEET NO.
20E28
122 OF 227

100% SUBMITTAL - ISSUED FOR BID

8/23/2022 12:07 PM Z:\1951_SAWS Dos Rios WRC Electrical System Improvements - Phase II\5 Drawings\Dos Rios Phase II\Electrical\Working\Phase B\1951_20E56.dwg Jenny Meam

INTERFACE DIAGRAM			
EQUIPMENT TAG	DESCRIPTION	FIELD WIRING	PLC/RIO
AERATION TANKS NO.1 & NO.2			
SG-A1	SLUICE GATE (INFLUENT)	SG C6 RIRS11-101 (6#14 - SPARE)	PLC-RS1
SG-A2	SLUICE GATE (INFLUENT)	SG C6 RIRS11-102 (6#14 - SPARE)	
SG-A3	SLUICE GATE (INFLUENT)	SG C6 RIRS11-103 (6#14 - SPARE)	
SG-A4	SLUICE GATE (INFLUENT)	SG C6 RIRS11-104 (6#14 - SPARE)	
SG-A31	SLUICE GATE (EFFLUENT)	SG C6 RIRS11-105 (6#14 - SPARE)	
SG-A32	SLUICE GATE (EFFLUENT)	SG C6 RIRS11-106 (6#14 - SPARE)	
SG-A33	SLUICE GATE (EFFLUENT)	SG C6 RIRS11-107 (6#14 - SPARE)	
SG-A34	SLUICE GATE (EFFLUENT)	SG C6 RIRS11-108 (6#14 - SPARE)	
AE-C501	DISSOLVE OXYGEN (DO) SENSOR	AE ① IC-A12 AIT-C501	
AE-C502	DISSOLVE OXYGEN (DO) SENSOR	AE ① A6 RIRS11-109 2-1PR#16TSP- SPARE	
AE-C507	DISSOLVE OXYGEN (DO) SENSOR	AE ① AIT-C507	
AE-C504	DISSOLVE OXYGEN (DO) SENSOR	AE ①	
FIT-C503	FLOW TRANSMITTER	FIT A1 RIRS11-110	
FIT-C504	FLOW TRANSMITTER	FIT A1 RIRS11-111	
FIT-C505	FLOW TRANSMITTER	FIT A1 RIRS11-112	
FIT-C509	FLOW TRANSMITTER	FIT A1 RIRS11-113	
FIT-C510	FLOW TRANSMITTER	FIT A1 RIRS11-114	
FIT-C511	FLOW TRANSMITTER	FIT A1 RIRS11-115	
FIRST STAGE SETTLING TANKS NO.1 & NO.2			
SG-F1	SLUICE GATE	SG C6 RIRS11-116 (6#14 - SPARE)	
SG-F2	SLUICE GATE	SG C6 RIRS11-117 (6#14 - SPARE)	
SG-F3	SLUICE GATE	SG C6 RIRS11-118 (6#14 - SPARE)	
SG-F4	SLUICE GATE	SG C6 RIRS11-119 (6#14 - SPARE)	
E003	SLUDGE COLLECTOR PANEL NO.1A	CP C4 RIRS11-120 (2#14 - SPARE)	
E004	SLUDGE COLLECTOR PANEL NO.1B	CP C4 RIRS11-121 (2#14 - SPARE)	
E005	SLUDGE COLLECTOR PANEL NO.2A	CP C4 RIRS11-122 (2#14 - SPARE)	
E006	SLUDGE COLLECTOR PANEL NO.2B	CP C5 RIRS11-123 (2#14 - SPARE)	

INTERFACE DIAGRAM			
EQUIPMENT TAG	DESCRIPTION	FIELD WIRING	PLC/RIO
AERATION TANKS NO.1 AND NO.2 PIPE GALLERY			
FIT-E001	FLOW TRANSMITTER	FIT ② RIRS11-124 ENCLOSURE SKF1 A1 RIRS11-124	PLC-RS1
V-E001	VALVE CONTROL PANEL	CP ② RIRS11-125 A1 RIRS11-125	
FIT-E002	FLOW TRANSMITTER	FIT ② RIRS11-126 A1 RIRS11-126	
V-E002	VALVE CONTROL PANEL	CP ② RIRS11-127 A1 RIRS11-127	
ELECTRICAL BUILDING EB-RS-1			
ZS-RS1-2	CONTROL ROOM INTRUSION SWITCH	ZS C1 RIRS11-128	PLC-RS1
NETRAK-RS1	NETWORK ENCLOSURE	CP C1 RIRS11-129	
TIT-RS1-2	CONTROL ROOM TEMPERATURE TRANSMITTER	TIT A1 RIRS11-130	

GENERAL NOTES:

- ALL THE CONDUIT AND WIRE RUNS ARE SHOWN INDIVIDUALLY FOR CLARITY. CONTRACTOR TO ROUTE WIRES AND CONDUITS AS PER RISER DIAGRAM.
- THE CONDUIT SIZE AS SHOWN ARE MINIMUM.
- ALL WIRES SHALL BE TERMINATED ON TERMINAL BLOCK. THERE SHALL BE NO LOOSE WIRES.
- THE SIZES AS SHOWN ARE MINIMUM. THE CONTRACTOR SHALL BE RESPONSIBLE TO FURNISH THE CABINET AND TERMINATE ALL WIRES PLUS 25% SPARE TERMINAL BLOCKS.
- ALL CAT-6 CABLE TO BE ROUTED IN CONDUIT ONLY.
- REFER TO SHEET 20N34 FOR THE EQUIPMENT TAGS CROSS REFERENCE.

NOTES:

- EXISTING EQUIPMENT, CABLES AND CONDUITS.
- EXISTING EQUIPMENT. PROVIDE NEW CABLES IN EXISTING CONDUITS.

CONTROL & INSTRUMENTATION WIRE/CONDUIT SCHEDULE

C1	2#14, #14G, 3/4"C	A1	1-1P#16 TSP, #14G, 3/4"C
C2	4#14, #14G, 3/4"C	A2	2-1P#16 TSP, #14G, 3/4"C
C3	6#14, #14G, 1"C	A3	3-1P#16 TSP, #14G, 3/4"C
C4	8#14, #14G, 1"C	A4	4-1P#16 TSP, #14G, 1"C
C5	10#14, #14G, 1"C	A5	5-1P#16 TSP, #14G, 1"C
C6	12#14, #14G, 1-1/4"C	A6	6-1P#16 TSP, #14G, 1-1/2"C
C7	14#14, #14G, 1-1/4"C	A7	7-1P#16 TSP, #14G, 2"C
C8	16#14, #14G, 1-1/4"C	A8	8-1P#16 TSP, #14G, 2"C
C9	18#14, #14G, 1-1/4"C	A9	9-1P#16 TSP, #14G, 2"C
C10	20#14, #14G, 1-1/4"C	A10	10-1P#16 TSP, #14G, 2"C
C11	22#14, #14G, 1-1/4"C	A11	11-1P#16 TSP, #14G, 2"C
C12	24#14, #14G, 1-1/4"C	M1	1-CAT-5e, #14G, 1"C
C14	28#14, #14G, 1-1/4"C	M2	2-CAT-5e, #14G, 1-1/2"C
C30	60#14, #14G, 3-1/2"C	M3	3-CAT-5e, #14G, 2"C
C37	74#14, #14G, 4"C	M4	4-CAT-5e, #14G, 2"C

CONTROL & INSTRUMENTATION WIRE/CONDUIT TABLE NOTES:

1) NOT ALL POSSIBLE COMBINATIONS ARE LISTED. INCLUDE A SEPARATE GROUND WIRE IN EACH CONDUIT RUN.

REPRESENTS PAIR OF WIRE
EXAMPLE C10 = 20#14 WIRES
EXAMPLE C20 = 40#14 WIRES

C#
C = CONTROL

2) ANALOG CABLES ARE INTENDED TO BE INDIVIDUALLY INSULATED TWISTED SHIELDED PAIRS UNLESS OTHERWISE NOTED ON THE DRAWING.

GAI
Gupta & Associates, Inc.
CONSULTING ENGINEERING
REGISTRATION NO. F-2593
13771 N. Metro Road
Dallas, Texas 75244
Tel: 972-485-1725
email: gai@gaiaonline.com



SAN ANTONIO WATER SYSTEM

REV. NO.	DATE	DRWN	ER	ADDITIONAL NO.4	REMARKS
A	08/30/22				

SAN ANTONIO WATER SYSTEM
STEVEN M. CLOUSE WRC
ELECTRICAL SYSTEM IMPROVEMENTS PHASE 2B
ELECTRICAL
FIRST STAGE AERATION TANKS INTERFACE DIAGRAM

DESIGNED BY: K. KADAM
DRAWN BY: E. RANGEL
SHEET CHKD BY: V.K. GUPTA
APPROVED BY: W. SAKO
DATE: JULY 2022
SAWS JOB NO.: 21-6510
FILE NAME: 1951_20E56

SHEET NO.
20E56
150 OF 227

8/23/2022 12:08 PM Z:\1951_SAWS Dos Rios WRC Electrical System Improvements - Phase II\5 Drawings\Dos Rios Phase II\Electrical\Working\Phase B\1951_20E57.dwg Jenny Meam

INTERFACE DIAGRAM			
EQUIPMENT TAG	DESCRIPTION	FIELD WIRING	PLC/RIO
AERATION TANKS NO.3 & NO.4			
SG-A5	SLUICE GATE (INFLUENT)	SG C6 RIRS12-101 (6#14 - SPARE)	REMOTE I/O RIO-RS1-1
SG-A6	SLUICE GATE (INFLUENT)	SG C6 RIRS12-102 (6#14 - SPARE)	
SG-A7	SLUICE GATE (INFLUENT)	SG C6 RIRS12-103 (6#14 - SPARE)	
SG-A8	SLUICE GATE (INFLUENT)	SG C6 RIRS12-104 (6#14 - SPARE)	
SG-A35	SLUICE GATE (EFFLUENT)	SG C6 RIRS12-105 (6#14 - SPARE)	
SG-A36	SLUICE GATE (EFFLUENT)	SG C6 RIRS12-106 (6#14 - SPARE)	
SG-A37	SLUICE GATE (EFFLUENT)	SG C6 RIRS12-107 (6#14 - SPARE)	
SG-A38	SLUICE GATE (EFFLUENT)	SG C6 RIRS12-108 (6#14 - SPARE)	
AE-C513	DISSOLVE OXYGEN (DO) SENSOR	AE ① IC-A34 AIT-C513	
AE-C514	DISSOLVE OXYGEN (DO) SENSOR	AE ① A6 RIRS12-109 2-1PR#16TSP- SPARE	
AE-C519	DISSOLVE OXYGEN (DO) SENSOR	AE ① AIT-C519	
AE-C520	DISSOLVE OXYGEN (DO) SENSOR	AE ①	
FIT-C515	FLOW TRANSMITTER	FIT A1 RIRS12-110	
FIT-C516	FLOW TRANSMITTER	FIT A1 RIRS12-111	
FIT-C517	FLOW TRANSMITTER	FIT A1 RIRS12-112	
FIT-C521	FLOW TRANSMITTER	FIT A1 RIRS12-113	
FIT-C522	FLOW TRANSMITTER	FIT A1 RIRS12-114	
FIT-C523	FLOW TRANSMITTER	FIT A1 RIRS12-115	
FIRST STAGE SETTLING TANKS NO.3 & NO.4			
SG-F5	SLUICE GATE	SG C6 RIRS12-116 (6#14 - SPARE)	
SG-F6	SLUICE GATE	SG C6 RIRS12-117 (6#14 - SPARE)	
SG-F7	SLUICE GATE	SG C6 RIRS12-118 (6#14 - SPARE)	
SG-F8	SLUICE GATE	SG C6 RIRS12-119 (6#14 - SPARE)	
E010	SLUDGE COLLECTOR PANEL NO.3A	CP C4 RIRS12-120 (2#14 - SPARE)	
E011	SLUDGE COLLECTOR PANEL NO.3B	CP C4 RIRS12-121 (2#14 - SPARE)	
E012	SLUDGE COLLECTOR PANEL NO.4A	CP C4 RIRS12-122 (2#14 - SPARE)	
E013	SLUDGE COLLECTOR PANEL NO.4B	CP C4 RIRS12-123 (2#14 - SPARE)	

INTERFACE DIAGRAM			
EQUIPMENT TAG	DESCRIPTION	FIELD WIRING	PLC/RIO
AERATION TANKS NO.3 AND NO.4 PIPE GALLERY			
FIT-E008	FLOW TRANSMITTER	FIT ② RIRS12-124 ENCLOSURE SKF1 A1 RIRS12-124	REMOTE I/O RIO-RS1-1
V-E008	VALVE CONTROL PANEL	CP ② RIRS12-125 A1 RIRS12-125	
FIT-E009	FLOW TRANSMITTER	FIT ② RIRS12-126 A1 RIRS12-126	
V-E009	VALVE CONTROL PANEL	CP ② RIRS12-127 A1 RIRS12-127	
ELECTRICAL BUILDING EB-RS-1			
ZS-RS1-A	ELECTRICAL ROOM INTRUSION SWITCH	ZS C1 RIRS12-128	REMOTE I/O RIO-RS1-1
ZS-RS1-B	ELECTRICAL ROOM INTRUSION SWITCH	ZS C1 RIRS12-128A	
ZS-RS1-C	ELECTRICAL ROOM INTRUSION SWITCH	ZS C1 RIRS12-128B	
TIT-RS1-1	ELECTRICAL ROOM TEMPERATURE	TIT A1 RIRS12-129	

GENERAL NOTES:

- ALL THE CONDUIT AND WIRE RUNS ARE SHOWN INDIVIDUALLY FOR CLARITY. CONTRACTOR TO ROUTE WIRES AND CONDUITS AS PER RISER DIAGRAM.
- THE CONDUIT SIZE AS SHOWN ARE MINIMUM.
- ALL WIRES SHALL BE TERMINATED ON TERMINAL BLOCK. THERE SHALL BE NO LOOSE WIRES.
- THE SIZES AS SHOWN ARE MINIMUM. THE CONTRACTOR SHALL BE RESPONSIBLE TO FURNISH THE CABINET AND TERMINATE ALL WIRES PLUS 25% SPARE TERMINAL BLOCKS.
- ALL CAT-6 CABLE TO BE ROUTED IN CONDUIT ONLY.
- REFER TO SHEET 20N34 FOR THE EQUIPMENT TAGS CROSS REFERENCE.

NOTES:

- EXISTING EQUIPMENT, CABLES AND CONDUITS.
- EXISTING EQUIPMENT. PROVIDE NEW CABLES IN EXISTING CONDUITS.

CONTROL & INSTRUMENTATION WIRE/CONDUIT SCHEDULE			
C1	2#14, #14G, 3/4"C	A1	1-1Pr#16 TSP, #14G, 3/4"C
C2	4#14, #14G, 3/4"C	A2	2-1Pr#16 TSP, #14G, 3/4"C
C3	6#14, #14G, 1"C	A3	3-1Pr#16 TSP, #14G, 3/4"C
C4	8#14, #14G, 1"C	A4	4-1Pr#16 TSP, #14G, 1"C
C5	10#14, #14G, 1"C	A5	5-1Pr#16 TSP, #14G, 1"C
C6	12#14, #14G, 1-1/4"C	A6	6-1Pr#16 TSP, #14G, 1-1/2"C
C7	14#14, #14G, 1-1/4"C	A7	7-1Pr#16 TSP, #14G, 2"C
C8	16#14, #14G, 1-1/4"C	A8	8-1Pr#16 TSP, #14G, 2"C
C9	18#14, #14G, 1-1/4"C	A9	9-1Pr#16 TSP, #14G, 2"C
C10	20#14, #14G, 1-1/4"C	A10	10-1Pr#16 TSP, #14G, 2"C
C11	22#14, #14G, 1-1/4"C	A11	11-1Pr#16 TSP, #14G, 2"C
C12	24#14, #14G, 1-1/4"C	M1	1-CAT-5e, #14G, 1"C
C14	28#14, #14G, 1-1/4"C	M2	2-CAT-5e, #14G, 1-1/2"C
C30	60#14, #14G, 3-1/2"C	M3	3-CAT-5e, #14G, 2"C
C37	74#14, #14G, 4"C	M4	4-CAT-5e, #14G, 2"C

CONTROL & INSTRUMENTATION WIRE/CONDUIT TABLE NOTES:

- NOT ALL POSSIBLE COMBINATIONS ARE LISTED. INCLUDE A SEPARATE GROUND WIRE IN EACH CONDUIT RUN.
REPRESENTS PAIR OF WIRE
EXAMPLE C10 = 20#14 WIRES
EXAMPLE C20 = 40#14 WIRES
C# = CONTROL
- ANALOG CABLES ARE INTENDED TO BE INDIVIDUALLY INSULATED TWISTED SHIELDED PAIRS UNLESS OTHERWISE NOTED ON THE DRAWING.

GAI
Gupta & Associates, Inc.
CONSULTING ENGINEERING
REGISTRATION NO. F-2593
13777 N. Metro Road
Dallas, Texas 75244
Tel: 972-485-1725
email: gai@gaiaonline.com



SAN ANTONIO WATER SYSTEM

NO.	REV.	DATE	DRWN	ER	ADDED/REV. NO.4	REMARKS
1	A	08/30/22				

SAN ANTONIO WATER SYSTEM
STEVEN M. CLOUSE WRC
ELECTRICAL SYSTEM IMPROVEMENTS PHASE 2B
ELECTRICAL
FIRST STAGE AERATION TANKS INTERFACE DIAGRAM

DESIGNED BY: K. KADAM
DRAWN BY: E. RANGEL
SHEET CHKD BY: V.K. GUPTA
APPROVED BY: W. SAKO
DATE: JULY 2022
SAWS JOB NO.: 21-6510
FILE NAME: 1951_20E57

SHEET NO.
20E57
151 OF 227

8/23/2022 12:09 PM Z:\1951_SAWS Dos Rios WRC Electrical System Improvements - Phase II\5 Drawings\Dos Rios Phase II\Electrical\Working\Phase B\1951_20E58.dwg Jenny Meam

INTERFACE DIAGRAM				
EQUIPMENT TAG	DESCRIPTION	FIELD WIRING	PLC/RIO	
AERATION TANKS NO.5 & NO.6				
SG-A9	SLUICE GATE (INFLUENT)	SG C6 RIRS21-101 (6#14 - SPARE)	PLC-RS2	
SG-A10	SLUICE GATE (INFLUENT)	SG C6 RIRS21-102 (6#14 - SPARE)		
SG-A11	SLUICE GATE (INFLUENT)	SG C6 RIRS21-103 (6#14 - SPARE)		
SG-A12	SLUICE GATE (INFLUENT)	SG C6 RIRS21-104 (6#14 - SPARE)		
SG-A39	SLUICE GATE (EFFLUENT)	SG C6 RIRS21-105 (6#14 - SPARE)		
SG-A40	SLUICE GATE (EFFLUENT)	SG C6 RIRS21-106 (6#14 - SPARE)		
SG-A41	SLUICE GATE (EFFLUENT)	SG C6 RIRS21-107 (6#14 - SPARE)		
SG-A42	SLUICE GATE (EFFLUENT)	SG C6 RIRS21-108 (6#14 - SPARE)		
AE-C525	DISSOLVE OXYGEN (DO) SENSOR	AE ① IC-A56 AIT-C525		
AE-C526	DISSOLVE OXYGEN (DO) SENSOR	AE ① AIT-C525 A4 RIRS21-109 2-PR#16TSP- SPARE		
AE-C531	DISSOLVE OXYGEN (DO) SENSOR	AE ① AIT-C531		
AE-C532	DISSOLVE OXYGEN (DO) SENSOR	AE ①		
FIT-C527	FLOW TRANSMITTER	FIT A1 RIRS21-110		
FIT-C528	FLOW TRANSMITTER	FIT A1 RIRS21-111		
FIT-C529	FLOW TRANSMITTER	FIT A1 RIRS21-112		
FIT-C533	FLOW TRANSMITTER	FIT A1 RIRS21-113		
FIT-C534	FLOW TRANSMITTER	FIT A1 RIRS21-114		
FIT-C535	FLOW TRANSMITTER	FIT A1 RIRS21-115		
FIRST STAGE SETTLING TANKS NO.5 & NO.6				
TIT-C561	TEMPERATURE TRANSMITTER	TIT A1 RIRS21-116		
TIT-C562	TEMPERATURE TRANSMITTER	TIT A1 RIRS21-117		
SG-F9	SLUICE GATE	SG C6 RIRS21-118 (6#14 - SPARE)		
SG-F10	SLUICE GATE	SG C6 RIRS21-119 (6#14 - SPARE)		
SG-F11	SLUICE GATE	SG C6 RIRS21-120 (6#14 - SPARE)		
SG-F12	SLUICE GATE	SG C6 RIRS21-121 (6#14 - SPARE)		
E017	SLUDGE COLLECTOR PANEL NO.5A	CP C4 RIRS21-122 (2#14 - SPARE)		
E018	SLUDGE COLLECTOR PANEL NO.5B	CP C4 RIRS21-123 (2#14 - SPARE)		
E019	SLUDGE COLLECTOR PANEL NO.6A	CP C4 RIRS21-124 (2#14 - SPARE)		
E020	SLUDGE COLLECTOR PANEL NO.6B	CP C4 RIRS21-125 (2#14 - SPARE)		

INTERFACE DIAGRAM				
EQUIPMENT TAG	DESCRIPTION	FIELD WIRING	PLC/RIO	
AERATION TANKS NO.5 AND NO.6 PIPE GALLERY				
FIT-E015	FLOW TRANSMITTER	FIT ② RIRS21-126 ENCLOSURE SKF2 A1 RIRS21-126	PLC-RS2	
V-E015	VALVE CONTROL PANEL	CP ② RIRS21-127 A1 RIRS21-127		
FIT-E016	FLOW TRANSMITTER	FIT ② RIRS21-128 A1 RIRS21-128		
V-E106	VALVE CONTROL PANEL	CP ② RIRS21-129 A1 RIRS21-129		
ELECTRICAL BUILDING EB-RS-2				
ZS-RS2-A	ELECTRICAL ROOM INTRUSION SWITCH	ZS C1 RIRS21-130		
ZS-RS2-B	ELECTRICAL ROOM INTRUSION SWITCH	ZS C1 RIRS21-130A		
ZS-RS2-C	ELECTRICAL ROOM INTRUSION SWITCH	ZS C1 RIRS21-130B		
NETRAK-RS2	NETWORK ENCLOSURE	CP C1 RIRS21-131		
TIT-RS2-1	ELECTRICAL TEMPERATURE TRANSMITTER	TIT A1 RIRS21-132		

GENERAL NOTES:

- ALL THE CONDUIT AND WIRE RUNS ARE SHOWN INDIVIDUALLY FOR CLARITY. CONTRACTOR TO ROUTE WIRES AND CONDUITS AS PER RISER DIAGRAM.
- THE CONDUIT SIZE AS SHOWN ARE MINIMUM.
- ALL WIRES SHALL BE TERMINATED ON TERMINAL BLOCK. THERE SHALL BE NO LOOSE WIRES.
- THE SIZES AS SHOWN ARE MINIMUM. THE CONTRACTOR SHALL BE RESPONSIBLE TO FURNISH THE CABINET AND TERMINATE ALL WIRES PLUS 25% SPARE TERMINAL BLOCKS.
- ALL CAT-6 CABLE TO BE ROUTED IN CONDUIT ONLY.
- REFER TO SHEET 20N34 FOR THE EQUIPMENT TAGS CROSS REFERENCE.

NOTES:

- EXISTING EQUIPMENT, CABLES AND CONDUITS.
- EXISTING EQUIPMENT. PROVIDE NEW CABLES IN EXISTING CONDUITS.

CONTROL & INSTRUMENTATION WIRE/CONDUIT SCHEDULE			
C1	2#14, #14G, 3/4"C	A1	1-1P#16 TSP, #14G, 3/4"C
C2	4#14, #14G, 3/4"C	A2	2-1P#16 TSP, #14G, 3/4"C
C3	6#14, #14G, 1"C	A3	3-1P#16 TSP, #14G, 3/4"C
C4	8#14, #14G, 1"C	A4	4-1P#16 TSP, #14G, 1"C
C5	10#14, #14G, 1"C	A5	5-1P#16 TSP, #14G, 1"C
C6	12#14, #14G, 1-1/4"C	A6	6-1P#16 TSP, #14G, 1-1/2"C
C7	14#14, #14G, 1-1/4"C	A7	7-1P#16 TSP, #14G, 2"C
C8	16#14, #14G, 1-1/4"C	A8	8-1P#16 TSP, #14G, 2"C
C9	18#14, #14G, 1-1/4"C	A9	9-1P#16 TSP, #14G, 2"C
C10	20#14, #14G, 1-1/4"C	A10	10-1P#16 TSP, #14G, 2"C
C11	22#14, #14G, 1-1/4"C	A11	11-1P#16 TSP, #14G, 2"C
C12	24#14, #14G, 1-1/4"C	M1	1-CAT-5e, #14G, 1"C
C14	28#14, #14G, 1-1/4"C	M2	2-CAT-5e, #14G, 1-1/2"C
C30	60#14, #14G, 3-1/2"C	M3	3-CAT-5e, #14G, 2"C
C37	74#14, #14G, 4"C	M4	4-CAT-5e, #14G, 2"C

CONTROL & INSTRUMENTATION WIRE/CONDUIT TABLE NOTES:

- NOT ALL POSSIBLE COMBINATIONS ARE LISTED. INCLUDE A SEPARATE GROUND WIRE IN EACH CONDUIT RUN.
REPRESENTS PAIR OF WIRE
EXAMPLE C10 = 20#14 WIRES
EXAMPLE C20 = 40#14 WIRES
C# = CONTROL
- ANALOG CABLES ARE INTENDED TO BE INDIVIDUALLY INSULATED TWISTED SHIELDED PAIRS UNLESS OTHERWISE NOTED ON THE DRAWING.

GAI
Gupta & Associates, Inc.
CONSULTING ENGINEERING
REGISTRATION NO. F-2593
Dallas, Texas 75244
13771 N. Metro Road
Fax: 972-485-1725
email: gai@gaia.com



SAN ANTONIO WATER SYSTEM

REV. NO.	DATE	DRWN	ER	ADDENDUM NO.4	REMARKS
1	08/30/22				

ONE INCH AT FULL SIZE IF NOT ONE INCH SCALE ACCORDINGLY

SAN ANTONIO WATER SYSTEM
STEVEN M. CLOUSE WRC
ELECTRICAL SYSTEM IMPROVEMENTS PHASE 2B
FIRST STAGE AERATION TANKS INTERFACE DIAGRAM

DESIGNED BY: K. KADAM
DRAWN BY: E. RANGEL
SHEET CHKD BY: V.K. GUPTA
APPROVED BY: W. SAKO
DATE: JULY 2022
SAWS JOB NO.: 21-6510
FILE NAME: 1951_20E58

SHEET NO.
20E58
152 OF 227

8/23/2022 12:09 PM Z:\1951_SAWS Dos Rios WRC Electrical System Improvements - Phase II\5 Drawings\Dos Rios Phase II\Electrical\Working\Phase B\1951_20E59.dwg, Jenny Meam

INTERFACE DIAGRAM			
EQUIPMENT TAG	DESCRIPTION	FIELD WIRING	PLC/RIO
AERATION TANKS NO.7 & NO.8			
SG-A13	SLUICE GATE (INFLUENT)	SG C6 RIRS22-101 (6#14 - SPARE)	REMOTE I/O RIO-RS2-1
SG-A14	SLUICE GATE (INFLUENT)	SG C6 RIRS22-102 (6#14 - SPARE)	
SG-A15	SLUICE GATE (INFLUENT)	SG C6 RIRS22-103 (6#14 - SPARE)	
SG-A16	SLUICE GATE (INFLUENT)	SG C6 RIRS22-104 (6#14 - SPARE)	
SG-A43	SLUICE GATE (EFFLUENT)	SG C6 RIRS22-105 (6#14 - SPARE)	
SG-A44	SLUICE GATE (EFFLUENT)	SG C6 RIRS22-106 (6#14 - SPARE)	
SG-A45	SLUICE GATE (EFFLUENT)	SG C6 RIRS22-107 (6#14 - SPARE)	
SG-A46	SLUICE GATE (EFFLUENT)	SG C6 RIRS22-108 (6#14 - SPARE)	
AE-C537	DISSOLVE OXYGEN (DO) SENSOR	AE (1) IC-A78 AIT-C537 A6 RIRS22-109	
AE-C538	DISSOLVE OXYGEN (DO) SENSOR	AE (1) AIT-C543 2-1PR#16TSP- SPARE	
AE-C543	DISSOLVE OXYGEN (DO) SENSOR	AE (1)	
AE-C544	DISSOLVE OXYGEN (DO) SENSOR	AE (1)	
FIT-C539	FLOW TRANSMITTER	FIT A1 RIRS22-110	
FIT-C540	FLOW TRANSMITTER	FIT A1 RIRS22-111	
FIT-C541	FLOW TRANSMITTER	FIT A1 RIRS22-112	
FIT-C545	FLOW TRANSMITTER	FIT A1 RIRS22-113	
FIT-C546	FLOW TRANSMITTER	FIT A1 RIRS22-114	
FIT-C547	FLOW TRANSMITTER	FIT A1 RIRS22-115	
FIRST STAGE SETTLING TANKS NO.7 & NO.8			
SG-F13	SLUICE GATE	SG C6 RIRS22-116 (6#14 - SPARE)	
SG-F14	SLUICE GATE	SG C6 RIRS22-117 (6#14 - SPARE)	
SG-F15	SLUICE GATE	SG C6 RIRS22-118 (6#14 - SPARE)	
SG-F16	SLUICE GATE	SG C6 RIRS22-119 (6#14 - SPARE)	
E055	SLUDGE COLLECTOR PANEL NO.7A	CP C4 RIRS22-120 (2#14 - SPARE)	
E024	SLUDGE COLLECTOR PANEL NO.7B	CP C4 RIRS22-121 (2#14 - SPARE)	
E025	SLUDGE COLLECTOR PANEL NO.8A	CP C4 RIRS22-122 (2#14 - SPARE)	
E026	SLUDGE COLLECTOR PANEL NO.8B	CP C4 RIRS22-123 (2#14 - SPARE)	

INTERFACE DIAGRAM				
EQUIPMENT TAG	DESCRIPTION	FIELD WIRING	PLC/RIO	
AERATION TANKS NO.7 AND NO.8 PIPE GALLERY				
FIT-E022	FLOW TRANSMITTER	FIT (2) RIRS22-124 ENCLOSURE SKF2 A1 RIRS22-124	REMOTE I/O RIO-RS2-1	
V-E022	VALVE CONTROL PANEL	CP (2) RIRS22-125 A1 RIRS22-125		
FIT-E023	FLOW TRANSMITTER	FIT (2) RIRS22-126 A1 RIRS22-126		
V-E023	VALVE CONTROL PANEL	CP (2) RIRS22-127 A1 RIRS22-127		
ELECTRICAL BUILDING EB-RS-2				
ZS-RS2-2	CONTROL ROOM INTRUSION SOUTH	ZS C1 RIRS22-128		
TIT-RS2-2	CONTROL ROOM TEMPERATURE TRANSMITTER	TIT A1 RIRS22-129		

GENERAL NOTES:

- ALL THE CONDUIT AND WIRE RUNS ARE SHOWN INDIVIDUALLY FOR CLARITY. CONTRACTOR TO ROUTE WIRES AND CONDUITS AS PER RISER DIAGRAM.
- THE CONDUIT SIZE AS SHOWN ARE MINIMUM.
- ALL WIRES SHALL BE TERMINATED ON TERMINAL BLOCK. THERE SHALL BE NO LOOSE WIRES.
- THE SIZES AS SHOWN ARE MINIMUM. THE CONTRACTOR SHALL BE RESPONSIBLE TO FURNISH THE CABINET AND TERMINATE ALL WIRES PLUS 25% SPARE TERMINAL BLOCKS.
- ALL CAT-6 CABLE TO BE ROUTED IN CONDUIT ONLY.
- REFER TO SHEET 20N34 FOR THE EQUIPMENT TAGS CROSS REFERENCE.

NOTES:

- EXISTING EQUIPMENT, CABLES AND CONDUITS.
- EXISTING EQUIPMENT. PROVIDE NEW CABLES IN EXISTING CONDUITS.

CONTROL & INSTRUMENTATION WIRE/CONDUIT SCHEDULE			
C1	2#14, #14G, 3/4"C	A1	1-1Pr#16 TSP, #14G, 3/4"C
C2	4#14, #14G, 3/4"C	A2	2-1Pr#16 TSP, #14G, 3/4"C
C3	6#14, #14G, 1"C	A3	3-1Pr#16 TSP, #14G, 3/4"C
C4	8#14, #14G, 1"C	A4	4-1Pr#16 TSP, #14G, 1"C
C5	10#14, #14G, 1"C	A5	5-1Pr#16 TSP, #14G, 1"C
C6	12#14, #14G, 1-1/4"C	A6	6-1Pr#16 TSP, #14G, 1-1/2"C
C7	14#14, #14G, 1-1/4"C	A7	7-1Pr#16 TSP, #14G, 2"C
C8	16#14, #14G, 1-1/4"C	A8	8-1Pr#16 TSP, #14G, 2"C
C9	18#14, #14G, 1-1/4"C	A9	9-1Pr#16 TSP, #14G, 2"C
C10	20#14, #14G, 1-1/4"C	A10	10-1Pr#16 TSP, #14G, 2"C
C11	22#14, #14G, 1-1/4"C	A11	11-1Pr#16 TSP, #14G, 2"C
C12	24#14, #14G, 1-1/4"C	M1	1-CAT-5e, #14G, 1"C
C14	28#14, #14G, 1-1/4"C	M2	2-CAT-5e, #14G, 1-1/2"C
C30	60#14, #14G, 3-1/2"C	M3	3-CAT-5e, #14G, 2"C
C37	74#14, #14G, 4"C	M4	4-CAT-5e, #14G, 2"C

**CONTROL & INSTRUMENTATION
WIRE/CONDUIT TABLE NOTES:**

- NOT ALL POSSIBLE COMBINATIONS ARE LISTED. INCLUDE A SEPARATE GROUND WIRE IN EACH CONDUIT RUN.
REPRESENTS PAIR OF WIRE
EXAMPLE C10 = 20#14 WIRES
EXAMPLE C20 = 40#14 WIRES
C = CONTROL
- ANALOG CABLES ARE INTENDED TO BE INDIVIDUALLY INSULATED TWISTED SHIELDED PAIRS UNLESS OTHERWISE NOTED ON THE DRAWING.

GAI
Gupta & Associates, Inc.
CONSULTING ENGINEERING
Registration No. F-2593
13771 N. Metro Road
Dallas, Texas 75244
Tel: 972-485-1725
email: gai@gaiaurfg.com



**SAN ANTONIO
WATER
SYSTEM**

REV. NO.	DATE	DRWN	ER	ADDDITIONAL NO.4	REMARKS
A	08/30/22				

SAN ANTONIO WATER SYSTEM
STEVEN M. CLOUSE WRC
ELECTRICAL SYSTEM IMPROVEMENTS PHASE 2B
ELECTRICAL
**FIRST STAGE AERATION TANKS
INTERFACE DIAGRAM**

DESIGNED BY: K. KADAM
DRAWN BY: E. RANGEL
SHEET CHKD BY: V.K. GUPTA
APPROVED BY: W. SAKO
DATE: JULY 2022
SAWS JOB NO.: 21-6510
FILE NAME: 1951_20E59

SHEET NO.
20E59
153 OF 227

8/23/2022 12:10 PM Z:\1951_SAWS Dos Rios WRC Electrical System Improvements - Phase II\5 Drawings\Dos Rios Phase II\Electrical\Working\Phase B\1951_20E60.dwg Jenny Meam

INTERFACE DIAGRAM				
EQUIPMENT TAG	DESCRIPTION	FIELD WIRING	PLC/RIO	
AERATION TANKS NO.9 & NO.10				
SG-A17	SLUICE GATE (INFLUENT)	SG C6 RIRS23-101 (6#14 - SPARE)	REMOTE I/O RIO-RS2-2	
SG-A18	SLUICE GATE (INFLUENT)	SG C6 RIRS23-102 (6#14 - SPARE)		
SG-A19	SLUICE GATE (INFLUENT)	SG C6 RIRS23-103 (6#14 - SPARE)		
SG-A20	SLUICE GATE (INFLUENT)	SG C6 RIRS23-104 (6#14 - SPARE)		
SG-A47	SLUICE GATE (EFFLUENT)	SG C6 RIRS23-105 (6#14 - SPARE)		
SG-A48	SLUICE GATE (EFFLUENT)	SG C6 RIRS23-106 (6#14 - SPARE)		
SG-A49	SLUICE GATE (EFFLUENT)	SG C6 RIRS23-107 (6#14 - SPARE)		
SG-A50	SLUICE GATE (EFFLUENT)	SG C6 RIRS23-108 (6#14 - SPARE)		
AE-C549	DISSOLVE OXYGEN (DO) SENSOR	AE (1) IC-A910 AIT-C501		
AE-C550	DISSOLVE OXYGEN (DO) SENSOR	AE (1) A6 RIRS23-109 2-1PR#16TSP- SPARE		
AE-C555	DISSOLVE OXYGEN (DO) SENSOR	AE (1) AIT-C507		
AE-C556	DISSOLVE OXYGEN (DO) SENSOR	AE (1)		
FIT-C551	FLOW TRANSMITTER	FIT A1 RIRS23-110		
FIT-C552	FLOW TRANSMITTER	FIT A1 RIRS23-111		
FIT-C553	FLOW TRANSMITTER	FIT A1 RIRS23-112		
FIT-C557	FLOW TRANSMITTER	FIT A1 RIRS23-113		
FIT-C558	FLOW TRANSMITTER	FIT A1 RIRS23-114		
FIT-C559	FLOW TRANSMITTER	FIT A1 RIRS23-115		
FIRST STAGE SETTLING TANKS NO.9 & NO.10				
SG-F17	SLUICE GATE	SG C6 RIRS23-116 (6#14 - SPARE)		
SG-F18	SLUICE GATE	SG C6 RIRS23-117 (6#14 - SPARE)		
SG-F19	SLUICE GATE	SG C6 RIRS23-118 (6#14 - SPARE)		
SG-F20	SLUICE GATE	SG C6 RIRS23-119 (6#14 - SPARE)		
E030	SLUDGE COLLECTOR PANEL NO.9A	CP C4 RIRS23-120 (2#14 - SPARE)		
E031	SLUDGE COLLECTOR PANEL NO.9B	CP C4 RIRS23-121 (2#14 - SPARE)		
E032	SLUDGE COLLECTOR PANEL NO.10A	CP C4 RIRS23-122 (2#14 - SPARE)		
E033	SLUDGE COLLECTOR PANEL NO.10B	CP C4 RIRS23-123 (2#14 - SPARE)		

INTERFACE DIAGRAM			
EQUIPMENT TAG	DESCRIPTION	FIELD WIRING	PLC/RIO
AERATION TANKS NO.9 AND NO.10 PIPE GALLERY			
FIT-E028	FLOW TRANSMITTER	FIT (2) RIRS23-124	REMOTE I/O RIO-RS2-2
CV-E028	VALVE CONTROL PANEL	CP (2) RIRS23-125	
FIT-E029	FLOW TRANSMITTER	FIT (2) RIRS23-126	
CV-E029	VALVE CONTROL PANEL	CP (2) RIRS23-127	

GENERAL NOTES:

1. ALL THE CONDUIT AND WIRE RUNS ARE SHOWN INDIVIDUALLY FOR CLARITY. CONTRACTOR TO ROUTE WIRES AND CONDUITS AS PER RISER DIAGRAM.
2. THE CONDUIT SIZE AS SHOWN ARE MINIMUM.
3. ALL WIRES SHALL BE TERMINATED ON TERMINAL BLOCK. THERE SHALL BE NO LOOSE WIRES.
4. THE SIZES AS SHOWN ARE MINIMUM. THE CONTRACTOR SHALL BE RESPONSIBLE TO FURNISH THE CABINET AND TERMINATE ALL WIRES PLUS 25% SPARE TERMINAL BLOCKS.
5. ALL CAT-6 CABLE TO BE ROUTED IN CONDUIT ONLY.
6. REFER TO SHEET 20N34 FOR THE EQUIPMENT TAGS CROSS REFERENCE.

NOTES:

- (1) EXISTING EQUIPMENT, CABLES AND CONDUITS.
- (2) EXISTING EQUIPMENT. PROVIDE NEW CABLES IN EXISTING CONDUITS.

CONTROL & INSTRUMENTATION WIRE/CONDUIT SCHEDULE			
C1	2#14, #14G, 3/4"C	A1	1-1P#16 TSP, #14G, 3/4"C
C2	4#14, #14G, 3/4"C	A2	2-1P#16 TSP, #14G, 3/4"C
C3	6#14, #14G, 1"C	A3	3-1P#16 TSP, #14G, 3/4"C
C4	8#14, #14G, 1"C	A4	4-1P#16 TSP, #14G, 1"C
C5	10#14, #14G, 1"C	A5	5-1P#16 TSP, #14G, 1"C
C6	12#14, #14G, 1-1/4"C	A6	6-1P#16 TSP, #14G, 1-1/2"C
C7	14#14, #14G, 1-1/4"C	A7	7-1P#16 TSP, #14G, 2"C
C8	16#14, #14G, 1-1/4"C	A8	8-1P#16 TSP, #14G, 2"C
C9	18#14, #14G, 1-1/4"C	A9	9-1P#16 TSP, #14G, 2"C
C10	20#14, #14G, 1-1/4"C	A10	10-1P#16 TSP, #14G, 2"C
C11	22#14, #14G, 1-1/4"C	A11	11-1P#16 TSP, #14G, 2"C
C12	24#14, #14G, 1-1/4"C	M1	1-CAT-5e, #14G, 1"C
C14	28#14, #14G, 1-1/4"C	M2	2-CAT-5e, #14G, 1-1/2"C
C30	60#14, #14G, 3-1/2"C	M3	3-CAT-5e, #14G, 2"C
C37	74#14, #14G, 4"C	M4	4-CAT-5e, #14G, 2"C

CONTROL & INSTRUMENTATION WIRE/CONDUIT TABLE NOTES:

- 1) NOT ALL POSSIBLE COMBINATIONS ARE LISTED. INCLUDE A SEPARATE GROUND WIRE IN EACH CONDUIT RUN.
REPRESENTS PAIR OF WIRE
EXAMPLE C10 = 20#14 WIRES
EXAMPLE C20 = 40#14 WIRES
C = CONTROL
- 2) ANALOG CABLES ARE INTENDED TO BE INDIVIDUALLY INSULATED TWISTED SHIELDED PAIRS UNLESS OTHERWISE NOTED ON THE DRAWING.

GAI
Gupta & Associates, Inc.
CONSULTING ENGINEERING
Registration No. F-2593
1377 N. Metro Road
Dallas, Texas 75244
Tel: 972-488-1725
email: gait@gaiaurfg.com



SAN ANTONIO WATER SYSTEM

08/30/22	ER	ADDENDUM NO.4	REMARKS
REV. NO.	DATE	DRWN	REMARKS


ONE INCH AT FULL SIZE IF NOT ONE INCH SCALE ACCORDINGLY

SAN ANTONIO WATER SYSTEM
STEVEN M. CLOUSE WRC
ELECTRICAL SYSTEM IMPROVEMENTS PHASE 2B
ELECTRICAL
FIRST STAGE AERATION TANKS INTERFACE DIAGRAM


DESIGNED BY:	K. KADAM
DRAWN BY:	E. RANGEL
SHEET CHKD BY:	V.K. GUPTA
APPROVED BY:	W. SAKO
DATE:	JULY 2022
SAWS JOB NO.:	21-6510
FILE NAME:	1951_20E60

SHEET NO.
20E60
154 OF 227

8/23/2022 12:10 PM Z:\1951_SAWS Dos Rios WRC Electrical System Improvements - Phase II\Drawings\Dos Rios Phase II\Electrical\Working\Phase B\1951_20E61.dwg Jenny Meam

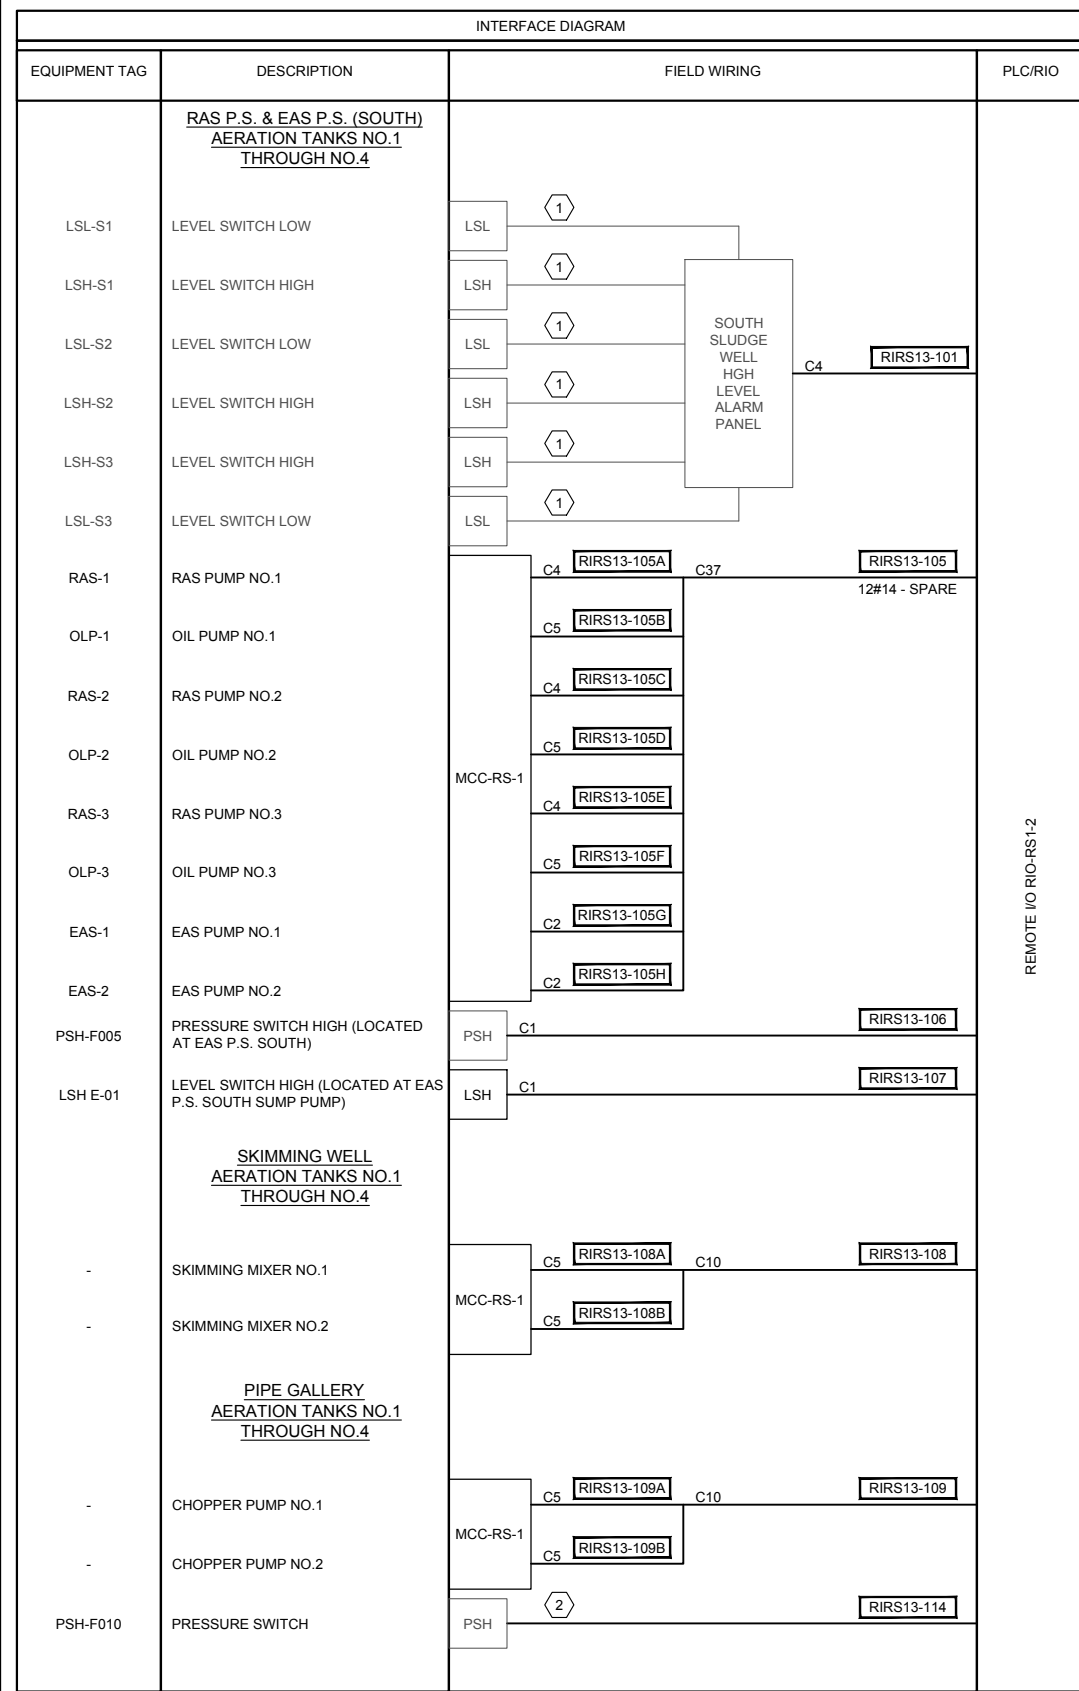

REMOTE I/O RIO-RS1-2

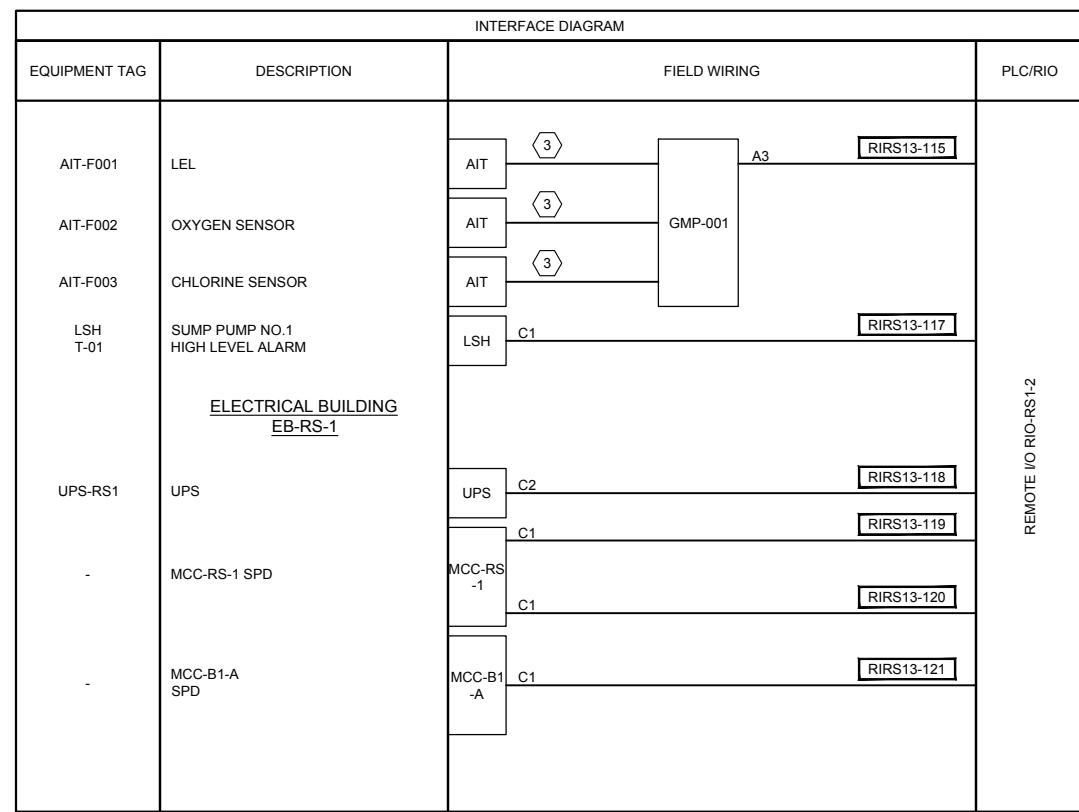

REMOTE I/O RIO-RS1-2

GENERAL NOTES:

- ALL THE CONDUIT AND WIRE RUNS ARE SHOWN INDIVIDUALLY FOR CLARITY. CONTRACTOR TO ROUTE WIRES AND CONDUITS AS PER RISER DIAGRAM.
- THE CONDUIT SIZE AS SHOWN ARE MINIMUM.
- ALL WIRES SHALL BE TERMINATED ON TERMINAL BLOCK. THERE SHALL BE NO LOOSE WIRES.
- THE SIZES AS SHOWN ARE MINIMUM. THE CONTRACTOR SHALL BE RESPONSIBLE TO FURNISH THE CABINET AND TERMINATE ALL WIRES PLUS 25% SPARE TERMINAL BLOCKS.
- ALL CAT-6 CABLE TO BE ROUTED IN CONDUIT ONLY.
- REFER TO SHEET 20N34 FOR THE EQUIPMENT TAGS CROSS REFERENCE.

NOTES:

- EXISTING EQUIPMENT, CABLES AND CONDUITS.
- EXISTING EQUIPMENT. PROVIDE NEW CABLES IN EXISTING CONDUITS.
- MANUFACTURER PROVIDED CABLE IN 1".

CONTROL & INSTRUMENTATION WIRE/CONDUIT SCHEDULE			
C1	2#14, #14G, 3/4"C	A1	1-1P#16 TSP, #14G, 3/4"C
C2	4#14, #14G, 3/4"C	A2	2-1P#16 TSP, #14G, 3/4"C
C3	6#14, #14G, 1"C	A3	3-1P#16 TSP, #14G, 3/4"C
C4	8#14, #14G, 1"C	A4	4-1P#16 TSP, #14G, 1"C
C5	10#14, #14G, 1"C	A5	5-1P#16 TSP, #14G, 1"C
C6	12#14, #14G, 1-1/4"C	A6	6-1P#16 TSP, #14G, 1-1/2"C
C7	14#14, #14G, 1-1/4"C	A7	7-1P#16 TSP, #14G, 2"C
C8	16#14, #14G, 1-1/4"C	A8	8-1P#16 TSP, #14G, 2"C
C9	18#14, #14G, 1-1/4"C	A9	9-1P#16 TSP, #14G, 2"C
C10	20#14, #14G, 1-1/4"C	A10	10-1P#16 TSP, #14G, 2"C
C11	22#14, #14G, 1-1/4"C	A11	11-1P#16 TSP, #14G, 2"C
C12	24#14, #14G, 1-1/4"C	M1	1-CAT-5e, #14G, 1"C
C14	28#14, #14G, 1-1/4"C	M2	2-CAT-5e, #14G, 1-1/2"C
C30	60#14, #14G, 3-1/2"C	M3	3-CAT-5e, #14G, 2"C
C37	74#14, #14G, 4"C	M4	4-CAT-5e, #14G, 2"C

CONTROL & INSTRUMENTATION WIRE/CONDUIT TABLE NOTES:

- NOT ALL POSSIBLE COMBINATIONS ARE LISTED. INCLUDE A SEPARATE GROUND WIRE IN EACH CONDUIT RUN.
REPRESENTS PAIR OF WIRE
EXAMPLE C10 = 20#14 WIRES
EXAMPLE C20 = 40#14 WIRES
C# = CONTROL
- ANALOG CABLES ARE INTENDED TO BE INDIVIDUALLY INSULATED TWISTED SHIELDED PAIRS UNLESS OTHERWISE NOTED ON THE DRAWING.

GAI
Gupta & Associates, Inc.
CONSULTING ENGINEERING
Registration No. F-2593
13771 N. Metro Road
Dallas, Texas 75244
Tel: 972-485-1725
Fax: 972-485-1725
email: gai@gaiconsulting.com



SAN ANTONIO WATER SYSTEM

REV. NO.	DATE	DRWN	REMARKS
A	08/30/22	ER	ADDENDUM NO.4


ONE INCH AT FULL SIZE IF NOT ONE INCH SCALE ACCORDINGLY

SAN ANTONIO WATER SYSTEM
STEVEN M. CLOUSE WRC
ELECTRICAL SYSTEM IMPROVEMENTS PHASE 2B
FIRST STAGE AERATION TANKS RAS P.S. AND EAS P.S. (SOUTH) INTERFACE DIAGRAM


DESIGNED BY:	K. KADAM
DRAWN BY:	E. RANGEL
SHEET CHKD BY:	V.K. GUPTA
APPROVED BY:	W. SAKO
DATE:	JULY 2022
SAWS JOB NO.:	21-6510
FILE NAME:	1951_20E61

SHEET NO.
20E61
155 OF 227

8/23/2022 12:11 PM Z:\1951_SAWS Dos Rios WRC Electrical System Improvements - Phase II\5 Drawings\Dos Rios Phase II\Electrical\Working\Phase B\1951_20E62.dwg - Jenny Meam

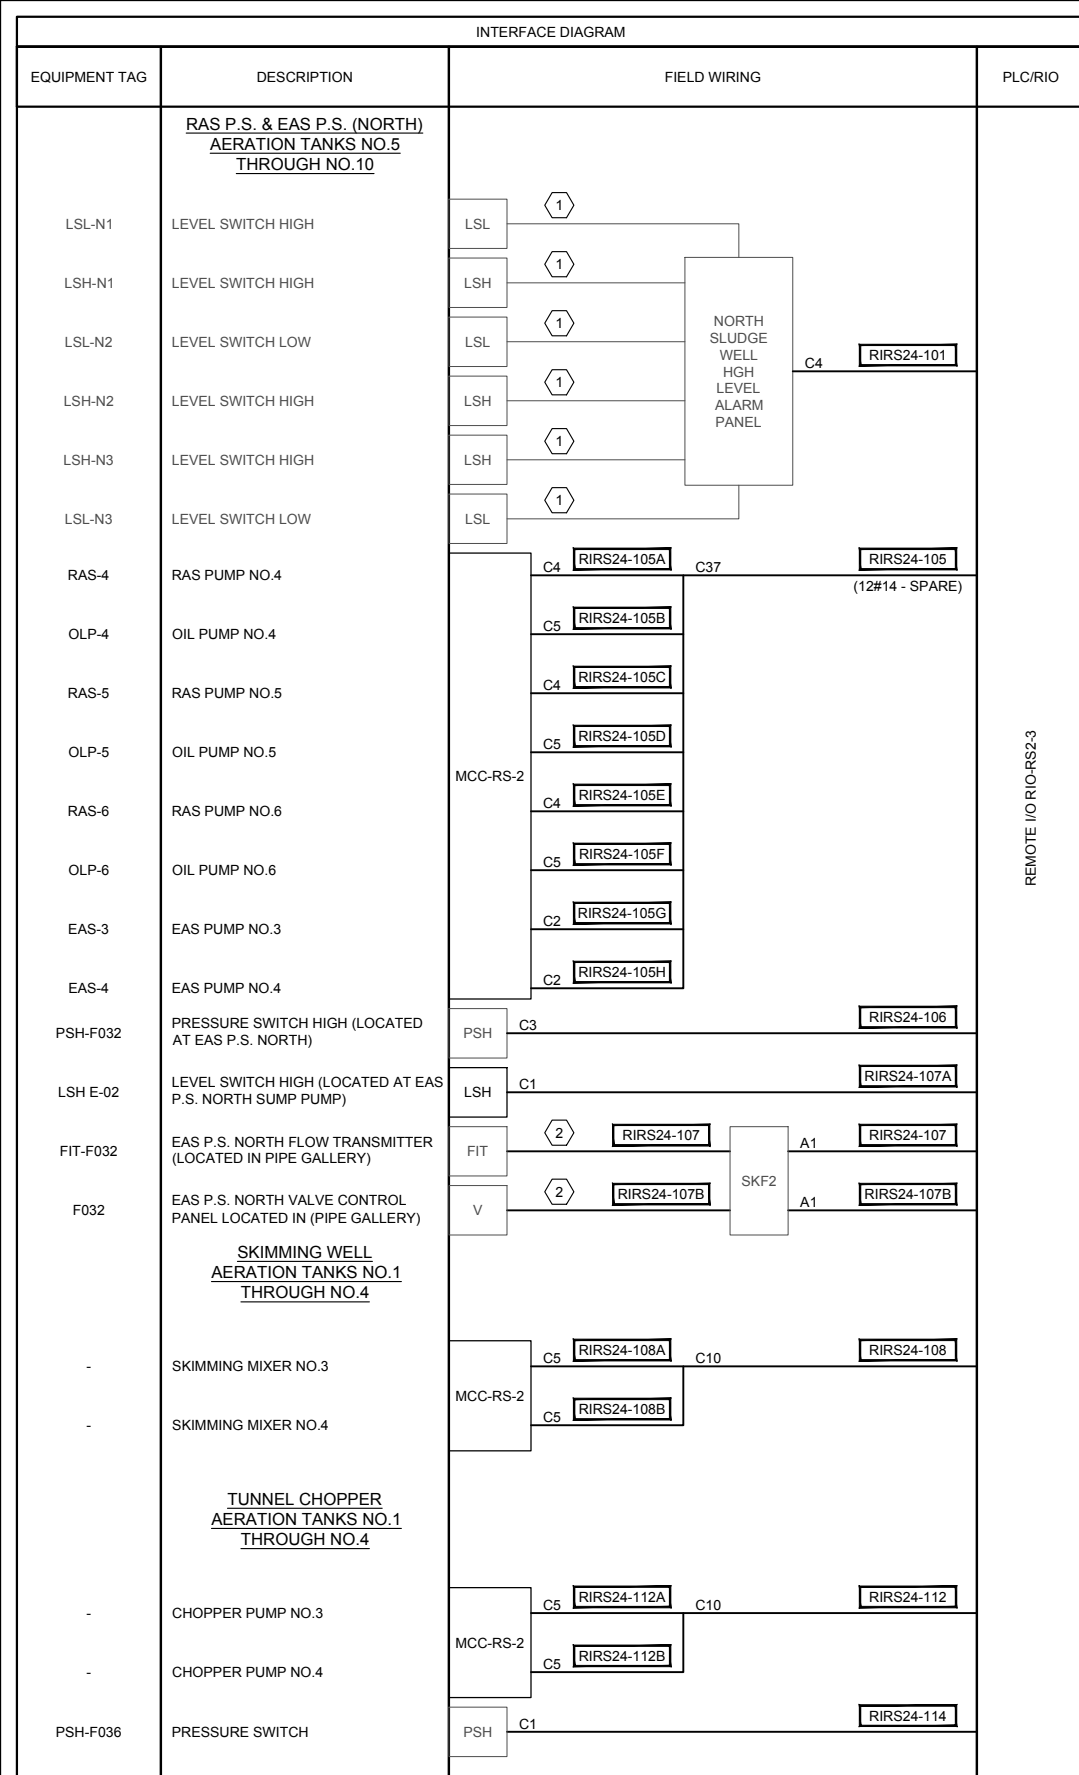

REMOTE I/O RIO-RS2-3

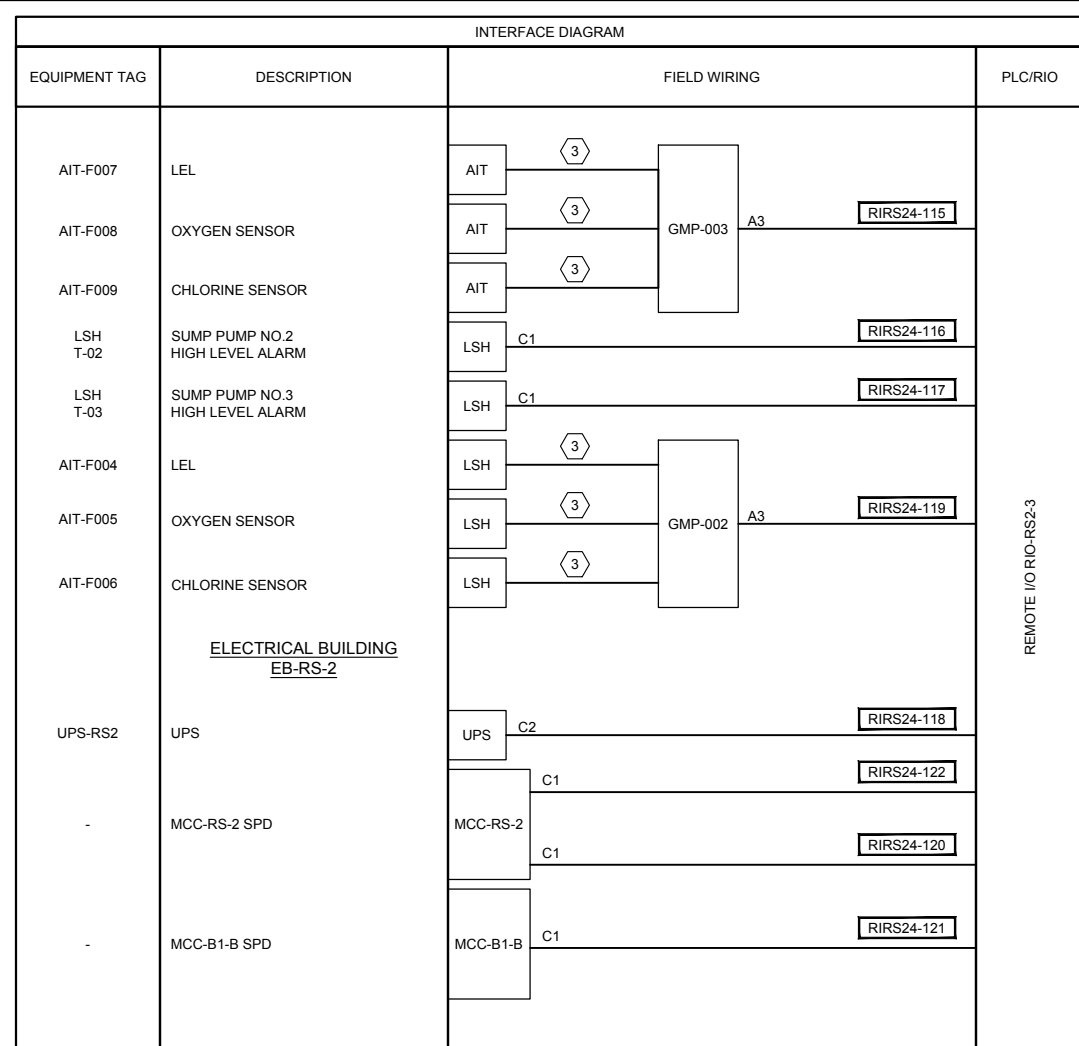

REMOTE I/O RIO-RS2-3

GENERAL NOTES:

- ALL THE CONDUIT AND WIRE RUNS ARE SHOWN INDIVIDUALLY FOR CLARITY. CONTRACTOR TO ROUTE WIRES AND CONDUITS AS PER RISER DIAGRAM.
- THE CONDUIT SIZE AS SHOWN ARE MINIMUM.
- ALL WIRES SHALL BE TERMINATED ON TERMINAL BLOCK. THERE SHALL BE NO LOOSE WIRES.
- THE SIZES AS SHOWN ARE MINIMUM. THE CONTRACTOR SHALL BE RESPONSIBLE TO FURNISH THE CABINET AND TERMINATE ALL WIRES PLUS 25% SPARE TERMINAL BLOCKS.
- ALL CAT-6 CABLE TO BE ROUTED IN CONDUIT ONLY.
- REFER TO SHEET 20N34 FOR THE EQUIPMENT TAGS CROSS REFERENCE.

NOTES:

- (1) EXISTING EQUIPMENT, CABLES AND CONDUITS.
- (2) EXISTING EQUIPMENT. PROVIDE NEW CABLES IN EXISTING CONDUITS.
- (3) MANUFACTURER PROVIDED CABLE IN 1".

CONTROL & INSTRUMENTATION WIRE/CONDUIT SCHEDULE			
C1	2#14, #14G, 3/4"C	A1	1-1Pr#16 TSP, #14G, 3/4"C
C2	4#14, #14G, 3/4"C	A2	2-1Pr#16 TSP, #14G, 3/4"C
C3	6#14, #14G, 1"C	A3	3-1Pr#16 TSP, #14G, 3/4"C
C4	8#14, #14G, 1"C	A4	4-1Pr#16 TSP, #14G, 1"C
C5	10#14, #14G, 1"C	A5	5-1Pr#16 TSP, #14G, 1"C
C6	12#14, #14G, 1-1/4"C	A6	6-1Pr#16 TSP, #14G, 1-1/2"C
C7	14#14, #14G, 1-1/4"C	A7	7-1Pr#16 TSP, #14G, 2"C
C8	16#14, #14G, 1-1/4"C	A8	8-1Pr#16 TSP, #14G, 2"C
C9	18#14, #14G, 1-1/4"C	A9	9-1Pr#16 TSP, #14G, 2"C
C10	20#14, #14G, 1-1/4"C	A10	10-1Pr#16 TSP, #14G, 2"C
C11	22#14, #14G, 1-1/4"C	A11	11-1Pr#16 TSP, #14G, 2"C
C12	24#14, #14G, 1-1/4"C	M1	1-CAT-5e, #14G, 1"C
C14	28#14, #14G, 1-1/4"C	M2	2-CAT-5e, #14G, 1-1/2"C
C30	60#14, #14G, 3-1/2"C	M3	3-CAT-5e, #14G, 2"C
C37	74#14, #14G, 4"C	M4	4-CAT-5e, #14G, 2"C

CONTROL & INSTRUMENTATION WIRE/CONDUIT TABLE NOTES:

- NOT ALL POSSIBLE COMBINATIONS ARE LISTED. INCLUDE A SEPARATE GROUND WIRE IN EACH CONDUIT RUN.
 - # REPRESENTS PAIR OF WIRE
 - EXAMPLE C10 = 20#14 WIRES
 - EXAMPLE C20 = 40#14 WIRES
- ANALOG CABLES ARE INTENDED TO BE INDIVIDUALLY INSULATED TWISTED SHIELDED PAIRS UNLESS OTHERWISE NOTED ON THE DRAWING.

GAI
Gupta & Associates, Inc.
CONSULTING ENGINEERING
REGISTRATION NO. F-2593
Dallas, Texas 75244
13771 N. Metro Road
Fax: 972-485-1725
email: gait@gaia.com



SAN ANTONIO WATER SYSTEM

REV. NO.	DATE	DRWN	ER	ADDED/REV. NO. 4	REMARKS
1	08/30/22				

SAN ANTONIO WATER SYSTEM
STEVEN M. CLOUSE WRC
ELECTRICAL SYSTEM IMPROVEMENTS PHASE 2B
FIRST STAGE AERATION TANKS
RAS P.S. AND EAS P.S. (NORTH)
INTERFACE DIAGRAM

DESIGNED BY: K. KADAM
DRAWN BY: E. RANGEL
SHEET CHKD BY: V.K. GUPTA
APPROVED BY: W. SAKO
DATE: JULY 2022
SAWS JOB NO.: 21-6510
FILE NAME: 1951_20E62

SHEET NO.
20E62
156 OF 227